


9512-RP
13124-RIO
16832-RIO
20322-RP

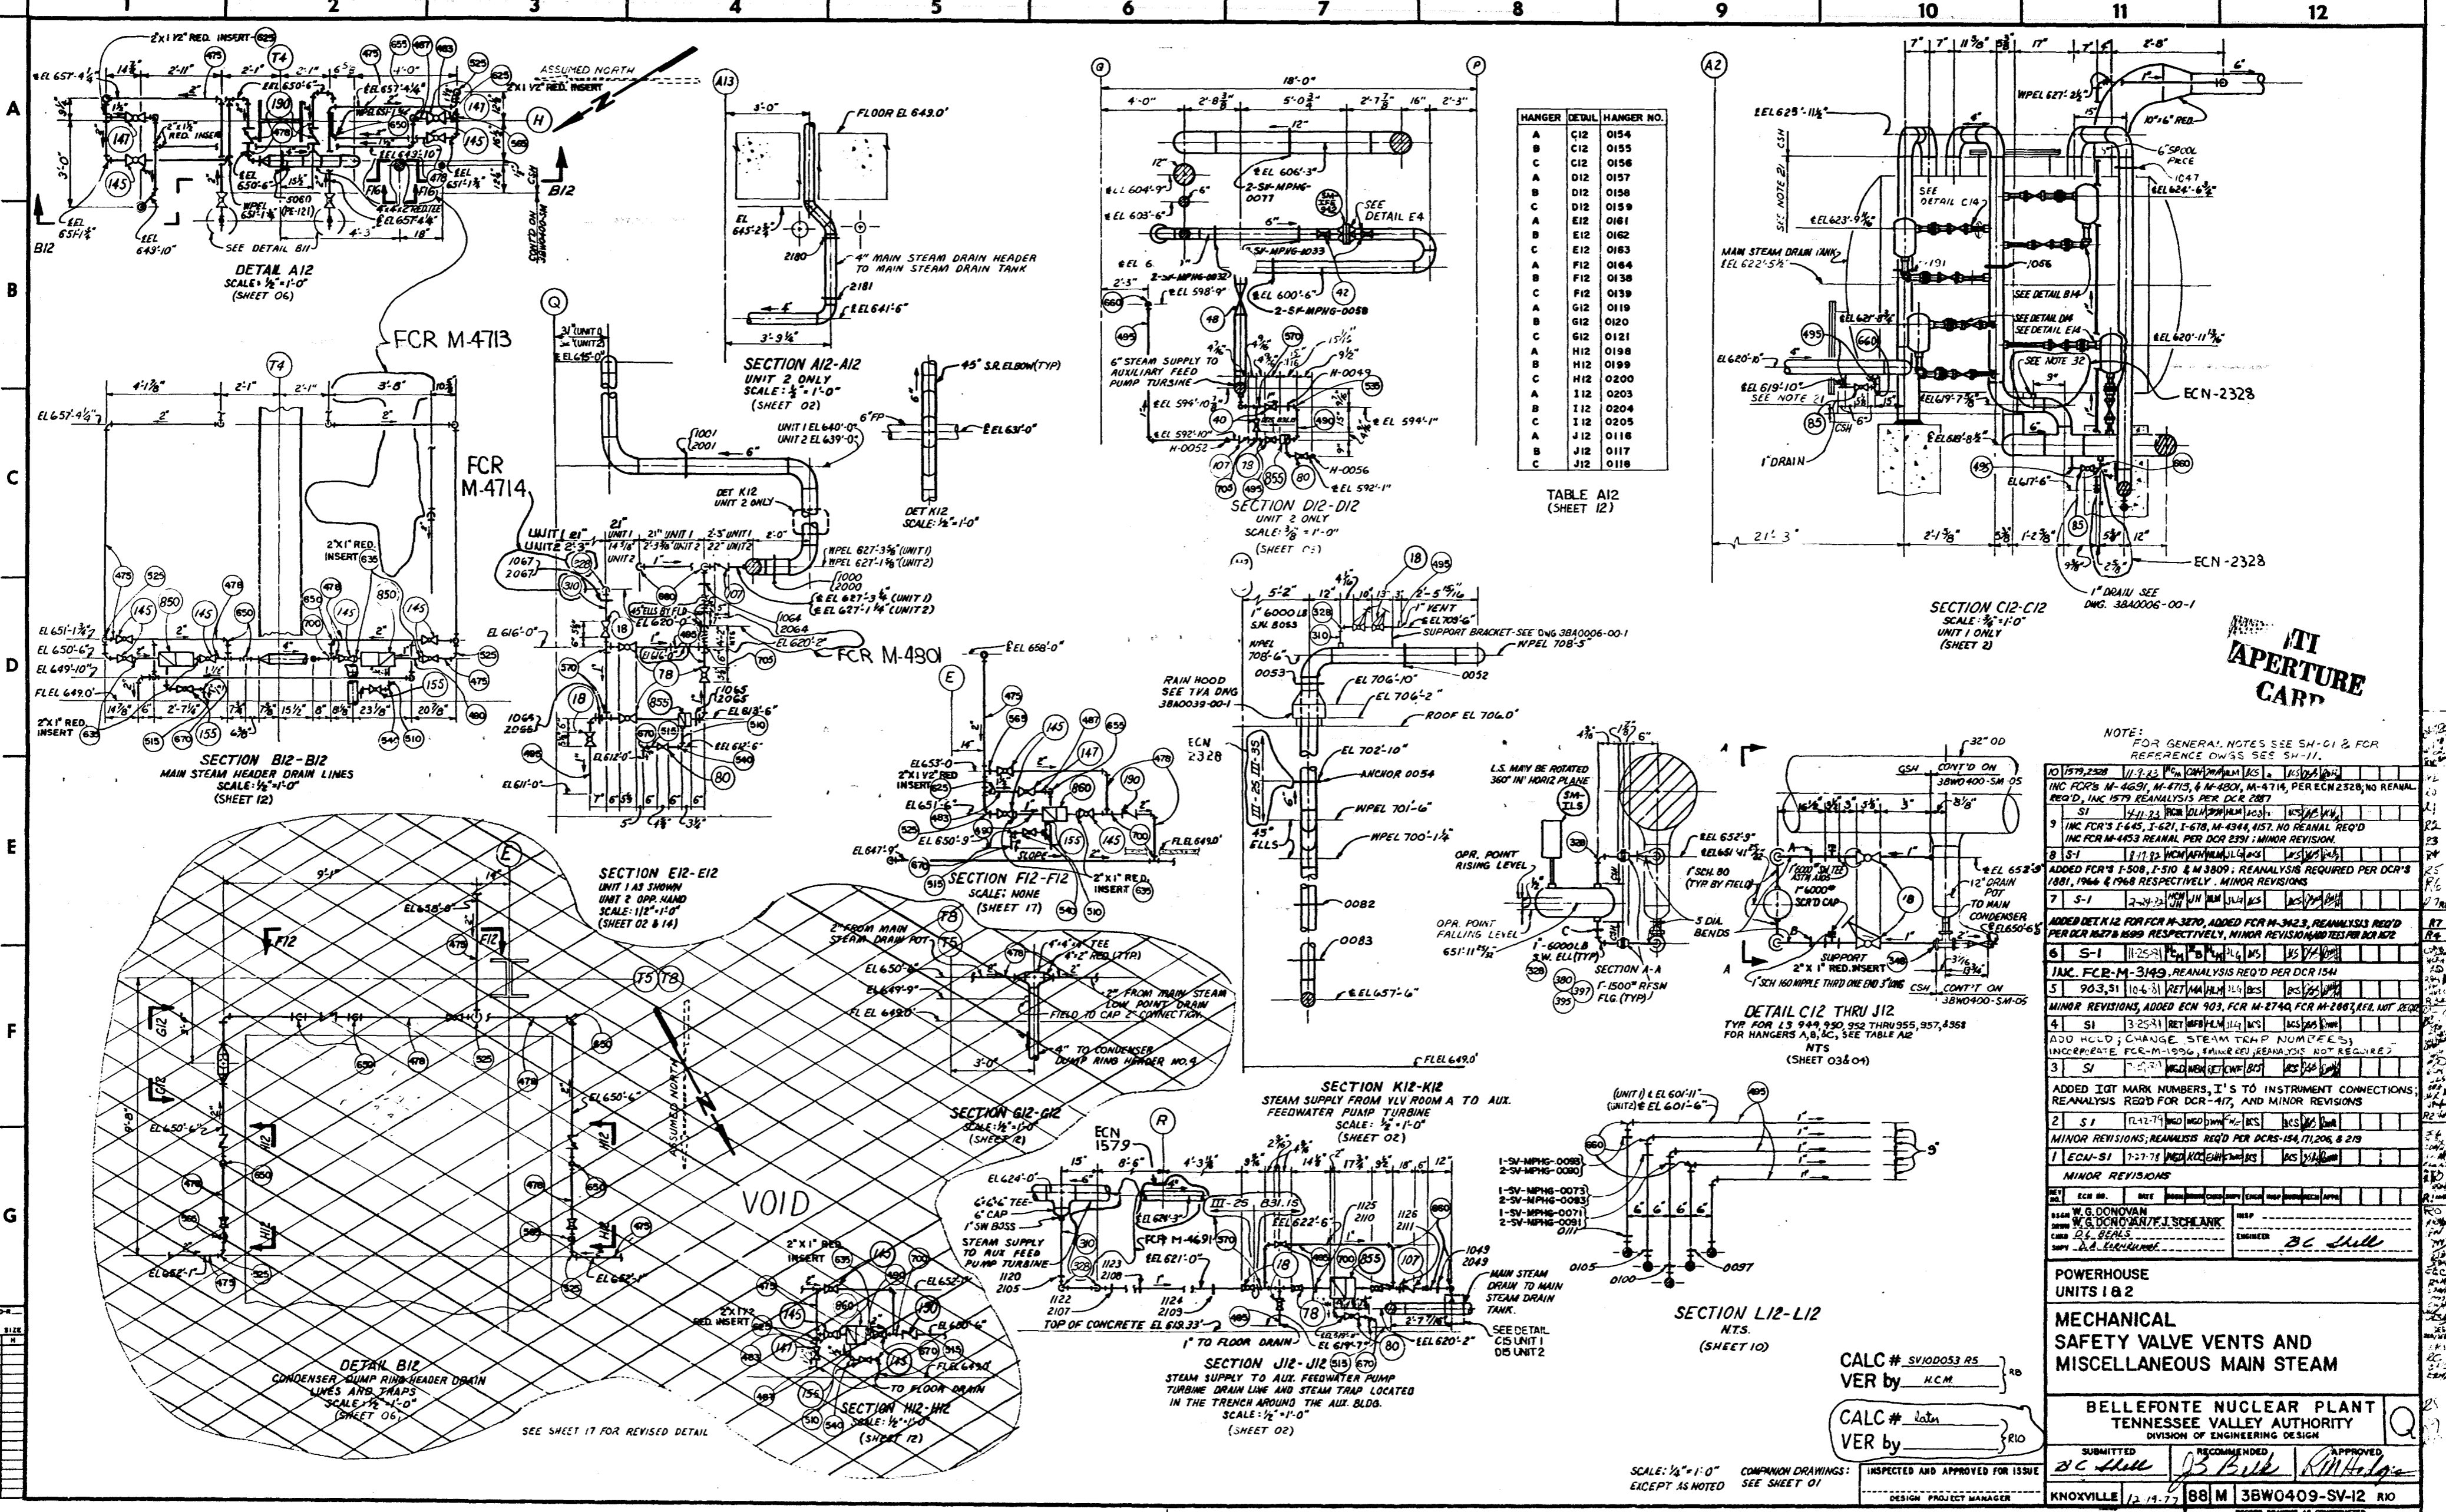

IT APERTURE CARD

NOTE: FOR GENERAL NOTES SEE SH-01 & FOR REFERENCE DWGS SEE SH-11.

CALC # SV10053 AS
VER by H.C.M.

CALC # [blank]
VER by [blank]

SCALE: 1/2" = 1'-0"
EXCEPT AS NOTED

COMPANION DRAWINGS: SEE SHEET 01
INSPECTED AND APPROVED FOR ISSUE
DESIGN PROJECT MANAGER

POWERHOUSE UNITS 1 & 2
MECHANICAL SAFETY VALVE VENTS AND MISCELLANEOUS MAIN STEAM

BELLEFONTE NUCLEAR PLANT
TENNESSEE VALLEY AUTHORITY
DIVISION OF ENGINEERING DESIGN
SUBMITTED: [blank] RECOMMENDED: [blank] APPROVED: [blank]
KNOXVILLE 12-14-77 88 M 38W0409-SV-12 RIO
SECOND DRAWING AS CONSTRUCTED

8508060328