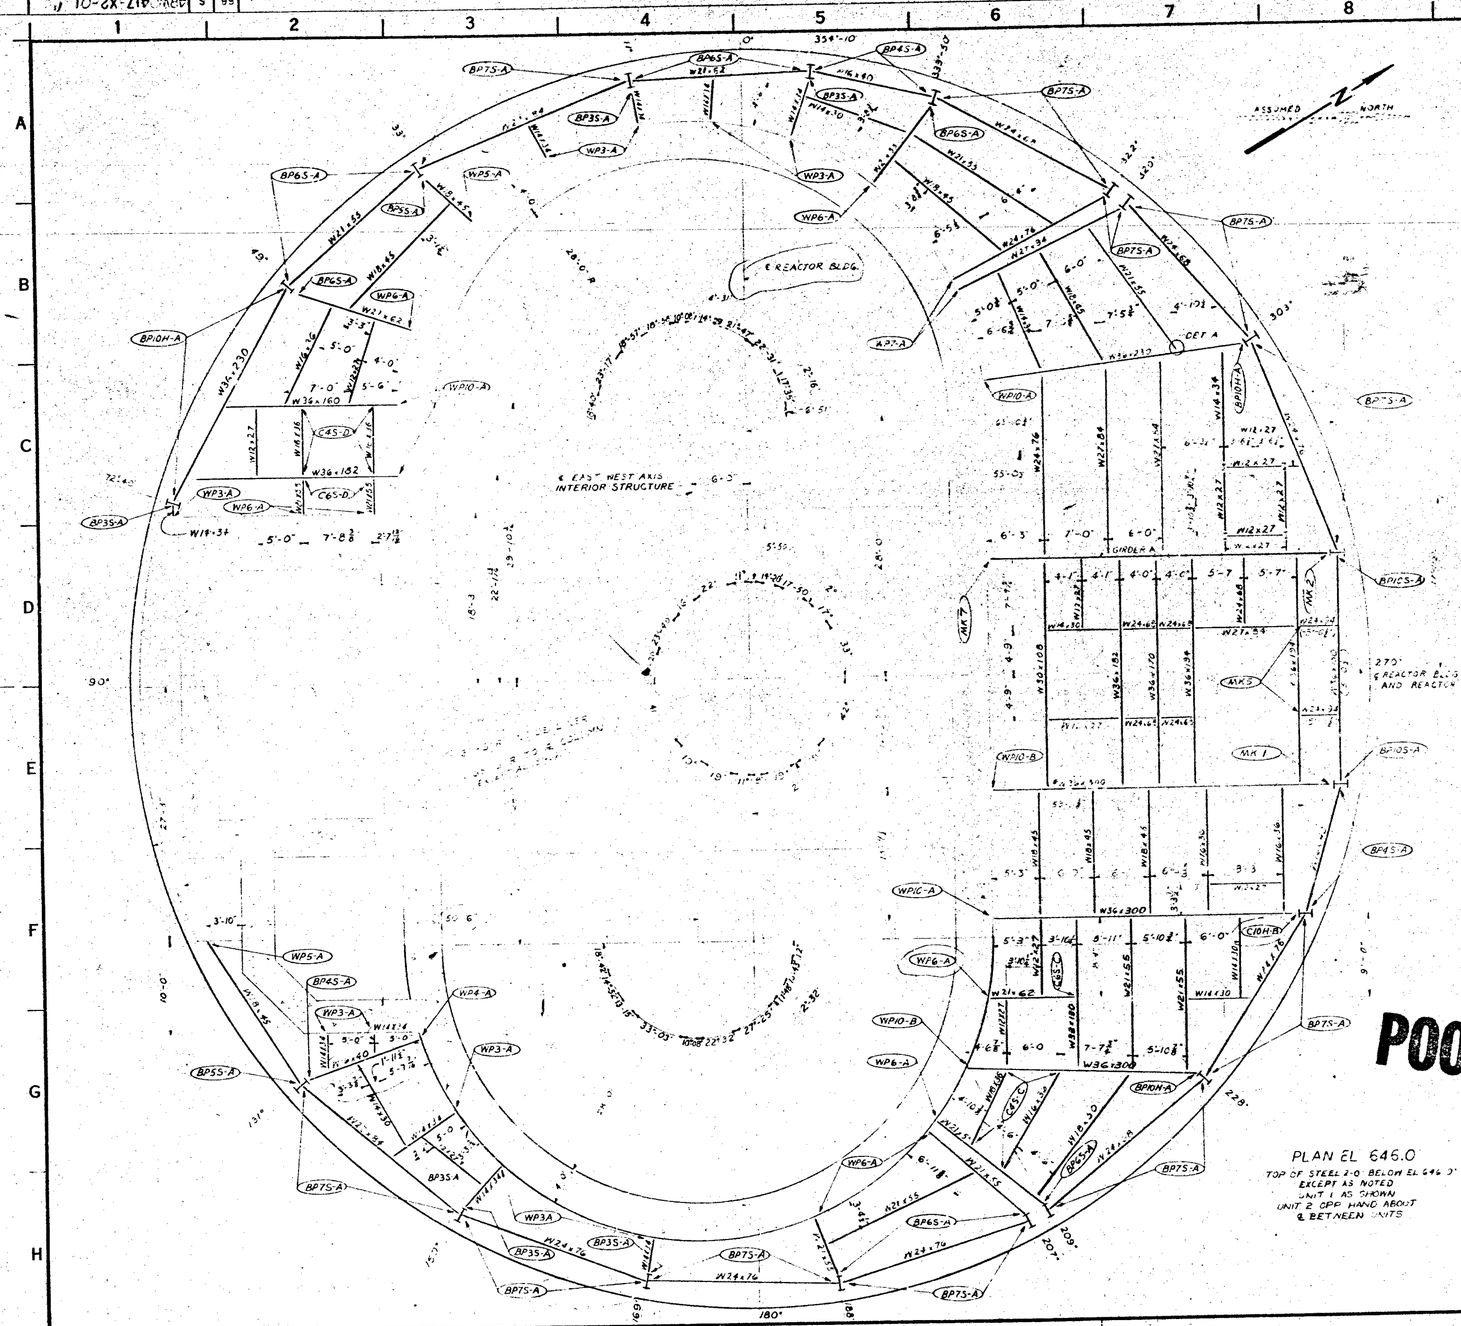

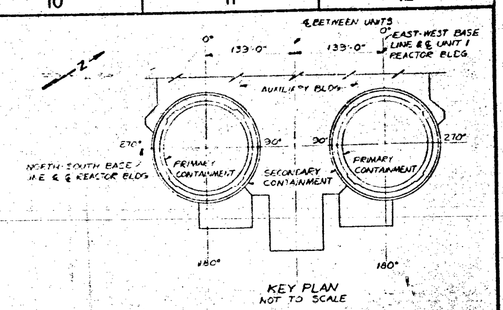

NOTES:

1. FOR GENERAL NOTES SEE 4RW0418-X2-02.
2. BEAMS MARKED WITH AN ASTERISK, * W36x300, SHALL BE OF MATERIAL CONFORMING TO ASTM SPECIFICATION DESIGNATION A572, GRADE 50. ALL OTHER MATERIAL SHALL CONFORM TO ASTM DESIGNATION A36, EXCEPT AS OTHERWISE NOTED.
3. THE SYMBOL (MK 1) DENOTES CONNECTION. SEE 4RW0418-X2-02 FOR DETAILS.
4. FOR GIRDER SCHEDULE SEE 4RW0417-X2-02.
5. FOR COLUMN AND VERTICAL BRACING SIZES SEE 4RW0420-X2-01.

PRC APERTURE CARD

POOR ORIGINAL

Docket # ~~50-438~~/439
Control # ~~8209010288~~
Date 8/23/82 of Document
REGULATORY DOCKET FILE

REV NO	ECN NO.	DATE	DSGN	DRN	CHKD	SUPV	ENGR	INSP	SCRN	RECM	APPR
3	7.2	9-14-78									
CHANGED CONNECTIONS IN AREA 5 EET. ADDED NOTE R.B CENTERLINE AND CHANGED DIMENSIONS IN AREA G2.											
2	S1	5-5-76									
GENERAL REVISION											
1	S1	12-29-75									
BEAM RELOCATED IN DIAGRAM A-5											

DSGN R. W. HOUSE
DRWN G. MILLER
CHKD
SUPV C. D. SATTMAYER
INSP
ENGINEER Carl W. Hatcher

REACTOR BUILDING
UNITS 1 & 2

STRUCTURAL STEEL FLOOR FRAMING EL 646.0

BELLEFONTE NUCLEAR PLANT
TENNESSEE VALLEY AUTHORITY
DIVISION OF ENGINEERING DESIGN

SUBMITTED	RECOMMENDED	APPROVED
Carl W. Hatcher	[illegible]	R. M. Hodge

KNOXVILLE 12-10-75 | 88 | 4RW0417-X2-01 R3

RECORD DRAWING AS CONSTRUCTED