NOTES:
1. FOR GENERAL NOTES AND REFERENCES SEE SGW0640-NS-01.

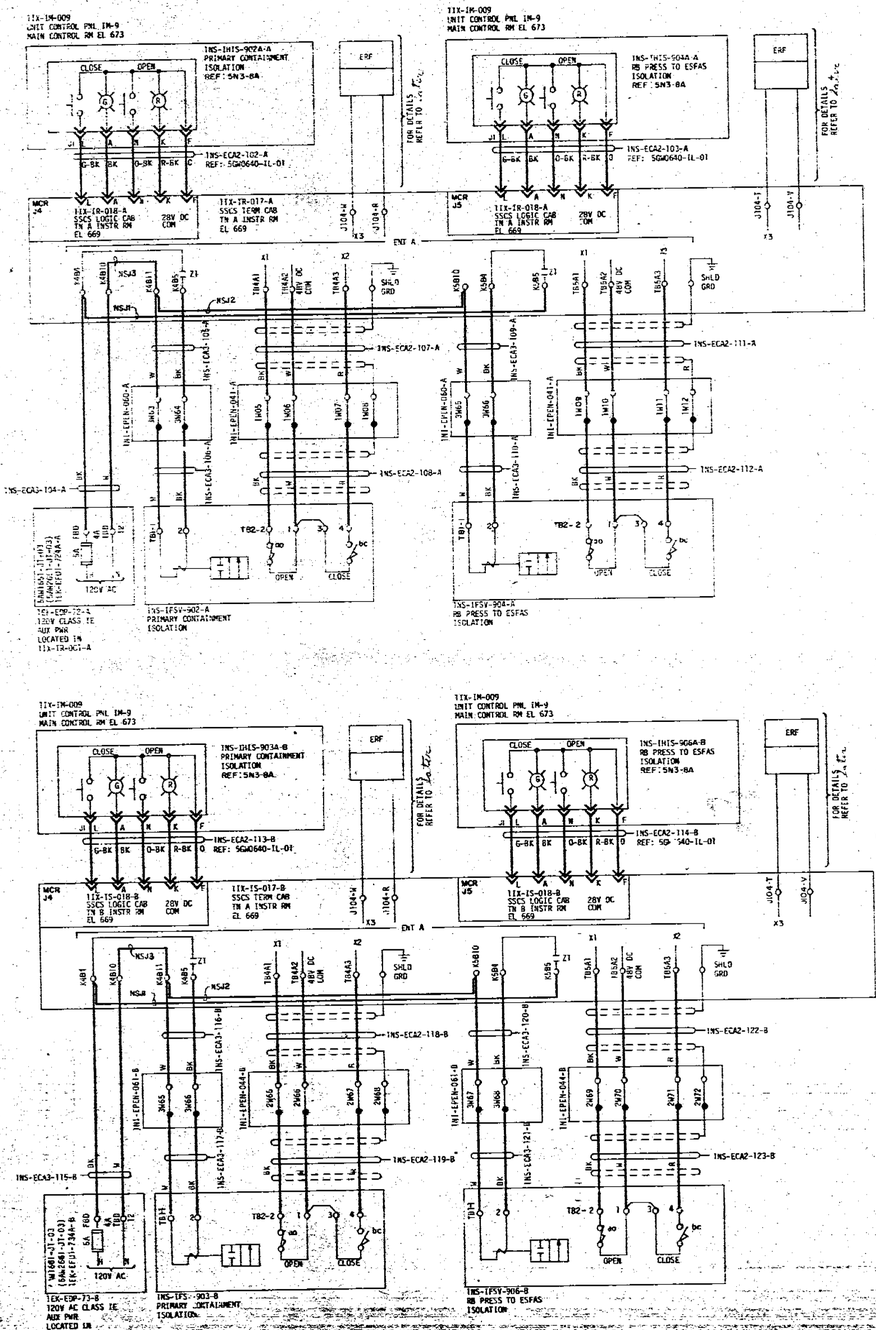

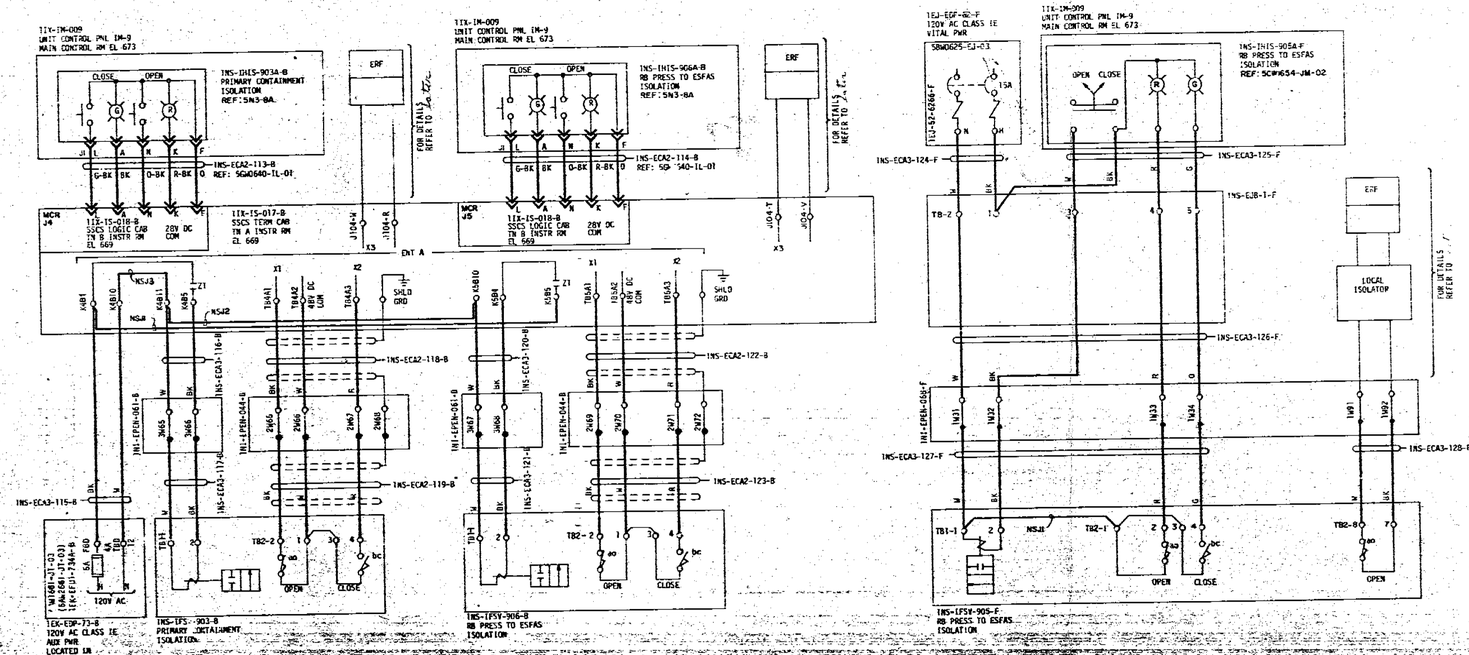

Docket 50-438
Docket 50-439
8304050056
Rec'd 3-25-83 of Ltr dated
Distribution Code A116

THIS DRAWING ISSUED FOR ECN 1027.

REVIEWED	
EEB	N/A
CEB	N/A
MEB	N/A
NEB	N/A

INSPECTED AND APPROVED FOR ISSUE

REV NO.	ECN NO	DATE	DSGN	DRWN	CHKD	SUPV	INSP	SUBMITTED	APPR

DSGN Louis Hamlett
DRWN R B Tate
CHKD B J Hylton
SUPV B J Conlon
INSP
ENGINEER M W Thomas

SCALE: NTS — EXCEPT AS NOTED

GENERAL
UNITS 1 & 2

SCHEMATIC DIAGRAM
REACTOR BLDG SPRAY SYS

BELLEFONTE NUCLEAR PLANT
TENNESSEE VALLEY AUTHORITY
DIVISION OF ENGINEERING DESIGN

Q

SUBMITTED	RECOMMENDED	APPROVED
M W Thomas	[signature]	K M Hahaya

KNOXVILLE 2-24-82 | 88 | E | SGW0640-NS-15 R8

RECORD DRAWING AS CONSTRUCTED

PRINT SIZE: A B C D E F H
BW ON PROJ ME CE CE AD CD ED MD SW WB PA
WIDTH 2600-0

PRC APERTURE CARD