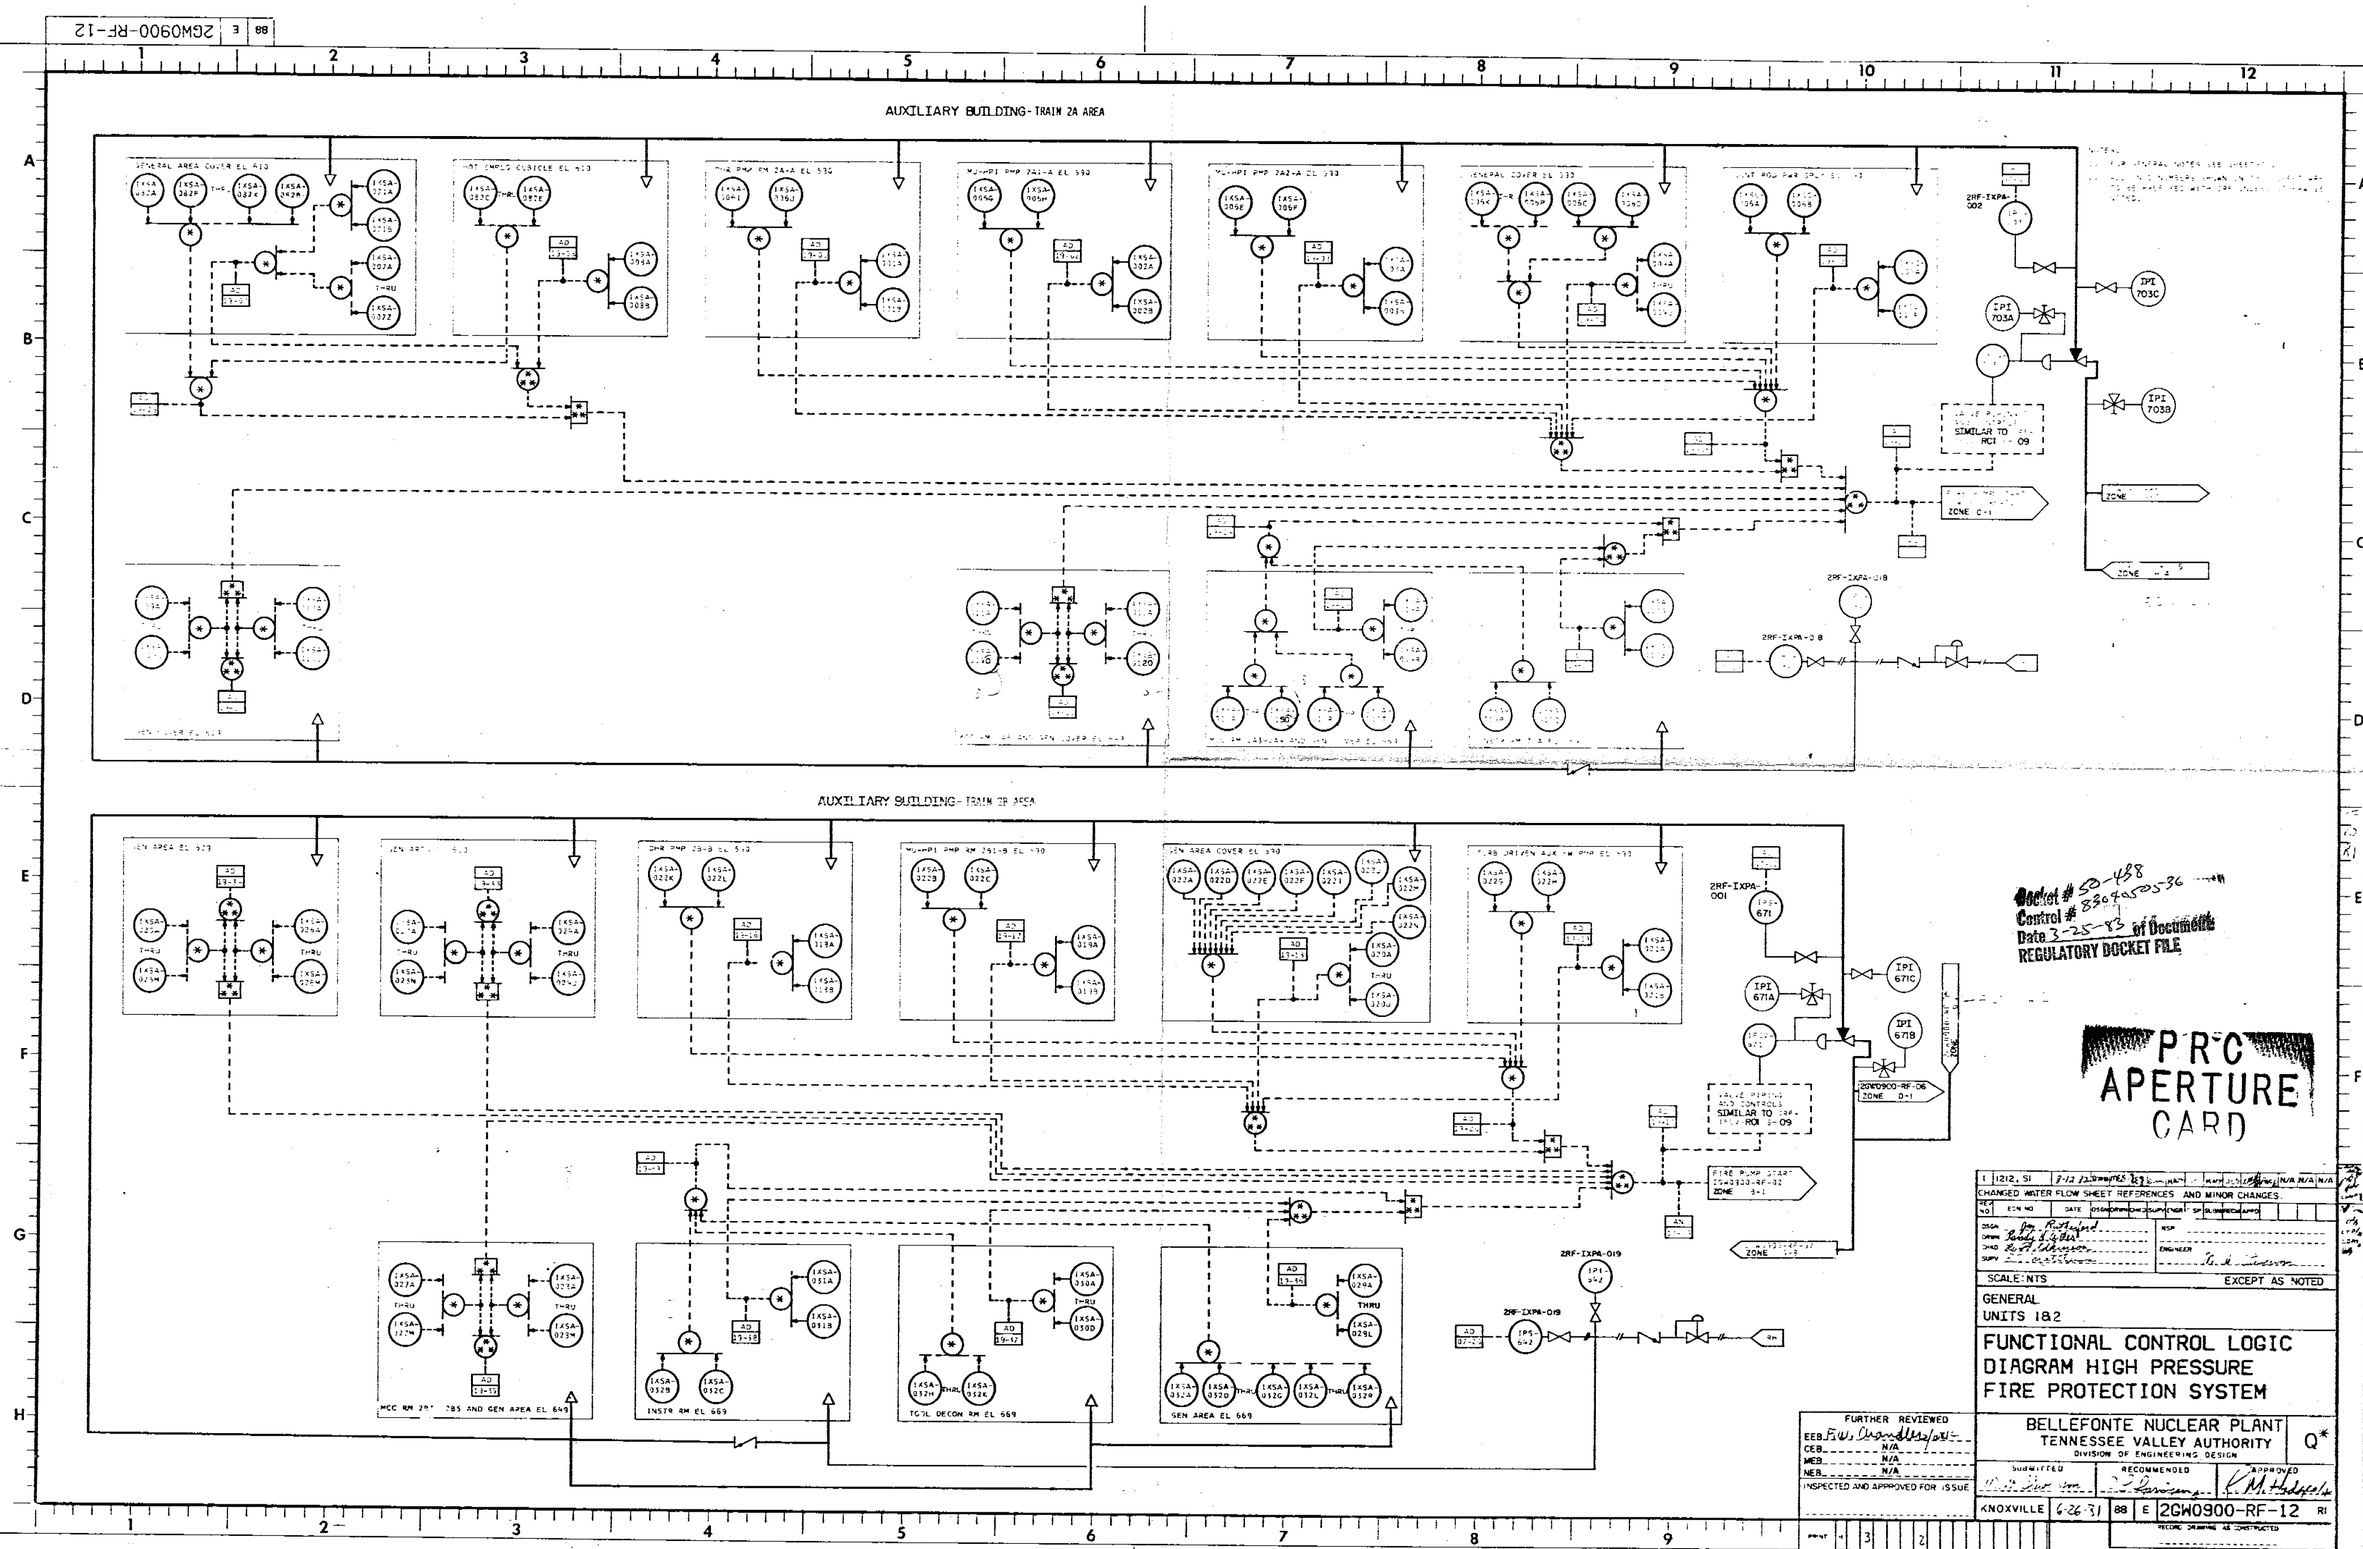

Docket # 50-438
Control # 8304050536
Date 3-25-83 of Document
REGULATORY DOCKET FILE

PRC APERTURE CARD

REV NO	ECN NO	DATE	DSGN	DRWN	CHKD	SUPV	ENGR	SP	SLSM	RECM	APPD
1	1212, SI	7-12-82									N/A N/A N/A

CHANGED WATER FLOW SHEET REFERENCES AND MINOR CHANGES.

DSGN Jon Rutherford
DRWN Randy L. Miller
CHKD R. F. Atkinson
SUPV
MSP
ENGINEER

SCALE: NTS EXCEPT AS NOTED

GENERAL
UNITS 1&2

FUNCTIONAL CONTROL LOGIC DIAGRAM HIGH PRESSURE FIRE PROTECTION SYSTEM

FURTHER REVIEWED
EEB F.W. Chandler
CEB N/A
MEB N/A
NEB N/A
INSPECTED AND APPROVED FOR ISSUE

BELLEFONTE NUCLEAR PLANT
TENNESSEE VALLEY AUTHORITY
DIVISION OF ENGINEERING DESIGN

Q*

SUBMITTED | RECOMMENDED | APPROVED

KNOXVILLE 6-26-81 88 E 2GW0900-RF-12 R1

RECORD DRAWING AS CONSTRUCTED

PRINT 4 3 2