NOTES.
1. FOR GENERAL NOTES SEE SHEET 01.
2. REFER TO DRAWINGS 6OW0634-00-SERIES FOR PLUMBING, ELECTRICAL COMPONENTS AND CONTROL DETAILS.

S1

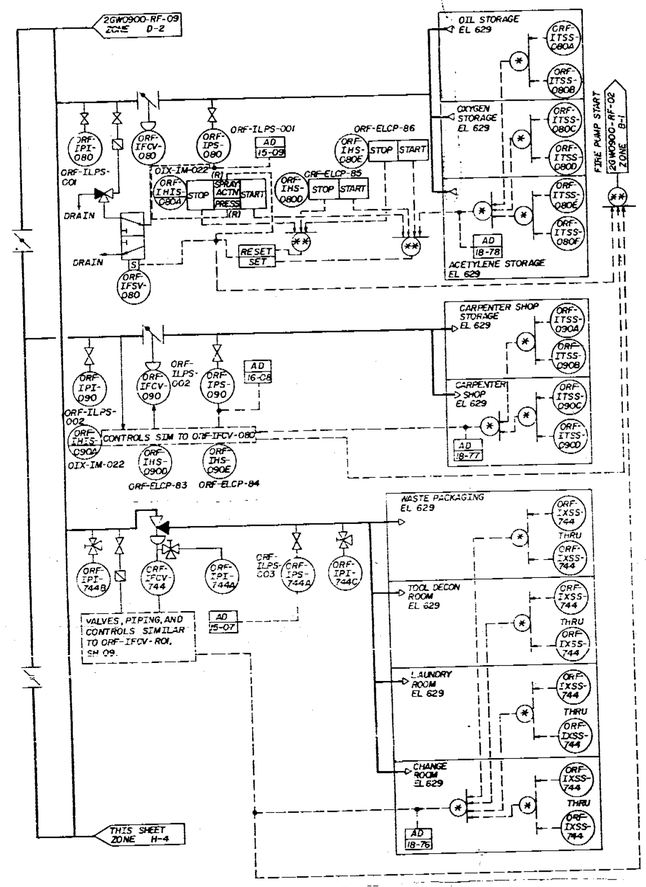

HOLD EL. ECN END: 25 JAN 82

PRC APERTURE CARD

Docket # 50-438
Control # 8304050036
Date 3-25-83 of Document
REGULATORY DOCKET FILE

NO.	ECN NO.	DATE
1	917, 423, S1	1-14-82

REMOVED HOLD FOR OFFICE AND SERVICE BUILDING ADDITION, ADDED AUXILIARY BOILER BLDG & MINOR CHANGES.

DESGN: J. M. Rutherford | DRWN: | CHKD: R. E. Johnson | SUPVR: | ENGR/ER: | HELP:

SCALE: NTS — EXCEPT AS NOTED

GENERAL
UNITS 182

FUNCTIONAL CONTROL LOGIC DIAGRAM HIGH PRESSURE FIRE PROTECTION SYSTEM

FURTHER REVIEWED
EEB: [illegible] 1-25-82
CEB: N/A
MEB: N/A
NEB: N/A
INSPECTED AND APPROVED FOR ISSUE

BELLEFONTE NUCLEAR PLANT
TENNESSEE VALLEY AUTHORITY
DIVISION OF ENGINEERING DESIGN

Q*

SUBMITTED	RECOMMENDED	APPROVED
M. J. Anderson	J. P. Spraker	R. M. Hodges

KNOXVILLE	1-26-81	88	E	2GWO900-RF-14	R1

RECORD DRAWING AS CONSTRUCTED