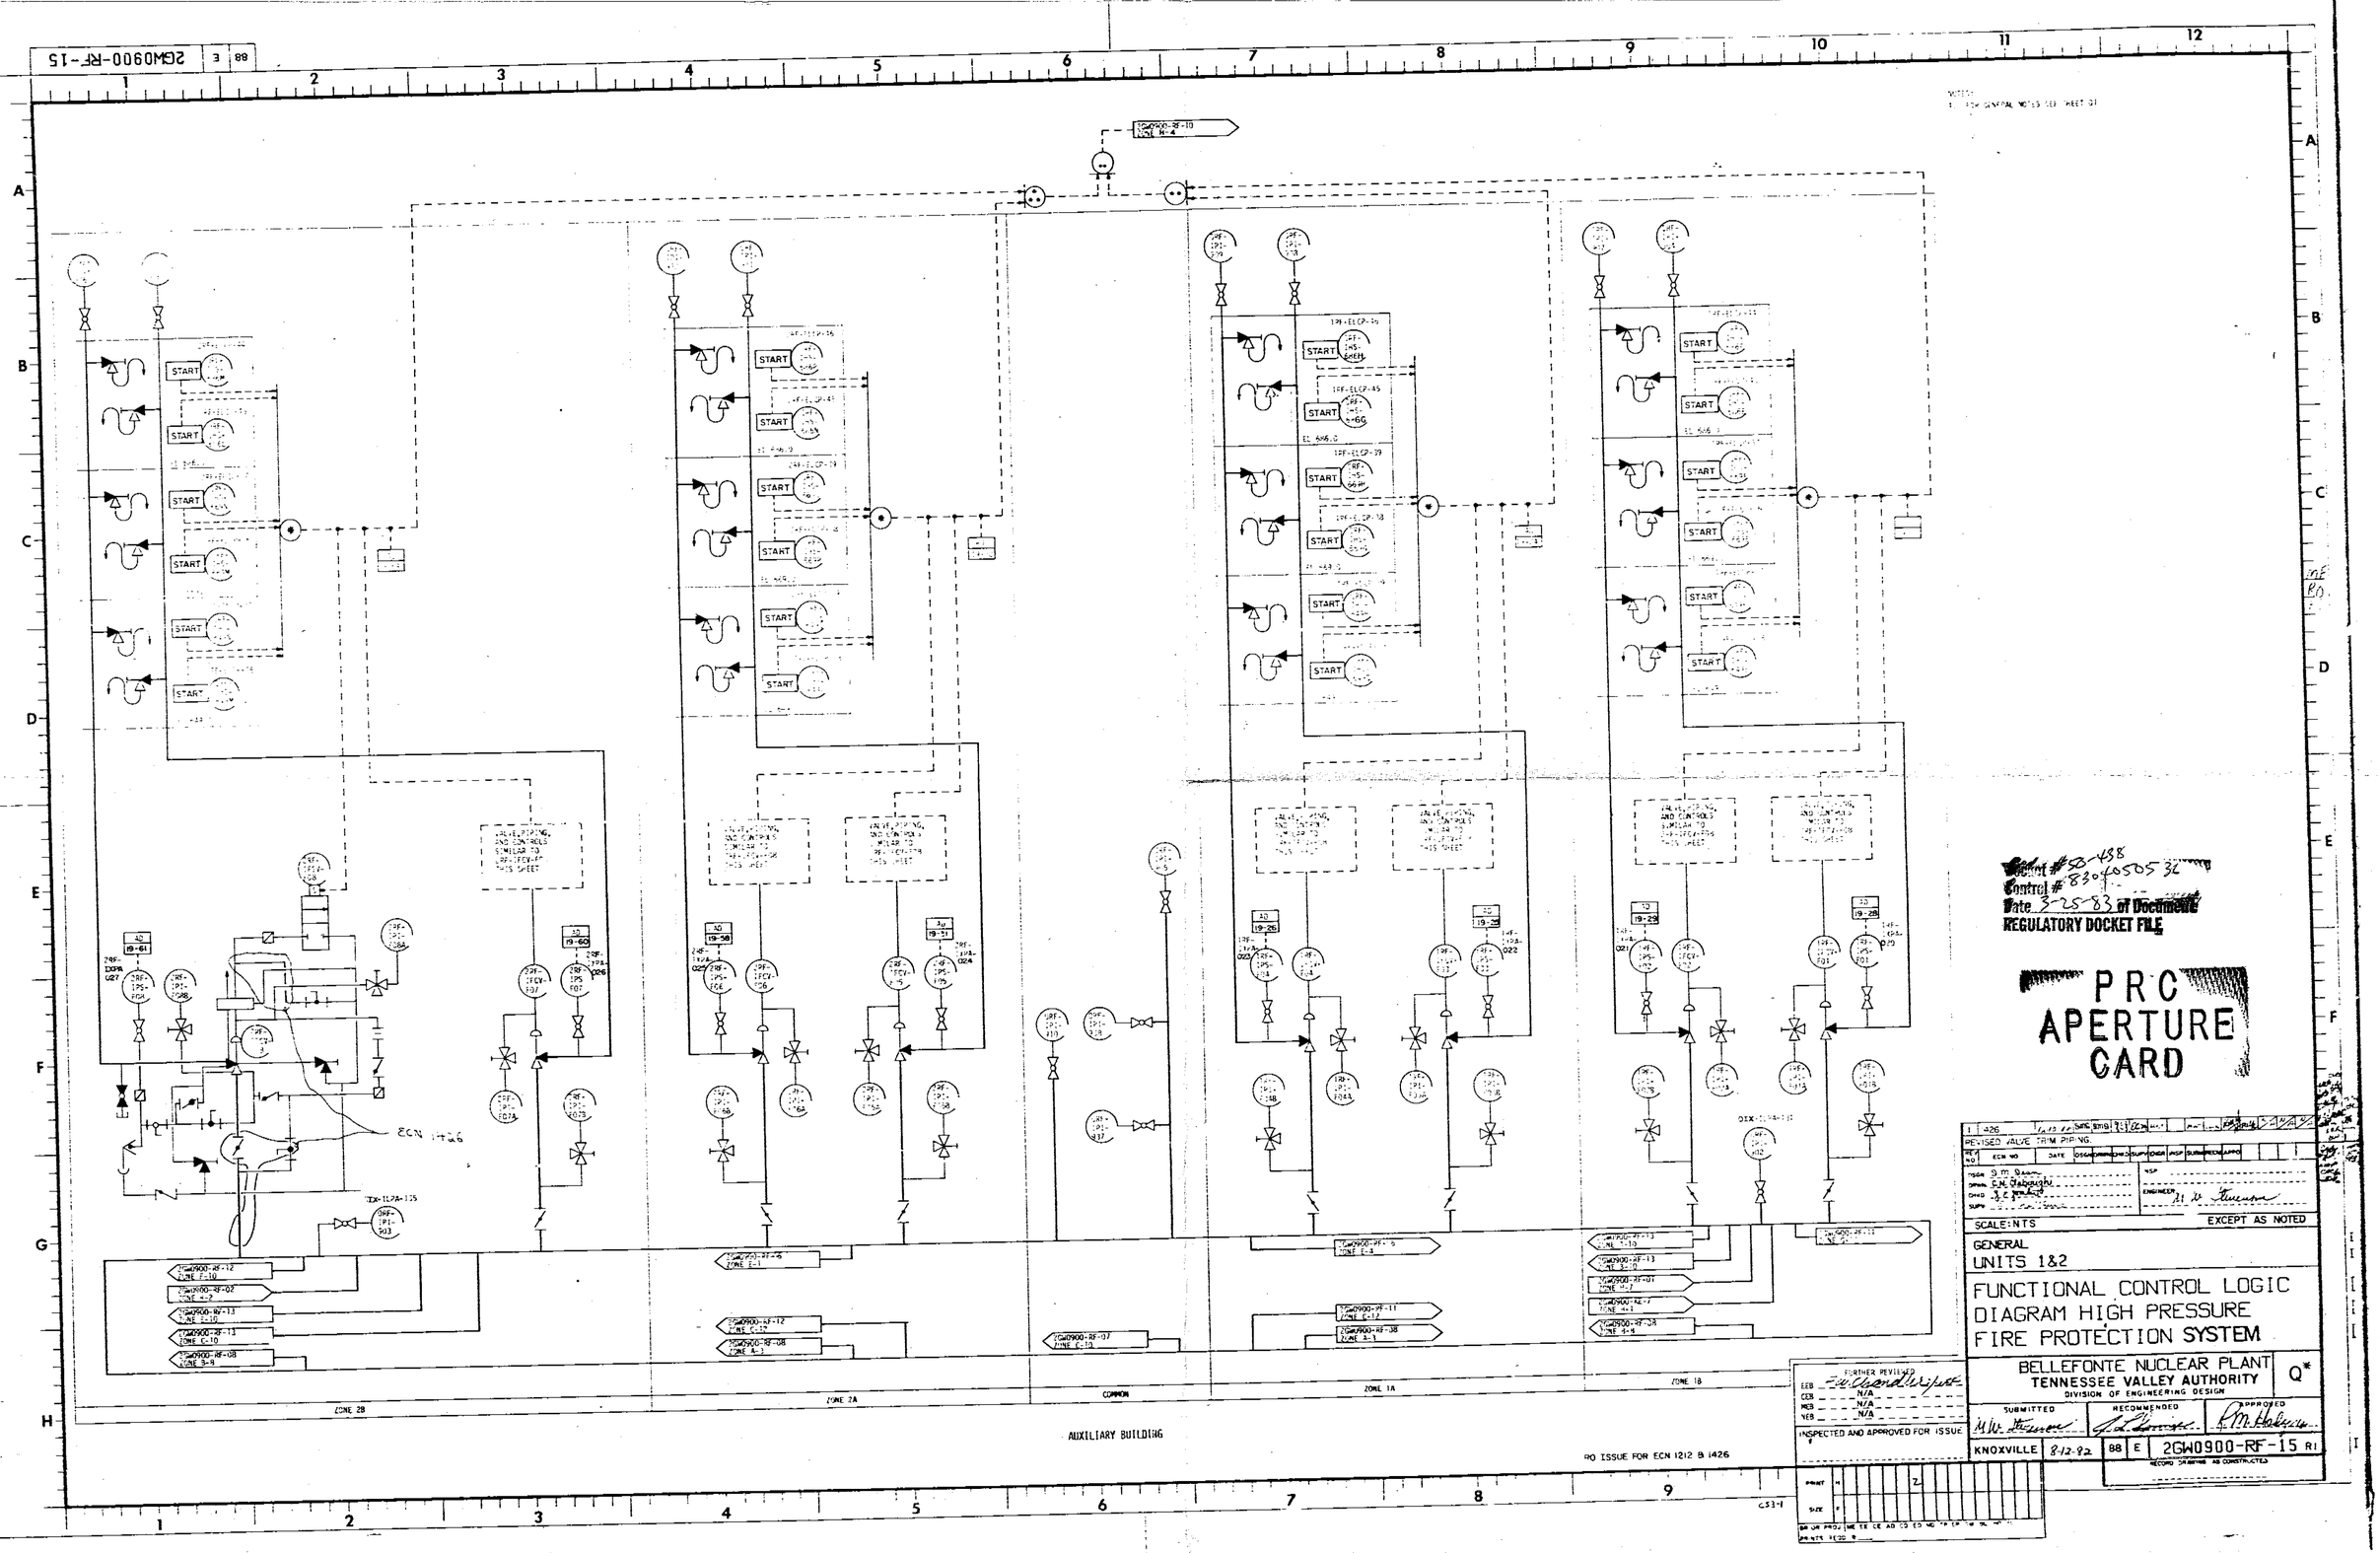

Docket #50-438
Control # 8304050532
Date 3-25-83 of Document
REGULATORY DOCKET FILE

PRC APERTURE CARD

REV NO	ECN NO	DATE	DSGN	DRWN	CHKD	SUPV	ENGR	INSP	SUBMITTED	RECM	APPD
1	1426										

REVISED VALVE TRIM PIPING.

DSGN S.M. Dixon
DRWN C.N. Chabaugh
CHKD
SUPV
NSP
ENGINEER

SCALE: NTS — EXCEPT AS NOTED

GENERAL
UNITS 1&2

FUNCTIONAL CONTROL LOGIC
DIAGRAM HIGH PRESSURE
FIRE PROTECTION SYSTEM

BELLEFONTE NUCLEAR PLANT
TENNESSEE VALLEY AUTHORITY
DIVISION OF ENGINEERING DESIGN

Q*

SUBMITTED — RECOMMENDED — APPROVED

KNOXVILLE 8-12-82 | 88 | E | 2GW0900-RF-15 R1

RECORD DRAWING AS CONSTRUCTED

FURTHER REVIEWED
EEB F.W. Ward Wright
CEB N/A
MEB N/A
VEB N/A

INSPECTED AND APPROVED FOR ISSUE

RO ISSUE FOR ECN 1212 & 1426