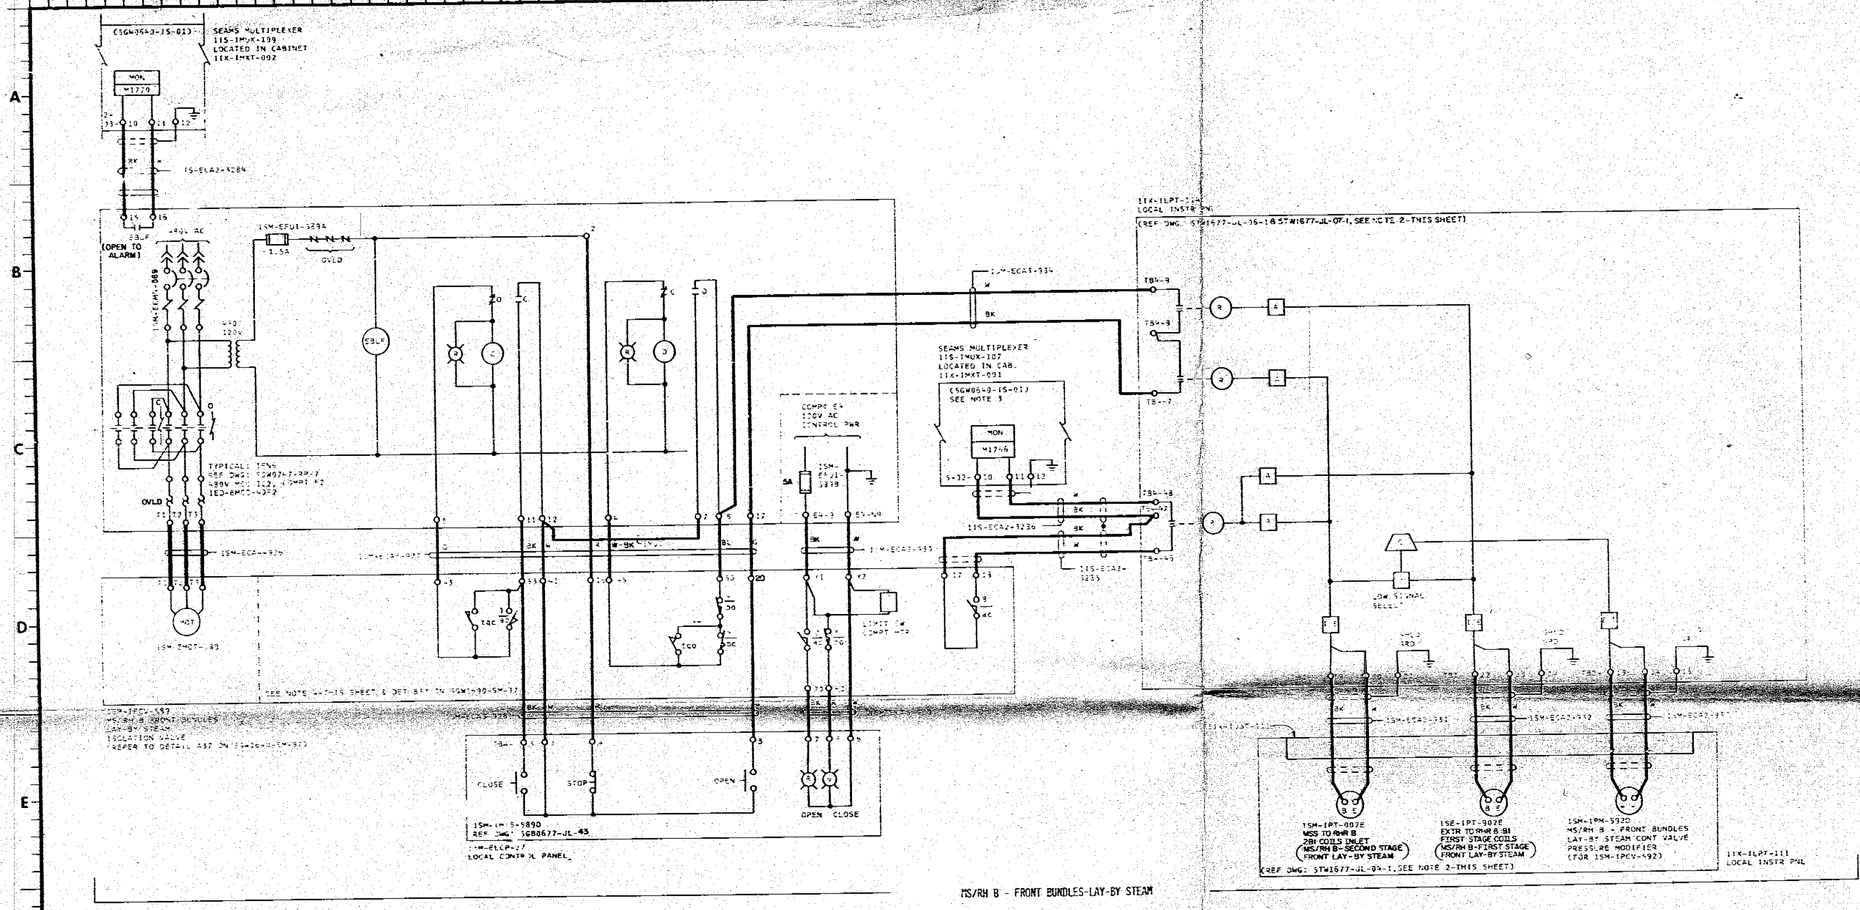

NOTES:

1. FOR GENERAL NOTES, REFERENCE DRAWINGS, AND SYMBOLS SEE SGW1640-SM-01.
2. THIS DRAWING REFERENCE IS FOR THE "AS BUILT" MANUFACTURER'S DRAWING BY YORK ELECTRO-PANEL CONTROL CO., INC. ON CONTRACT 76K3-86743-1 (FILE NO. NAE-23-1).
3. AN ALARM SHALL BE GIVEN FOR HIGH LAY-BY STEAM PRESSURE.
4. REFER TO LIMITORQUE CORPORATION DRAWINGS 03-602-0107-2 AND 15-477-7637-3 ON CONTRACT 76K38-86163-2 (FILE NO. NAM-17-2). ALSO, REFER TO DETAIL B37 ON SGW1640-SM-37. 1SM-IFC-587,-588,-589,-590 HAVE BEEN WIRED BY THE MANUFACTURER PER DRAWING 15-477-7637-3 ON ABOVE REFERENCED CONTRACT. THESE ACTUATORS ARE TO BE RE-WIRED BY TVA PER DETAIL B37 ON SGW1640-SM-37. REFERENCE SHOULD BE MADE TO DRAWING 15-477-7637-3 FOR LIMIT SWITCH CONTACT DEVELOPMENT.

PRC APERTURE CARD

Docket # 50-438
Control # 8306050536
Date 3-25-83 of Document
REGULATORY DOCKET FILE

REV NO	ECN NO.	DATE	DSGN	DRWN	CHKD	SUPV	ENGR	INSP	SUBM	RECM	APPD

DSGN: [signature]
DRWN: [signature]
CHKD: [signature]
SUPV: [signature]
INSP:
ENGINEER: [signature]

SCALE: NTS — EXCEPT AS NOTED

GENERAL
UNIT 1

SCHEMATIC DIAGRAM
MAIN & REHEAT STEAM SYSTEM

BELLEFONTE NUCLEAR PLANT
TENNESSEE VALLEY AUTHORITY
DIVISION OF ENGINEERING DESIGN

N

SUBMITTED	RECOMMENDED	APPROVED
[signature]	[signature]	R. M. Hodgers

KNOXVILLE 7-31-81 — 88 E — SGW1640-SM-39 RD

RECORD DRAWING AS CONSTRUCTED

RD ISSUED FOR ECN 646

INSPECTED AND APPROVED FOR ISSUE

PRINT H
SIZE F
BR DR PROJ ME EE CE AD CD EQ MD SW BL PA
PRINTS REQD-N