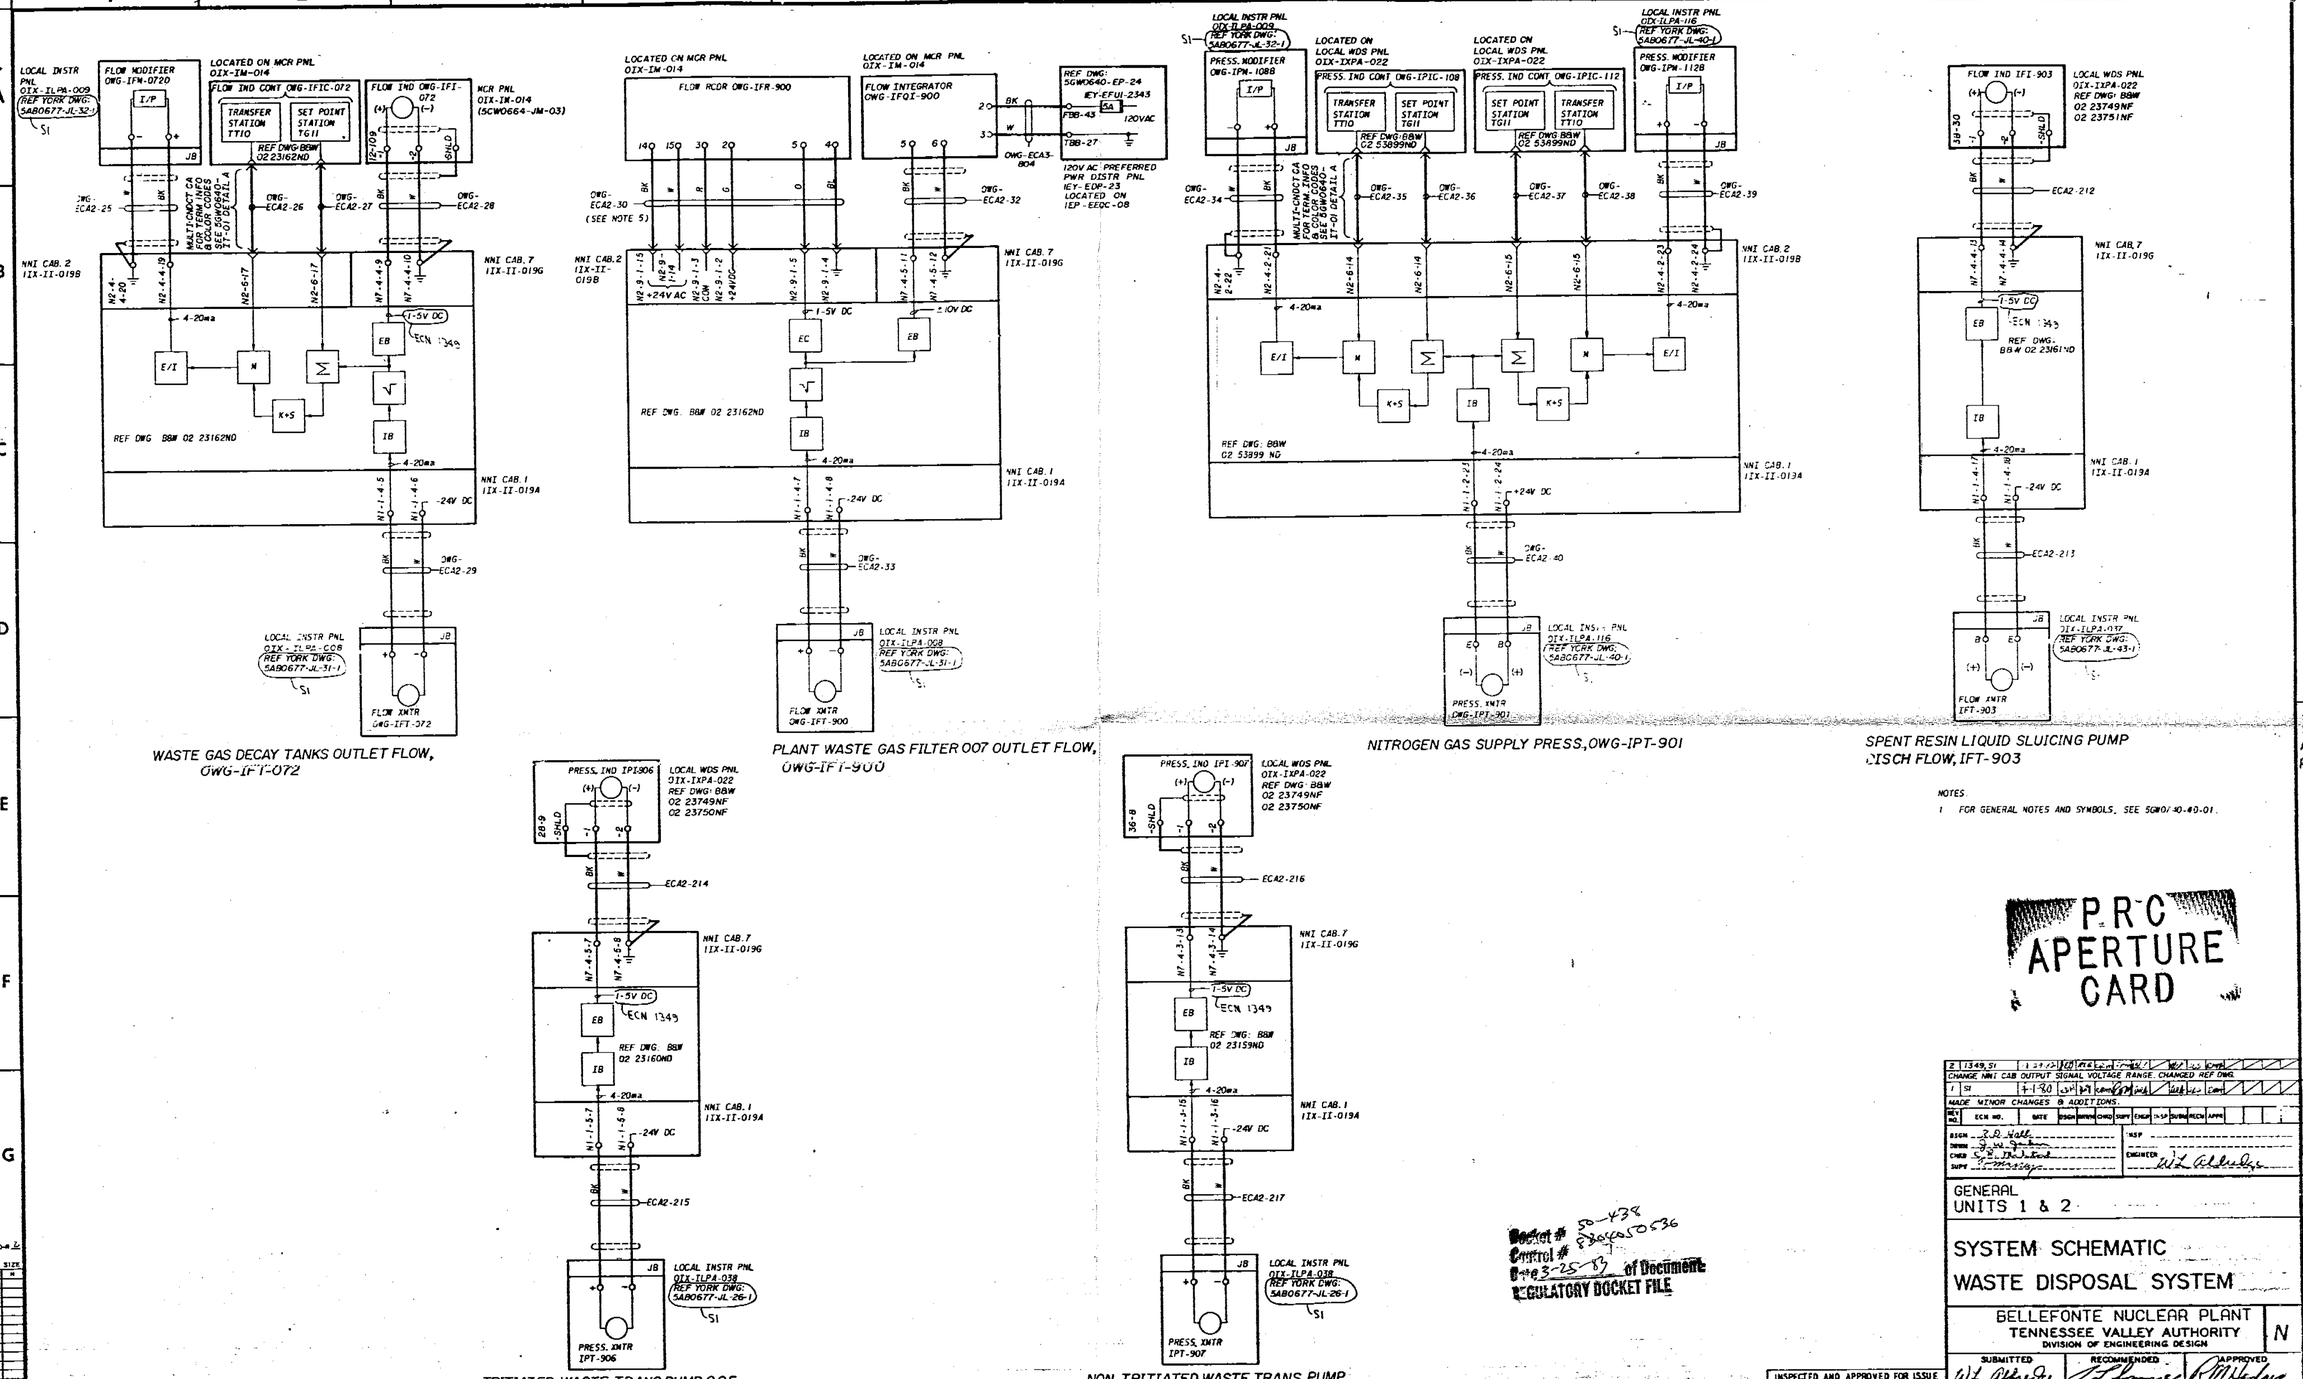

NOTES:

1. FOR GENERAL NOTES AND SYMBOLS, SEE SGW0740-00-01.

PRC APERTURE CARD

REV NO.	ECN NO.	DATE	DSGN	DRWN	CHKD	SUPV	ENGR	N-SP	SUPR	RECN	APPR
2	1349.S1	1-27-83									
CHANGE NNI CAB OUTPUT SIGNAL VOLTAGE RANGE. CHANGED REF DWG.											
1	S1	7-1-80									
MADE MINOR CHANGES & ADDITIONS.											

DSGN W.L. Walk
DRWN
CHKD
SUPV
NSP
ENGINEER W.L. Aldridge

GENERAL
UNITS 1 & 2

SYSTEM SCHEMATIC
WASTE DISPOSAL SYSTEM

BELLEFONTE NUCLEAR PLANT
TENNESSEE VALLEY AUTHORITY
DIVISION OF ENGINEERING DESIGN

N

SUBMITTED W.L. Aldridge | RECOMMENDED | APPROVED R.M. Hedrick

KNOXVILLE 12-15-78 | 88 | E- | SGW0740-WD-18 | R2

RECORD DRAWING AS CONSTRUCTED

INSPECTED AND APPROVED FOR ISSUE

Docket # 50-438
Control # 8304050536
Date 03-25-83
of Documents
REGULATORY DOCKET FILE

PRINTS REQD-R 2
BK W
PROJ OWG SIZE
F H
ME
EE
CE
AD
CO
ED
MD
SF
SW
BL
PA