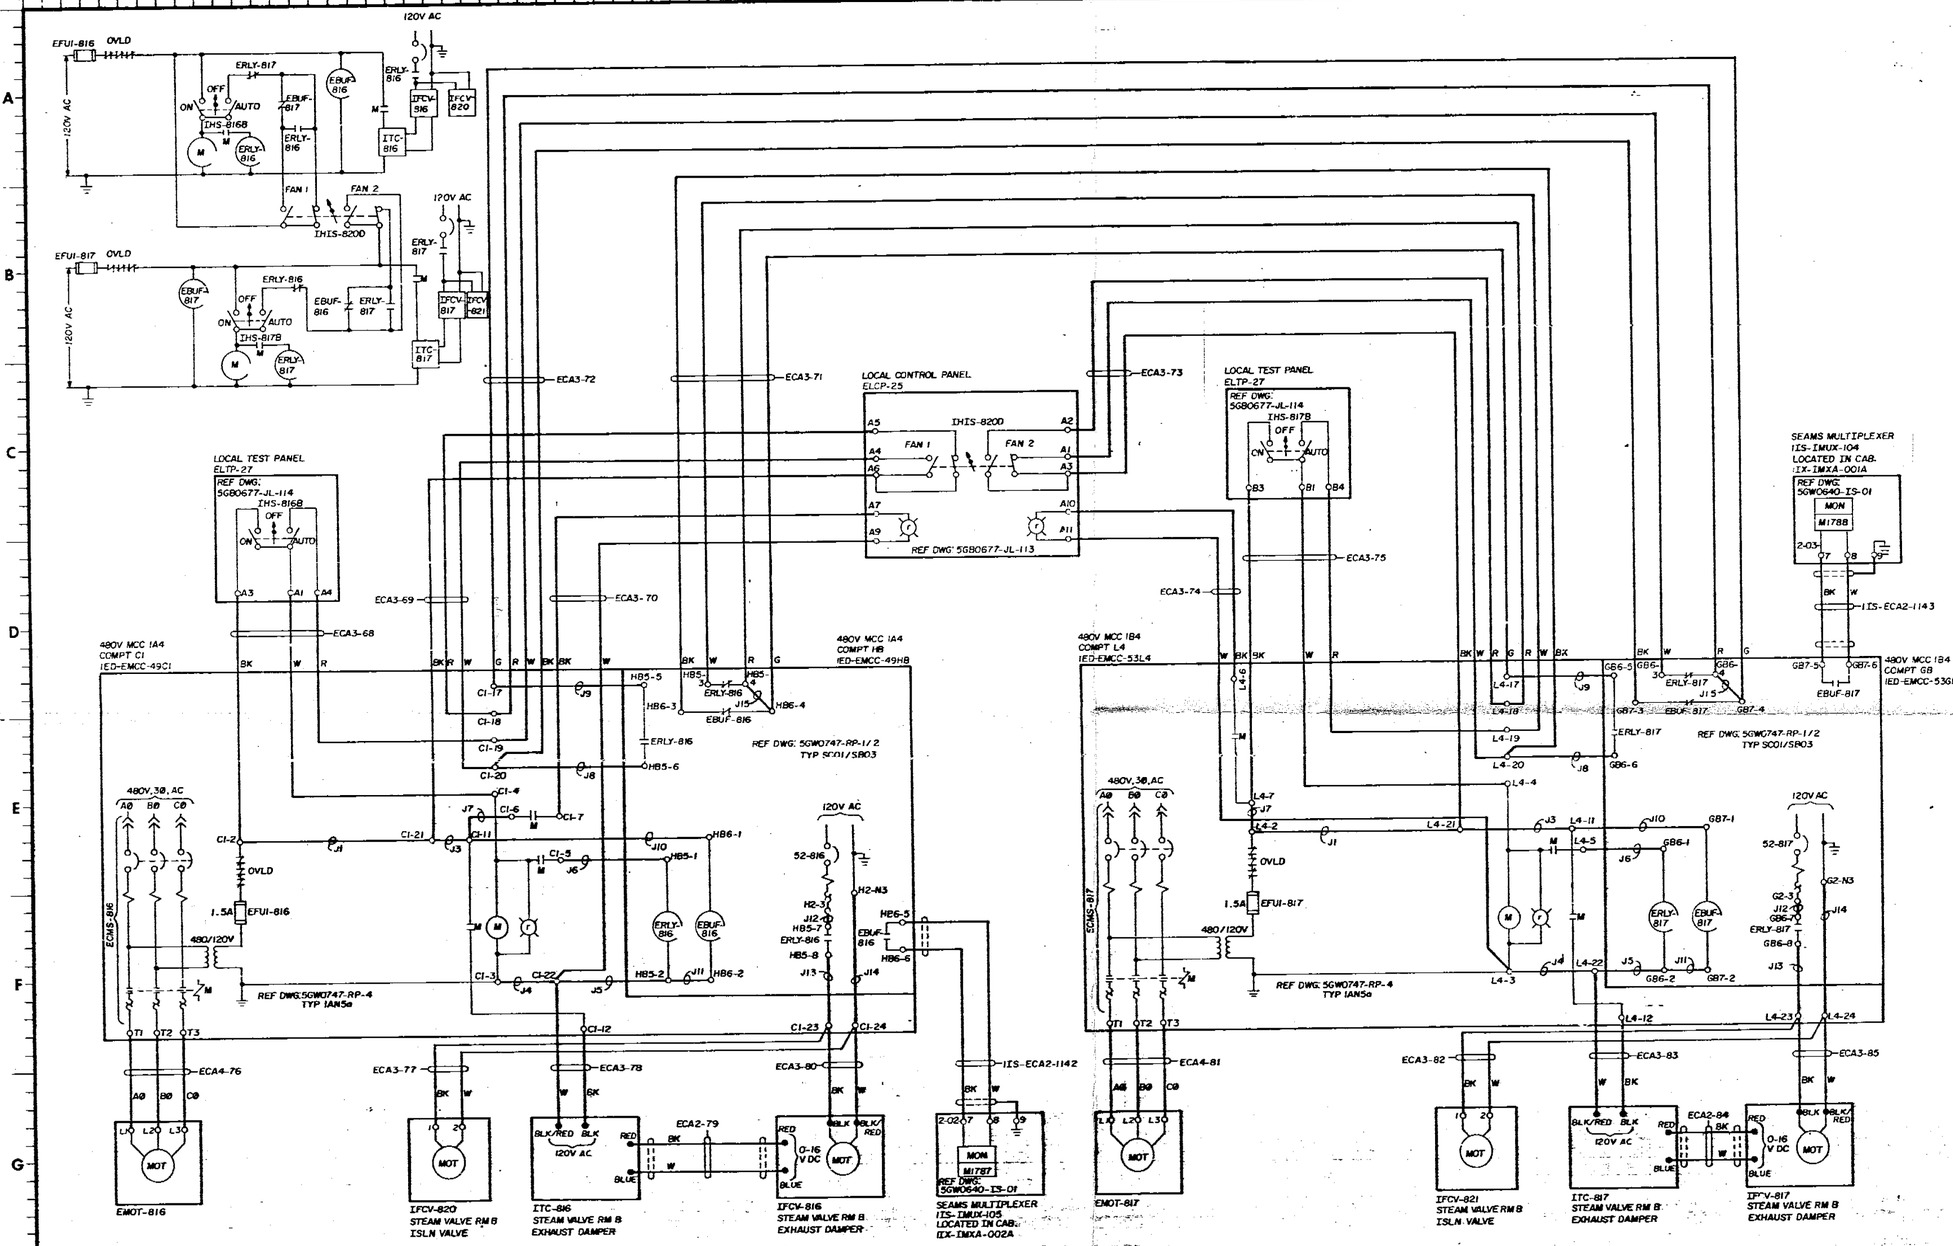

NOTES:

1. FOR GENERAL NOTES AND SYMBOLS SEE SHEET 01.
2. ALL UNID'S SHOWN ON THIS SHEET ARE PRECEDED BY IVC UNLESS OTHERWISE NOTED.

STEAM VALVE ROOM B EXHAUST FANS
MFAN-816 & MFAN-817

RO ISSUE FOR ECN 899 & 1185

Docket # 50-438
Docket # 50-439
3-25-83
of Documents
REGULATORY DOCKET FILE

PRC
APERTURE
CARD

REV NO	ECN NO.	DATE	DSGN	DRWN	CHKD	SUPV	CONC	MSP	SUBM	APPD

DSGN J. W. Pfeifer
DRWN
CHKD
SUPV
MSP
ENGINEER H. C. Rutledge Jr.

SCALE: EXCEPT AS NOTED

GENERAL
UNITS 1 & 2

SYSTEM SCHEMATIC
AUX BLDG COMMON AREA
ENVIRONMENTAL CONTROL SYS

BELLEFONTE NUCLEAR PLANT
TENNESSEE VALLEY AUTHORITY
DIVISION OF ENGINEERING DESIGN

N

SUBMITTED H. C. Rutledge Jr.
RECOMMENDED
APPROVED R. M. Phelps

KNOXVILLE 8-19-82 88 E 5GW0740-VC-18 RO

RECORD DRAWING AS CONSTRUCTED

INSPECTED AND APPROVED FOR ISSUE

PRINT
SIZE

BR OR PROJ | ME | EE | CE | AC | CD | ED | MD | TP | EP | SW | SL | NP | TC

PRINTS REQD - R

JAMES RIVER GRAPHICS
BHLF-4-8823