NOTES:
FOR GENERAL NOTES AND REFERENCE DRAWINGS SEE 5GW2740-EG-01.

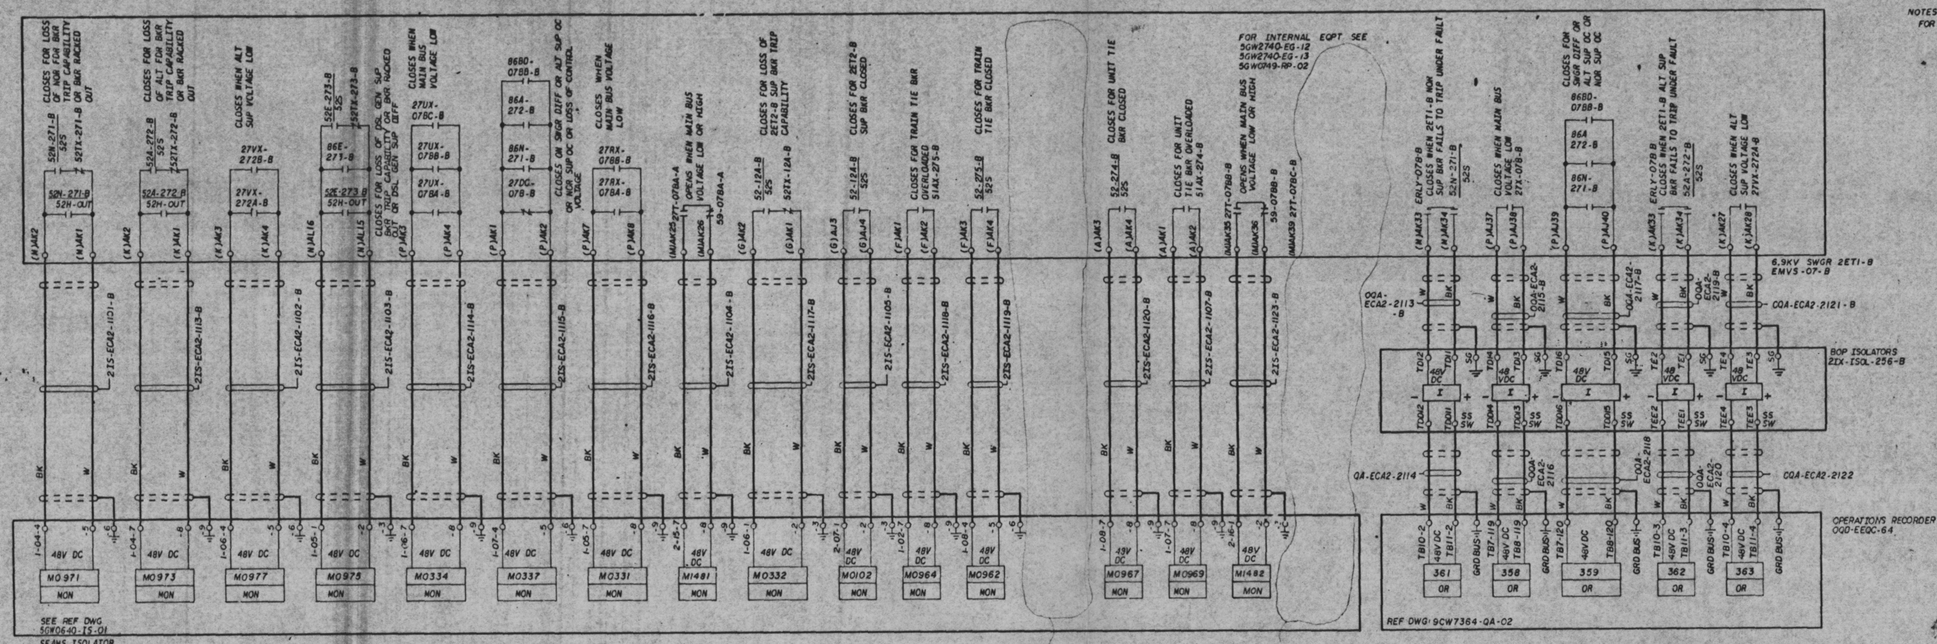

6.9KV SWITCHGEAR 2ETI-B, 2EG-EMVS-07-B, MONITORING

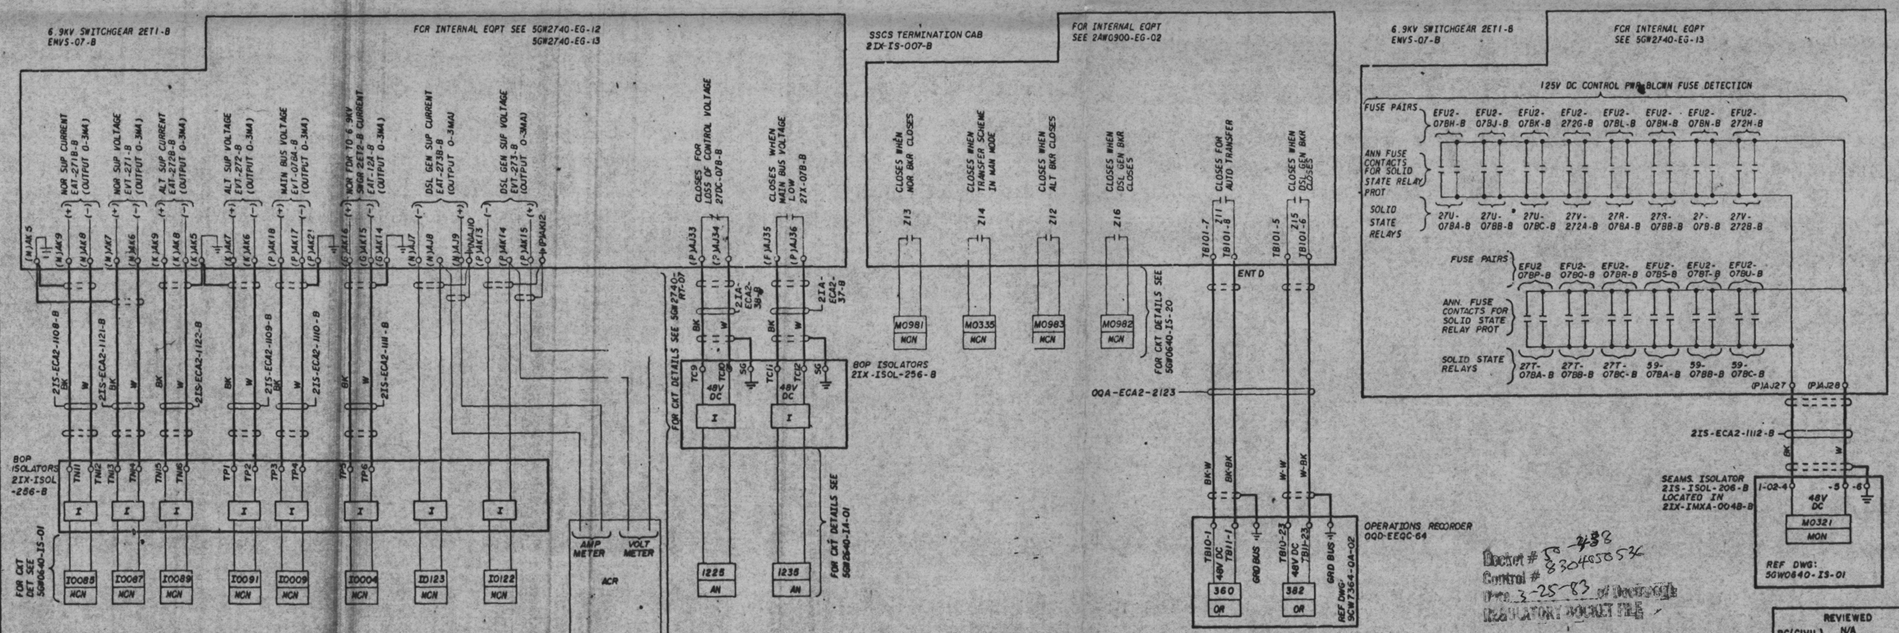

6.9KV SWITCHGEAR 2ETI-B, 2EG-EMVS-07-B, MONITORING

PRC APERTURE CARD

REV NO	ECN NO	DATE	DSGN	DFTMN	CHKD	SUPV	ENGR	INSP	SUPIN	ENGIN	APPR	RC	RC	RN	RN
3	1146,51	5-7-81													
2	773	11-14-79													
1	467,51	1-6-79													

3 — DELETED SEAMS MONITOTING POINTS.
2 — CHANGED 628F CONTACT TO EMLY CONTACT & ADDED 525 AUX CONTACT.
1 — INCORPORATED THE NEW AND MODIFIED DESIGN REQUIREMENTS FOR BUS TRANSFERS AND VOLTAGE ANN. POINTS. ADDED BOP ISOLATOR TERMINAL POINTS AND SIGNAL POINTS.

DSGN T.C. Hill
DFTMN
CHKD
SUPV
INSP
ENGINEER W.L. Aldridge

SCALE EXCEPT AS NOTED

GENERAL
UNIT 2

SYSTEM SCHEMATIC
6.9KV CLASS 1E AC AUX PWR DISTRIBUTION SYSTEM

BELLEFONTE NUCLEAR PLANT
TENNESSEE VALLEY AUTHORITY
DIVISION OF ENGINEERING DESIGN

Q

SUBMITTED W.L. Aldridge
RECOMMENDED L.L. Spangler
APPROVED R.M. Hodges

KNOXVILLE 1/10/77

88 E 5GW2740-EG-09 R3

RECORD DRAWING AS CONSTRUCTED

REVIEWED
RC(CIVIL) N/A
RE(ELEC) F.E. Wendel
RM(MECH) N/A

Docket # 50-438
Control # 8304050534
Date 3-25-83
REGULATORY DOCKET FILE

PRINT
SIZE