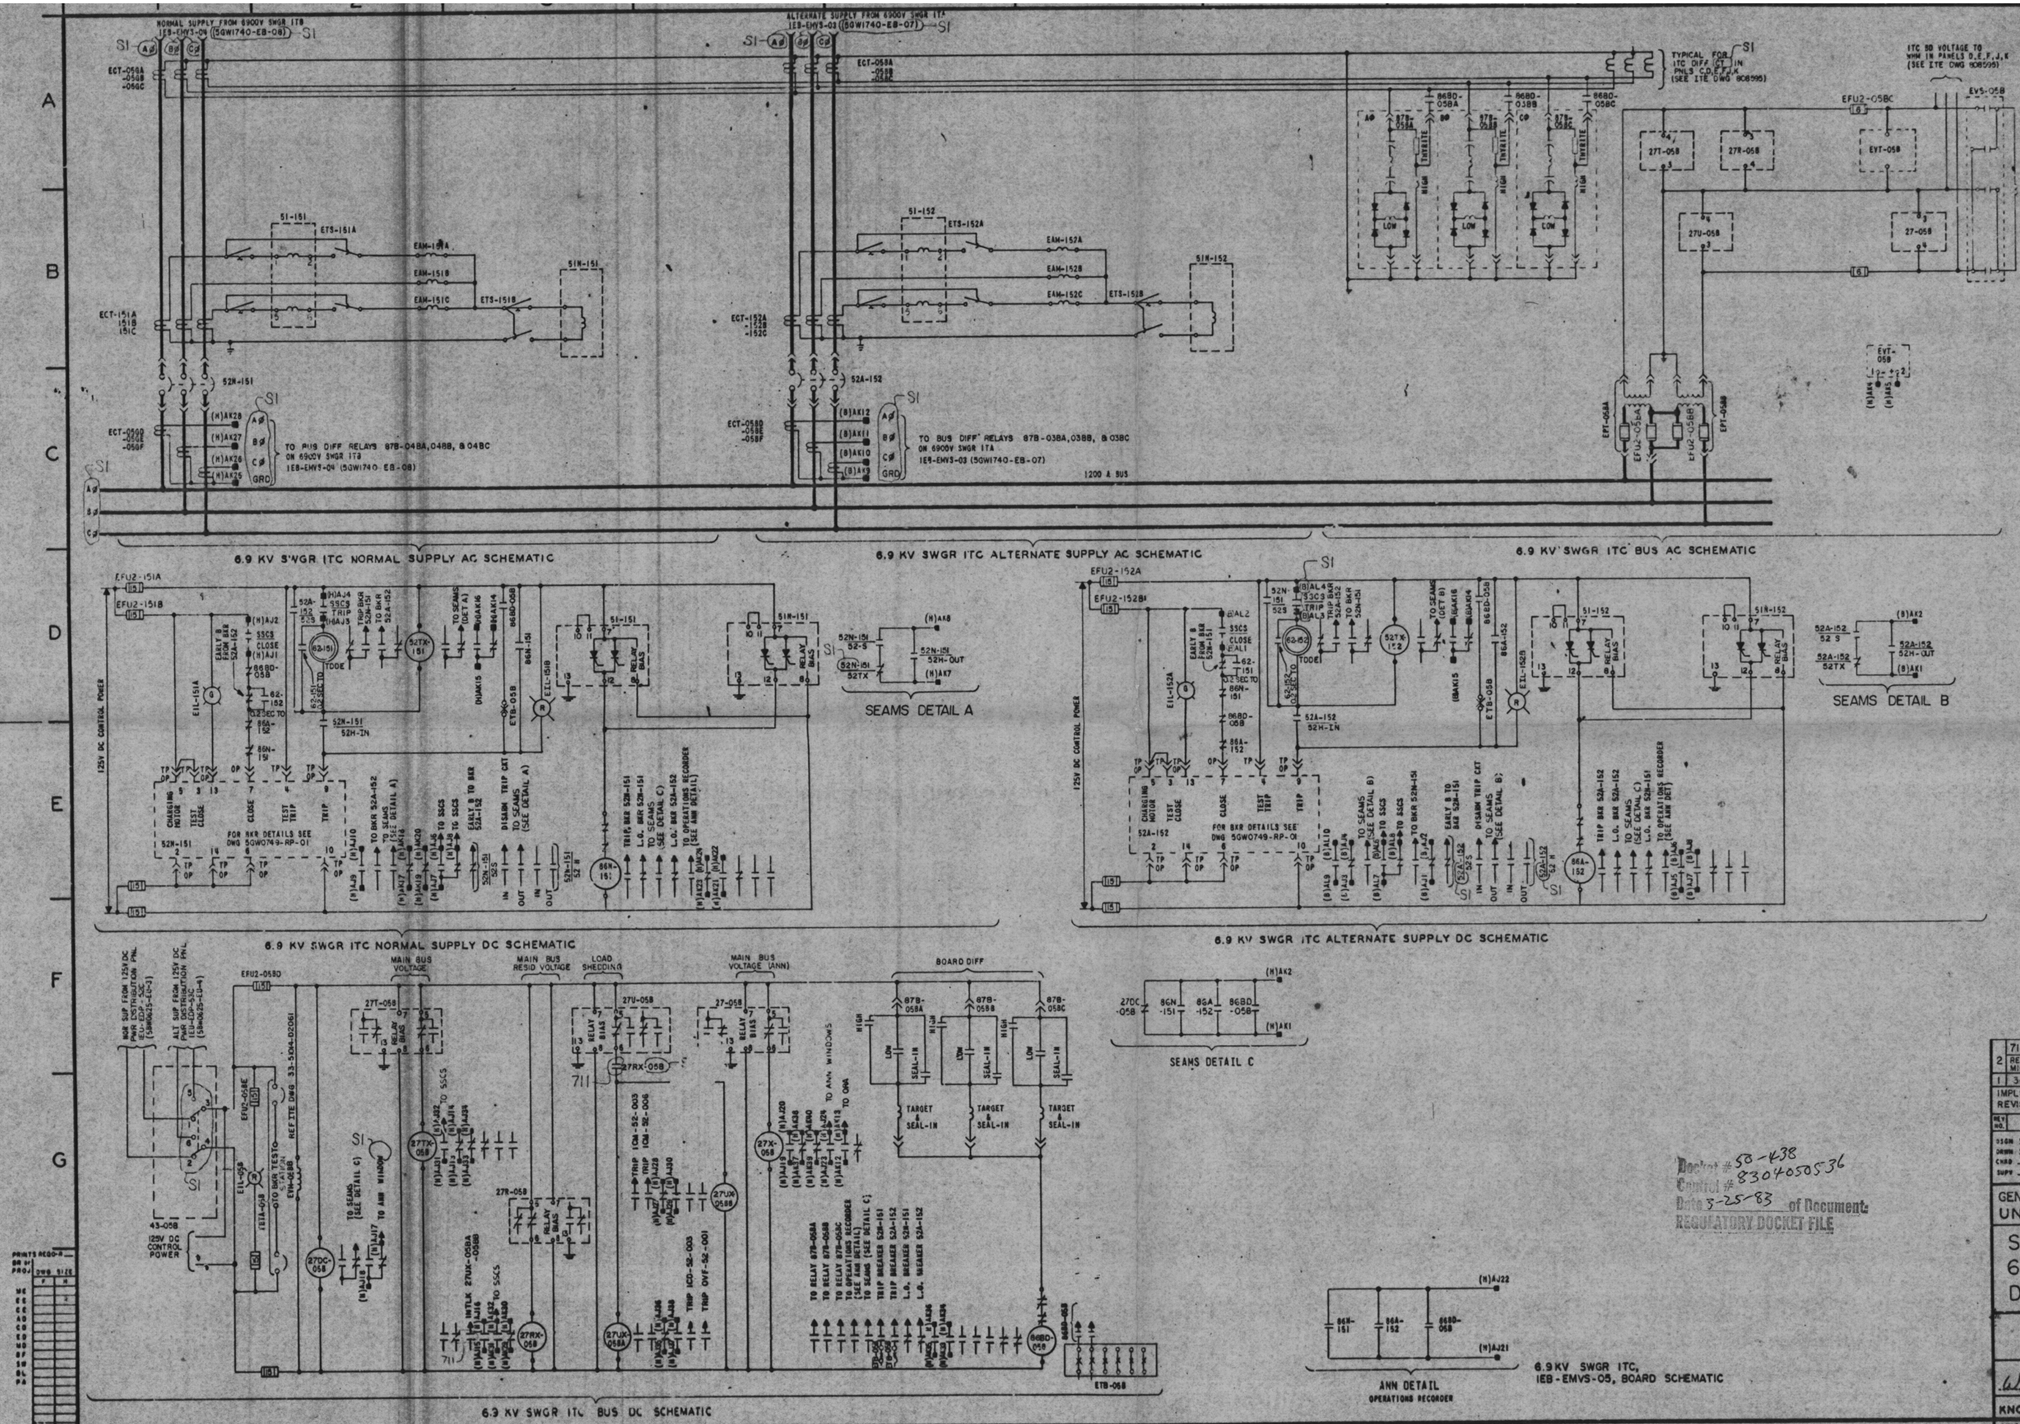

NOTES:
1. FOR GENERAL NOTES AND REFERENCE DRAWINGS SEE 5GW1740-EB-01.
2. FOR EXTERNAL CABLING DIAGRAM SEE SYSTEM SCHEMATIC 5GW1740-EB-04 & 06.

SYMBOLS:
FOR GENERAL SYMBOLS SEE 5GW1740-EB-01.

■ SWGR INTERFACE

PRC APERTURE CARD

Docket # 50-438
Control # 8304050536
Date 3-25-83 of Document
REGULATORY DOCKET FILE

REV NO.	ECN NO.	DATE	DSGN	DRWN	CHKD	SUPV	ENGR	INSP	DUBL	RECD	APPR
2	711, S1	9-12-79	[illegible]	[illegible]	[illegible]	[illegible]	[illegible]	[illegible]	[illegible]	[illegible]	[illegible]
2	REVISED LOAD SHEDDING CIRCUIT BY USING A NORMALLY OPEN 27RX CONTACT. MINOR CHANGES.										
1	341, S1	6-12-79	[illegible]	[illegible]	[illegible]	[illegible]	[illegible]	[illegible]	[illegible]	[illegible]	[illegible]
1	IMPLEMENTED ANTICIPATORY RELAY SCHEME PER ECN 341. MADE MINOR REVISIONS PER S1.										

DSGN J.E. GILLIAN
DRWN J.W. JACKSON
CHKD D.M. LASHLEY
SUPV R.O. MASSKE
INSP
ENGINEER W.R. Aldredge

GENERAL
UNIT 1

SYSTEM SCHEMATIC
6.9KV NORMAL AC AUX POWER
DISTRIBUTION SYSTEM

BELLEFONTE NUCLEAR PLANT
TENNESSEE VALLEY AUTHORITY
DIVISION OF ENGINEERING DESIGN

N

SUBMITTED	RECOMMENDED	APPROVED
W.R. Aldredge	[illegible]	[illegible]

KNOXVILLE 10-14-77 | 88 | E | 5GW1740-EB-09 R2

ORIGINAL DRAWING NO. 5TW1745-EB-03

RECORD DRAWING AS CONSTRUCTED