NOTES:
1. FOR GENERAL NOTES AND SYMBOLS SEE DWG 5GW2740-ED-01.

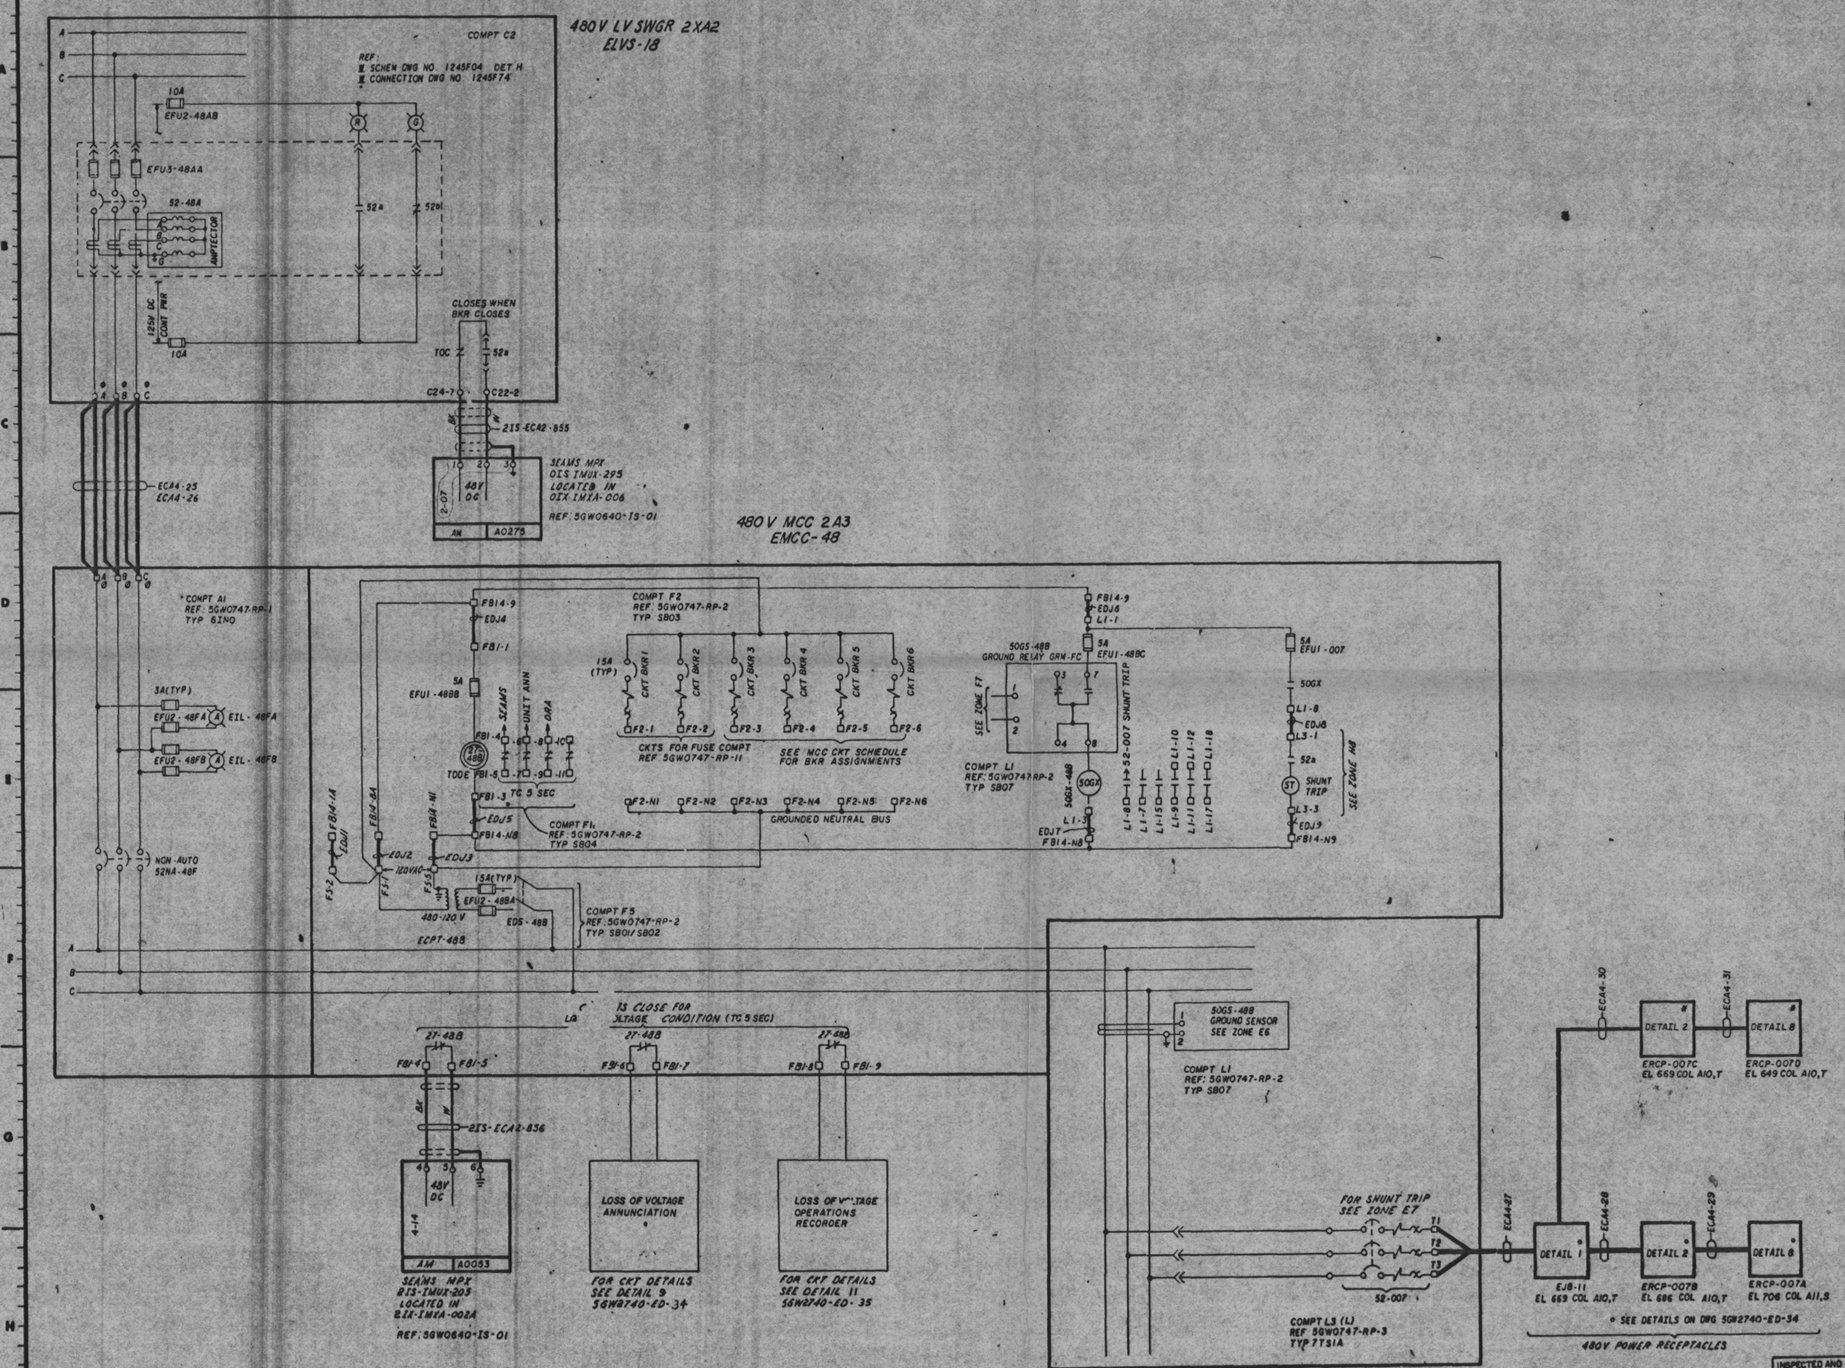

Docket # 50-438
Control # 8304050536
Date 3-25-83
Regulatory Docket File

PRC APERTURE CARD

REV NO	ECN NO	DATE	DRAWN	DWN	CHKD	SUPV	ENGR	INSP	SUPR	RECD	APPD
1	836	1-12-83	RSM	13.5	RJ	JF	14	-	6W	JS	KMS

RELOCATED SEAMS POINT A0275

DRAWN: [illegible]
CHKD: [illegible]
SUPV: [illegible]
INSP:
ENGINEER: W.L. Alinsky

SCALE: EXCEPT AS NOTED

GENERAL
UNIT 2

SYSTEM SCHEMATIC
480V NORMAL AC
AUX POWER DISTRIBUTION SYSTEM

BELLEFONTE NUCLEAR PLANT
TENNESSEE VALLEY AUTHORITY
DIVISION OF ENGINEERING DESIGN

N

SUBMITTED	RECOMMENDED	APPROVED
W.L. Alinsky	[illegible]	R.M. Dodson

KNOXVILLE | 12-12-78 | 88 | E | 5GW2740-ED-20 | R1

RECORD DRAWING AS CONSTRUCTED

INSPECTED AND APPROVED FOR ISSUE