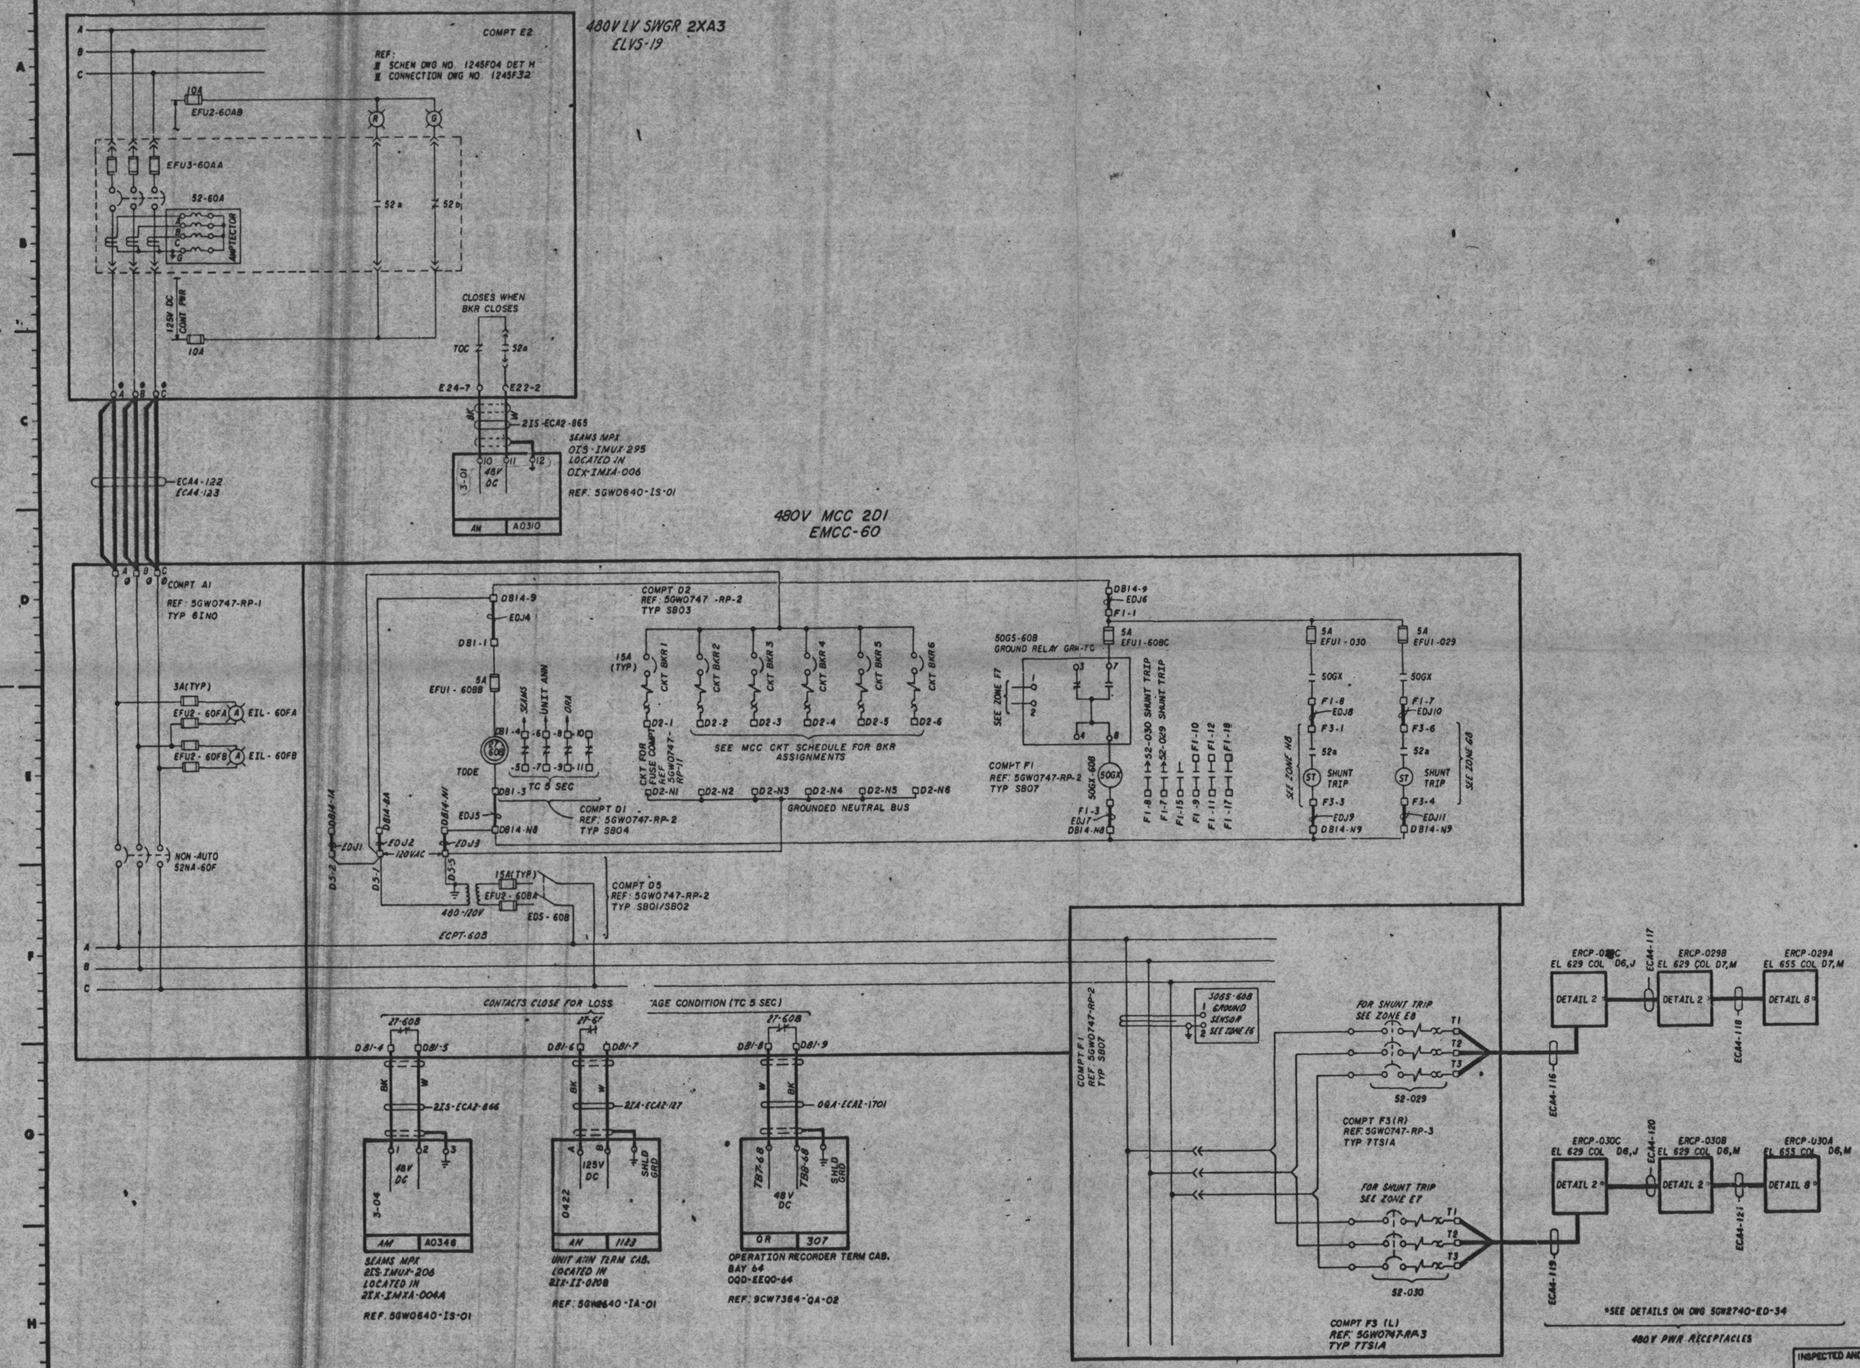

NOTES:
1. FOR GENERAL NOTES AND SYMBOLS SEE DWG 5GW2740-ED-01.

Docket # 50-438
Control # 830405034
Date 3-25-83 of Document
REGULATORY DOCKET FILE

PRC APERTURE CARD

REV NO	ECN NO	DATE	DSGN	DRWN	CHKD	SUPV	ENGR	INSP	SUBM	RECM	APPD
2	856	1-15-80									
1	SI	8-24-79									

RELOCATED SEAMS POINT A0310
CHANGE ROUTING OF CABLE NO. 116 & 119

DSGN R.B. Gallagher
DRWN
CHKD
SUPV W.L. Sotrow
INSP
ENGINEER W.L. Aldredge

SCALE: EXCEPT AS NOTED

GENERAL
UNIT 2

SYSTEM SCHEMATIC
480V NORMAL AC
AUX POWER DISTRIBUTION SYSTEM

BELLEFONTE NUCLEAR PLANT
TENNESSEE VALLEY AUTHORITY
DIVISION OF ENGINEERING DESIGN

N

SUBMITTED W.L. Aldredge
RECOMMENDED
APPROVED R.M. Hodges

KNOXVILLE 12-14-78 88 E 5GW2740-ED-25 R2

RECORD DRAWING AS CONSTRUCTED

INSPECTED AND APPROVED FOR ISSUE

88 E 5GW2740-ED-25