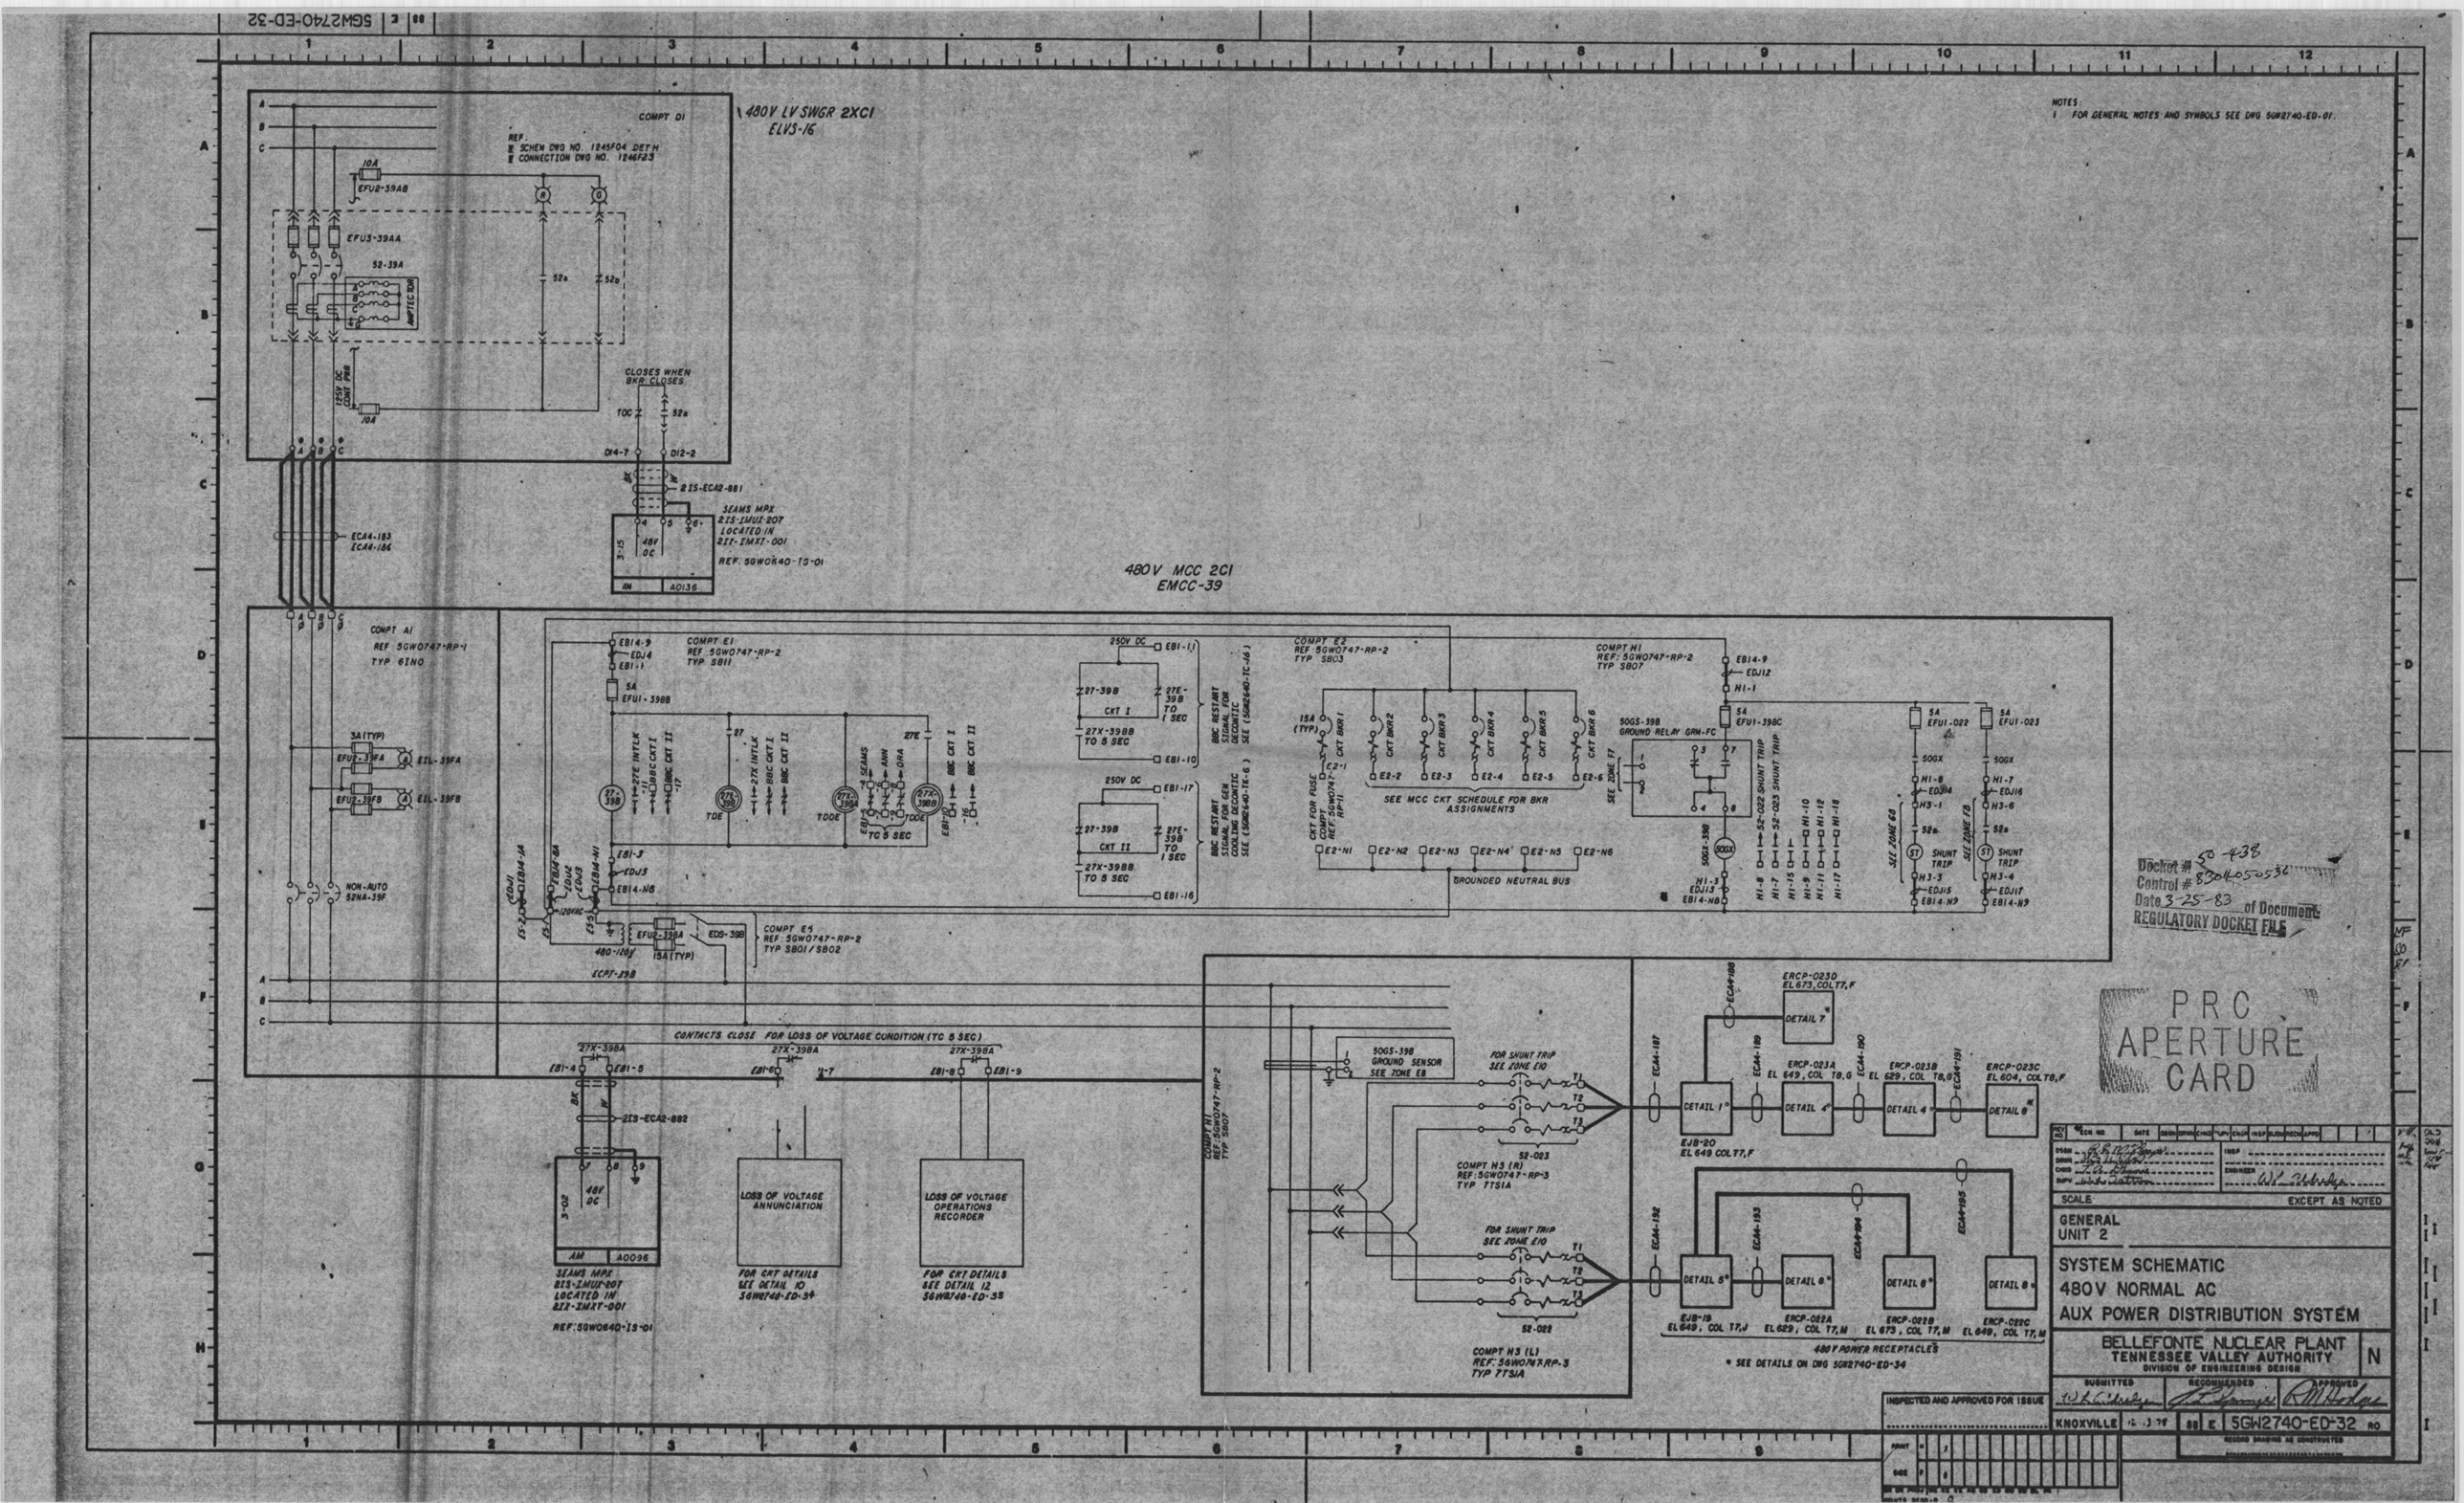

Docket # 50-438
Control # 8304050536
Date 3-25-83 of Document
REGULATORY DOCKET FILE

PRC APERTURE CARD

SCALE EXCEPT AS NOTED

GENERAL
UNIT 2

SYSTEM SCHEMATIC
480V NORMAL AC
AUX POWER DISTRIBUTION SYSTEM

BELLEFONTE NUCLEAR PLANT
TENNESSEE VALLEY AUTHORITY
DIVISION OF ENGINEERING DESIGN

N

SUBMITTED | RECOMMENDED | APPROVED

KNOXVILLE

88 E 5GW2740-ED-32 R0

RECORD DRAWING AS CONSTRUCTED

INSPECTED AND APPROVED FOR ISSUE