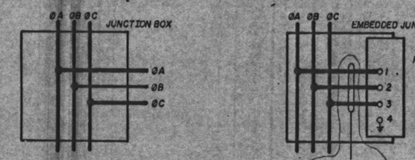

DETAIL 1

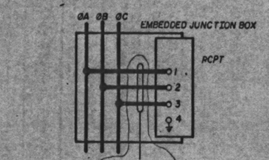

DETAIL 2

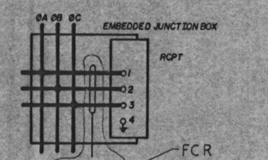

DETAIL 3

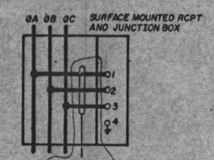

DETAIL 4

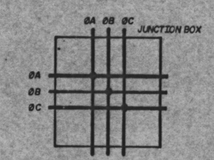

DETAIL 5

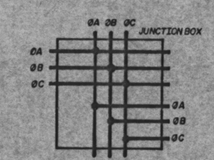

DETAIL 6

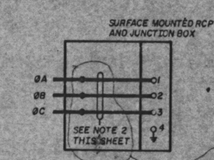

DETAIL 7

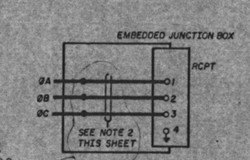

DETAIL 8

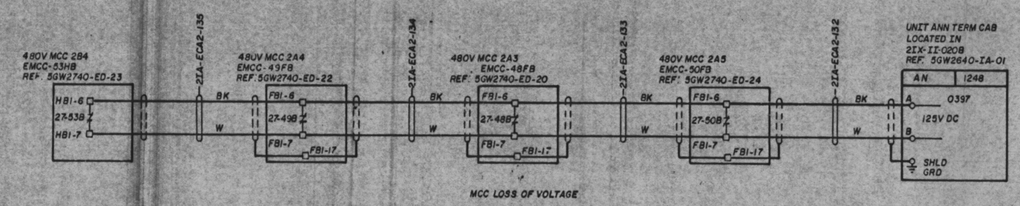

MCC LOSS OF VOLTAGE

DETAIL 9

FCR E-1928

NOTES:
1. FOR GENERAL NOTES AND SYMBOLS SEE 5GW2740-ED-01
2. 60 AMP POWER RECEPTACLE CONNECTOR PIGTAILS MAY BE REDUCED TO A MINIMUM OF 4 AWG IF REQUIRED.

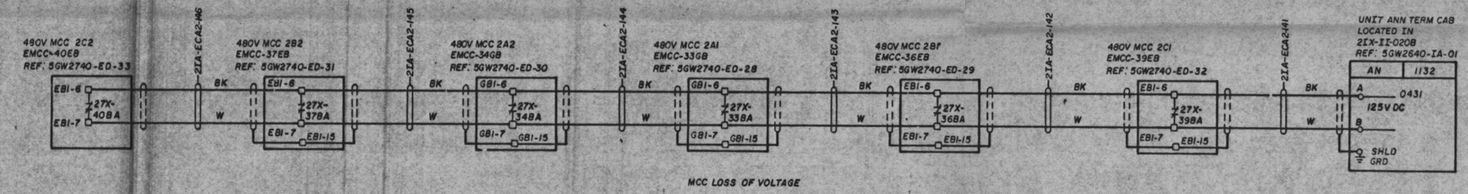

MCC LOSS OF VOLTAGE

DETAIL 10

PRC APERTURE CARD

Doc. # 53-438
Control # 8307050536
Date 3-25-83 of Document:
REGULATORY DOCKET FILE

REV NO.	ECN NO.	DATE	DESN	DRWN	CHKD	SUPV	CHKR	INSP	SUBM	RECM	APPR
1	S1	5-6-81									
INCORPORATED FCR E-1928											

DESN R.E. McKeever
DRWN L.A. Stewart
CHKD I.B. Patrick
SUPV W.K. Oldwiler
INSP
ENGINEER W.K. Oldwiler

SCALE EXCEPT AS NOTED

GENERAL
UNIT 2

SYSTEM SCHEMATIC
480V NORMAL AC
AUX POWER DISTRIBUTION SYSTEM

BELLEFONTE NUCLEAR PLANT
TENNESSEE VALLEY AUTHORITY
DIVISION OF ENGINEERING DESIGN

N

SUBMITTED W.K. Oldwiler
RECOMMENDED
APPROVED R.M. Hodges

INSPECTED AND APPROVED FOR ISSUE

KNOXVILLE 12-12-78 88 E 5GW2740-ED-34 R1

RECORD DRAWING AS CONSTRUCTED