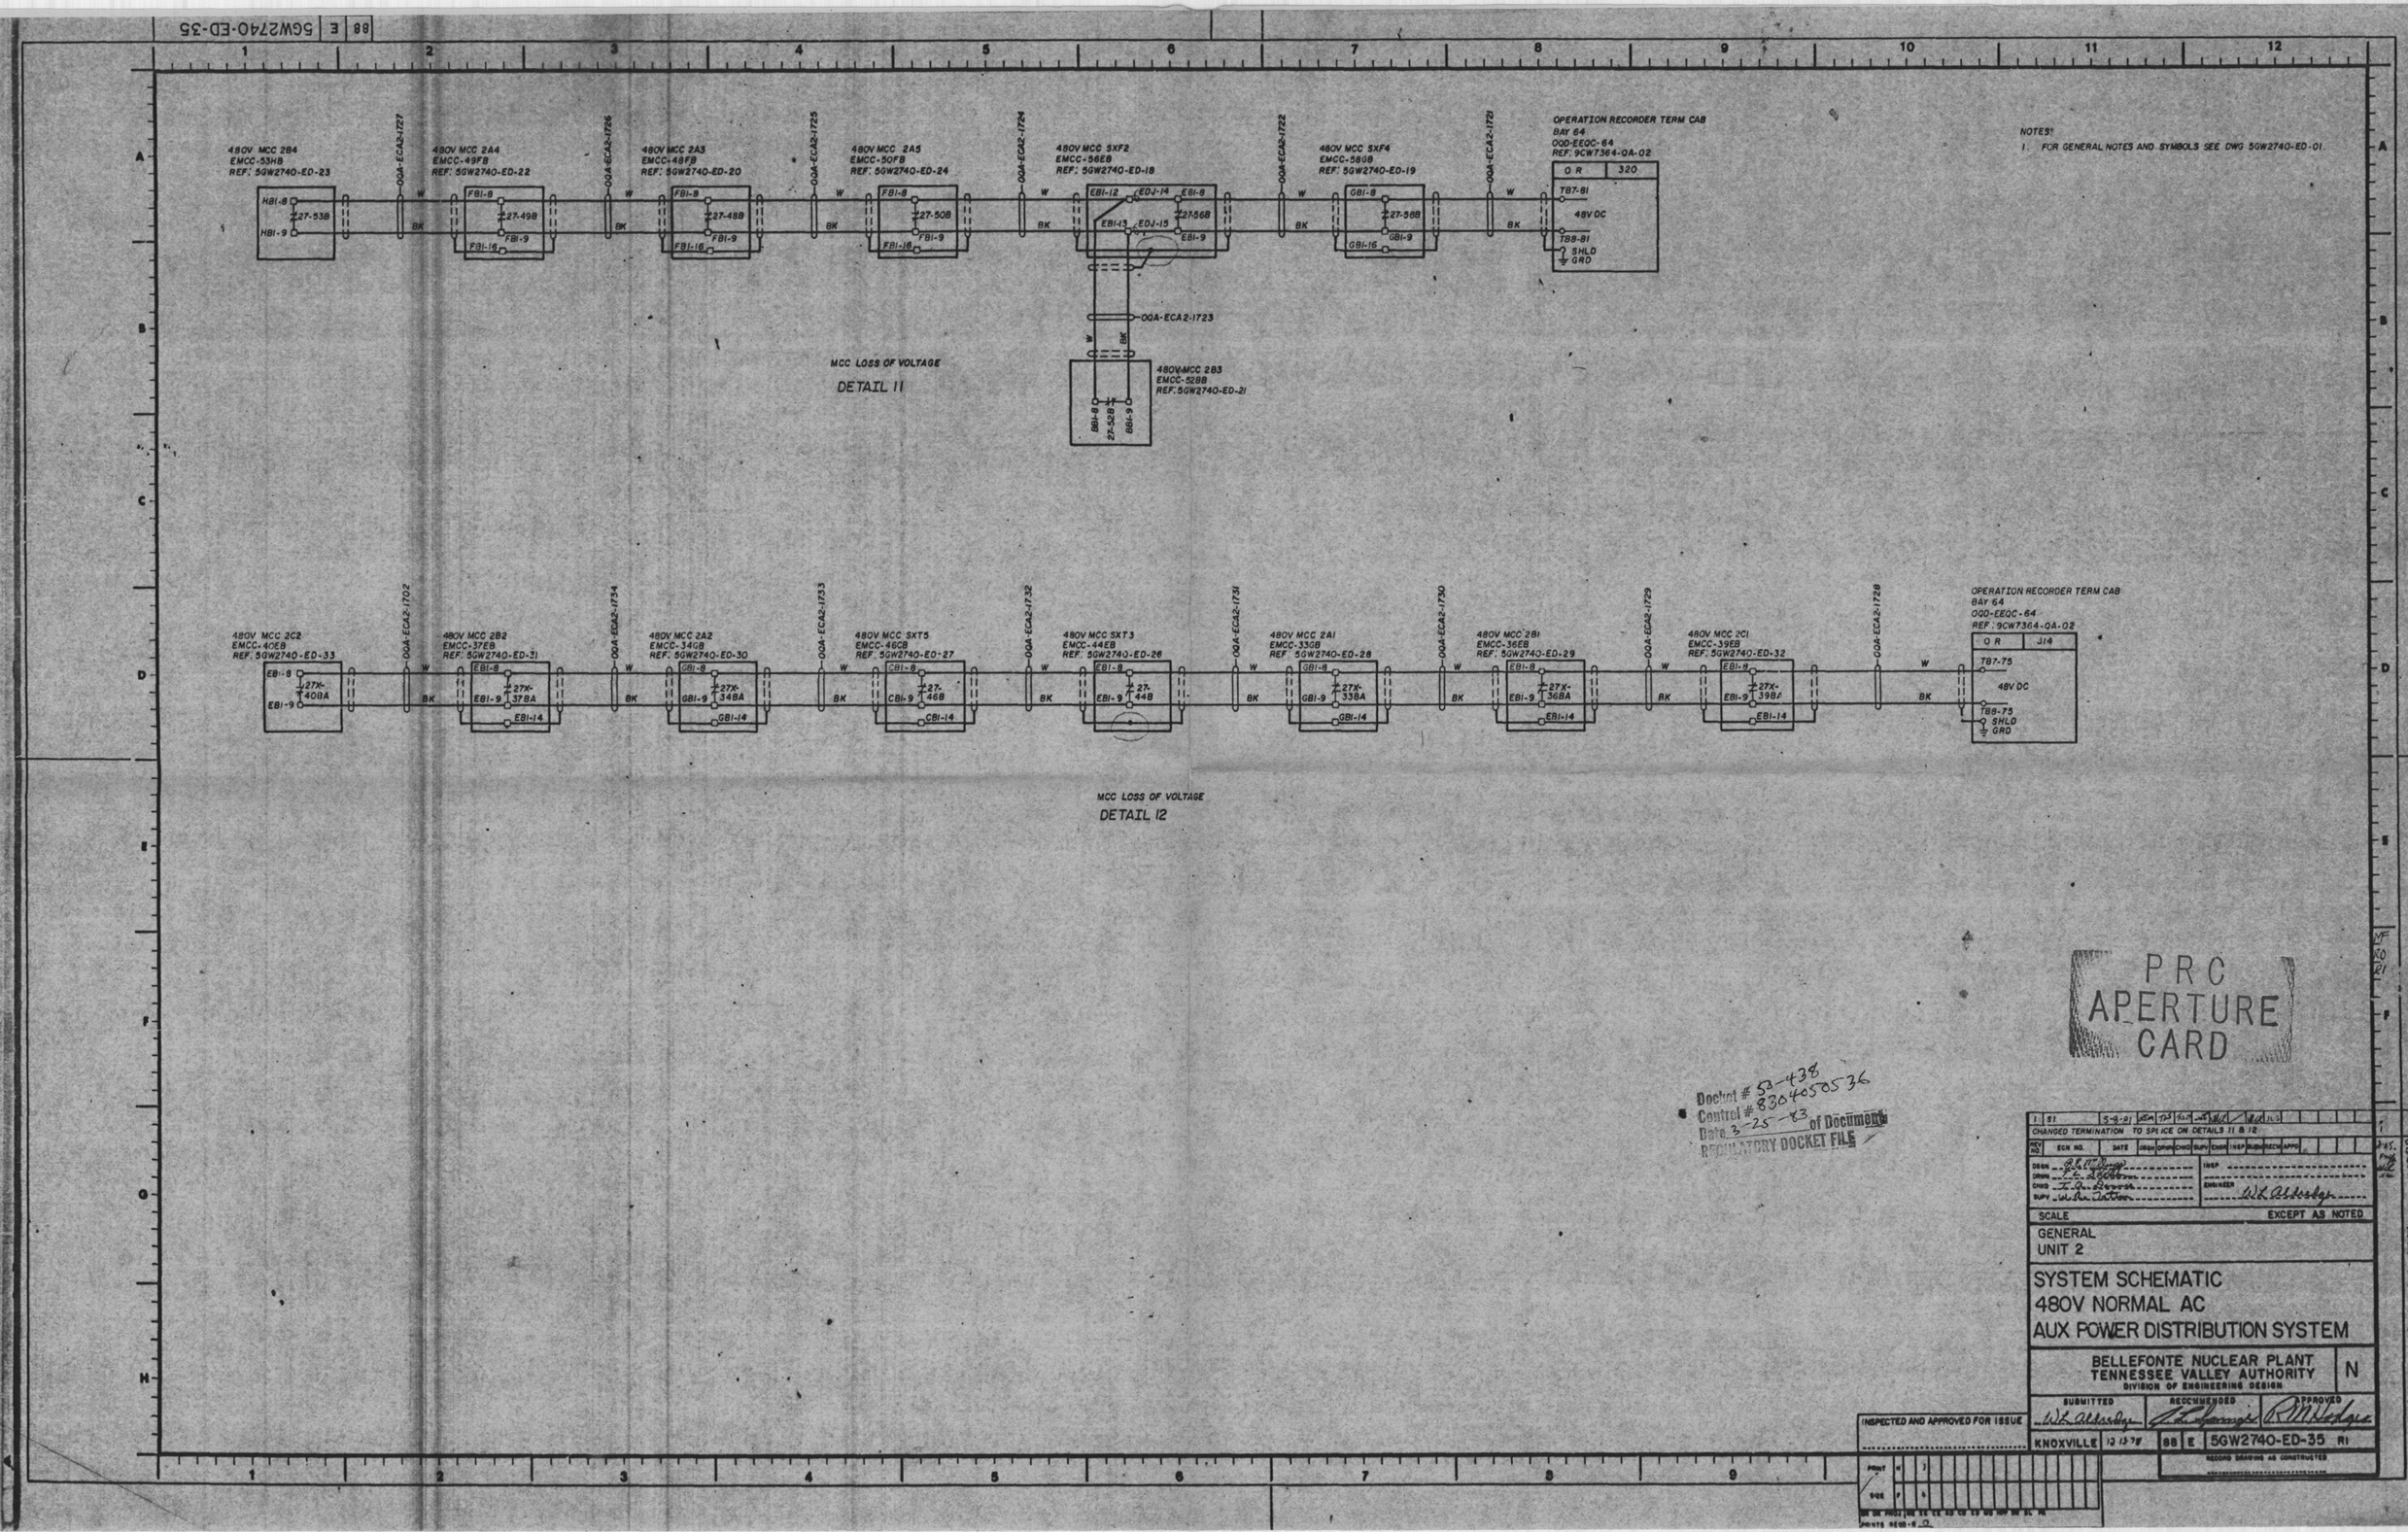

NOTES:
1. FOR GENERAL NOTES AND SYMBOLS SEE DWG 5GW2740-ED-01.

PRC APERTURE CARD

Docket # 53-438
Control # 8304050536
Date 3-25-83 of Document
REGULATORY DOCKET FILE

REV NO.	ECN NO.	DATE	DSGN	DRWN	CHKD	SUPV	ENGR	INSP	SUBM	RECM	APPD
1	S1	5-8-81									

CHANGED TERMINATION TO SPLICE ON DETAILS 11 & 12

DSGN R.L. McDonald
DRWN T.L. Stebbins
CHKD T.A. Dennis
SUPV W.R. Patton
INSP
ENGINEER W.L. Aldredge

SCALE EXCEPT AS NOTED

GENERAL
UNIT 2

SYSTEM SCHEMATIC
480V NORMAL AC
AUX POWER DISTRIBUTION SYSTEM

BELLEFONTE NUCLEAR PLANT
TENNESSEE VALLEY AUTHORITY
DIVISION OF ENGINEERING DESIGN

N

SUBMITTED W.L. Aldredge
RECOMMENDED
APPROVED R.M. Hodges

KNOXVILLE 12-13-78

88 E 5GW2740-ED-35 R1

RECORD DRAWING AS CONSTRUCTED

INSPECTED AND APPROVED FOR ISSUE

PRINTS REQD-N 0