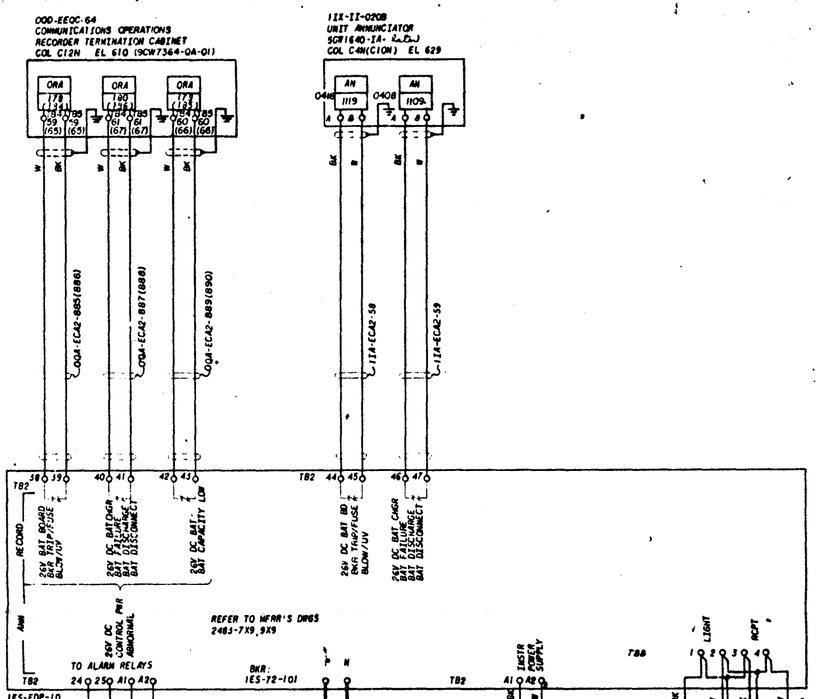

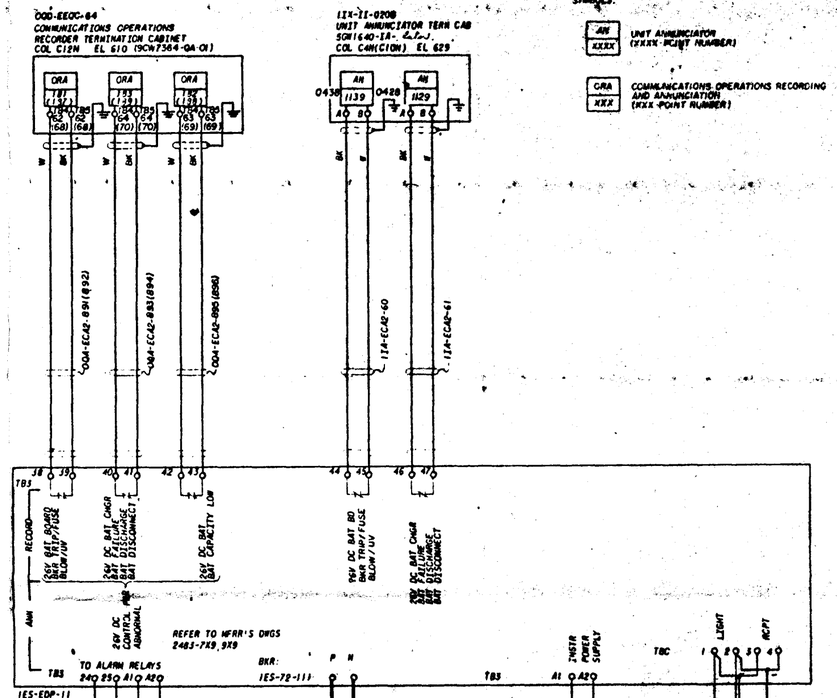

SYMBOLS:

AN XXXX — UNIT ANNUNCIATOR (XXXX-POINT NUMBER)

CRA XXX — COMMUNICATIONS OPERATIONS RECORDING AND ANNUNCIATION (XXX-POINT NUMBER)

NOTES:

1. THIS DRAWING SHOWS INTERCONNECTION OF INSTRUMENT CONTROL, ANNUNCIATION, LIGHTING CIRCUITS AND BATTERY CIRCUITS
2. SHOWN FOR UNIT 1, UNIT 2 SIMILAR EXCEPT AS NOTED AND SHOWN IN PARENTHESIS.
3. 26V TURBINE DISTRIBUTION PANELS ARE PROVIDED AS PART OF 250V NORMAL BAT BD. ON CONTRACT 75K3-86429.
4. 26V TURBINE BATTERY CHARGERS ARE PROVIDED ON CONTRACT 76K3-86148-2.
5. 26V TURBINE BATTERIES ARE PROVIDED ON CONTRACT 77K7-92184.
6. ALL ANNUNCIATION CONTACTS ARE CLOSE TO ALARM.

REFERENCE DWGS.

5BW1625-EP } ..... SINGLE LINES
5BW2626-EP }

5BW0620-EP ..... KEY DIAGRAM

5GC0600-EP }
5GC1600-EP } ..... CABLE SCHEDULES
5GC2C00-EP }

CONFIGURATION DWGS: 5GW0640-EP-1, 2, 12, 14

Docket # 50-438
Control # 8304050536
Date 3-25-83 of Document
REGULATORY DOCKET FILE

PRC APERTURE CARD

3	SI	INCORPORATED FOR E-2206.	
2	SI	REVISED JUMPER NUMBERS, AND COLOR CODES.	
1	SI	REVISED CABLE NOS RELEASED MONITORING SYSTEMS TERMINATIONS.	
REV	ECN NO	DATE	DRAWN CHKD SUPV

DSGN C.K. PEARSON
DWN R.G. FOWLKES
CHKD B.L. WATERS
SUPV J.F. CUNNINGHAM

INDEP
ENGINEER A.L. [illegible]

SCALE EXCEPT AS NOTED

GENERAL
UNITS 1&2

SCHEMATIC DIAGRAM
250V NORMAL DC POWER
DISTRIBUTION SYSTEM

BELLEFONTE NUCLEAR PLANT
TENNESSEE VALLEY AUTHORITY
DIVISION OF ENGINEERING DESIGN

N

SUBMITTED	RECOMMENDED	APPROVED
[illegible]	[illegible]	R.M. Gridley

KNOXVILLE 5-2-77 | 88 | E | 5GW0640-EP-13 R3

RECORD DRAWING AS CONSTRUCTED

INSPECTED AND APPROVED FOR ISSUE

| | | |