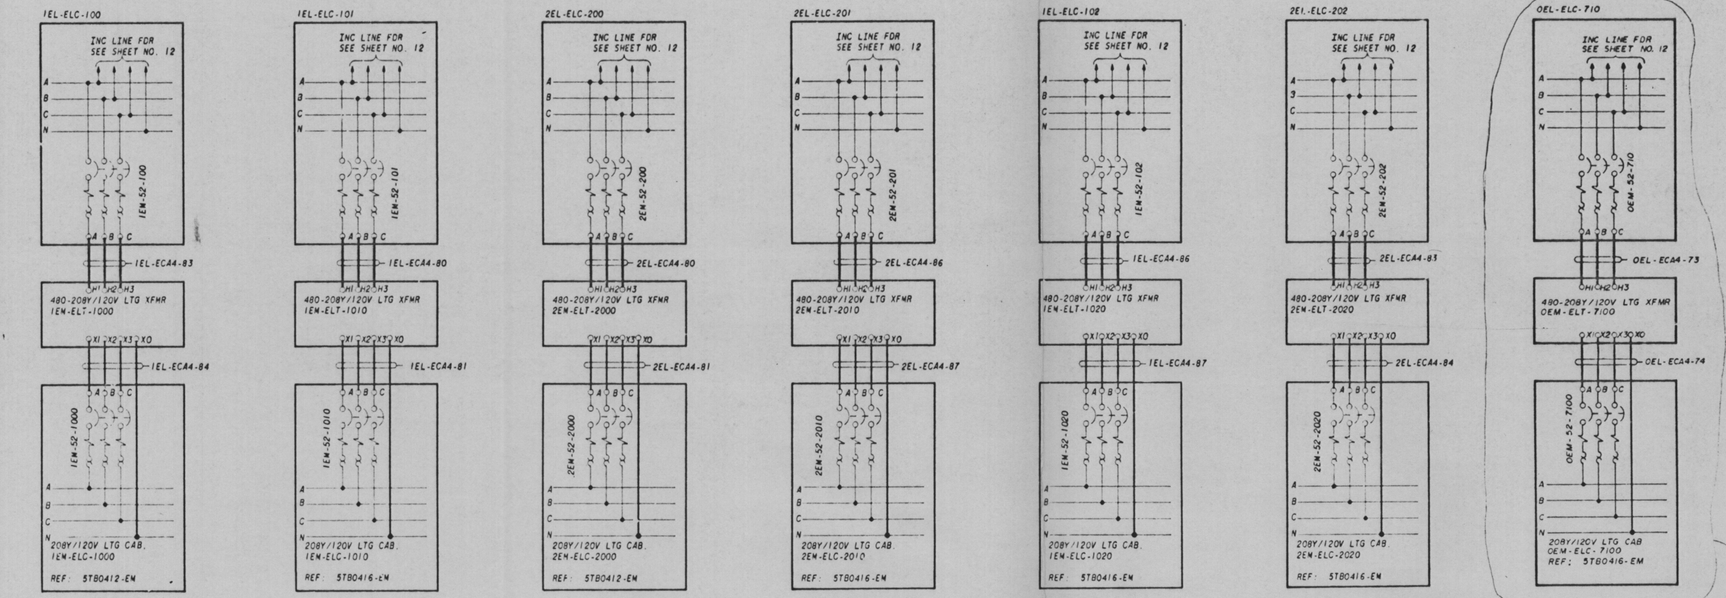

650

NOTES:
1. FOR GENERAL NOTES AND SYMBOLS SEE DWG 5GW0747-EL-01.

480V LIGHTING CABINET BRANCH FEEDERS FOR 208Y/120V LIGHTING SYSTEM

PRC APERTURE CARD

Docket # 50-438
Control # 8304050536
Date 3-25-83
of Document
REGULATORY DOCKET FILE

NO.	ECN NO	DATE	DSGN	DRWN	CHKD	SUPV	ENGR	VERF	SUBMITTED	RECMD	APPRD
1	650, S1	6-24-81									

ADDED LTG TRANSFORMER & LTG CAB 7100, REMOVED EL & COL

DSGN R.E. Hall
DRWN C.W. Estes
CHKD J.E. Hale
SUPV A.N. Peters
INSP
ENGINEER D.R. Gilbert

SCALE EXCEPT AS NOTED

GENERAL
UNITS 1 & 2

WIRING DIAGRAM NORMAL AC LIGHTING FEEDERS

BELLEFONTE NUCLEAR PLANT
TENNESSEE VALLEY AUTHORITY
DIVISION OF ENGINEERING DESIGN

N

SUBMITTED	RECOMMENDED	APPROVED
D.R. Gilbert	G.E. Young	R.M. Hollo
KNOXVILLE 2-7-78	88 E 5GW0747-EL-13 R1	

RECORD DRAWING AS CONSTRUCTED

INSPECTED AND APPROVED FOR ISSUE