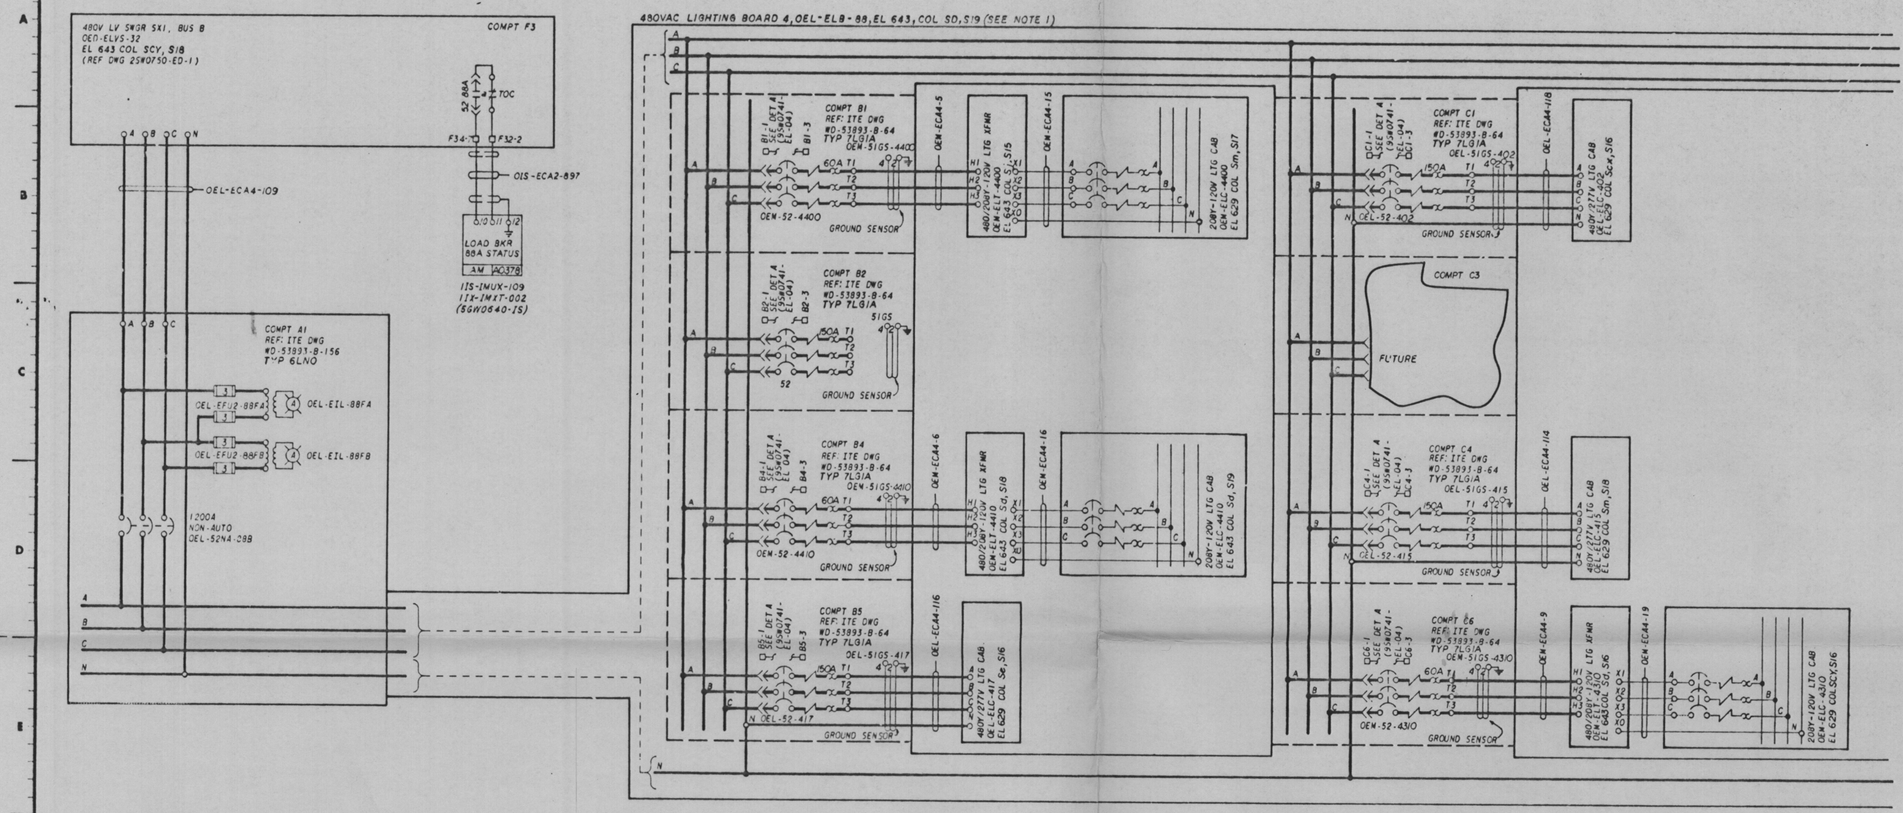

NOTES:
1. FOR MANUFACTURERS BILLS OF MATERIAL AND PHYSICAL ARRANGEMENT OF EQUIPMENT SEE TVA CONTRACT 76K5-86242, ITE IMPERIAL DWG 84-53893-71.

PRC APERTURE CARD

Docket # 50-438 / 83040500536
Date 3-25-83
Type of Document
REGULATORY DOCKET FILE

COMPANION DWGS:
9SW0741-EL-01, -02, -04

REV NO	ECN NO	DATE	DSGN	DRWN	CHKD	SUPV	ENGR	INSP	PLANR	RECM	APPD
1	722				TEM						
ECN-722 ADD LIGHTING XFMR FOR GATEHOUSE ADDITION											

DSGN J.P. SINK
DRWN J.D. SINATRA
CHKD G.A. DAVIDSON
SUPV B.M. WRIGHT
INSP
ENGINEER

SCALE EXCEPT AS NOTED

SERVICE AND OFFICE BUILDING
UNITS 1&2

WIRING DIAGRAM
480/277V LIGHTING BOARD 4
OEL-ELB-88

BELLEFONTE NUCLEAR PLANT
TENNESSEE VALLEY AUTHORITY
DIVISION OF ENGINEERING DESIGN

N

SUBMITTED	RECOMMENDED	APPROVED
Robert Z. Hewitt	R. A. Herndon	W. E. Hulvey, Jr.

INSPECTED AND APPROVED FOR ISSUE R. M. Hodges

KNOXVILLE 9-1-79 88 E 9SW0741-EL-03 R1

RECORD DRAWING AS CONSTRUCTED