NOTES:
1. FOR GENERAL NOTES AND SYMBOLS SEE DWG 5GW0747-EL-01.

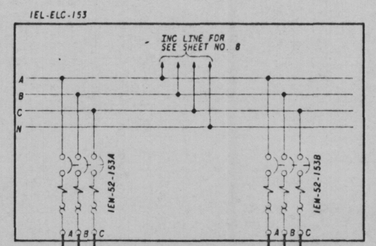

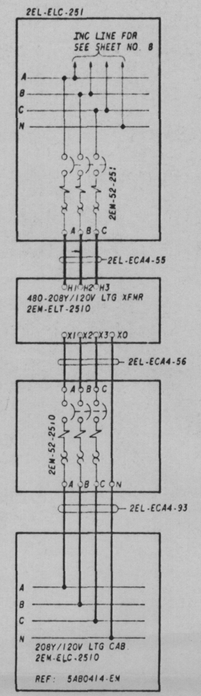

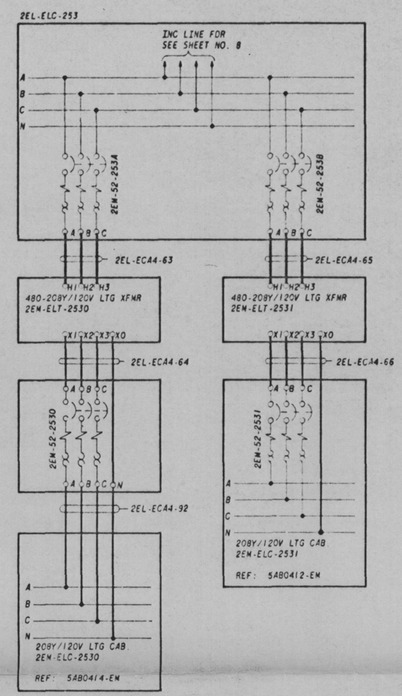

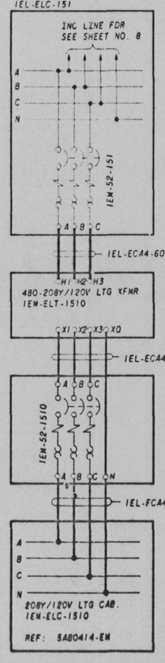

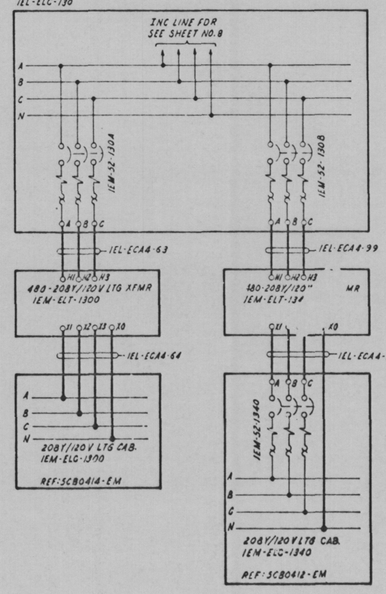

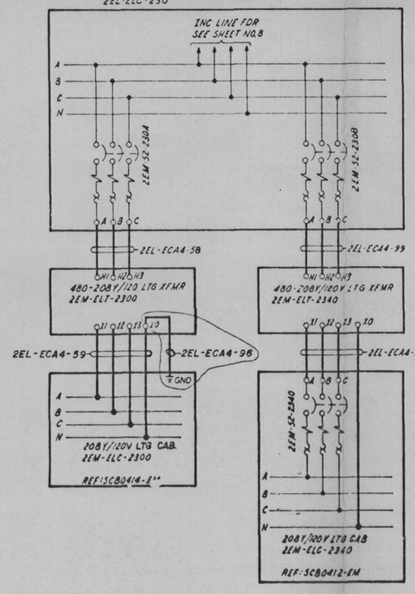

480V LIGHTING CABINET
BRANCH FEEDERS FOR
208Y/120V LIGHTING SYSTEM

PRC APERTURE CARD

Docket # 50-438
Control # 8304050536
Date 3-25-83 of Document
REGULATORY DOCKET FILE

REV NO	ECN NO	DATE	DSGN	DRWN	CHKD	SUPV	ENGR	NSP	SLDG	RECH	APPD
1	S1	7-5-83									

REMOVED COLBEL ADDED GROUND CABLE 2EL-ECA4-98.

DSGN R.E. Harwood — NSP
DRWN B.A. Stewart
CHKD L.W. Tate
SUPV W.R. Poston — ENGINEER W.L. Alderdyce

SCALE EXCEPT AS NOTED

GENERAL
UNITS 1 & 2

WIRING DIAGRAM
NORMAL AC
LIGHTING FEEDERS

BELLEFONTE NUCLEAR PLANT
TENNESSEE VALLEY AUTHORITY
DIVISION OF ENGINEERING DESIGN

N

SUBMITTED	RECOMMENDED	APPROVED
W.L. Alderdyce	C.E. Spangler	R.M. Gridley
KNOXVILLE 2-7-78	88 E	5GW0747-EL-09 R1

RECORD DRAWING AS CONSTRUCTED

INSPECTED AND APPROVED FOR ISSUE

PRINT SIZE