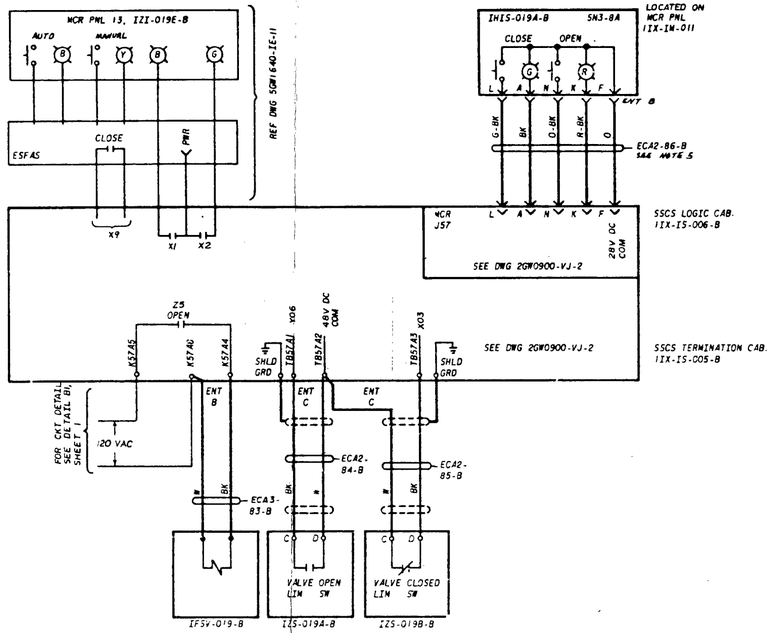

RB INSTR RM CHILLED WATER RETURN ISLN VALVE, IFCV-019-B

NOTES:
1 FOR GENERAL NOTES AND REFERENCE DRAWINGS SEE 5GW1740-VJ-01

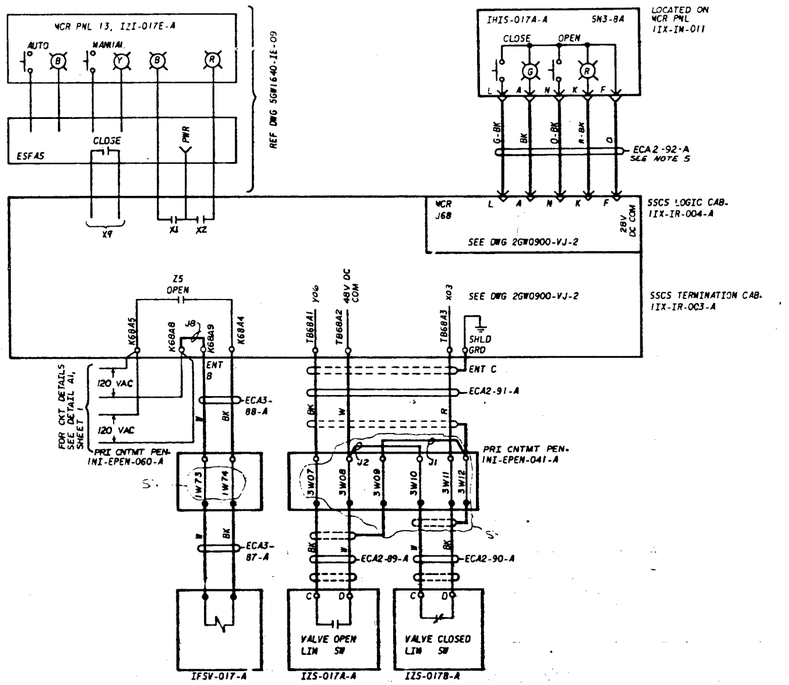

RB INSTR RM CHILLED WATER RETURN ISLN VALVE, IFCV-017-A

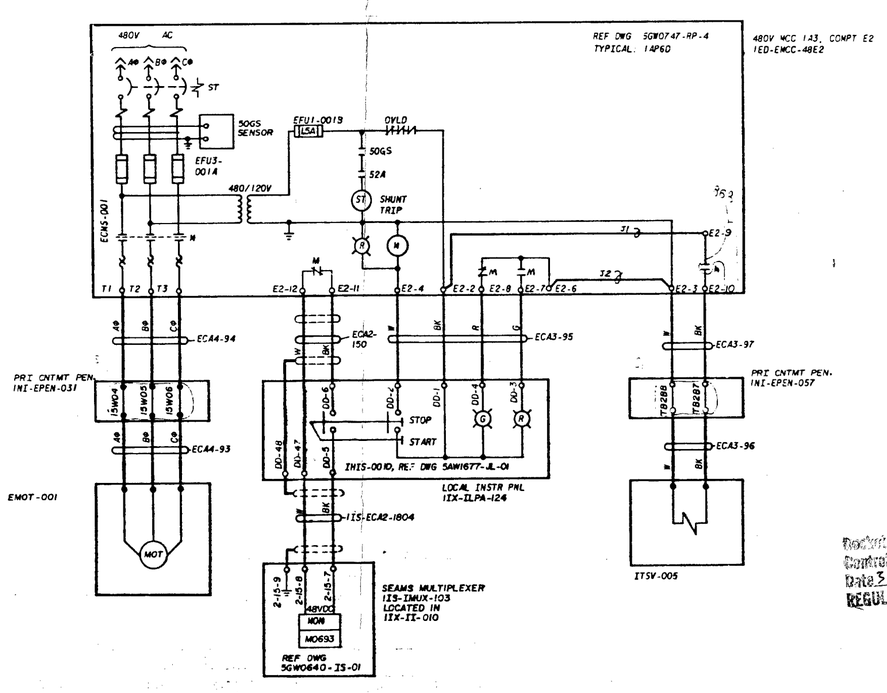

REACTOR BLDG INSTR RM AHU, MAHU-003

PRC APERTURE CARD

Docket #50-438
Control # 8304050536
Date 3-25-83 of Document
REGULATORY DOCKET FILE

REV	ECN NO.	DATE	DRWN	OPER	CHKD	SUPV	ENGR	ISEP	BLDG/MECH	APPD
2	51,868	7-7-80	JEB							
1	518,51	2-1-77	JDB							

2 ADDED SPLICE SYMBOLS TO VARIOUS PENETRATIONS, & MADE MINOR CHANGES, CHANGED PEN. TERM. NO.

1 CHANGED FUSE SIZE IN MCC PER ECN 518. CHANGED CABLING ARRGT TO ELIMINATE "AND" GATE IN SEAMS SOFTWARE, REMOVED LOCATIONS, PLUS OTHER MINOR CHANGES PER ECN 51.

DESIGN — J. Ballard
DRAWN — J. Jones
CHKD — [illegible]
SUPV — [illegible]
ISEP —
ENGINEER — W. L. Aldridge

SCALE — EXCEPT AS NOTED

GENERAL
UNIT 1

SYSTEM SCHEMATIC REACTOR BLDG AIR CONDITIONING & COOLING SYSTEM

BELLEFONTE NUCLEAR PLANT
TENNESSEE VALLEY AUTHORITY
DIVISION OF ENGINEERING DESIGN

Q

REVIEWED	
RCE(CIVIL)	N/A
RBELEC	N/A
RMMECH	N/A

SUBMITTED	RECOMMENDED	APPROVED
W L Aldridge	[signature]	[signature]
KNOXVILLE 3-8-78	88 E	5GW1740-VJ-05 R2

RECORD DRAWING AS CONSTRUCTED