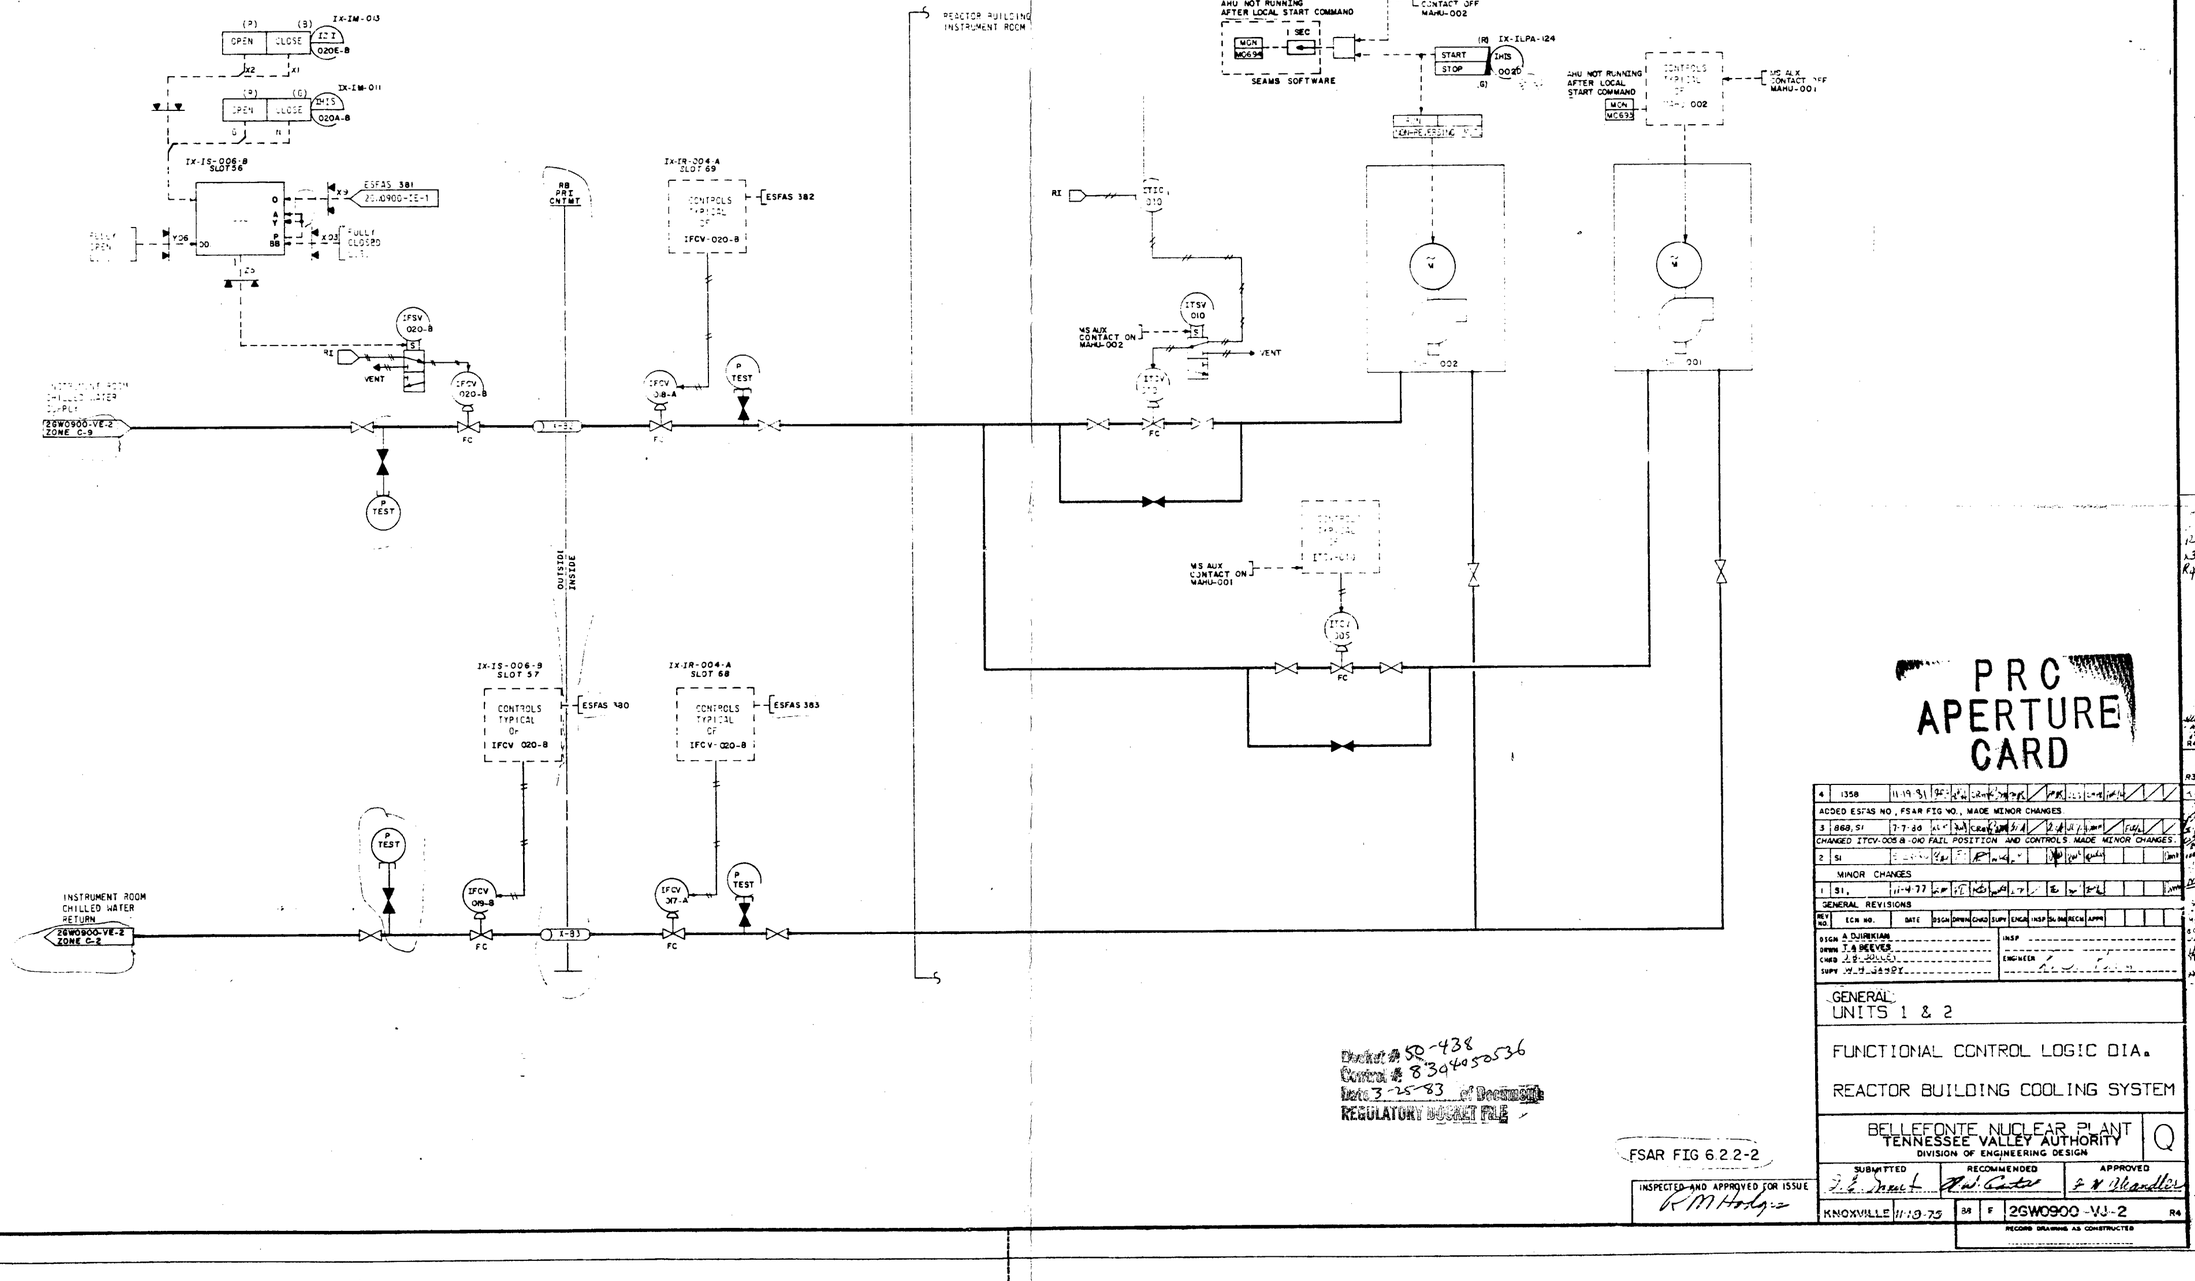

PRC APERTURE CARD

REV NO	ECN NO.	DATE	DSGN	DRWN	CHKD	SUPV	ENGR	INSP	SQ MR	RECH	APPR
4	1358	11-19-81									
ADDED ESFAS NO., FSAR FIG NO., MADE MINOR CHANGES											
3	868, SI	7-7-80									
CHANGED IFCV-005 B-010 FAIL POSITION AND CONTROLS MADE MINOR CHANGES.											
2	SI										
MINOR CHANGES											
1	SI	11-4-77									
GENERAL REVISIONS											

DSGN A DJURKIAM
DRWN T A REEVES
CHKD J B DOLLEY
SUPV W H JAGGER
INSP
ENGINEER

GENERAL
UNITS 1 & 2

FUNCTIONAL CONTROL LOGIC DIA.

REACTOR BUILDING COOLING SYSTEM

BELLEFONTE NUCLEAR PLANT
TENNESSEE VALLEY AUTHORITY
DIVISION OF ENGINEERING DESIGN

Q

SUBMITTED	RECOMMENDED	APPROVED
J. E. Smith	Neil Carter	E. W. Chandler

KNOXVILLE 11-19-73 | BR | F | 2GW0900-VJ-2 | R4

RECORD DRAWING AS CONSTRUCTED

Docket # 50-438
Control # 8304050536
Date 3-25-83 of Document
REGULATORY DOCKET FILE

FSAR FIG 6.2.2-2

INSPECTED AND APPROVED FOR ISSUE
R M Hodges

PRINTS REQD R
BR W
PROJ

	DWG SIZE P	H
ME		3
CE		
CR		
AD		
CO		
ED		
MD		
EF		
SW		
BL		
PA		