2GW0900-VJ-3 | 3 | 99

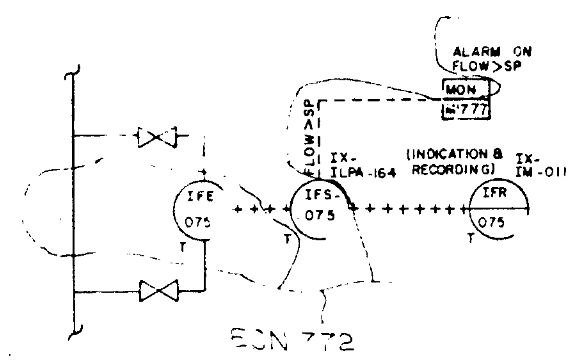

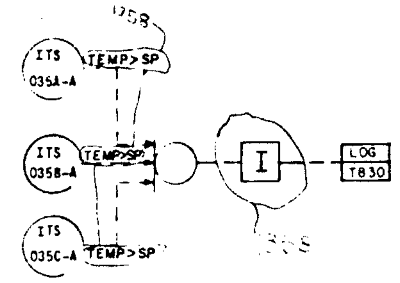

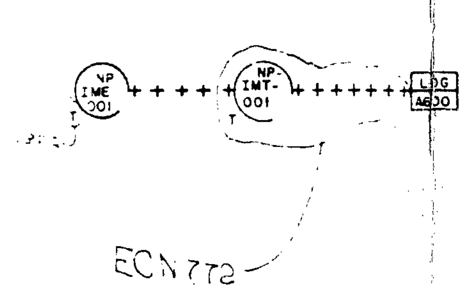

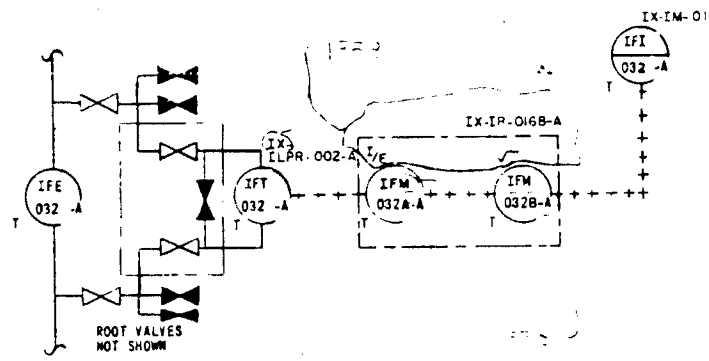

LOOP NO	LOG No
036A-B, 036B-B, 036C-B	T831
034A-B, 034B-B, 034C-B	T829

LOOP NO	LOG NO.
002	A601
003	A604

LOOP NO.	TRANSMITTER LOCATION LOCAL PNL UNID NO	BOP CBM CAB UNID NO
033 -B	IX-ILPR-005-B	IX-IS-016B-B
031 -B	IX-ILPR-005-B	IX-IS-016B-B

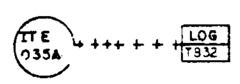

LOOP NO.	LOG NO.
035B	T833
034A	T834
034B	T835
036A	T836
036B	T837

PRC APERTURE CARD

REV NO.	ECN NO.	DATE	DSGN	DRWN	CHKD	SUPV	ENGR	INSP	SUBM	RECM	APPR
3	772, 1358			DLC							
	DELETED INSTR INP-IPT-001B & ASSOCIATED LOOP CHANGED INSTR LOOP FOR IFE-075 MINOR CHANGES.										
2	772, 51										
	ADD INSTRUMENTS AND EXPAND UNID's										
1	51,	11-4-77									
	GENERAL REVISIONS										

DSGN J.B. FRANKLIN
DRWN T A BEEVES
CHKD R. BRAGAN
SUPV W.H. GANDY
INSP
ENGINEER

GENERAL
UNITS 1 & 2

FUNCTIONAL CONTROL LOGIC DIAGRAM

REACTOR BUILDING COOLING SYSTEM

BELLEFONTE NUCLEAR PLANT
TENNESSEE VALLEY AUTHORITY
DIVISION OF ENGINEERING DESIGN
Q

SUBMITTED | RECOMMENDED | APPROVED

KNOXVILLE 2-11-75 | 88 | E | 2GW0900-VJ-3 R3

RECORD DRAWING AS CONSTRUCTED

FSAR: FIG 6.2.2-3

INSPECTED AND APPROVED FOR ISSUE

Docket # 50-438
Control # 8304050536
Date 3-25-83 of Document
REGULATORY DOCKET FILE