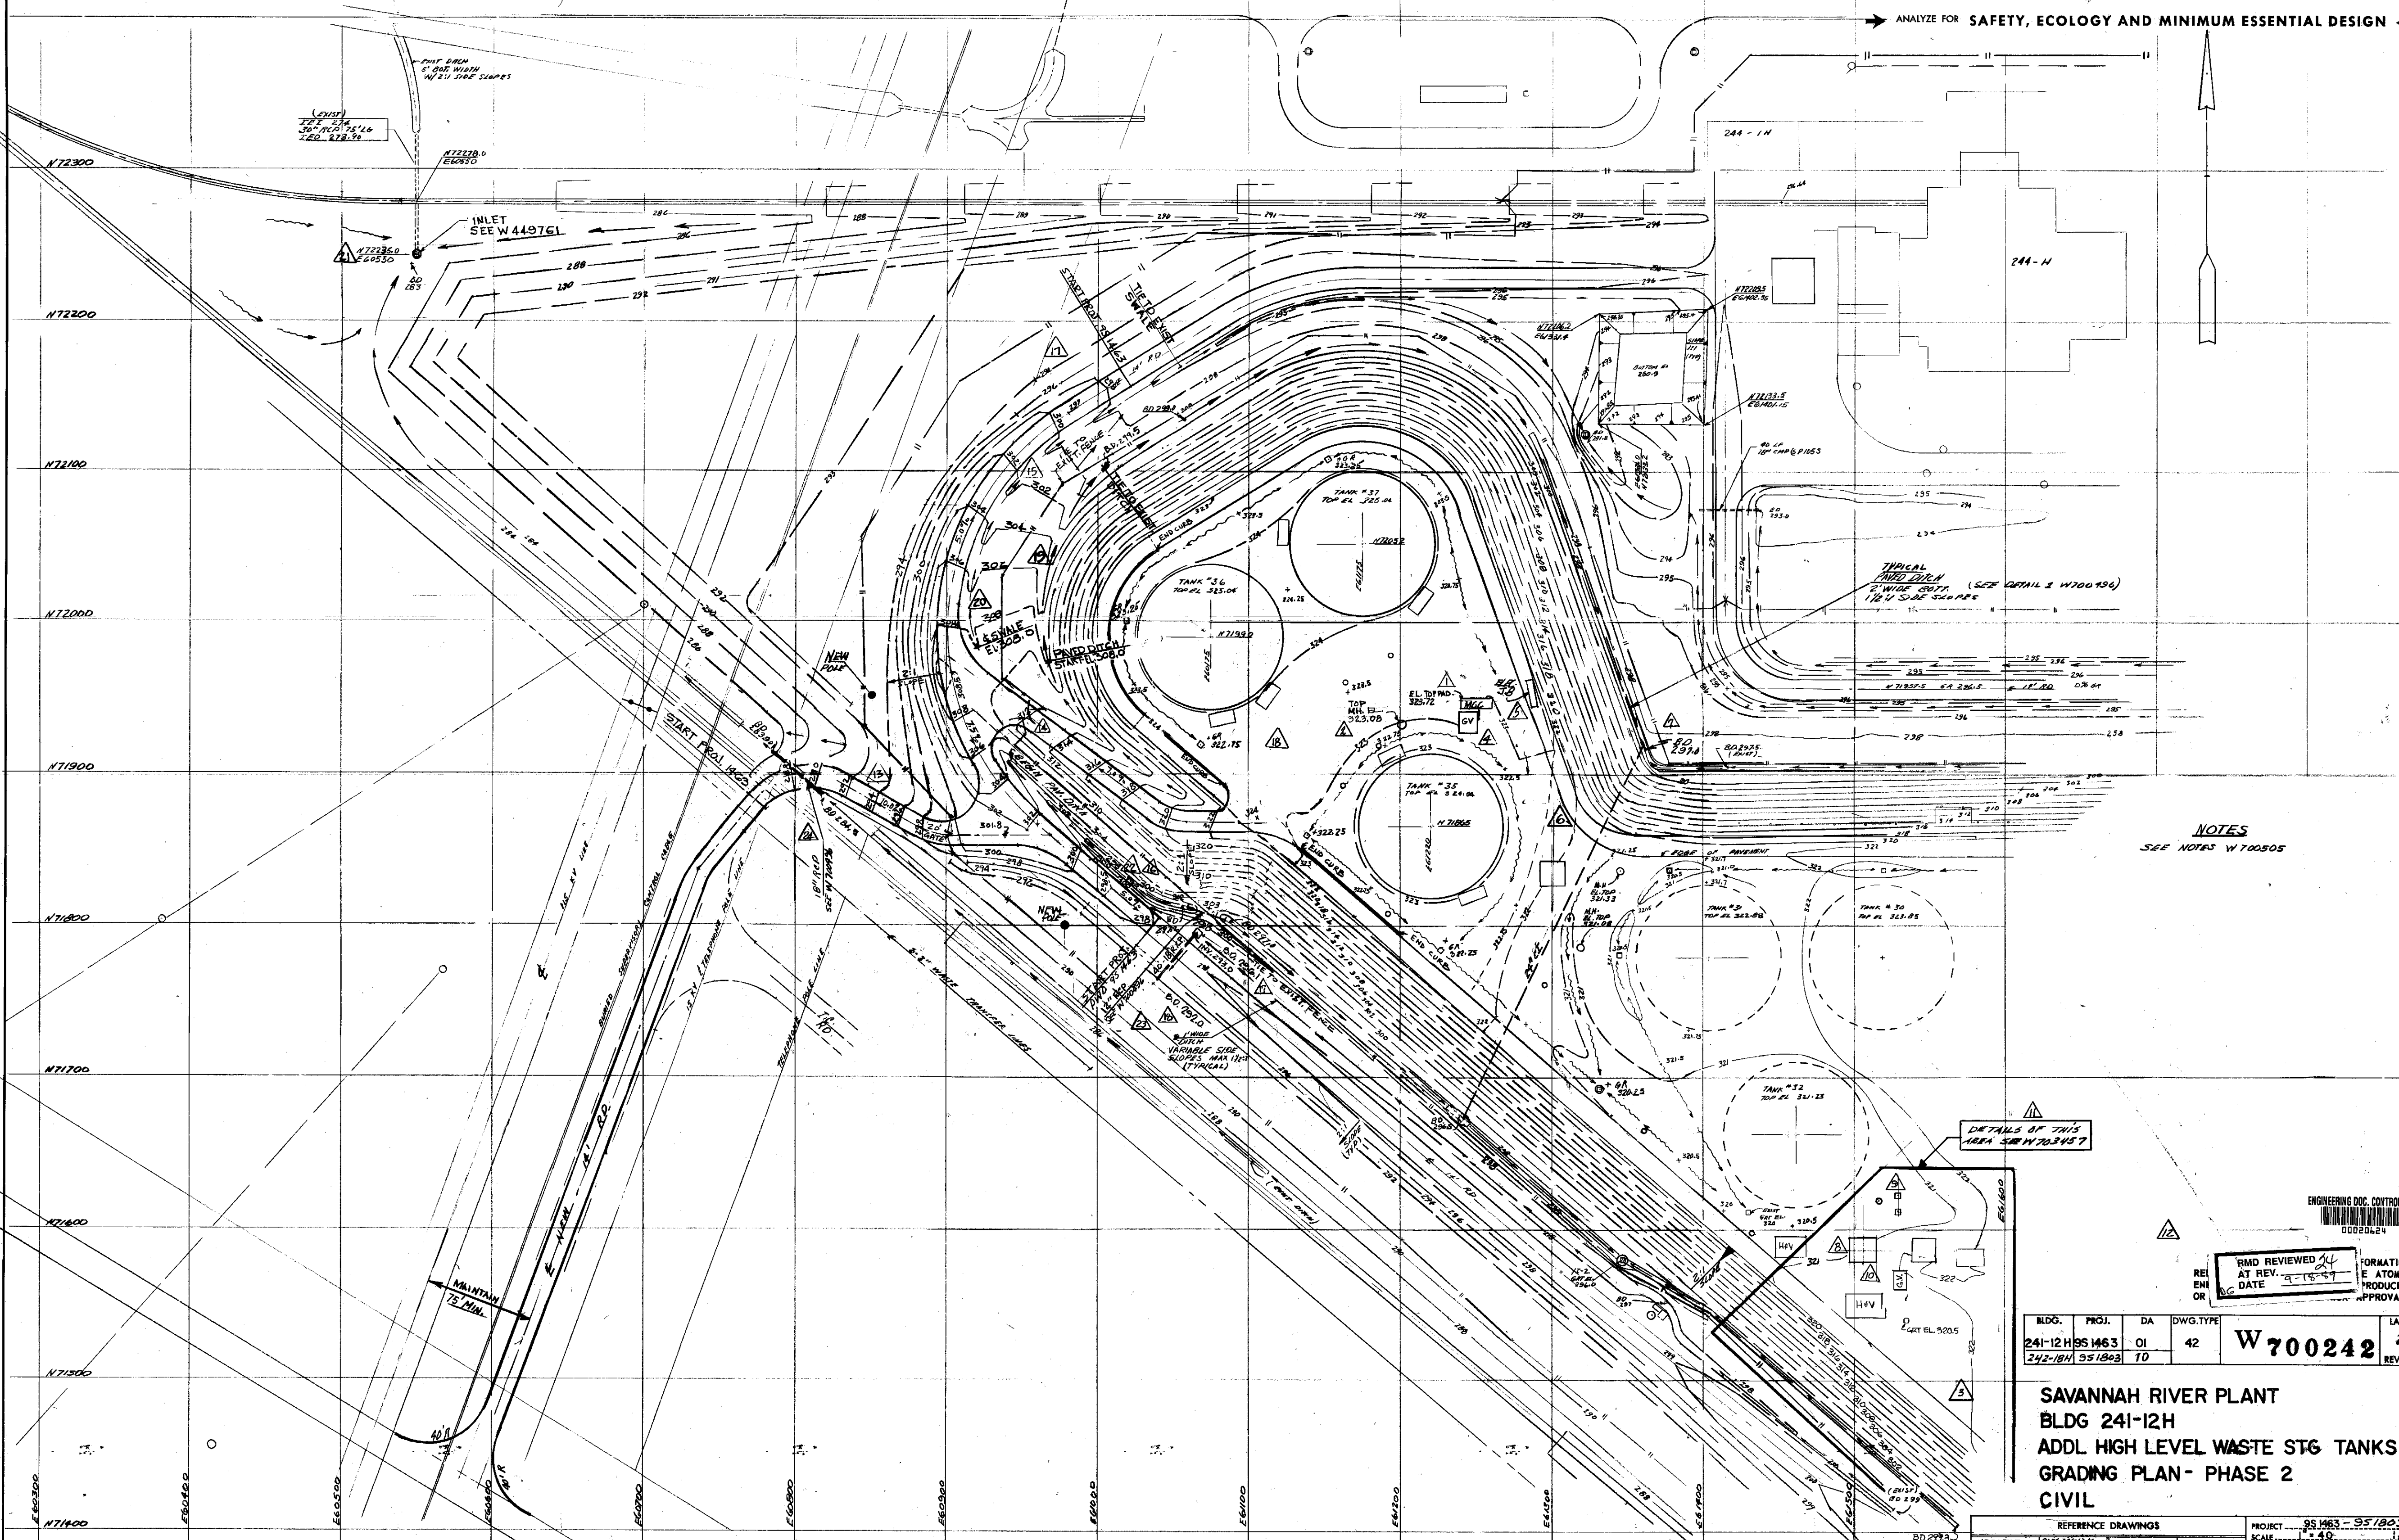

ENGINEERING DOC. CONTROL – SRS
00020624

RMD REVIEWED AT REV. 24 DATE 9-18-89

BLDG.	PROJ.	DA	DWG. TYPE		LATEST REVISION
241-12 H	9S 1463	01	42	W 700242	25
242-18H	951803	10			

SAVANNAH RIVER PLANT
BLDG 241-12H
ADDL HIGH LEVEL WASTE STG TANKS
GRADING PLAN - PHASE 2
CIVIL

PROJ. NO.	REVISIONS	REVISED BY DATE	CHECKED BY DATE	APPROVED BY DATE
95 1463 PWO 13	22 REVISED GRADING	THAKKAR 4-19-78	MIGALEDDI 4-20-78	W. PETERS 4-28-78
	23 ADDED 12" RCP.			
	24 DELETED 12" AC P, ADDED EXIST 12" RCP.			
95 1618	11 ADDED REF. DWG NO.	G. SINCLAIR 8-26-77	MIGALEDDI 8-31-77	B.E.L. 9-2-77
	12 REMOVED REF. DWG. WAS W 701248			
95 1463 PWO 13	13 14 ADDED RAMPS, REVISED GRADES	E. OSTAS 10-20-77	MIGALEDDI 10-21-77	W. PETERS 10-21-77
	15 16 REVISED GRADES			
	17 ADDED BD EL 296.1 (AS BUILT)	F. MONTI 1-10-78		
	18 ADDED BD EL 292.0 (AS BUILT)			
95 1463 PWO 13	19 ADDED PAVED DITCH FROM N72100 TO N71970±			
	20 ADDED SWALE FROM N71170± TO N71980±			
	21 N72235 WAS N72245	G. THAKKAR 4-19-78	MIGALEDDI 4-20-78	W. PETERS 4-28-78
95-1463	1 ADDED MOTOR CONTROL STATION PAD & ELEV.	JC 3/18/75	3/18/75	W. PETERS 3-21-75
951463	2 ADDED TOP MH. EL 323.08			
951463	3 REVISED GRADING OF SLOPE	MIGALEDDI 2-26-76	CARPENTER 2-26-76	W. PETERS 2-27-76
951463	4 REVISED MCC & GV. LOCN. ADDED ELEV. J.B.			
951463	5 RELOCATED HR. MCC & J.B. 10'-0" EAST PER FIELD AS BUILT.			
951463	6 EXTENDED PAVING, BERM & SLOPE EAST OF (5)	MIGALEDDI 10-20-76	J.H.C. 11-8-76	W. PETERS 11-10-76
951463	7 REVISED DITCH @ TOE OF SLOPE & EXTENDED 24" CI LINE			
951803	8 9 ADDED LOCATION OF NEW PUMP PIT & C.B.			
951803	10 REVISED EDGE OF PAVEMENT	G. SINCLAIR 8-8-77	MIGALEDDI 8-16-77	B.E.L. 9-2-77

REFERENCE STANDARDS
SCSE
C 115
SP1035

REFERENCE DRAWINGS	
W700505	BLDG 241-12H PLOT PLAN PH 2
W700209	BLDG 241-12H GR. PLAN PH 1
W449929	BLDG 241-12H PLOT PLAN PH 1
W700496	BLDG 241-12H STORM DRAIN
W703457	GRADING PLAN
W701248	PROCESS PIPING PLAN & DET. DWG

PROJECT	9S 1463 - 951803	
SCALE	1" = 40'	DATE
DRAWN	MIGALEDDI	10-2-74
CHECKED		1-28-75
APPROVED-INITIAL CONSTR. RELEASE	W. PETERS	1-28-75
APPROVED-FINAL	W. PETERS	4-30-75

THIS DRAWING HAS BEEN FURNISHED BY E. I. DU PONT DE NEMOURS & CO. THE INFORMATION AND KNOW-HOW THEREON MAY NOT BE USED NOR THE DRAWING REPRODUCED WITHOUT THE WRITTEN PERMISSION OF DU PONT. ALL REPRODUCTIONS IN WHOLE OR IN PART, INCLUDING VENDOR'S SHOP DRAWINGS, SHALL BEAR OR REFER TO THIS STAMP.

E. I. DU PONT DE NEMOURS & COMPANY INCORPORATED
WILMINGTON, DELAWARE
ENGINEERING DEPARTMENT

W 700242

ORIGINAL DRAWING MADE ON DU PONT POLYESTER FILM