RC=CEL:(55,100)FORMATS.CEL AC=E7749

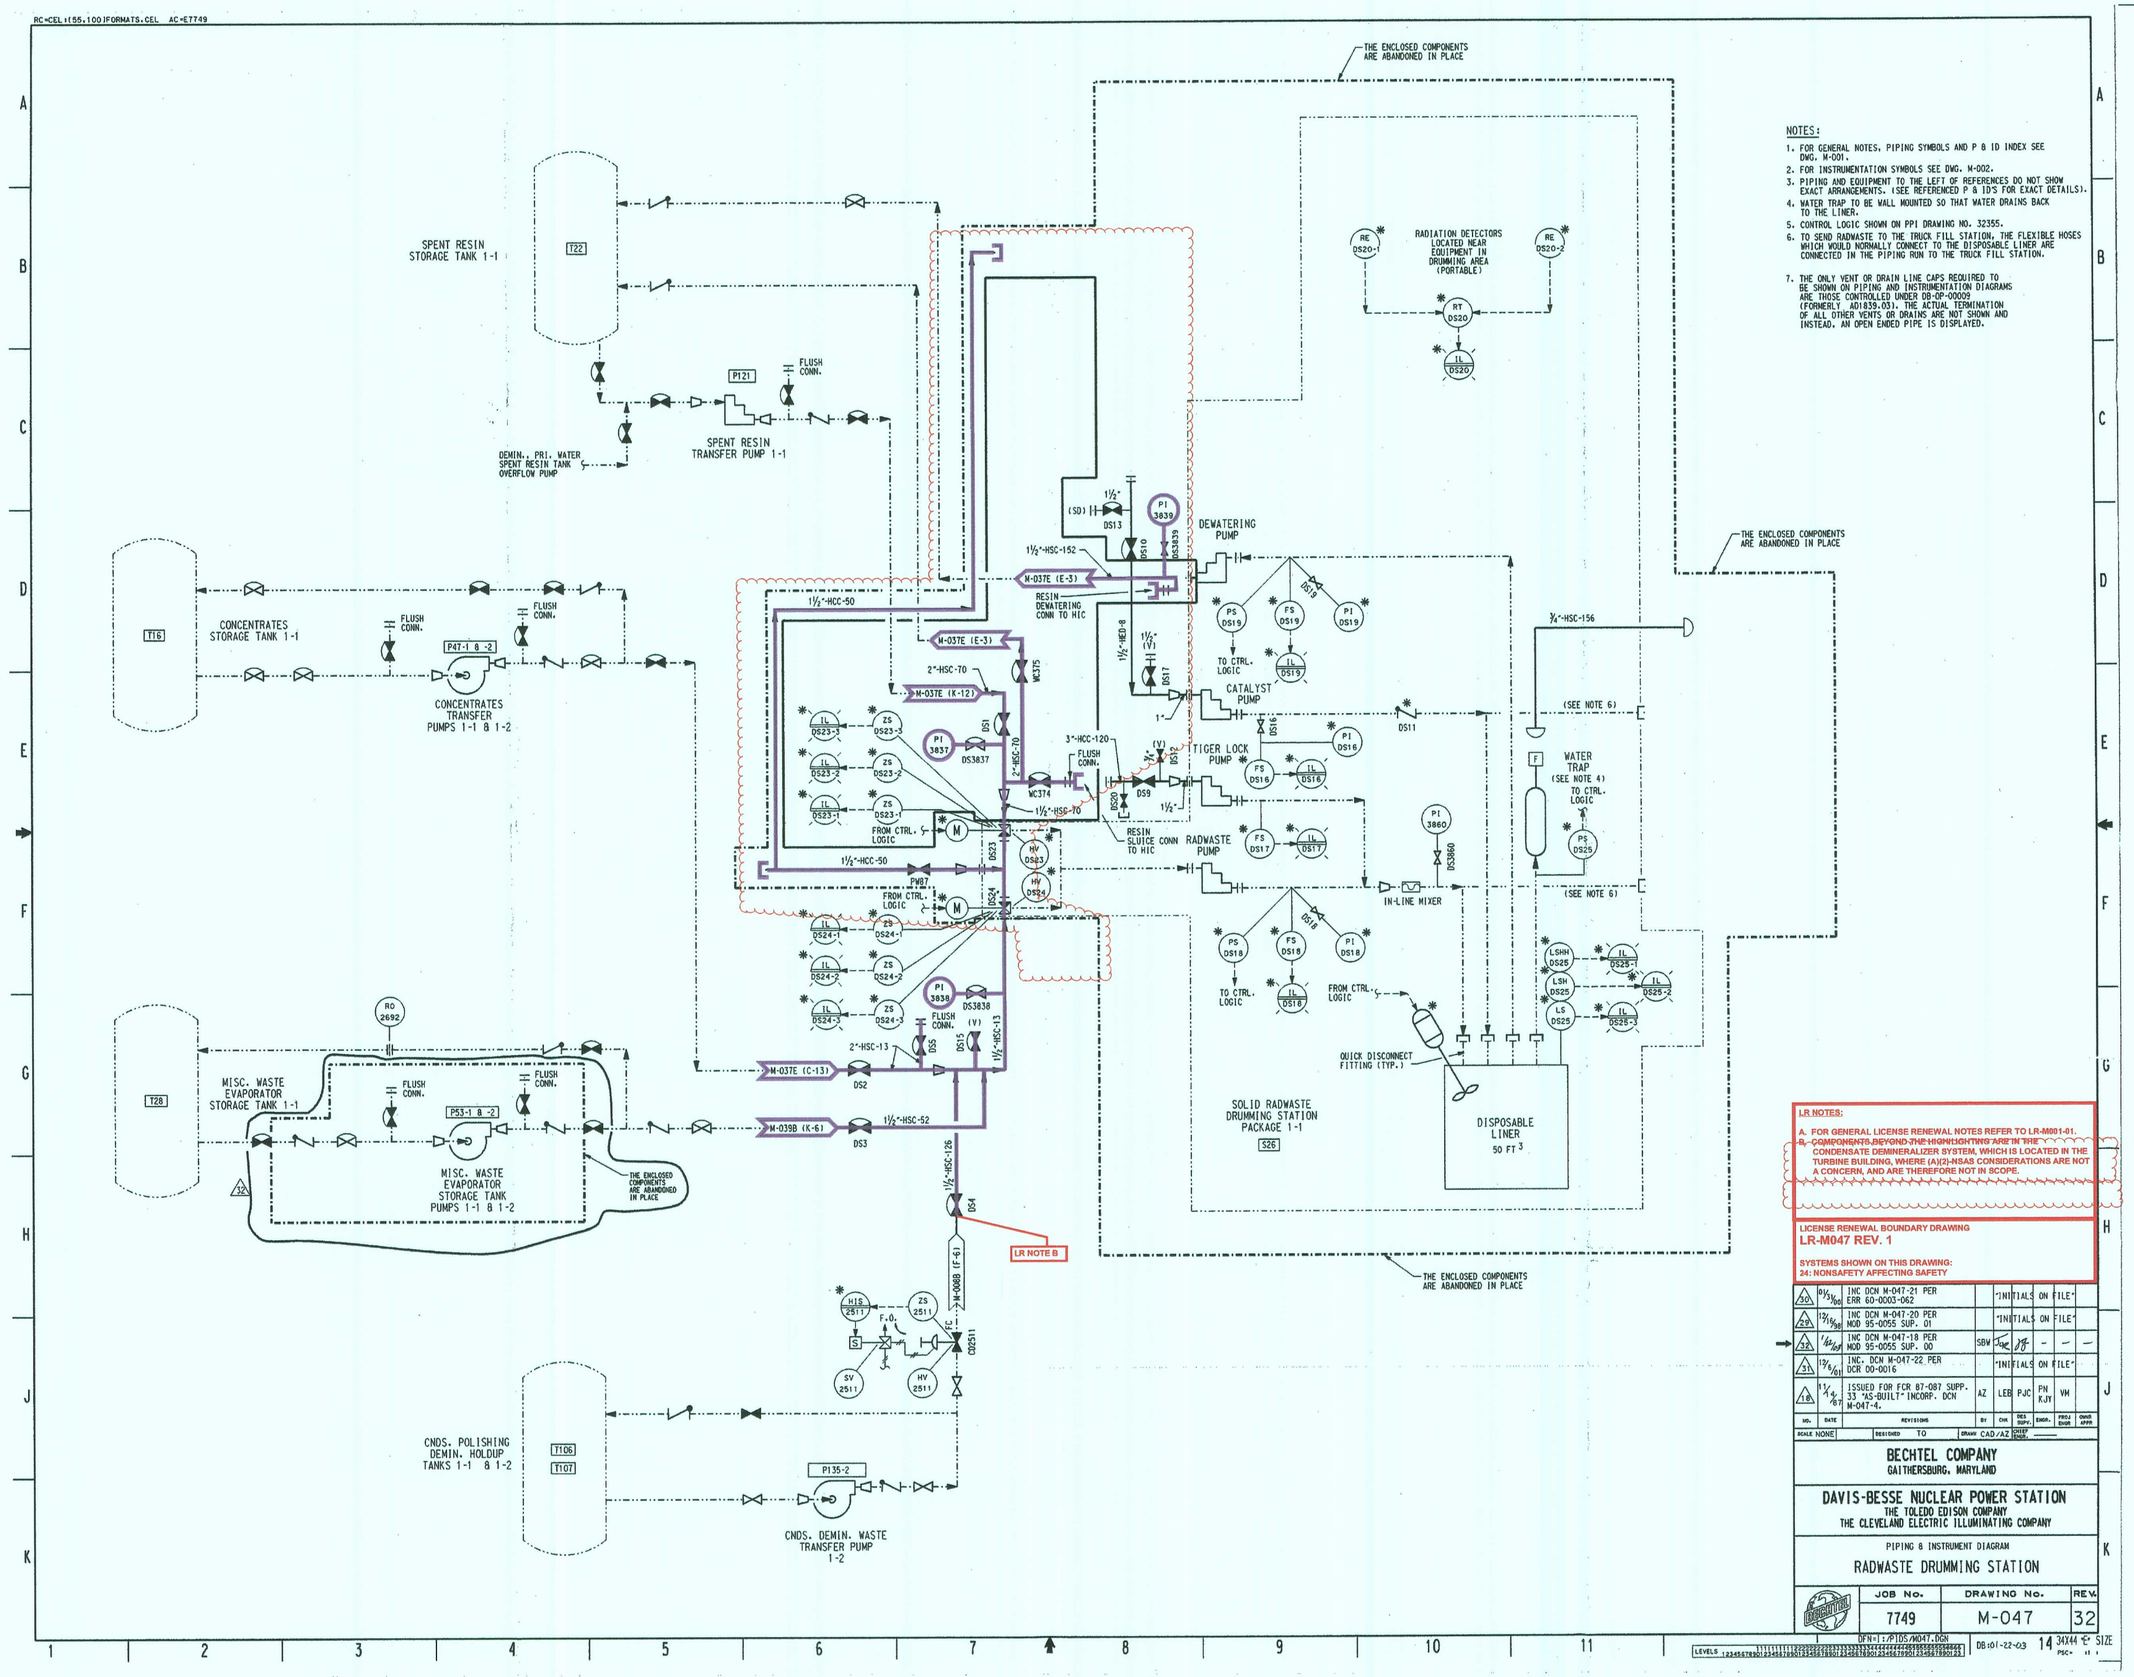

NOTES:

1. FOR GENERAL NOTES, PIPING SYMBOLS AND P & ID INDEX SEE DWG. M-001.
2. FOR INSTRUMENTATION SYMBOLS SEE DWG. M-002.
3. PIPING AND EQUIPMENT TO THE LEFT OF REFERENCES DO NOT SHOW EXACT ARRANGEMENTS. (SEE REFERENCED P & IDS FOR EXACT DETAILS).
4. WATER TRAP TO BE WALL MOUNTED SO THAT WATER DRAINS BACK TO THE LINER.
5. CONTROL LOGIC SHOWN ON PPI DRAWING NO. 32355.
6. TO SEND RADWASTE TO THE TRUCK FILL STATION, THE FLEXIBLE HOSES WHICH WOULD NORMALLY CONNECT TO THE DISPOSABLE LINER ARE CONNECTED IN THE PIPING RUN TO THE TRUCK FILL STATION.
7. THE ONLY VENT OR DRAIN LINE CAPS REQUIRED TO BE SHOWN ON PIPING AND INSTRUMENTATION DIAGRAMS ARE THOSE CONTROLLED UNDER DB-OP-00009 (FORMERLY AD1839.03). THE ACTUAL TERMINATION OF ALL OTHER VENTS OR DRAINS ARE NOT SHOWN AND INSTEAD, AN OPEN ENDED PIPE IS DISPLAYED.

LR NOTES:

A. FOR GENERAL LICENSE RENEWAL NOTES REFER TO LR-M001-01.
B. COMPONENTS BEYOND THE HIGHLIGHTING ARE IN THE CONDENSATE DEMINERALIZER SYSTEM, WHICH IS LOCATED IN THE TURBINE BUILDING, WHERE (A)(2)-NSAS CONSIDERATIONS ARE NOT A CONCERN, AND ARE THEREFORE NOT IN SCOPE.

LICENSE RENEWAL BOUNDARY DRAWING
LR-M047 REV. 1

SYSTEMS SHOWN ON THIS DRAWING:
24: NONSAFETY AFFECTING SAFETY

NO.	DATE	REVISIONS	BY	CHK	DES SUPV.	ENGR.	PROJ ENGR	OWNR APPR.
30	8/13/98	INC DCN M-047-21 PER ERR 60-0003-062	*INITIALS ON FILE*					
29	12/15/96	INC DCN M-047-20 PER MOD 95-0055 SUP. 01	*INITIALS ON FILE*					
32	1/6/99	INC DCN M-047-18 PER MOD 95-0055 SUP. 00	SBW	JWC	JJG	–	–	–
31	12/6/91	INC. DCN M-047-22 PER DCR 00-0016	*INITIALS ON FILE*					
18	11/4/87	ISSUED FOR FCR 87-087 SUPP. 33 "AS-BUILT" INCORP. DCN M-047-4.	AZ	LEB	PJC	FN KJY	VM	

SCALE NONE | DESIGNED TO | DRAWN CAD/AZ | CHECKED

BECHTEL COMPANY
GAITHERSBURG, MARYLAND

DAVIS-BESSE NUCLEAR POWER STATION
THE TOLEDO EDISON COMPANY
THE CLEVELAND ELECTRIC ILLUMINATING COMPANY

PIPING & INSTRUMENT DIAGRAM
RADWASTE DRUMMING STATION

JOB No.	DRAWING No.	REV.
7749	M-047	32

DFN=1:/PIDS/M047.DGN DB:01-22-03 14 34X44 E SIZE

01D63