ANALYZE FOR **SAFETY, ECOLOGY AND MINIMUM ESSENTIAL DESIGN**

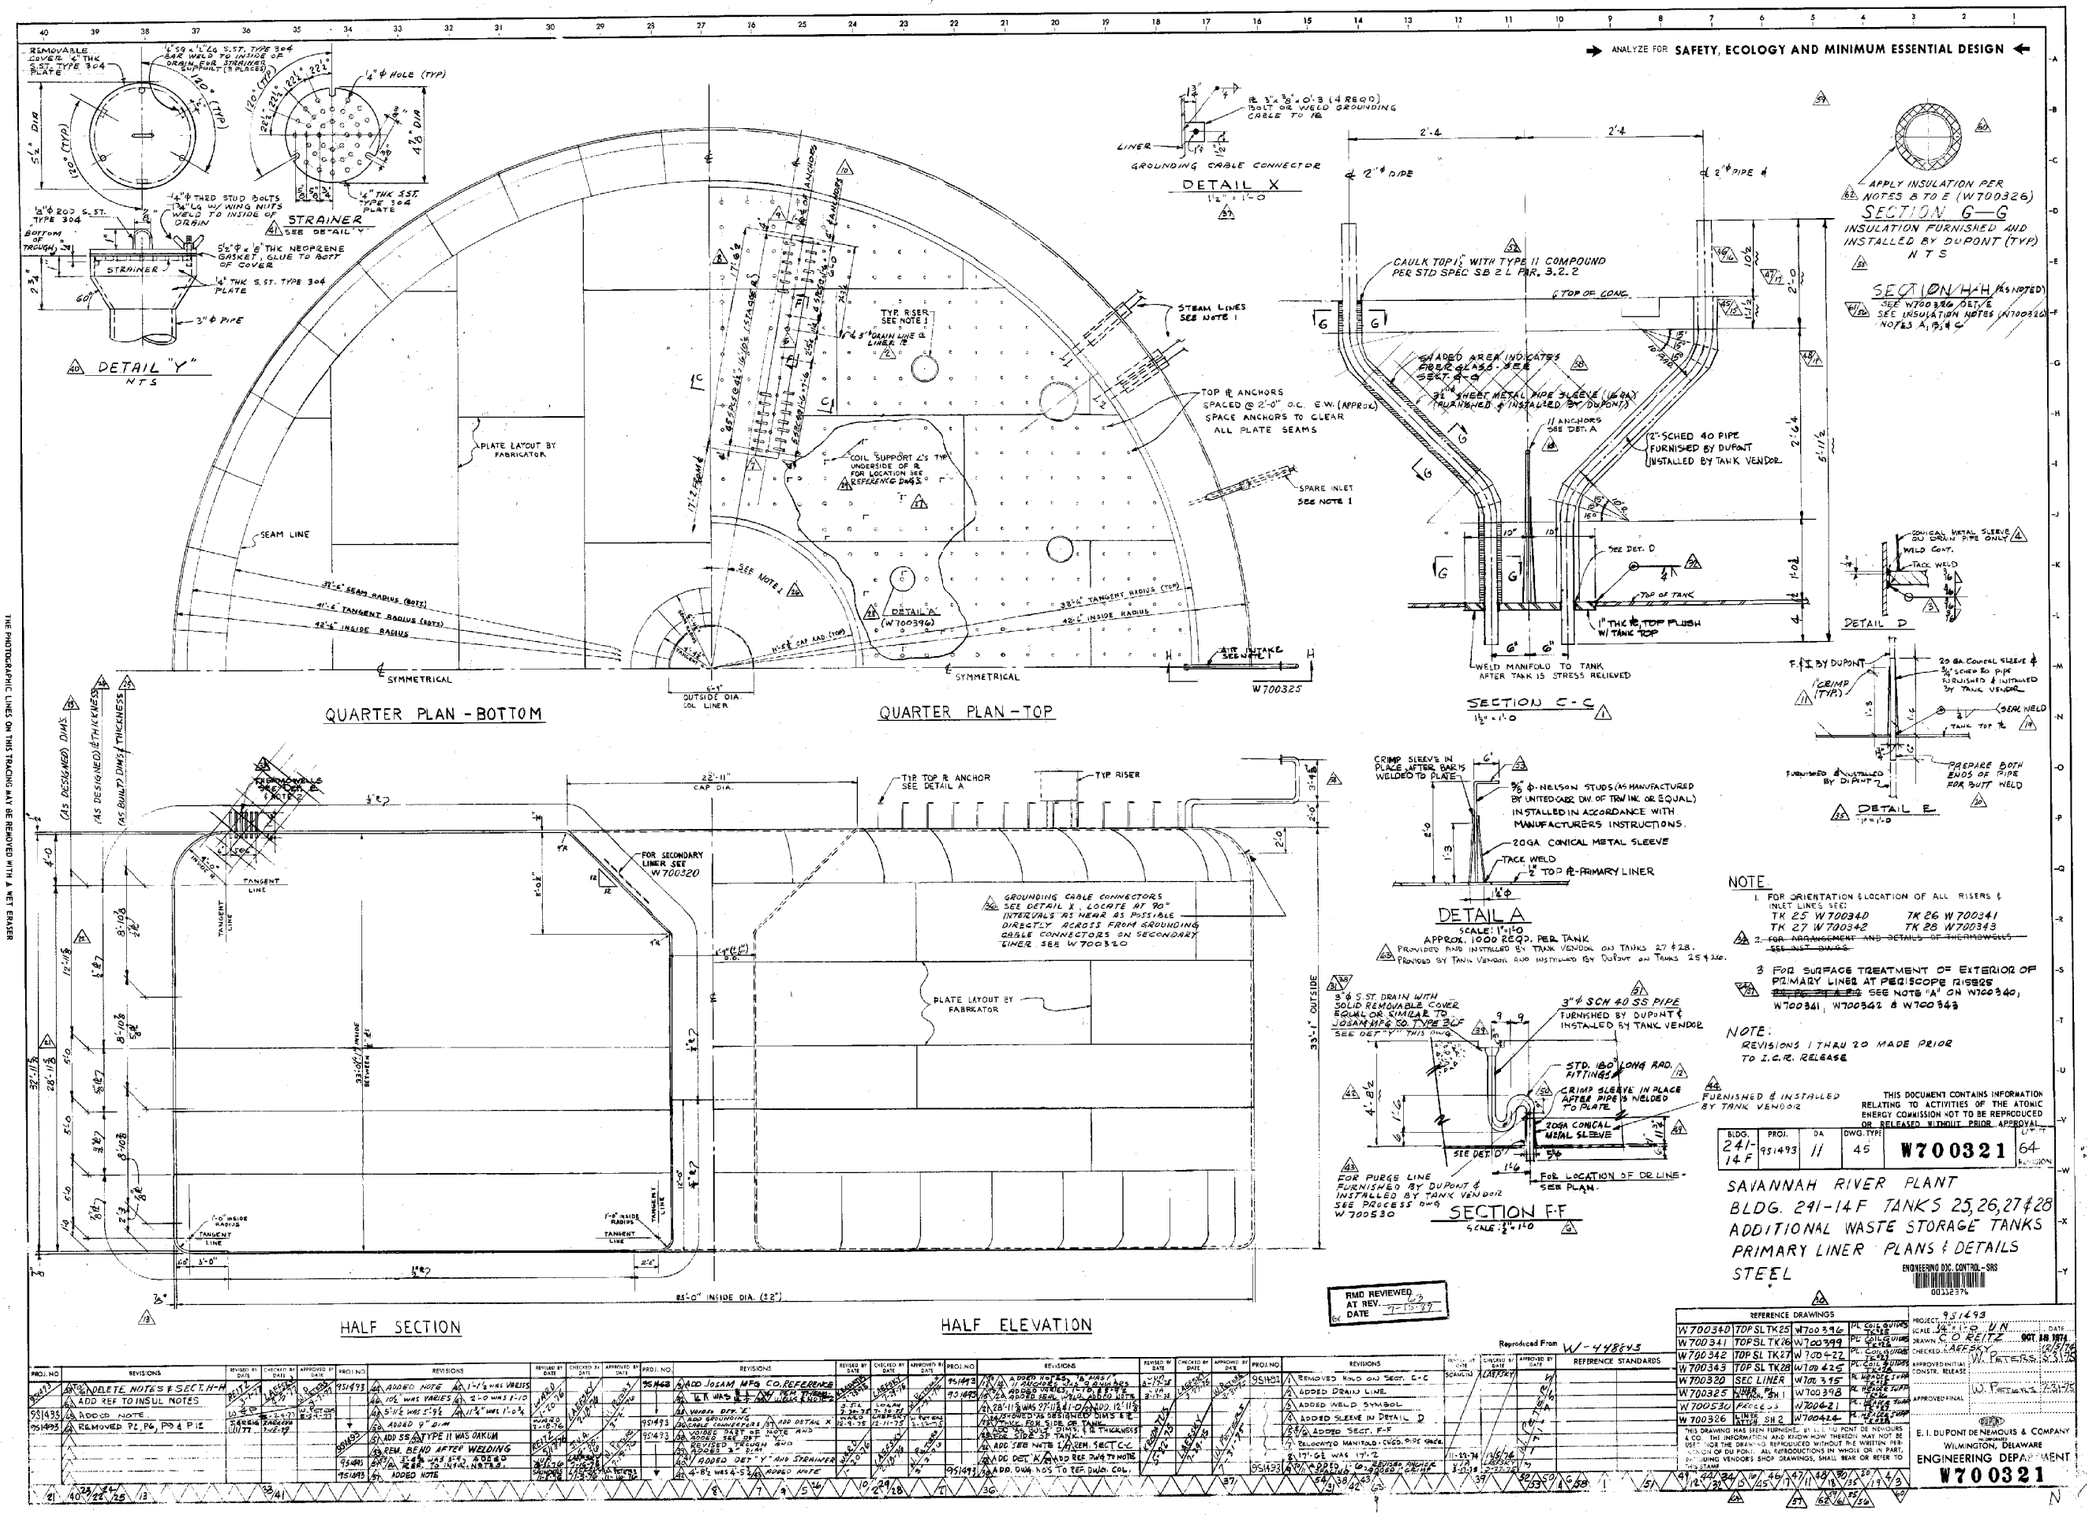

NOTE

1. FOR ORIENTATION & LOCATION OF ALL RISERS & INLET LINES SEE:
   TK 25 W700340 — TK 26 W700341
   TK 27 W700342 — TK 28 W700343
2. ~~FOR ARRANGEMENT AND DETAILS OF THERMOWELLS SEE INST DWGS~~
3. FOR SURFACE TREATMENT OF EXTERIOR OF PRIMARY LINER AT PERISCOPE RISERS ~~SEE PC PLAN~~ SEE NOTE "A" ON W700340, W700341, W700342 & W700343

NOTE:
REVISIONS 1 THRU 20 MADE PRIOR TO I.C.R. RELEASE

THIS DOCUMENT CONTAINS INFORMATION RELATING TO ACTIVITIES OF THE ATOMIC ENERGY COMMISSION NOT TO BE REPRODUCED OR RELEASED WITHOUT PRIOR APPROVAL

BLDG.	PROJ.	DA	DWG. TYPE		REVISION
241-14F	951493	11	45	W700321	64

SAVANNAH RIVER PLANT
BLDG. 241-14F TANKS 25, 26, 27 & 28
ADDITIONAL WASTE STORAGE TANKS
PRIMARY LINER PLANS & DETAILS
STEEL

ENGINEERING DIV. CONTROL - SRS
0031837

RMD REVIEWED AT REV. ___ DATE 11-13-79

Reproduced From W-448643

REFERENCE DRAWINGS			
W700340	TOP SL TK25	W700396	PL COIL SUPPORTS
W700341	TOP SL TK26	W700399	PL COIL SUPPORTS
W700342	TOP SL TK27	W700422	PL COIL SUPPORTS
W700343	TOP SL TK28	W700425	PL COIL SUPPORTS
W700320	SEC LINER	W700395	PL INSTALL PIPE
W700325	TANK PL SH 1	W700398	PL INSTALL PIPE
W700530	PROCESS	W700421	PL INSTALL PIPE
W700326	LINER DETAILS SH 2	W700424	PL INSTALL PIPE

REFERENCE STANDARDS

PROJECT	951493
SCALE	1/2"=1'-0
DRAWN	C. O. REITZ — OCT 18 1974
CHECKED	L. A. PERSKY — 12/6/74
APPROVED INITIAL CONSTR. RELEASE	W. PETERS — 12/3/74
APPROVED FINAL	W. PETERS — 2/3/75

THIS DRAWING HAS BEEN FURNISHED BY E. I. DU PONT DE NEMOURS & CO. THE INFORMATION AND KNOWHOW THEREIN MAY NOT BE USED FOR THE DRAWING REPRODUCED WITHOUT THE WRITTEN PERMISSION OF DU PONT. ALL REPRODUCTIONS IN WHOLE OR IN PART, INCLUDING VENDORS SHOP DRAWINGS, SHALL BEAR OR REFER TO THIS STAMP

E. I. DUPONT DE NEMOURS & COMPANY
WILMINGTON, DELAWARE
ENGINEERING DEPARTMENT
W700321

THE PHOTOGRAPHIC LINES ON THIS TRACING MAY BE REMOVED WITH A WET ERASER