


This drawing and the design it covers are the property of BECHTEL. They are hereby loaned and on the borrower's express agreement that they will not be reproduced, copied, loaned, exhibited, or used except in the limited way and private use permitted by any written consent given by the lender to the borrower.

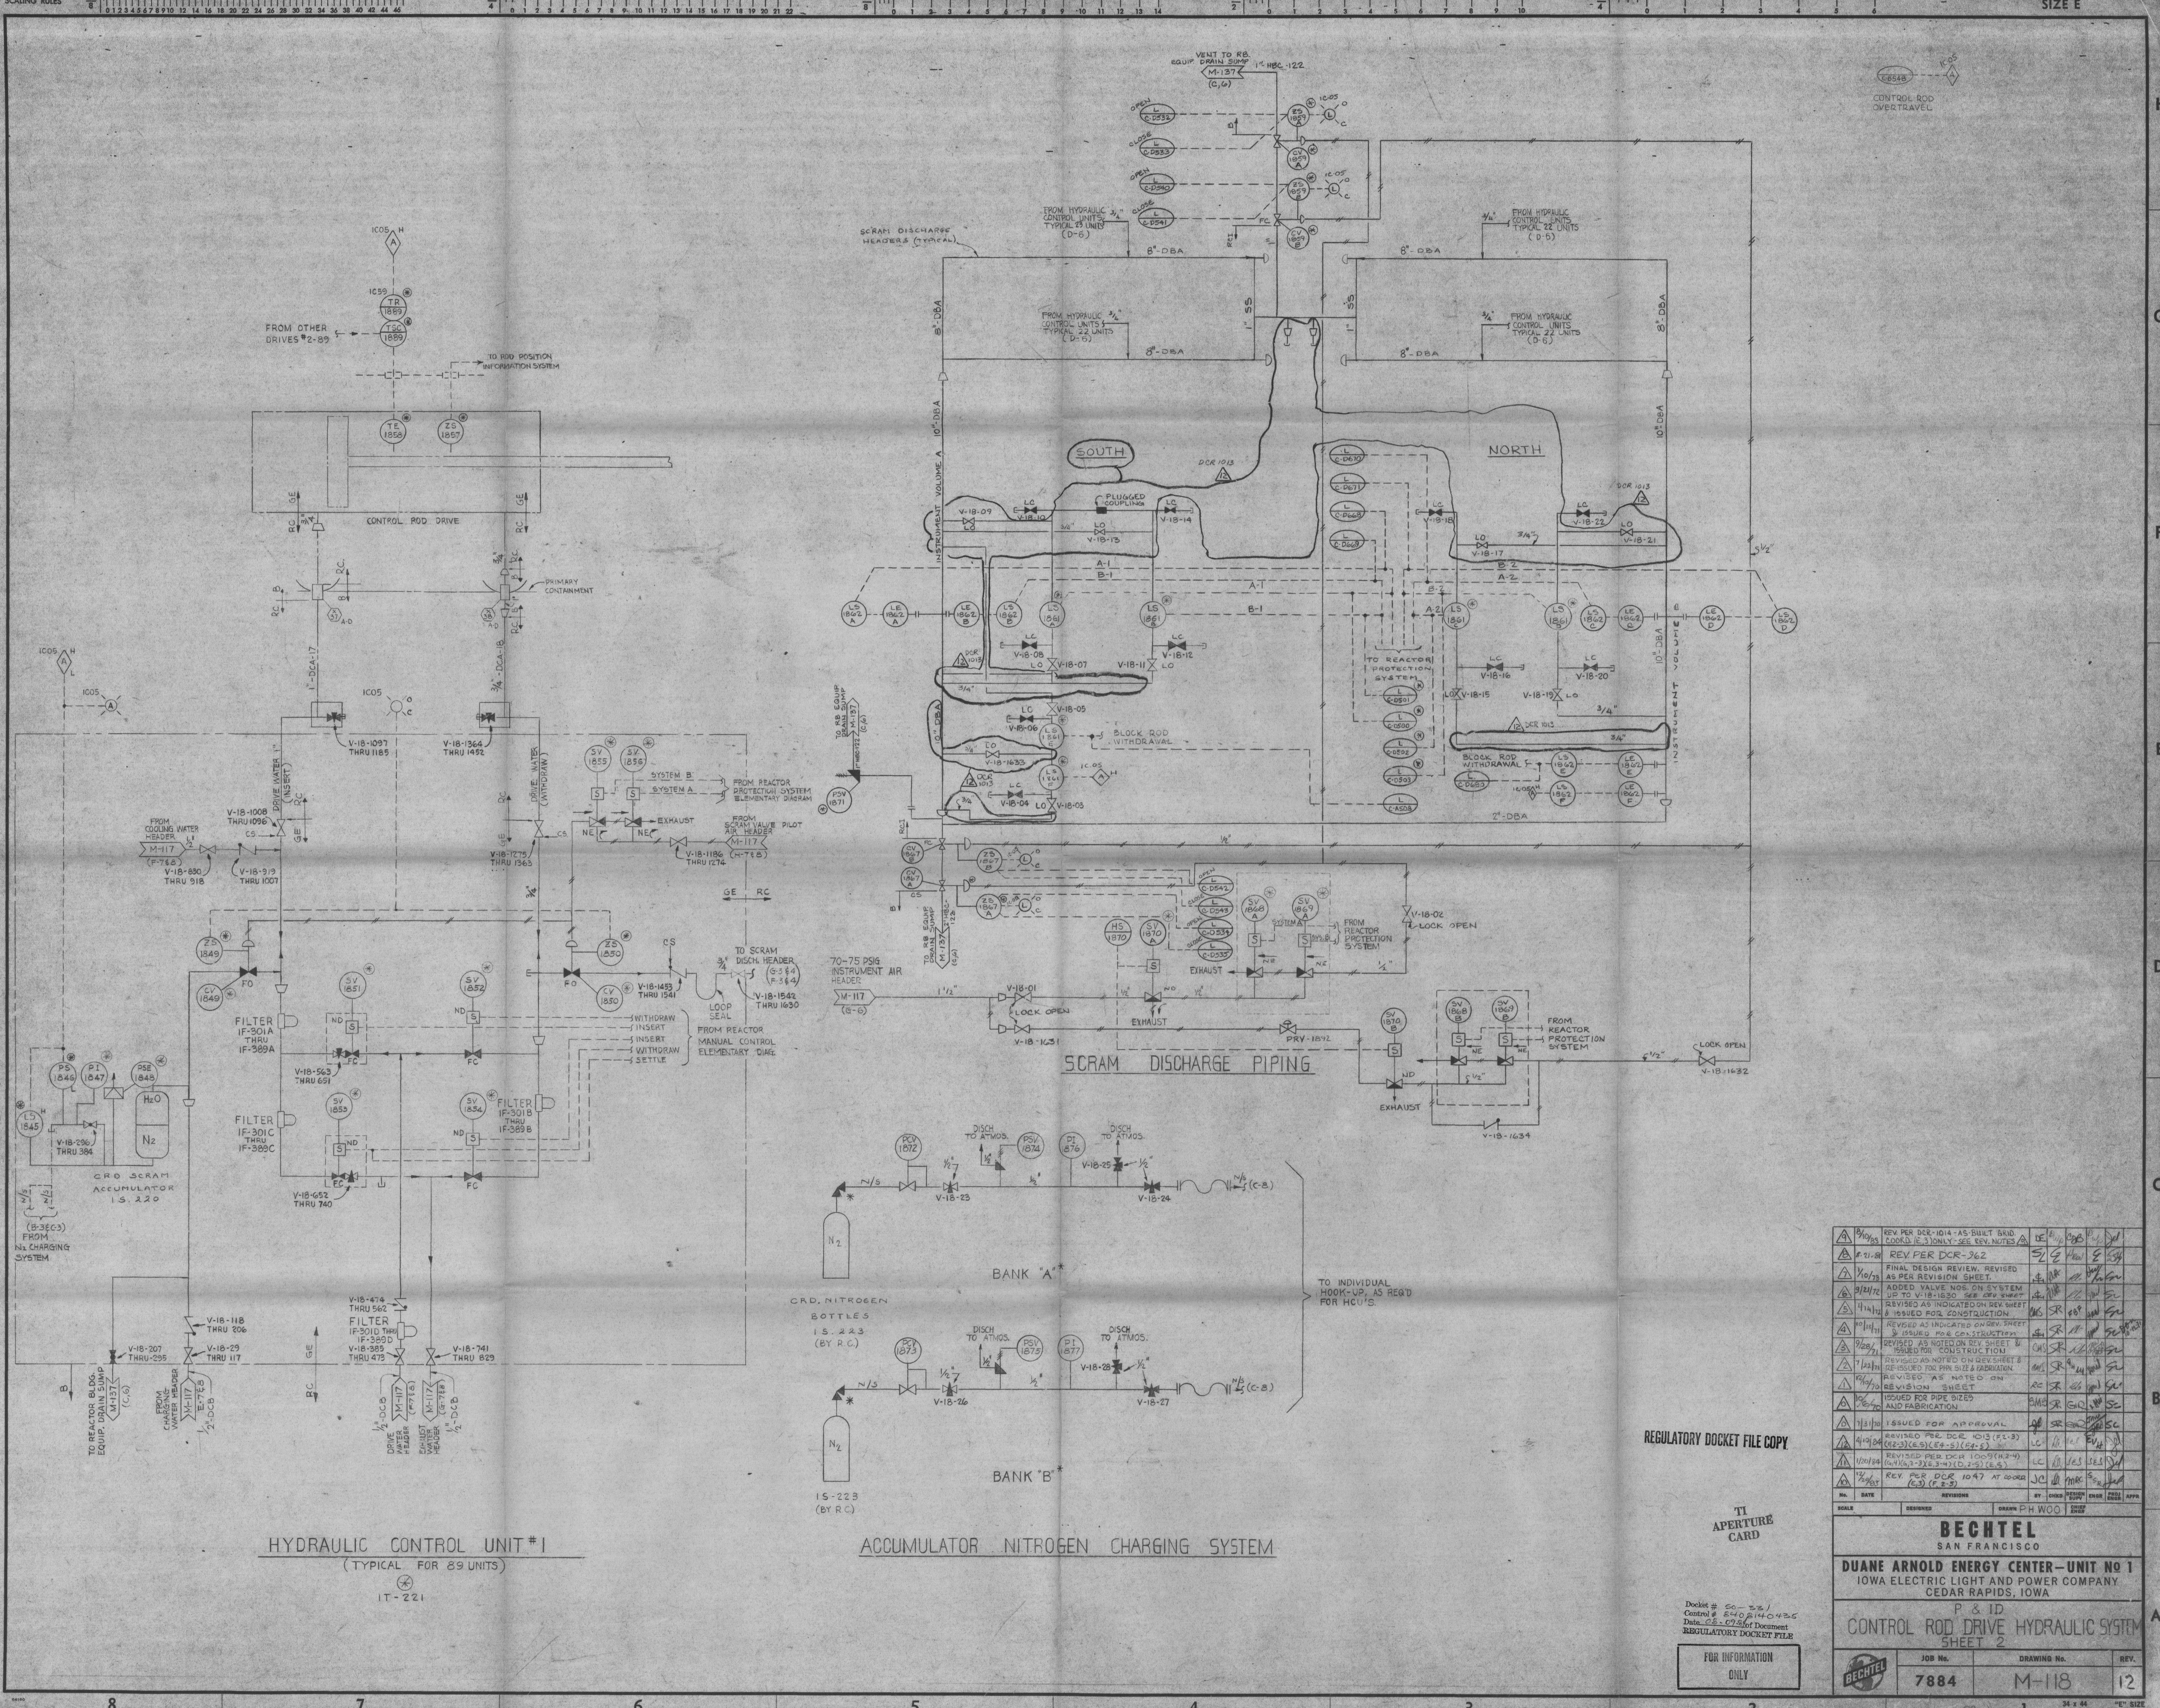

HYDRAULIC CONTROL UNIT #1
(TYPICAL FOR 89 UNITS)
IT-221

ACCUMULATOR NITROGEN CHARGING SYSTEM

NO.	DATE	REVISIONS	BY	CHECK	DESIGN	ENGR	DRWG	APPR

REGULATORY DOCKET FILE COPY

TI APERTURE CARD

BECHTEL
SAN FRANCISCO

DUANE ARNOLD ENERGY CENTER—UNIT NO 1
IOWA ELECTRIC LIGHT AND POWER COMPANY
CEDAR RAPIDS, IOWA

P & ID
CONTROL ROD DRIVE HYDRAULIC SYSTEM
SHEET 2

JOB No.	DRAWING No.	REV.
7884	M-118	12

FOR INFORMATION ONLY

Docket # 50-221
Control # 640 B140425
Data # 68-07264 Document
REGULATORY DOCKET FILE