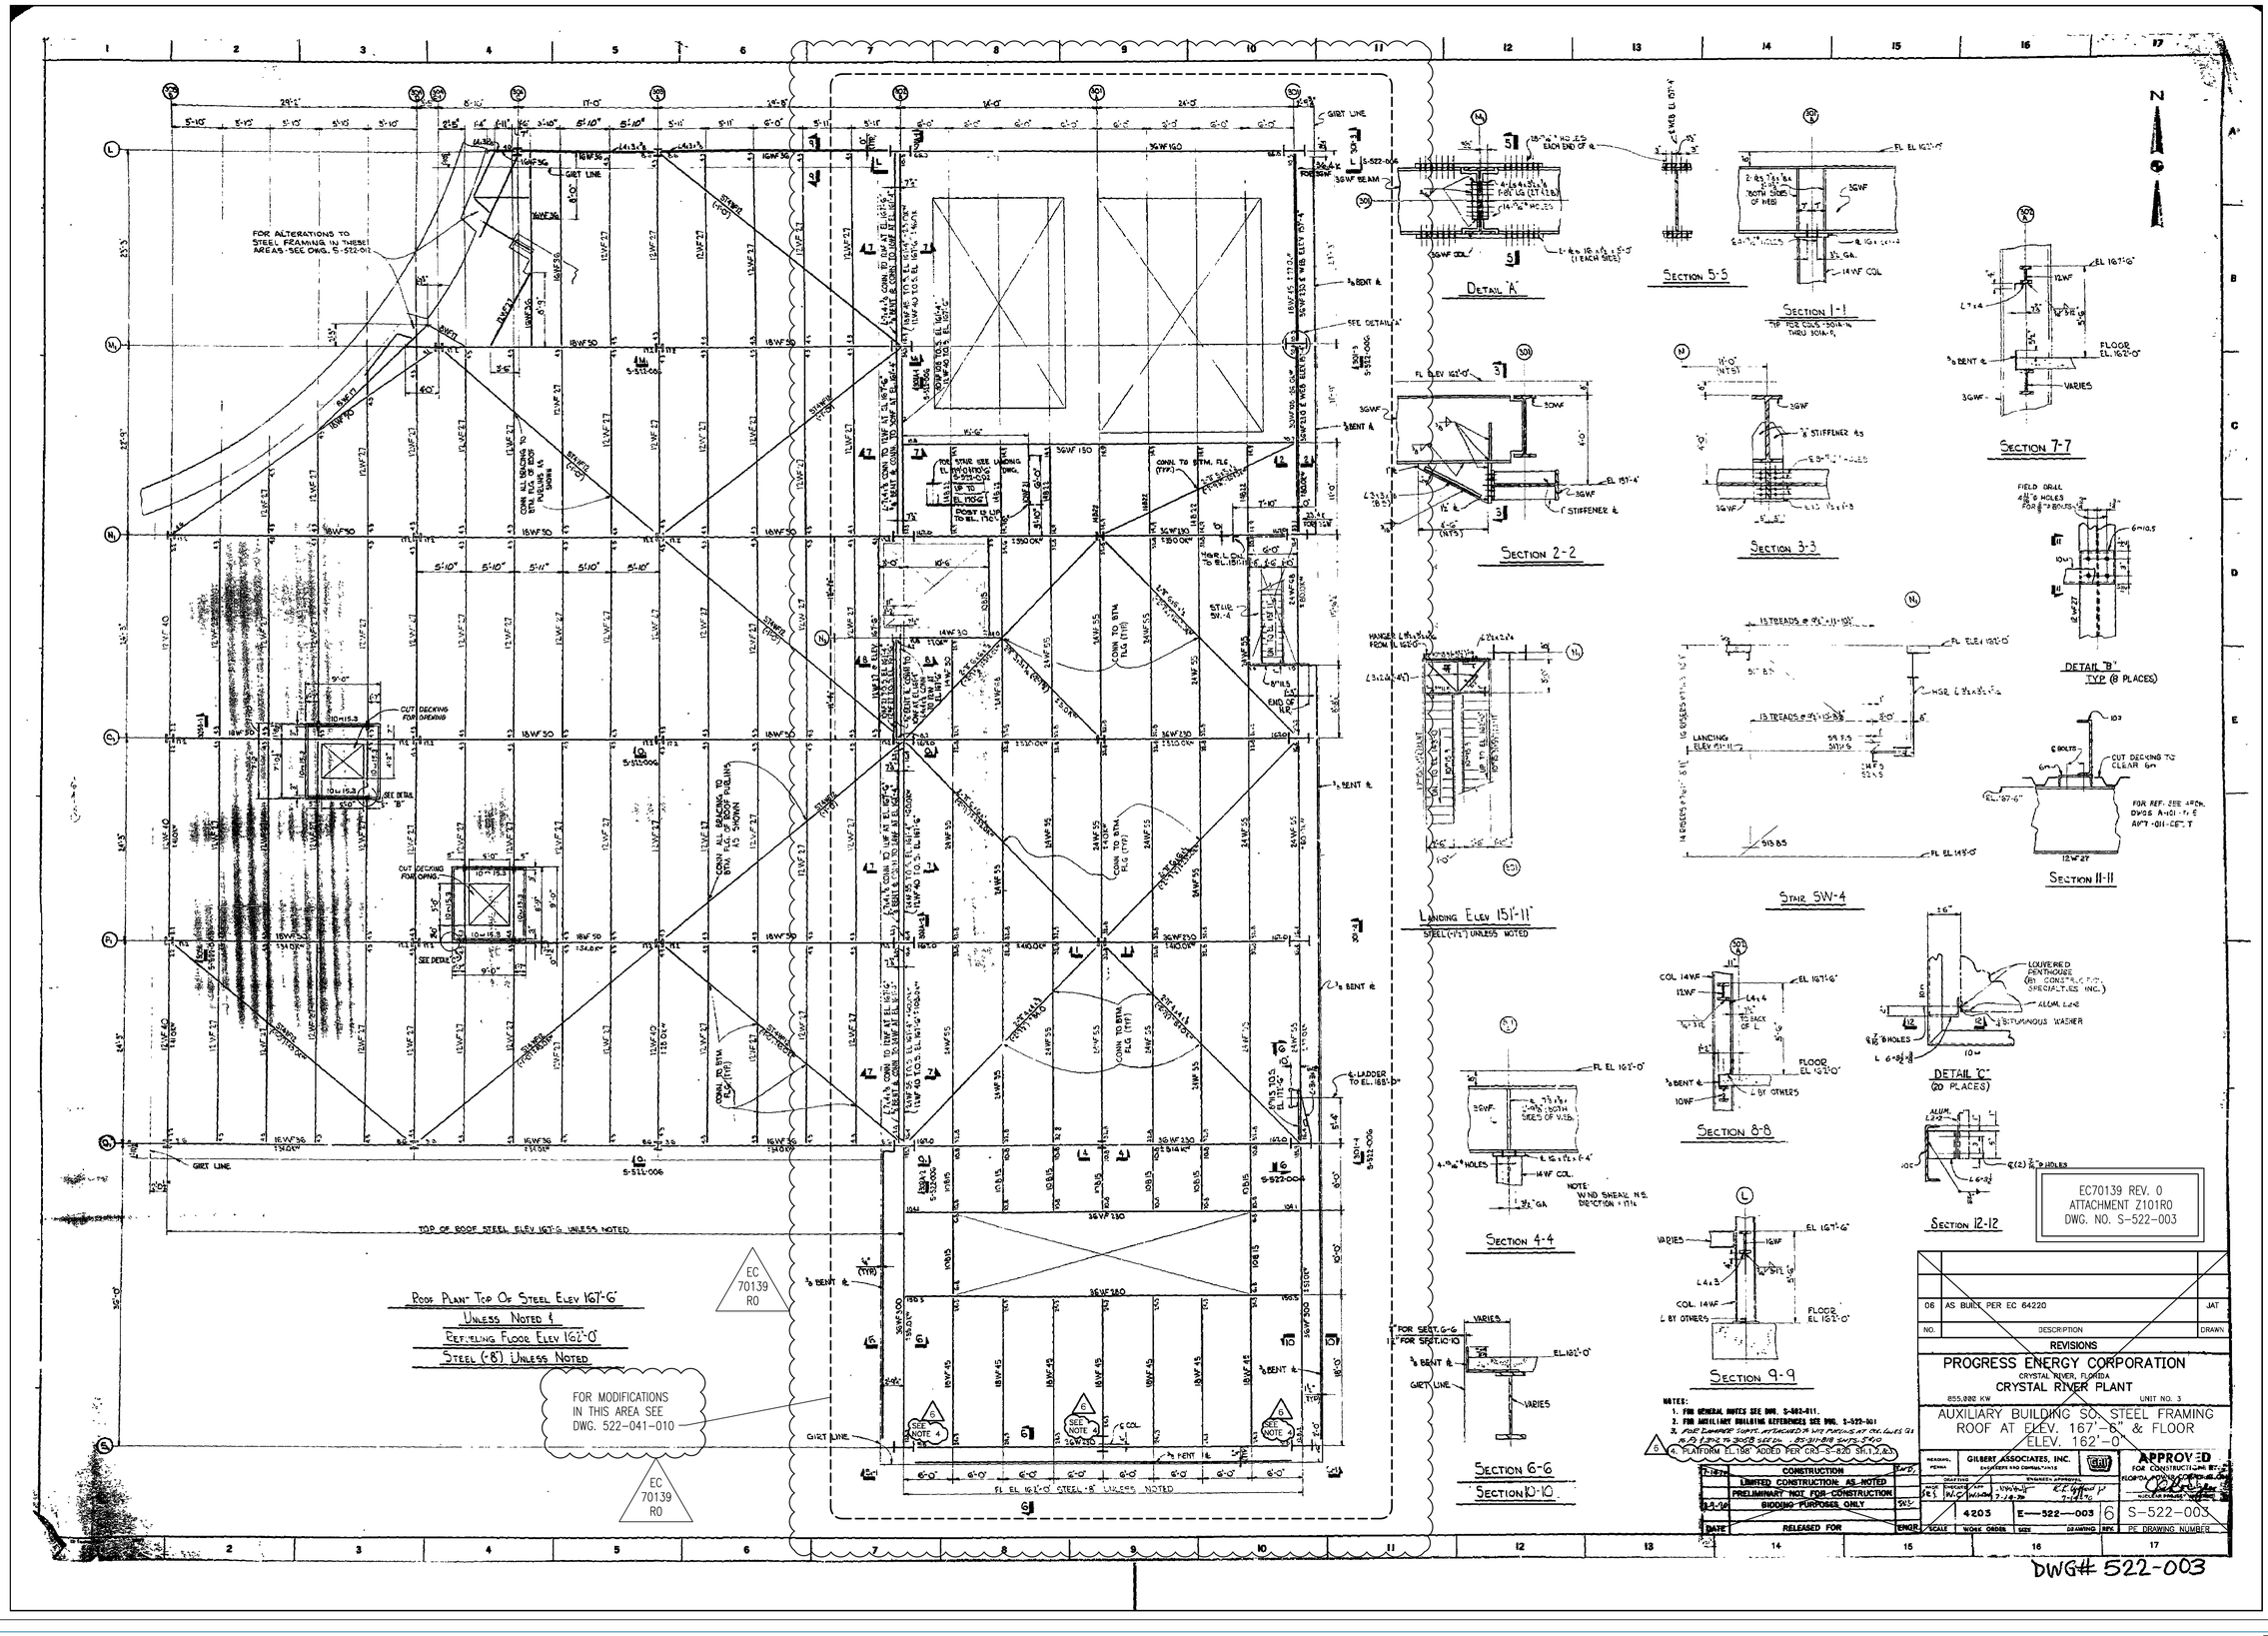
Roof Plan - Top Of Steel Elev 167'-6"
Unless Noted &
Refueling Floor Elev 162'-0"
Steel (-8") Unless Noted
FOR MODIFICATIONS IN THIS AREA SEE DWG. 522-041-010
EC 70139 R0
Detail "A"
Section 5-5
Section 1-1
Section 7-7
Section 2-2
Section 3-3
Detail "B" TYP (8 PLACES)
Landing Elev 151'-11"
Stair SW-4
Section 11-11
Section 8-8
Detail "C" (20 PLACES)
Section 4-4
Section 12-12
Section 9-9
Section 6-6
Section 10-10
EC70139 REV. 0
ATTACHMENT Z101R0
DWG. NO. S-522-003
06 AS BUILT PER EC 64220 JAT
REVISIONS
PROGRESS ENERGY CORPORATION
CRYSTAL RIVER, FLORIDA
CRYSTAL RIVER PLANT
855,000 KW UNIT NO. 3
AUXILIARY BUILDING SO. STEEL FRAMING
ROOF AT ELEV. 167'-6" & FLOOR
ELEV. 162'-0"
GILBERT ASSOCIATES, INC.
APPROVED
CONSTRUCTION
LIMITED CONSTRUCTION AS NOTED
PRELIMINARY NOT FOR CONSTRUCTION
BIDDING PURPOSES ONLY
RELEASED FOR
4203 E-522-003 6 S-522-003
PE DRAWING NUMBER
DWG# 522-003