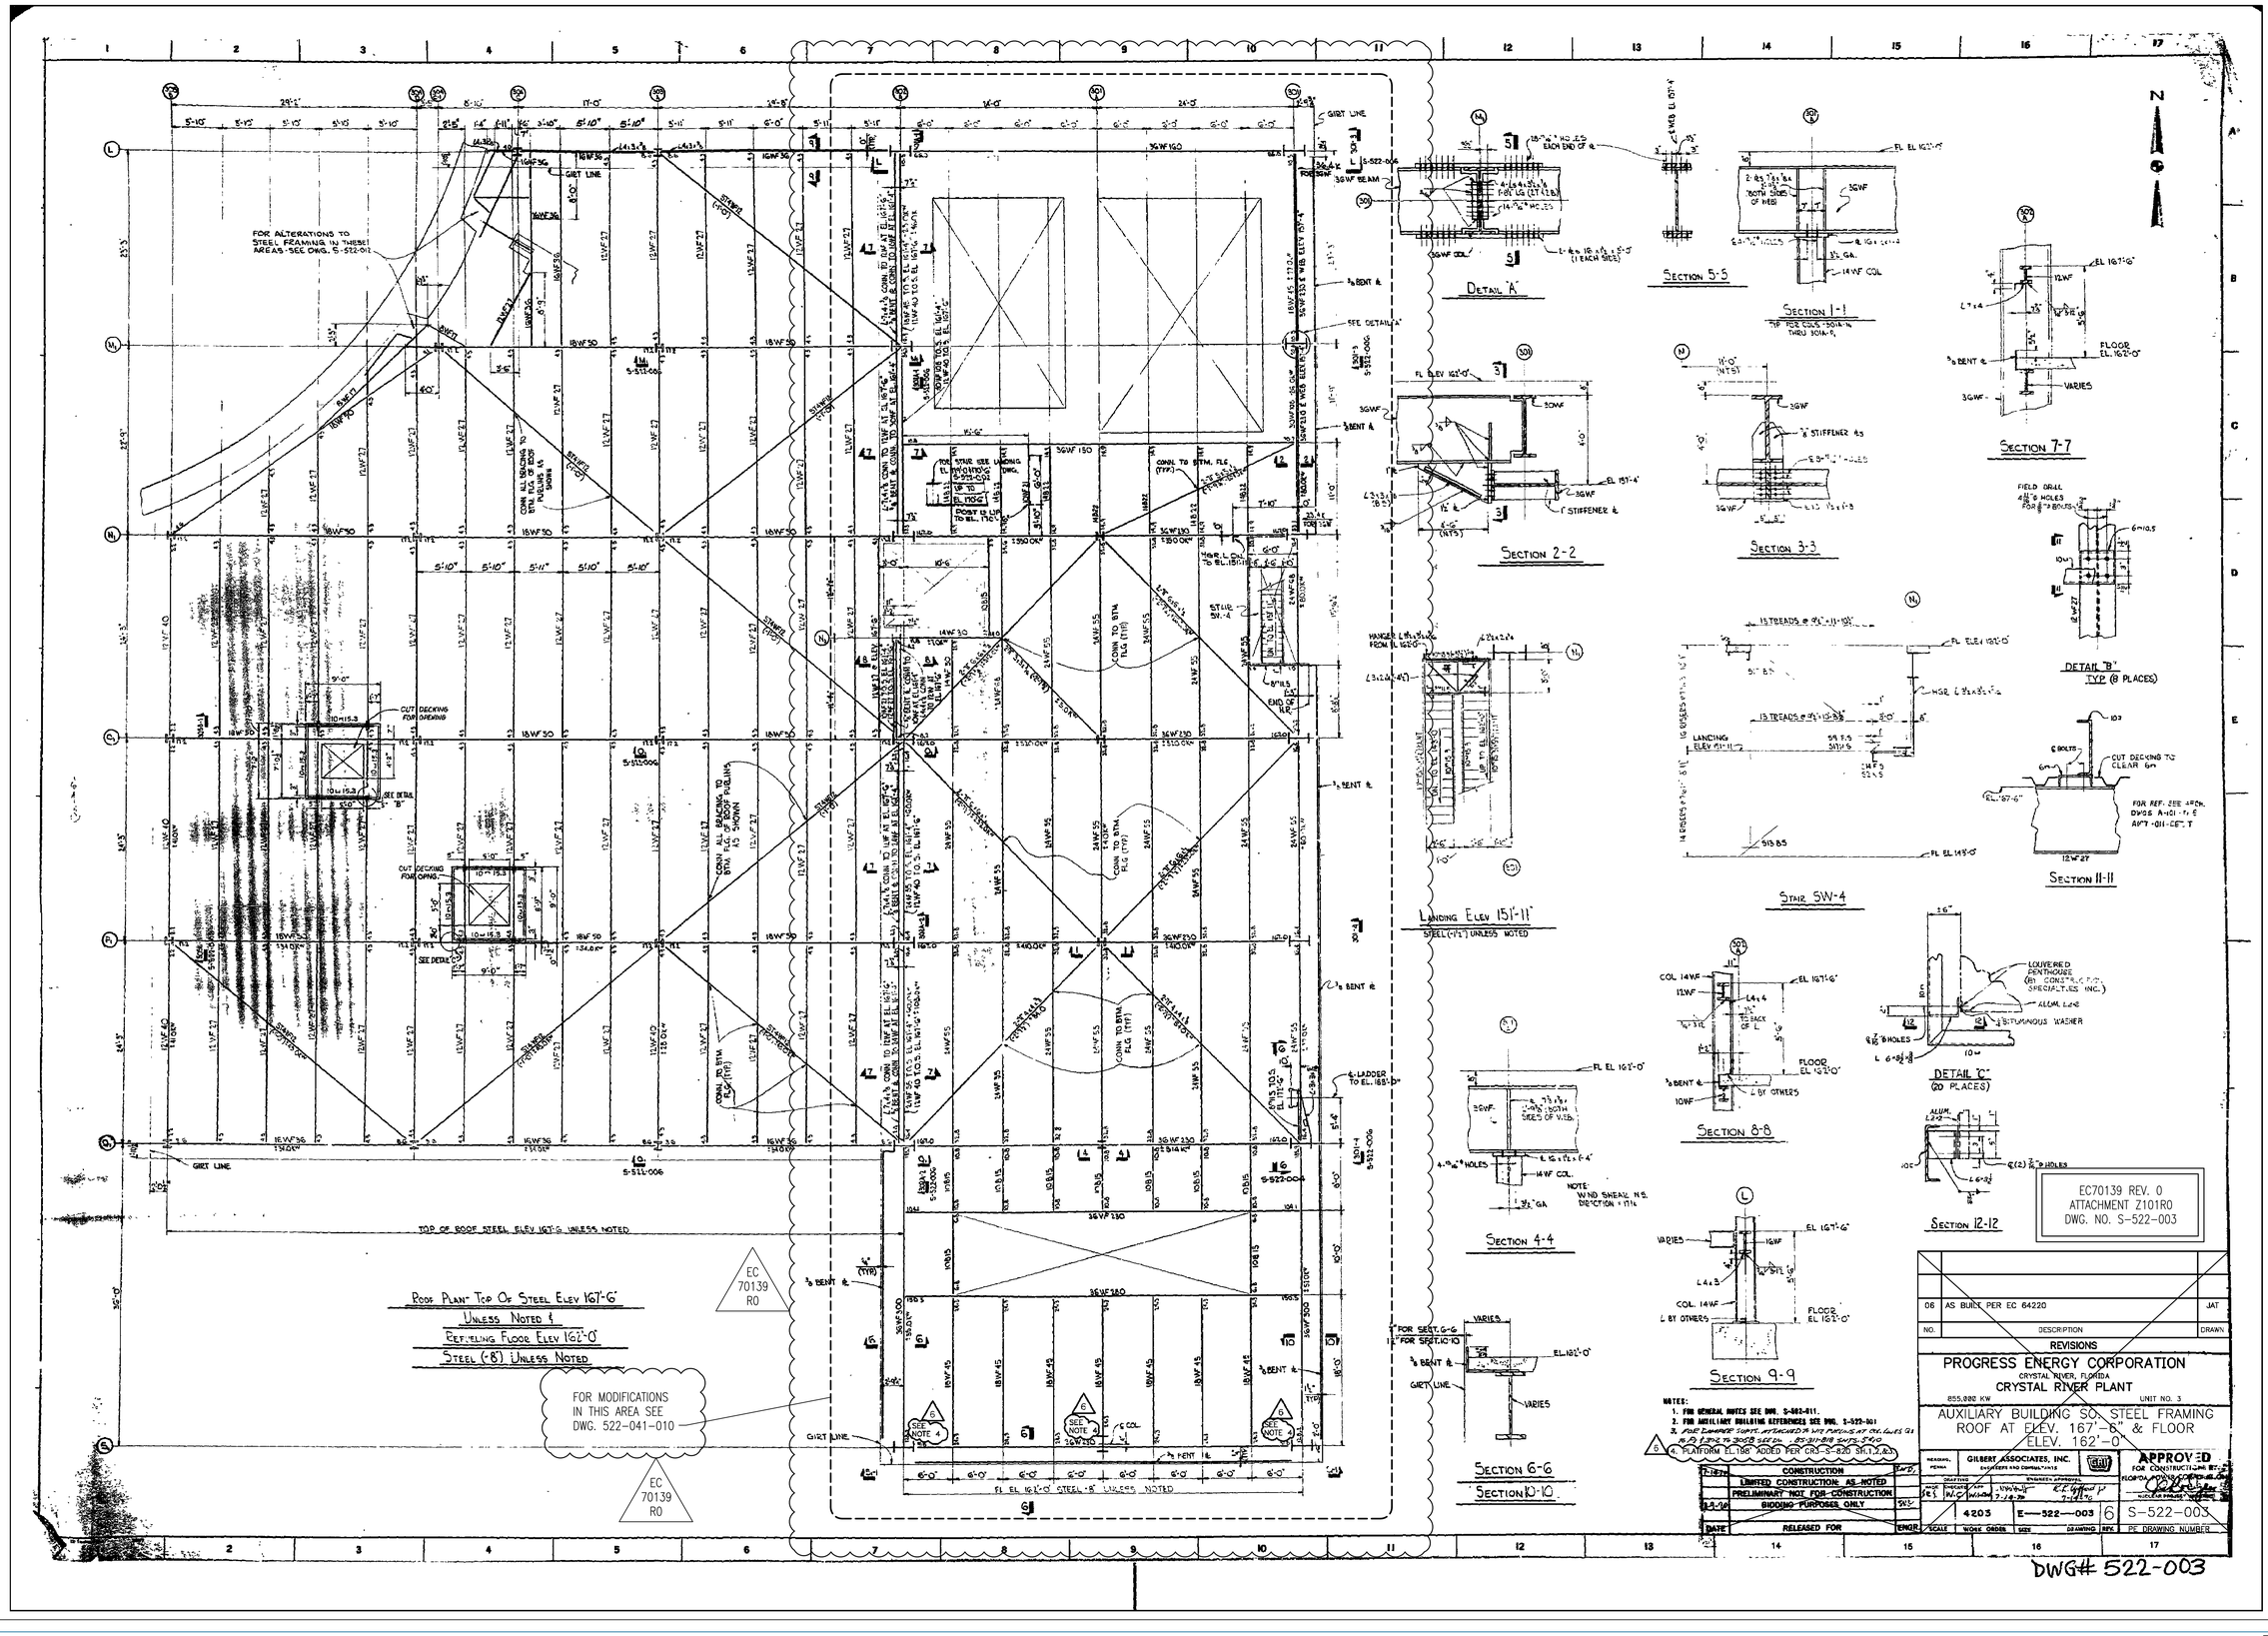
ROOF PLAN TOP OF STEEL ELEV 167'-6" UNLESS NOTED & REFUELING FLOOR ELEV 162'-0" STEEL (-8") UNLESS NOTED
TOP OF ROOF STEEL ELEV 167'-6 UNLESS NOTED
FL EL 162'-0" STEEL -8" UNLESS NOTED
FOR ALTERATIONS TO STEEL FRAMING IN THESE AREAS SEE DWG. S-522-012
FOR MODIFICATIONS IN THIS AREA SEE DWG. 522-041-010
EC 70139 R0
DETAIL 'A'
SECTION 2-2
SECTION 3-3
SECTION 4-4
SECTION 5-5
SECTION 6-6
SECTION 7-7
SECTION 8-8
SECTION 9-9
SECTION 10-10
SECTION 11-11
SECTION 12-12
SECTION 1-1
DETAIL 'B' TYP (@ PLACES)
DETAIL 'C' (20 PLACES)
STAIR SW-4
LANDING ELEV 151'-11"
NOTES:
1. FOR GENERAL NOTES SEE DWG. S-002-011.
2. FOR AUXILIARY BUILDING REFERENCES SEE DWG. S-522-001
4. PLATFORM EL 138' ADDED PER CRS-S-820 SH. 1, 2 & 3.
EC70139 REV. 0
ATTACHMENT Z101R0
DWG. NO. S-522-003
06 AS BUILT PER EC 64220 JAT
REVISIONS
PROGRESS ENERGY CORPORATION
CRYSTAL RIVER, FLORIDA
CRYSTAL RIVER PLANT
855,000 KW UNIT NO. 3
AUXILIARY BUILDING SO. STEEL FRAMING ROOF AT ELEV. 167'-6" & FLOOR ELEV. 162'-0"
GILBERT ASSOCIATES, INC.
CONSTRUCTION
LIMITED CONSTRUCTION AS NOTED
PRELIMINARY NOT FOR CONSTRUCTION
BIDDING PURPOSES ONLY
RELEASED FOR
APPROVED
4203 E—522—003 6 S-522-003
DWG# 522-003