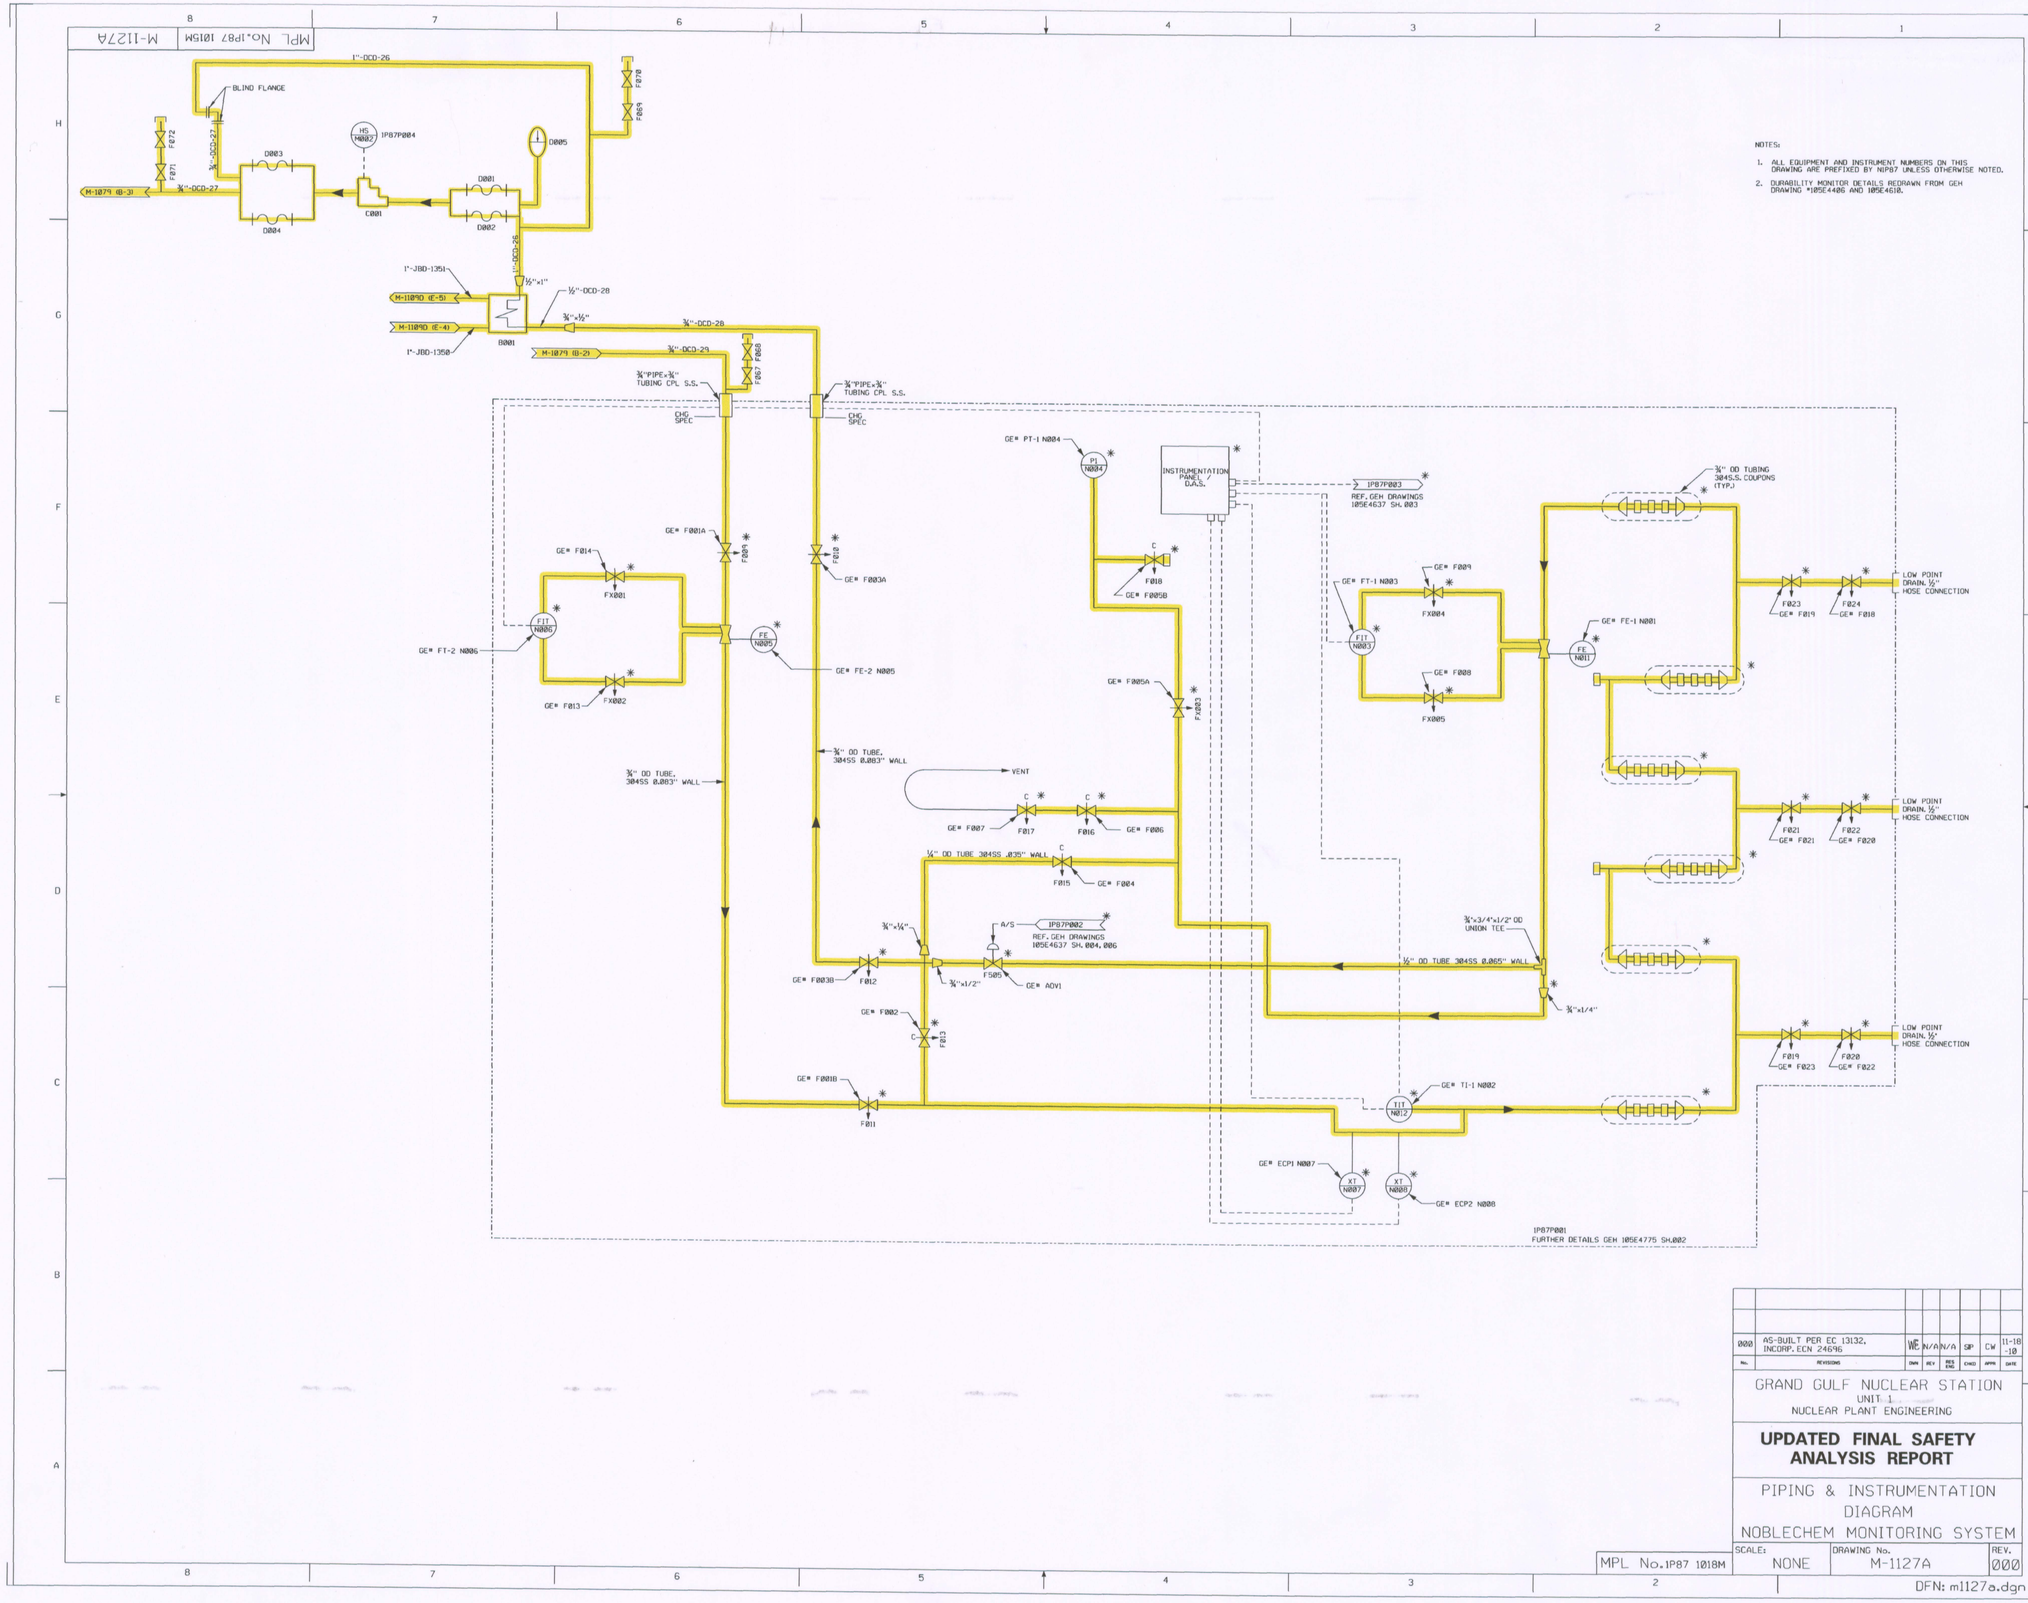

NOTES:

1. ALL EQUIPMENT AND INSTRUMENT NUMBERS ON THIS DRAWING ARE PREFIXED BY N1P87 UNLESS OTHERWISE NOTED.
2. DURABILITY MONITOR DETAILS REDRAWN FROM GEH DRAWING #105E4406 AND 105E4610.

COMPONENTS SUBJECT TO AMR

NON-SAFETY RELATED SYSTEMS & COMPONENTS AFFECTING SAFETY RELATED SYSTEMS AMM20

No.	REVISIONS	DWN	REV	RES ENG	CHKD	APPR	DATE
000	AS-BUILT PER EC 13132, INCORP. ECN 24696	WE	N/A	N/A	SP	CW	11-18-10

GRAND GULF NUCLEAR STATION
UNIT 1
NUCLEAR PLANT ENGINEERING

UPDATED FINAL SAFETY ANALYSIS REPORT

PIPING & INSTRUMENTATION DIAGRAM
NOBLECHEM MONITORING SYSTEM

NO.	DATE	DESCRIPTION	BY	ENG	CHK	APP
0	10-13-2011	.	.	.	.	.

REVISIONS

LRA-M-1127A

CAD FILE m1127a.DGN

RASTER FILE

MPL No.1P87 1018M

SCALE: NONE

DRAWING No. M-1127A

REV. 000

DFN: m1127a.dgn

D102