MPL NO.SP64 1015M | M-0035C

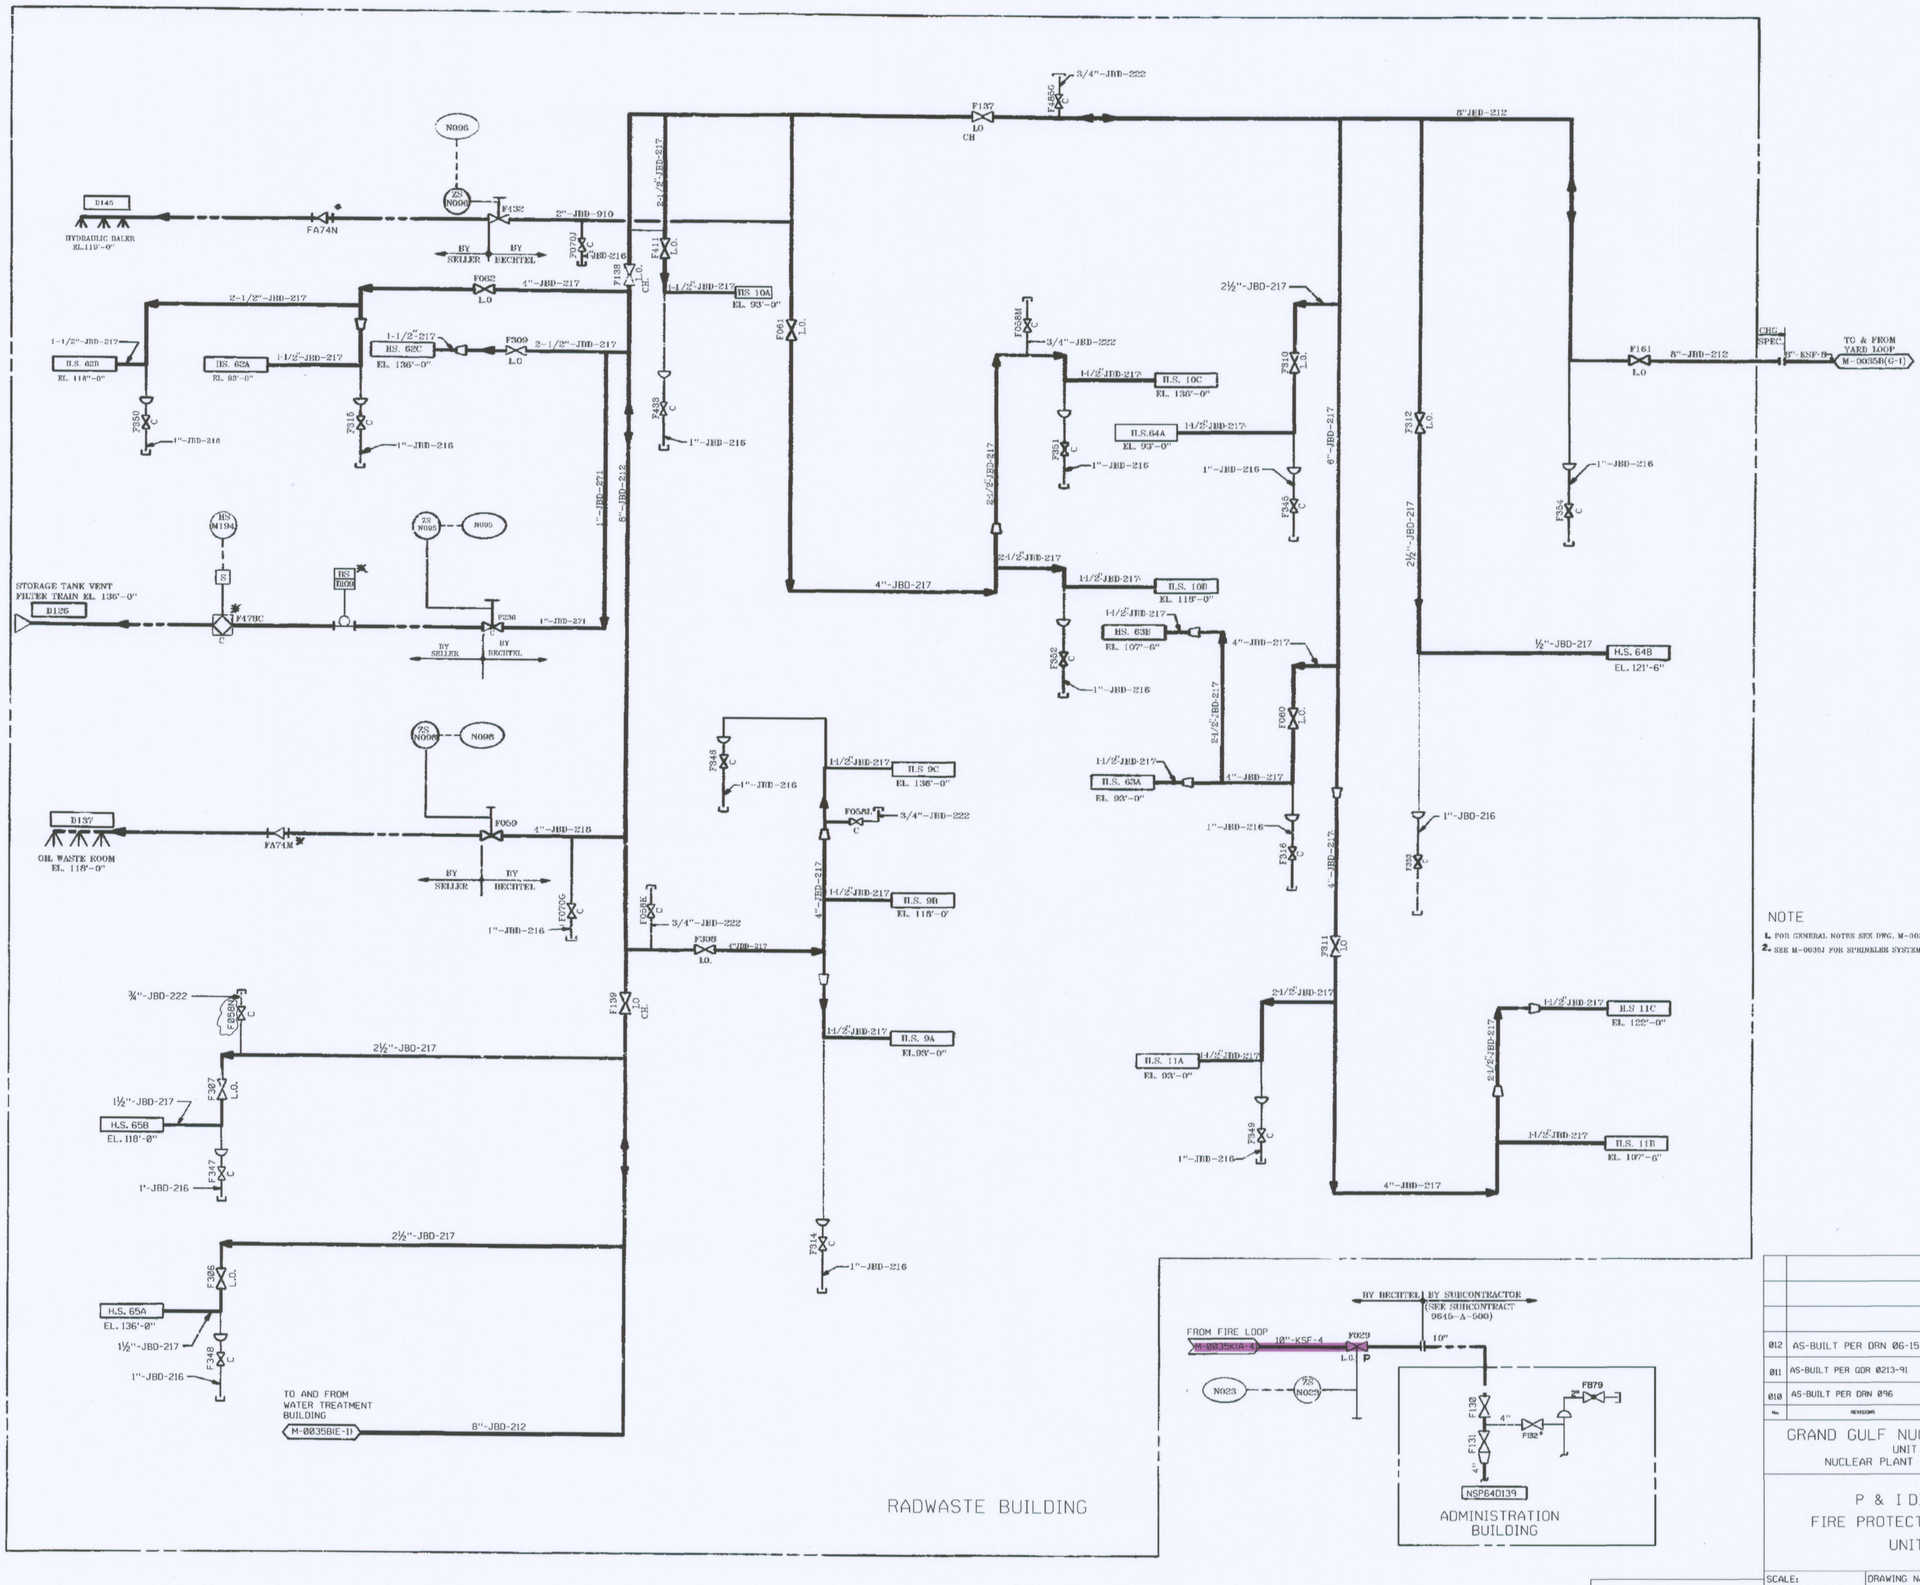

NOTE

1. FOR GENERAL NOTES SEE DWG. M-0035A
2. SEE M-0035J FOR SPRINKLER SYSTEM TYPICALS.

No.	REVISIONS	DWN	REV	REQ ENG	CHKD	APPD	DATE
012	AS-BUILT PER DRN 06-1581	WE	N/A	N/A			11-30-06
011	AS-BUILT PER QDR 0213-91	SIGN-OFF ON RECORD					
010	AS-BUILT PER DRN 096	WJE	TRG	FJB	EGR	SET	8/17/97

GRAND GULF NUCLEAR STATION
UNIT 1
NUCLEAR PLANT ENGINEERING

P & I DIAGRAM
FIRE PROTECTION SYSTEM
UNIT 1

SCALE:	DRAWING No.	REV.
NONE	M-0035G	012

HYBRID DFN: m0035g.dgn

COMPONENTS SUBJECT TO AMR
FIRE PROTECTION WATER SYSTEM AMM15

NO.	DATE	DESCRIPTION	BY	ENG	CHK	APP
0	9-29-2011	.	.	.	.	.

REVISIONS
LRA-M-0035G
CAD FILE m0035g.DGN
RASTER FILE

MPL No. SP64 1015M

D115