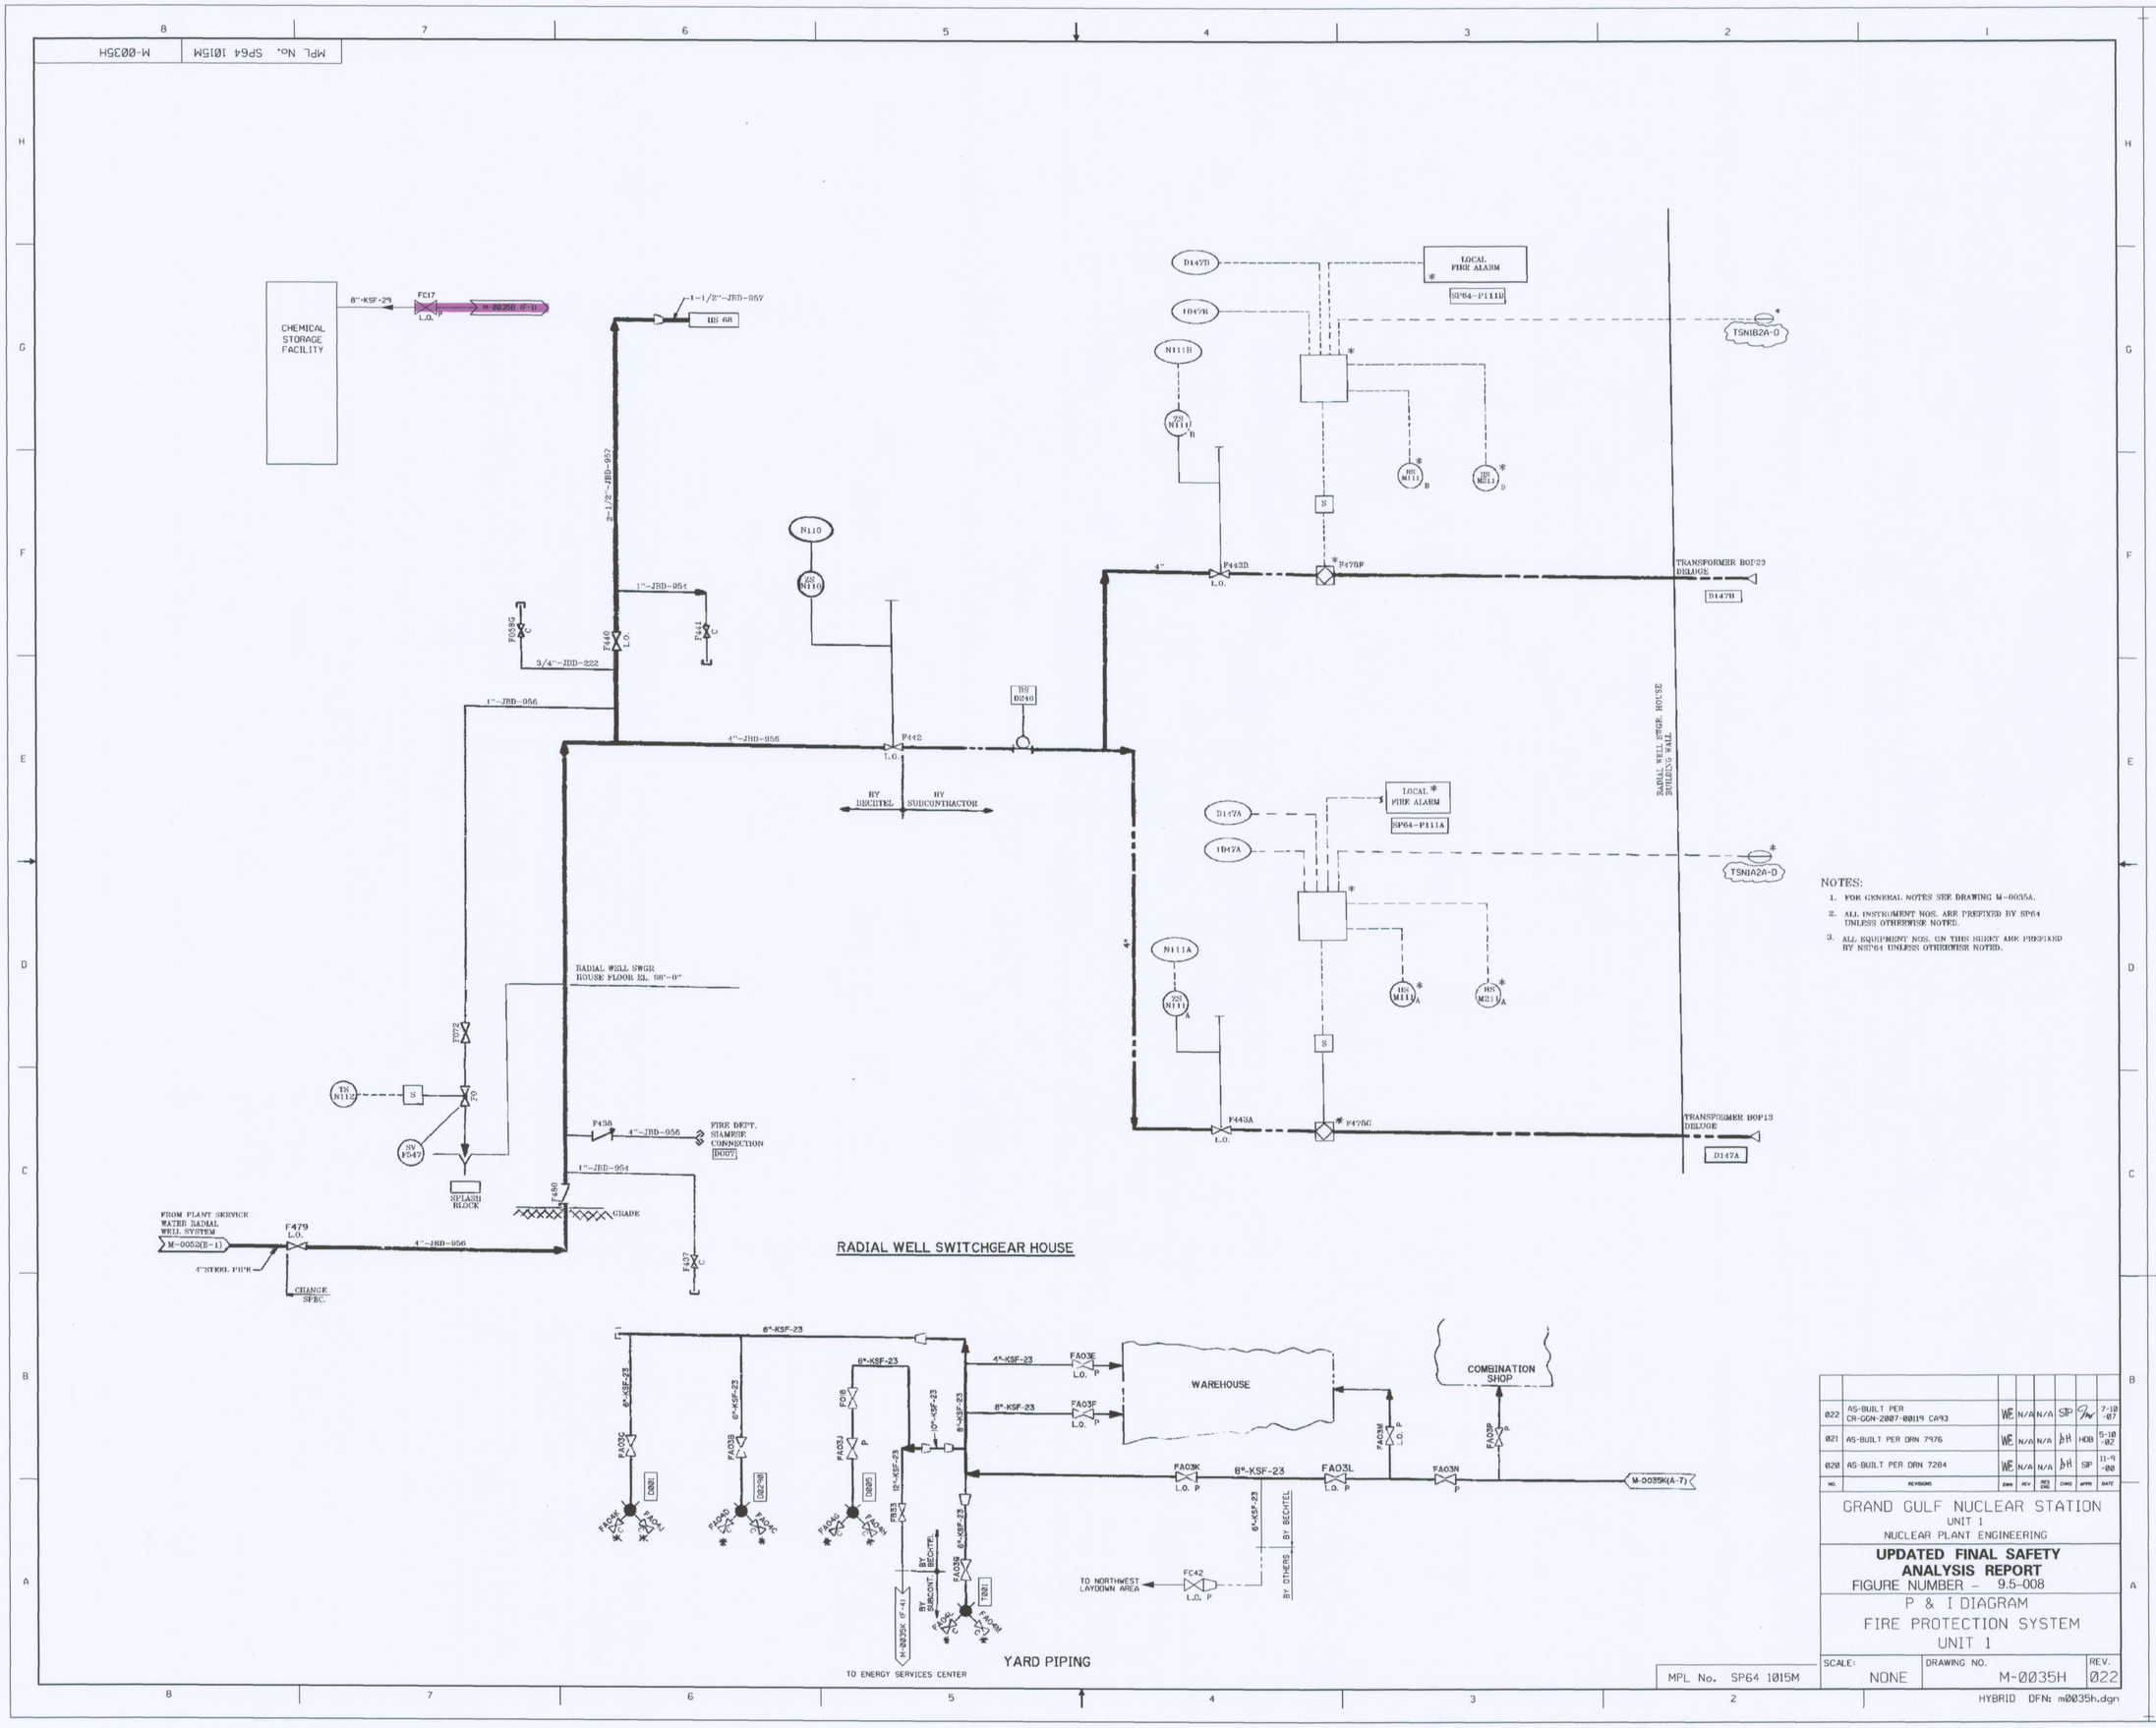

NOTES:

1. FOR GENERAL NOTES SEE DRAWING M-0035A.
2. ALL INSTRUMENT NOS. ARE PREFIXED BY SP64 UNLESS OTHERWISE NOTED.
3. ALL EQUIPMENT NOS. ON THIS SHEET ARE PREFIXED BY NSP64 UNLESS OTHERWISE NOTED.

NO.	REVISIONS	DRN	REV	RES ENG	CHKD	APPR	DATE
022	AS-BUILT PER CR-GGN-2007-00119 CA93	WE	N/A	N/A	SIP	[illegible]	7-10-07
021	AS-BUILT PER DRN 7976	WE	N/A	N/A	bH	HDB	5-10-02
020	AS-BUILT PER DRN 7284	WE	N/A	N/A	bH	SIP	11-9-00

GRAND GULF NUCLEAR STATION
UNIT 1
NUCLEAR PLANT ENGINEERING

UPDATED FINAL SAFETY ANALYSIS REPORT
FIGURE NUMBER – 9.5-008

P & I DIAGRAM
FIRE PROTECTION SYSTEM
UNIT 1

SCALE:	DRAWING NO.	REV.
NONE	M-0035H	022

MPL No. SP64 1015M

HYBRID DFN: m0035h.dgn

COMPONENTS SUBJECT TO AMR

FIRE PROTECTION WATER SYSTEM AMM15

NO.	DATE	DESCRIPTION	BY	ENG	CHK	APP
0	9-29-2011	.	.	.	.	.

REVISIONS

LRA-M-0035H

CAD FILE m0035h.DGN

RASTER FILE

D116