MPL No. 1N22 1015M | M-1064J

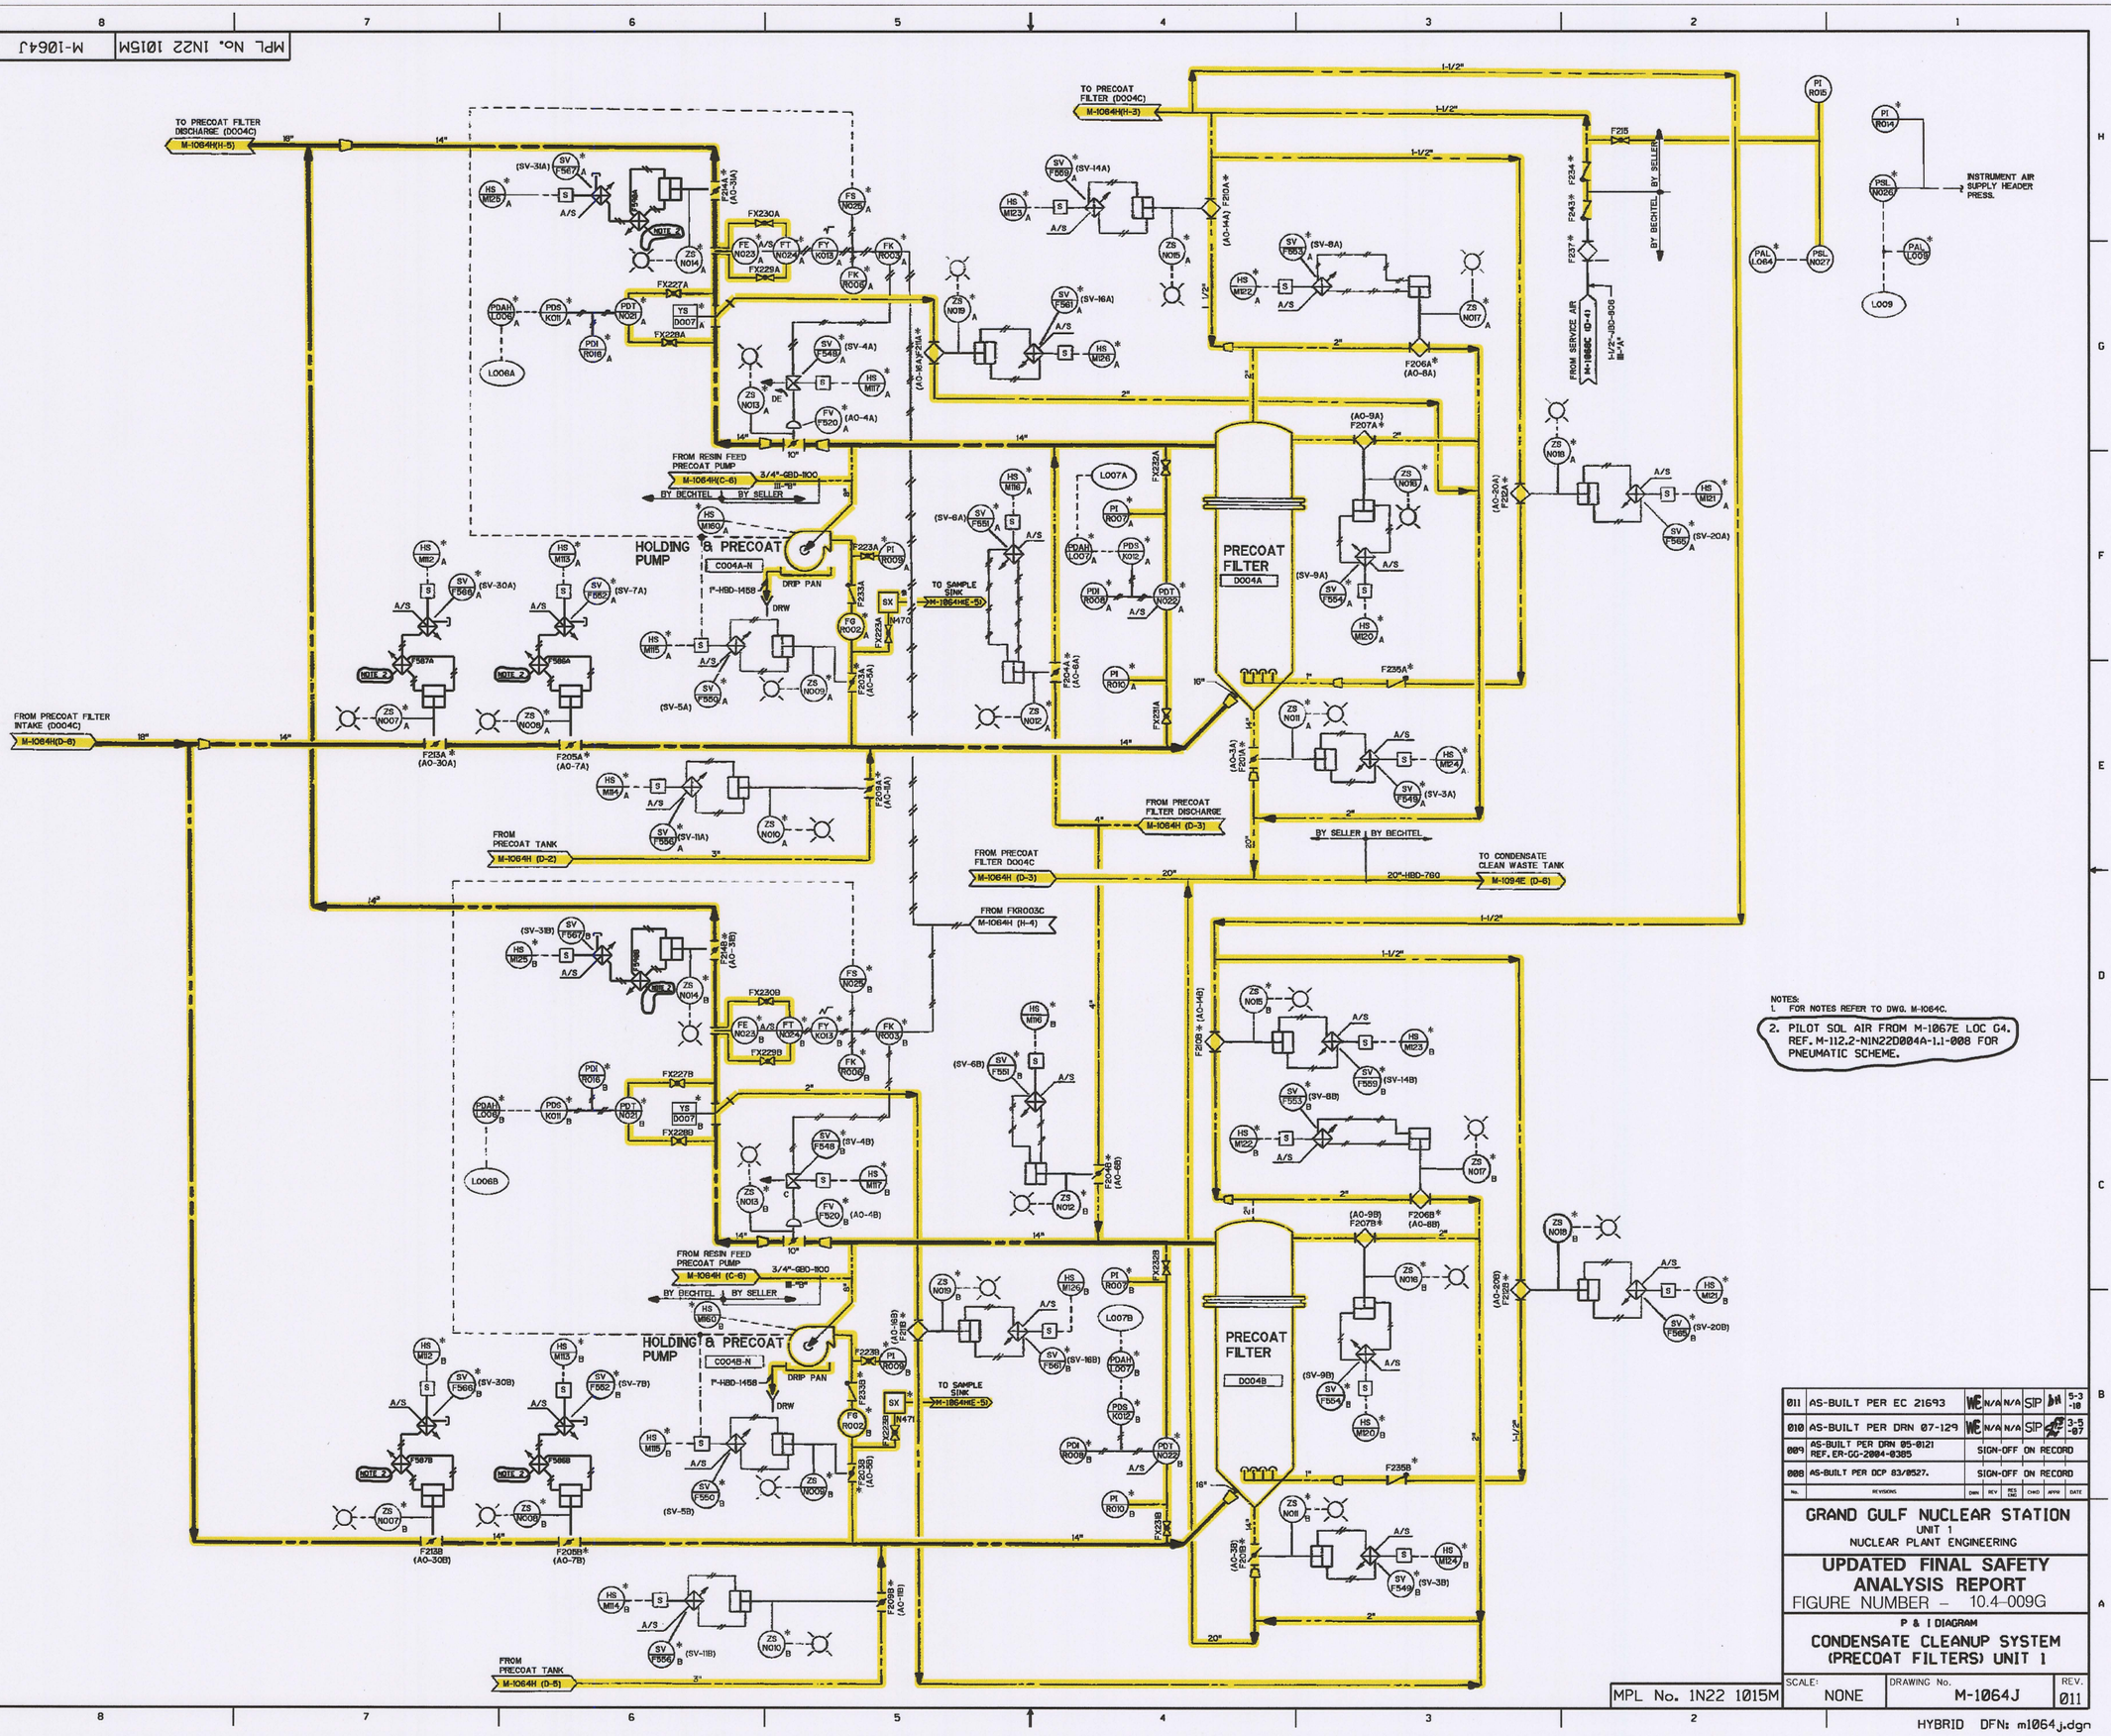

NOTES:
1. FOR NOTES REFER TO DWG. M-1064C.
2. PILOT SOL AIR FROM M-1067E LOC G4. REF. M-112.2-N1N22D004A-1.1-008 FOR PNEUMATIC SCHEME.

COMPONENTS SUBJECT TO AMR
NON-SAFETY RELATED SYSTEMS & COMPONENTS AFFECTING SAFETY RELATED SYSTEMS AMM20

NO.	DATE	DESCRIPTION	BY	ENG	CHK	APP
011		AS-BUILT PER EC 21693	WE	N/A	N/A	SIP
010		AS-BUILT PER DRN 07-129	WE	N/A	N/A	SIP
009		AS-BUILT PER DRN 05-0121 REF.ER-GG-2004-0385	SIGN-OFF ON RECORD			
008		AS-BUILT PER DCP 83/0527.	SIGN-OFF ON RECORD			

REVISIONS

GRAND GULF NUCLEAR STATION
UNIT 1
NUCLEAR PLANT ENGINEERING

UPDATED FINAL SAFETY ANALYSIS REPORT
FIGURE NUMBER – 10.4-009G

P & I DIAGRAM
CONDENSATE CLEANUP SYSTEM (PRECOAT FILTERS) UNIT 1

SCALE:	DRAWING No.	REV.
NONE	M-1064J	011

MPL No. 1N22 1015M

HYBRID DFN: m1064j.dgn

NO.	DATE	DESCRIPTION	BY	ENG	CHK	APP
0	10-10-2011	.	.	.	.	.

REVISIONS
LRA-M-1064J
CAD FILE m1064j.DGN
RASTER FILE

D172