

	PROJECT REPORT	PR No. DUK-001-PR-01
		Revision 0
		Page E1 of E160

Appendix E

Contents

HRQ-FWLA-001	E3
HRQ-FWLA-002	E114

Data Verification Summary

Data Verification Title: Cherokee Nuclear Station Final Foundation Field Maps and Index Map

ID Number: HRQ-FWLA-001

Date of Qualification Review Team Meeting: November 12, 2010

Quality Review Team:

Name	Sign (Initials)	Organization	Qualifications
Jim Cassidy	JRC 1 Dec 2010	Duke Energy	QA/QC Verification
John McConaghy	JMM 30 Nov 10	Duke Energy	Engineering
Juan Vizcaya	JV	Enercon Services Inc.	Engineering
Malcolm Schaeffer	MFS	HDR/DTA	Former Duke Power Project Geologist
Michael Gray	MGG	FWLA	Project Principal Geologist
Adam Wade	AWW	FWLA	Project Geologist

Data / Evidence Considered During the Reviews:

The contents of the files outlined in attachment 2 were reviewed for applicability and completeness.

Critical Attributes Considered During the Reviews:

Files comprise the hand drawn field maps, including index map, documenting observed foundation level mapping conducted at former Cherokee Nuclear Station (CNS) Unit 1 and portions of CNS Unit 2.

Basis for Qualification / Non-Qualification:

The data is qualified to use in WLS evaluations to document final foundation geology beneath former CNS units 1 and 2. The information documented in these files was acquired, prepared, and verified using the applicable specifications and Duke QA procedures governing at the time of gathering and preparation. The CNS final foundation field geologic maps, including index map, may be used in corroboration of information. These field maps will be used as inputs to develop a final foundation map record to support geologic evaluations as part of WLS COLA.

Is the data considered Nuclear Safety Related QA Qualified? Yes (Yes / No)

Recommendations for Additional Qualification Activities:

None

Dissenting conclusions or comments: If the team reaches concensus, enter "None" here. Otherwise, document the dissenting view as follows:

Reviewer Name and Organization: _____

Dissenting Statement: _____ None _____

Signature and Date: _____

I hereby certify this Data Verification Package is complete:

Quality Review Team Lead: *Michael G. Gmy* **(Sign)** **Date:** 12/02/2010

I approve this Data Verification Package for the usage identified above:

Approved By: *R.L. Morgan, Jr* **(Sign)** **Date:** 12/02/2010
(Duke Project Manager or designee)

Data Verification Planning Form

Data Verification Title: Cherokee Nuclear Station **ID Number:** HRO-FWLA-001

Final Foundation Maps and Index Map

Scope of Historical Data Requiring Review:

Sixty (60) hand drawn field geologic maps at 1"=10' scale of final excavated surface of the Cherokee Nuclear Station (CNS), and one (1) hand drawn index map. Mapping performed during CNS construction from 1977 to 1982. Attachment 1 summarizes the individual field maps to be qualified. Attachment 2 contains .pdf copies of hand drawn map panels and index map. Attachment 3 contains a copy of the records transmittal. Attachment 4 contains a copy of the written mapping procedures and addendum for the final excavation mapping program.

Purpose / Applicability of

Data:

These field maps will be used as inputs to develop a final foundation map record to support geologic evaluations as part of WLS COLA.

Methods of Verification (X):

Peer Review _____ Data Corroboration X Confirmatory Testing _____

Rationale:

The field maps generated for this project were produced using approved standards and procedures by Duke Power Company, now Duke-Energy. They represent an in-process product with status as of the time work on the Cherokee project was stopped. A copy of the Duke Power mapping procedure and addendum is provided in Attachment 4. Current-era work will compile information from these field maps to support licensing and construction of Lee Nuclear Station

Need for Data Qualification

Affirmed By:

Michael Gray
FWLA Project Manager (or designee)

Date: 5/19/2010

Required Organizations for

Verification:

FWLA with support from Duke-Energy and Enercon.

Duke Approval of Scope and Methods

Used:

RL Morgan, Jr
Duke Project Manager (or designee)

Date: 12/02/2010

Attachments:

- Attachment 1 Listing of Field Maps to be Qualified
- Attachment 2 CNS Final Foundation Field Maps and Index Map
- Attachment 3 Record Transmittals
- Attachment 4 Duke Power Company Mapping Procedures and Addendum

Attachment 1

Listing of Field Maps to be Qualified

Attachment 1 - Listing of Field Maps to be Qualified


Duke Energy Records Designation					CNS Records Designation	CNS Map Phase	
Folder Name	File Name/ Map Panel #	Date of Transmittal	Rescanned Map Panel File Name	Date of Transmittal	Map Panel Designation	Phase II map 1"=10'	Inset map 1"=10'
CK10-01	20.TIFF	March 23 2007			CK10-01A	X	
	21.TIFF	March 23 2007			CK10-01A		X
CK10-02	22.TIFF	March 23 2007			CK10-02B	X	
	23.TIFF	March 23 2007			CK10-01B	X	
	24.TIFF	March 23 2007			CK10-02D	X	
	25.TIFF	March 23 2007			CK10-02A	X	
	26.TIFF	March 23 2007			CK10-02F	X	
	27.TIFF	March 23 2007			CK10-02E	X	
	28.TIFF	March 23 2007			CK10-020	X	
CK10-03	29.TIFF	March 23 2007			CK10-03A	X	
	30.TIFF	March 23 2007			CK10-03B	X	
	31.TIFF	March 23 2007			CK10-03C	X	
	32.TIFF	March 23 2007			CK10-03D	X	
	33.TIFF	March 23 2007			CK10-03E	X	
CK10-04	34.TIFF	March 23 2007			CK10-03F	X	
	35.TIFF	March 23 2007			CK10-04A	X	
	36.TIFF	March 23 2007			CK10-04B	X	
	37.TIFF	March 23 2007			CK10-04C	X	
CK10-05	38.TIFF	March 23 2007			CK10-04D	X	
	39.TIFF	March 23 2007			CK10-05A	X	
CK10-06	40.TIFF	March 23 2007			CK10-05B	X	
	41.TIFF	March 23 2007			CK10-05C	X	
	42.TIFF	March 23 2007			CK10-06A	X	
CK10-07	43.TIFF	March 23 2007			CK10-06B	X	
	44.TIFF	March 23 2007			CK10-06C	X	
	45.TIFF	March 23 2007			CK10-06D	X	
	46.TIFF	March 23 2007			CK10-06E	X	
	47.TIFF	March 23 2007			CK10-06F	X	
CK10-08	48.TIFF	March 23 2007			CK10-07F		X
	49.TIFF	March 23 2007	49 CK10-07A.JPEG	June 4 2010	CK10-07A	X	
	50.TIFF	March 23 2007			CK10-07B	X	
	51.TIFF	March 23 2007			CK10-07C	X	
	52.TIFF	March 23 2007	52 CK10-07D.JPEG	June 4 2010	CK10-07D	X	
	53.TIFF	March 23 2007			CK10-07E	X	
CK10-09	54.TIFF	March 23 2007			CK10-07F	X	
	55.TIFF	March 23 2007			CK10-08C	X	
	56.TIFF	March 23 2007			CK10-08A	X	
	57.TIFF	March 23 2007			CK10-08B	X	
CK10-10	58.TIFF	March 23 2007			CK10-08D	X	
	59.TIFF	March 23 2007			CK10-09C	X	
	60.TIFF	March 23 2007			CK10-09A	X	
CK10-11	61.TIFF	March 23 2007			CK10-09B	X	
	62.TIFF	March 23 2007	62 CK10-10B.JPEG	June 4 2010	CK10-10B	X	
	63.TIFF	March 23 2007			CK10-10A	X	
	64.TIFF	March 23 2007			CK10-10D	X	
	65.TIFF	March 23 2007			CK10-10C	X	
	66.TIFF	March 23 2007			CK10-10F	X	
CK10-12	67.TIFF	March 23 2007			CK10-10E	X	
	68.TIFF	March 23 2007			CK10-11E	X	
	69.TIFF	March 23 2007	69 CK10-11F.JPEG	June 4 2010	CK10-11F	X	
	70.TIFF	March 23 2007			CK10-11B	X	
	71.TIFF	March 23 2007			CK10-11C	X	
CK10-13	72.TIFF	March 23 2007			CK10-11A	X	
	73.TIFF	March 23 2007	73 CK10-11D.JPEG	June 4 2010	CK10-11D	X	
CK10-14	74.TIFF	March 23 2007			CK10-12B	X	
	75.TIFF	March 23 2007			CK10-12C	X	
CK10-15	76.TIFF	March 23 2007			CK10-12A	X	
	77.TIFF	March 23 2007			CK10-13A	X	
CK10-16	78.TIFF	March 23 2007			CK10-14B	X	
	79.TIFF	March 23 2007			CK10-14A	X	
	Final Foundation Index Map (AKA Binder2 2).PDF	November 23 2006			CK-0021-05A Rev.2	NA	NA

ATTACHMENT 2

CNS Final Foundation Field Maps and Index Map

(1) South and East Wall
 of IAB Derrick Pad
 Map No.:

- August 1978
- September 1978
- October 1978
- November 1978
- December 1978
- January 1979
- February 1979
- March 1979
- April 1979
- May 1979
- June 1979
- July 1979
- August 1979
- September 1979
- October 1979
- November 1979
- December 1979
- January 1980
- February 1980
- March 1980
- April 1980
- May 1980
- June 1980
- July 1980
- August 1980
- September 1980
- October 1980
- November 1980
- December 1980

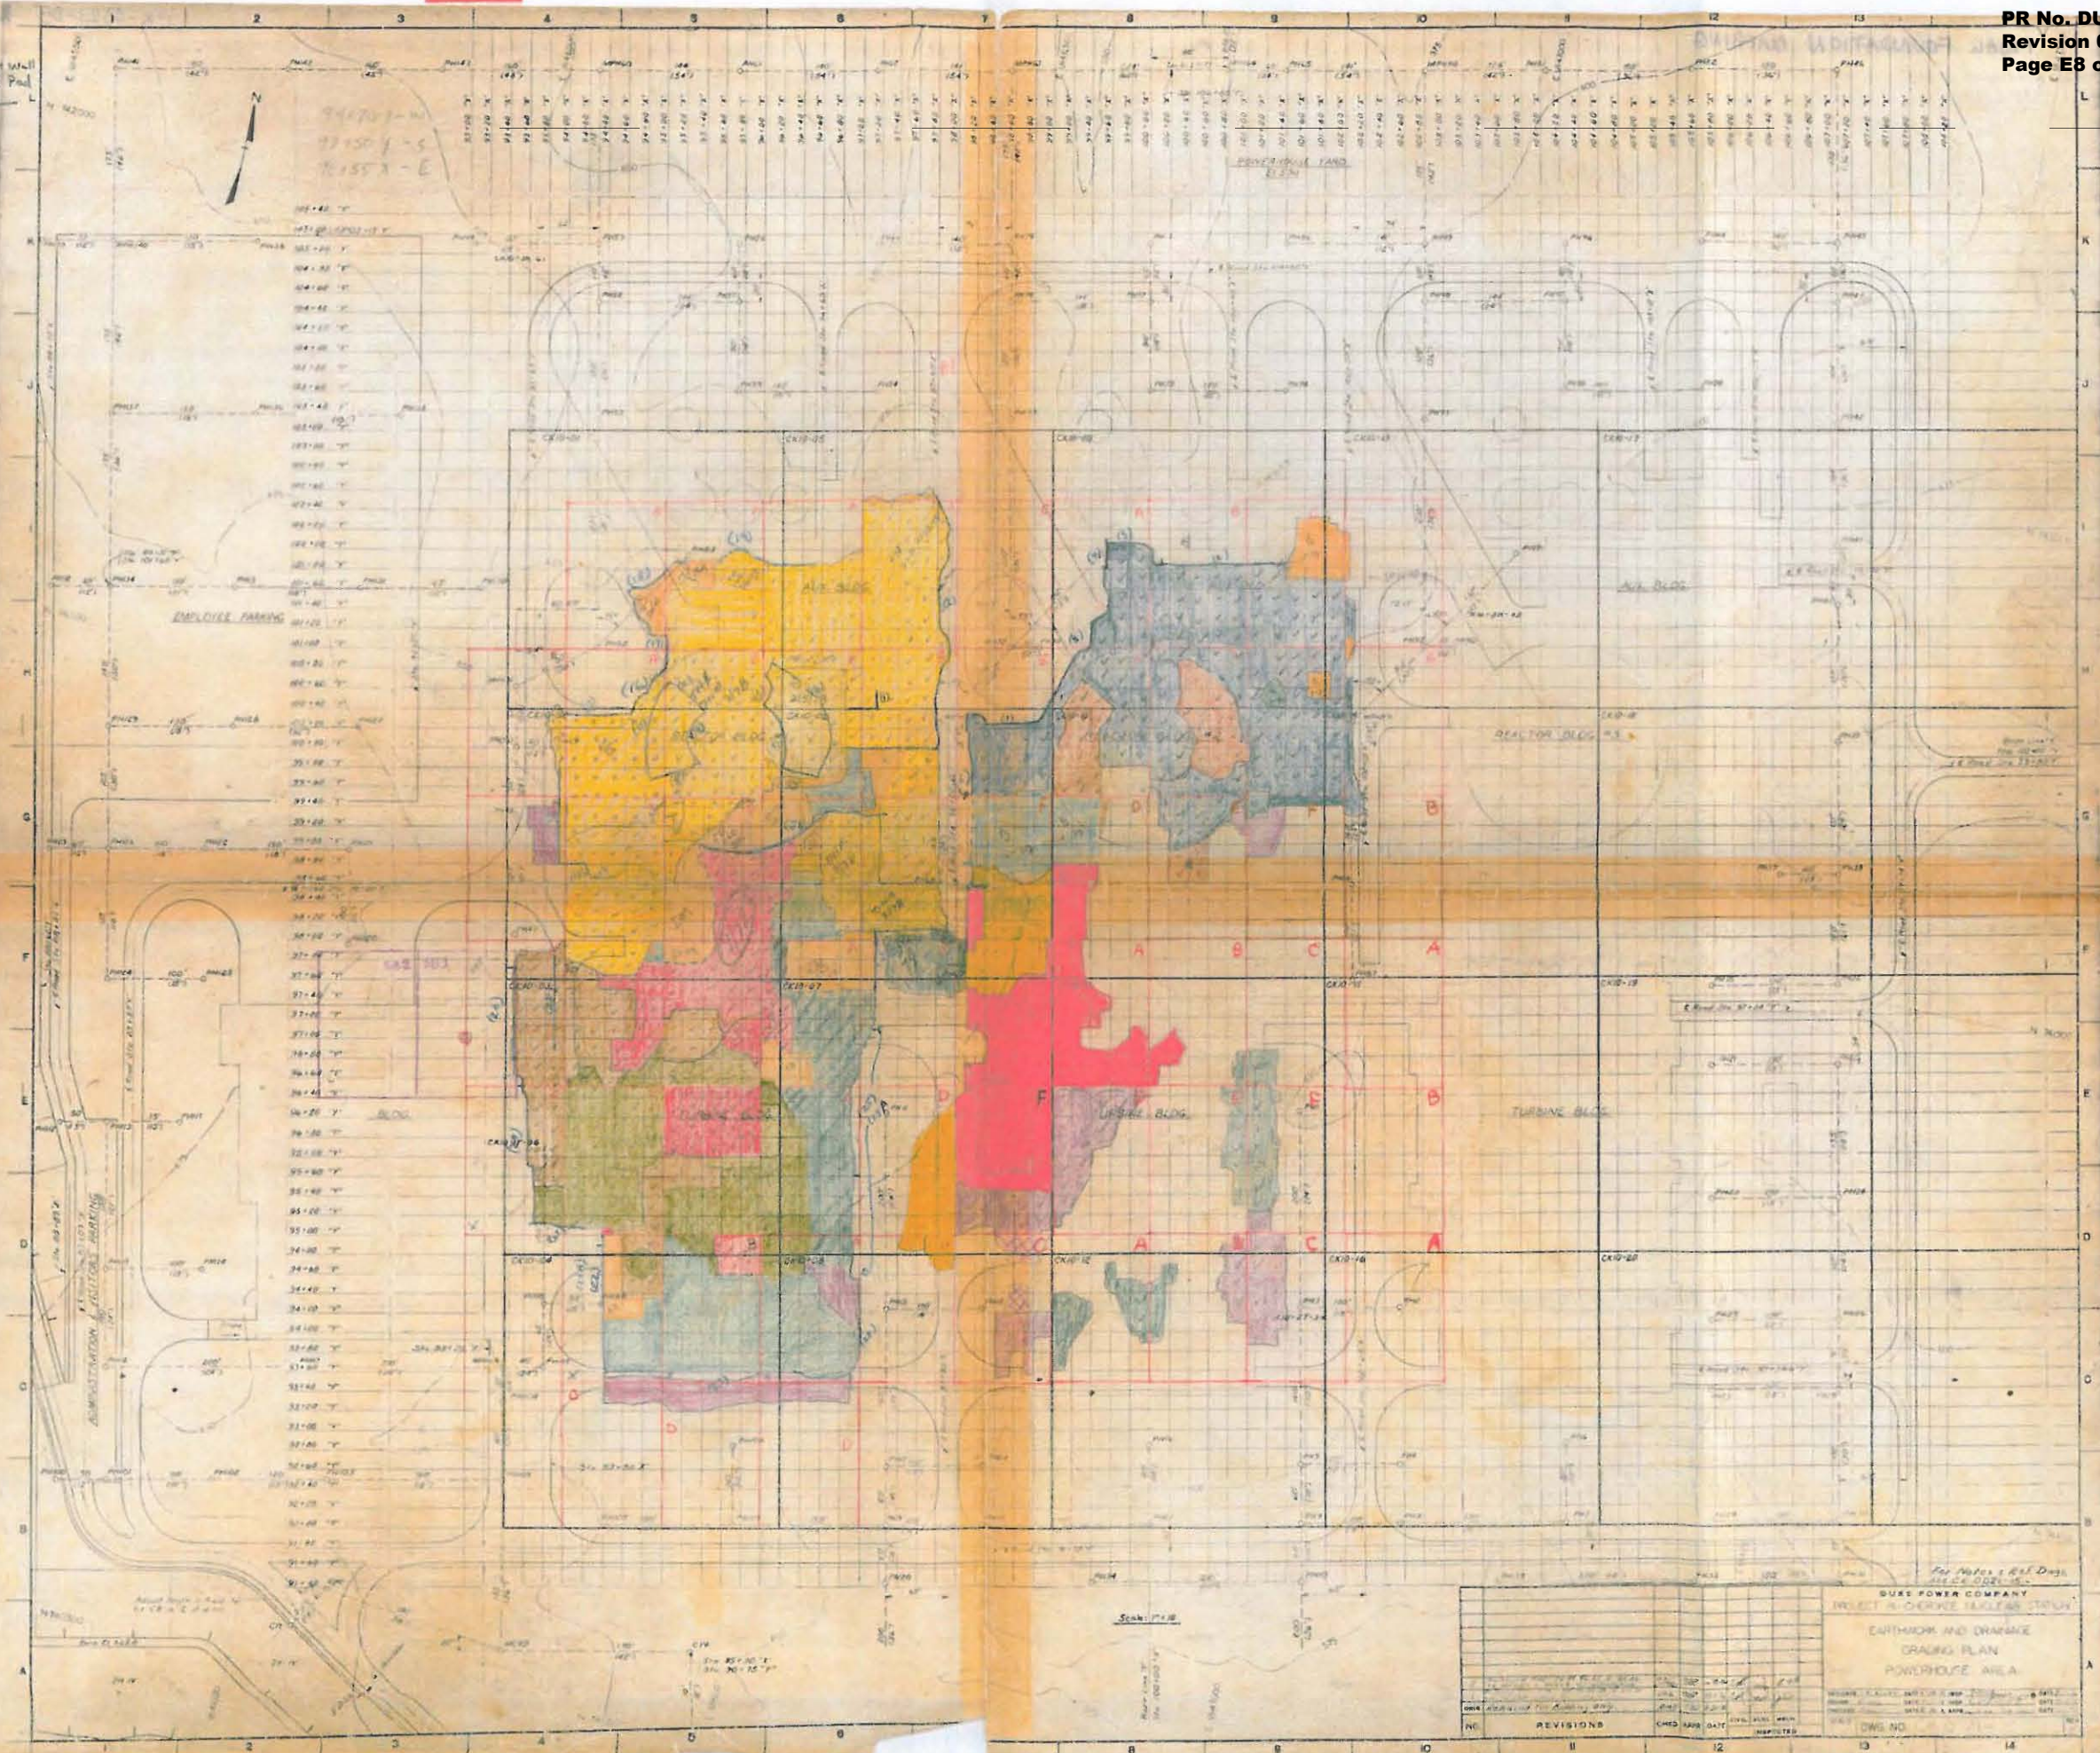


For Notes & Ref. Draw.
 DUK-001-PR-01-08
 PROJECT & DESIGNER'S SIGNATURE


EARTHWORK AND DRAINAGE
 GRADING PLAN
 POWERHOUSE AREA


NO.	REVISIONS	CHKD. DATE	BY

DWG. NO. 12
 13
 14

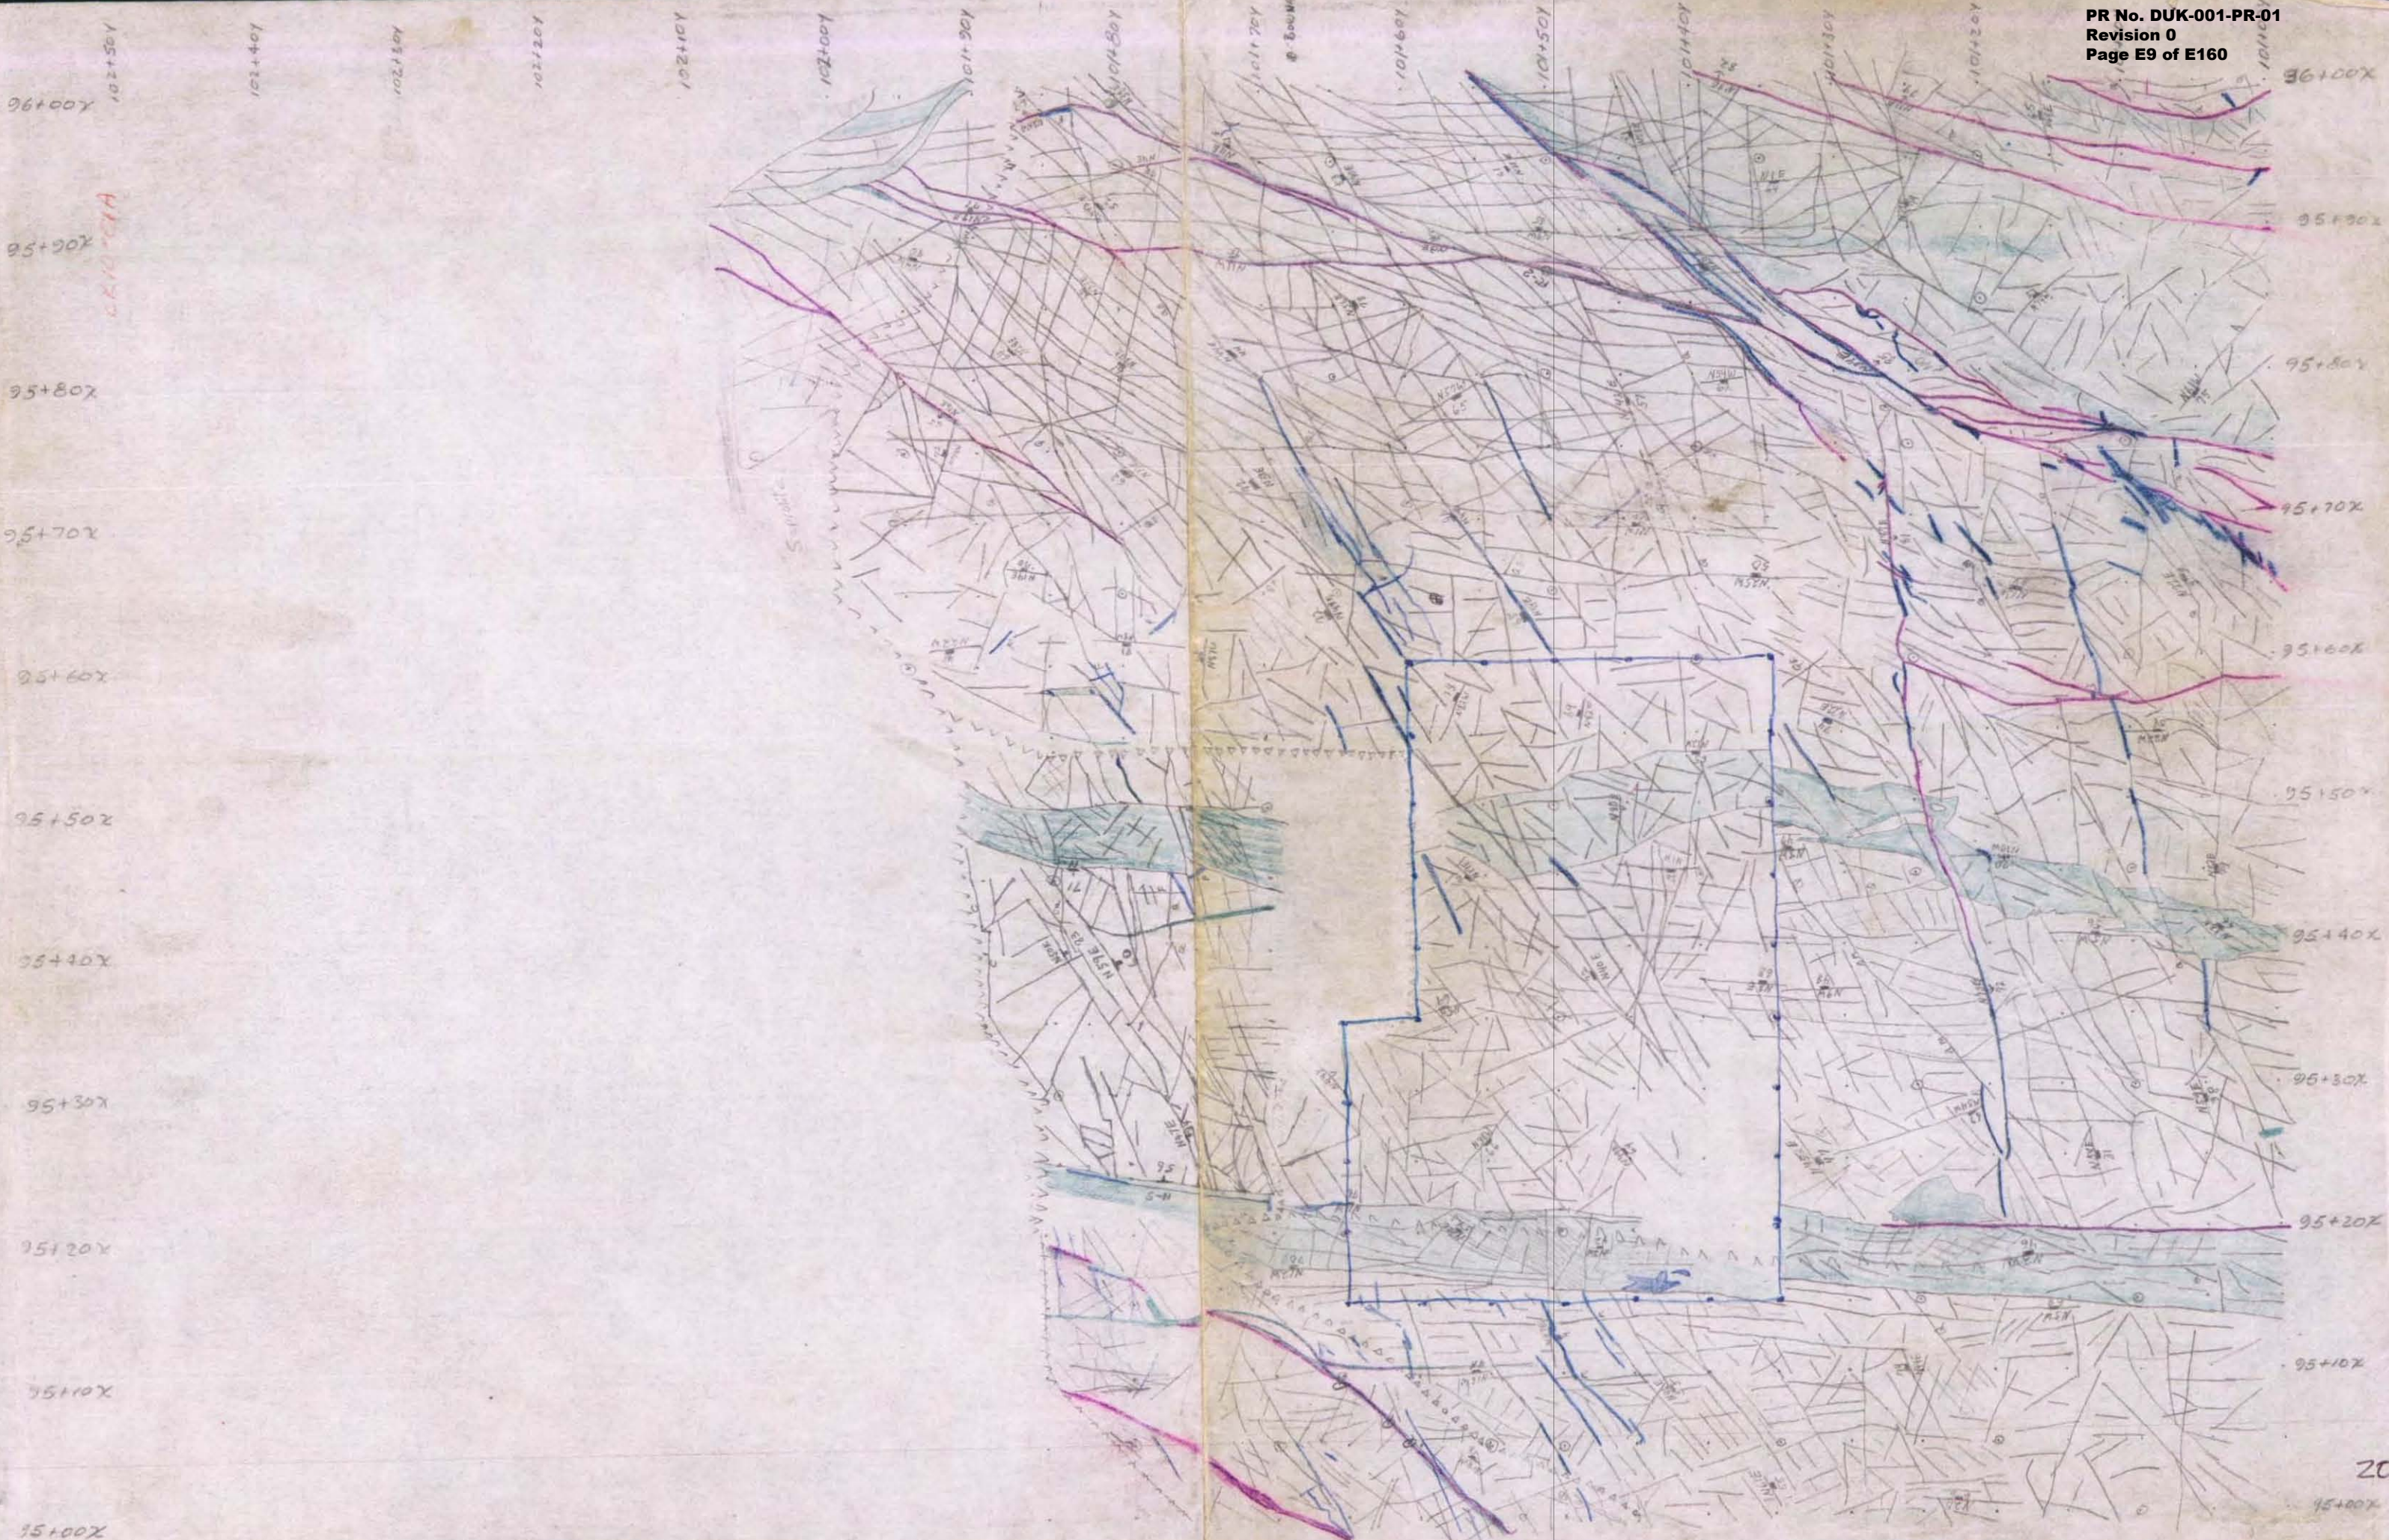

CK 10-01A

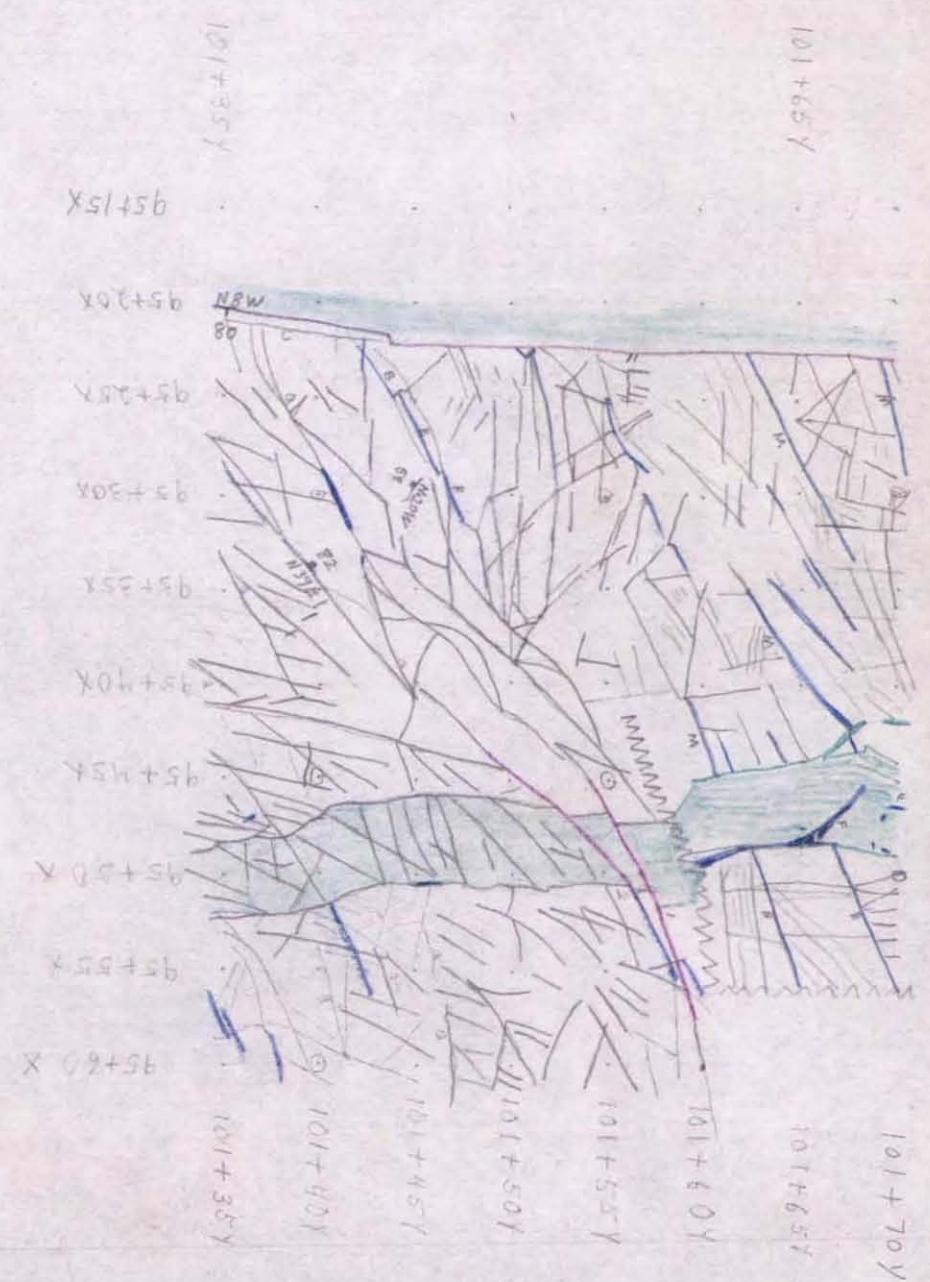

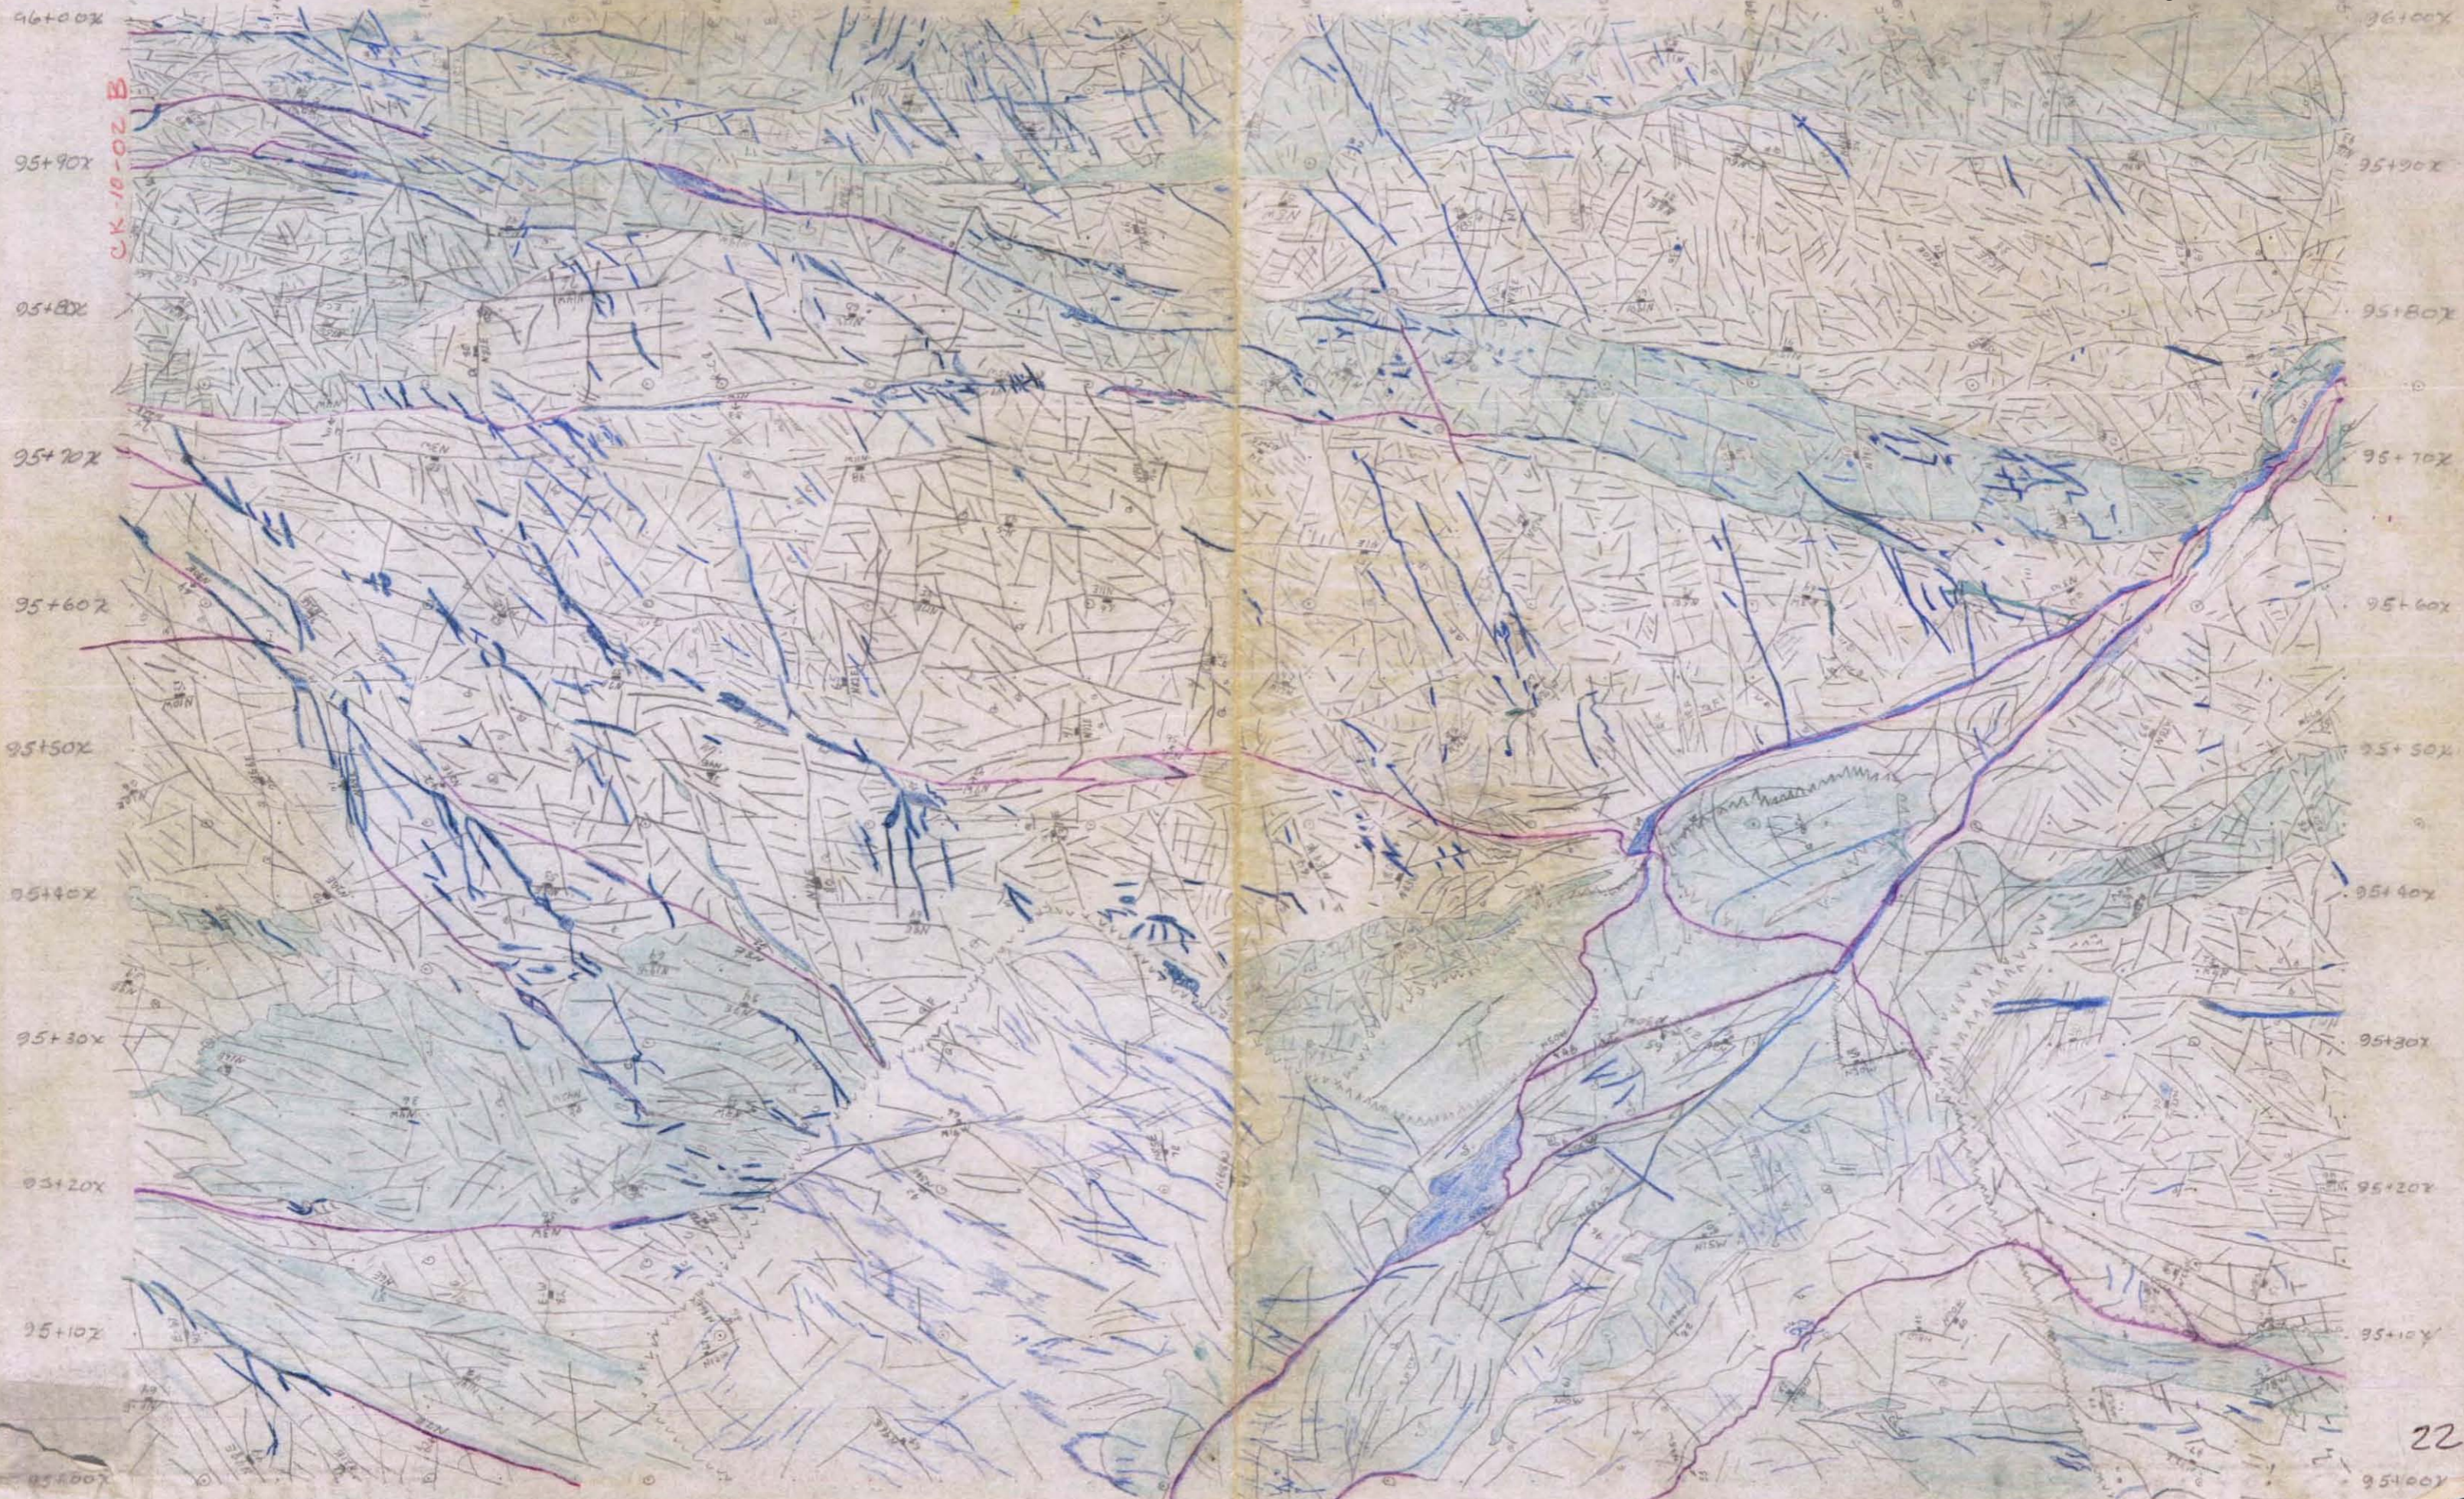


2K10-01B


102+00
101+00
100+00
99+00
98+00

200+50
200+00
199+50
199+00
198+50
198+00


102+50
102+00
101+50
101+00
100+50
100+00
99+50
99+00
98+50
98+00
97+50
97+00
96+50
96+00
95+50
95+00
94+50
94+00
93+50
93+00
92+50
92+00
91+50
91+00
90+50
90+00

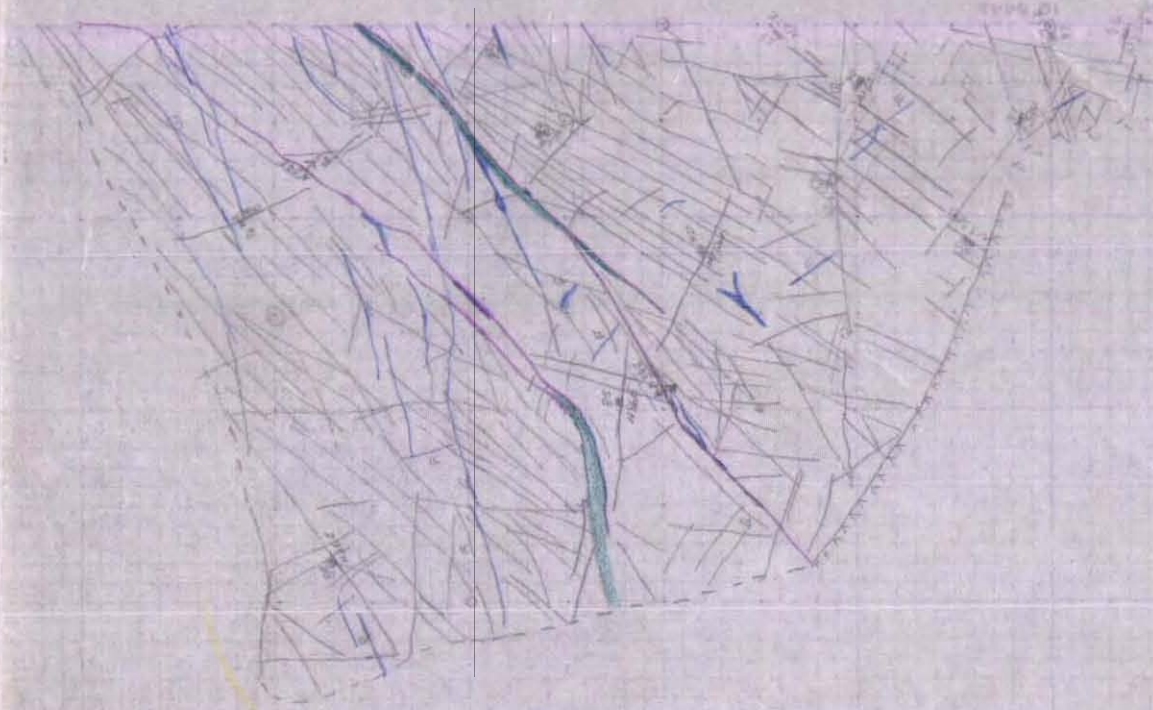




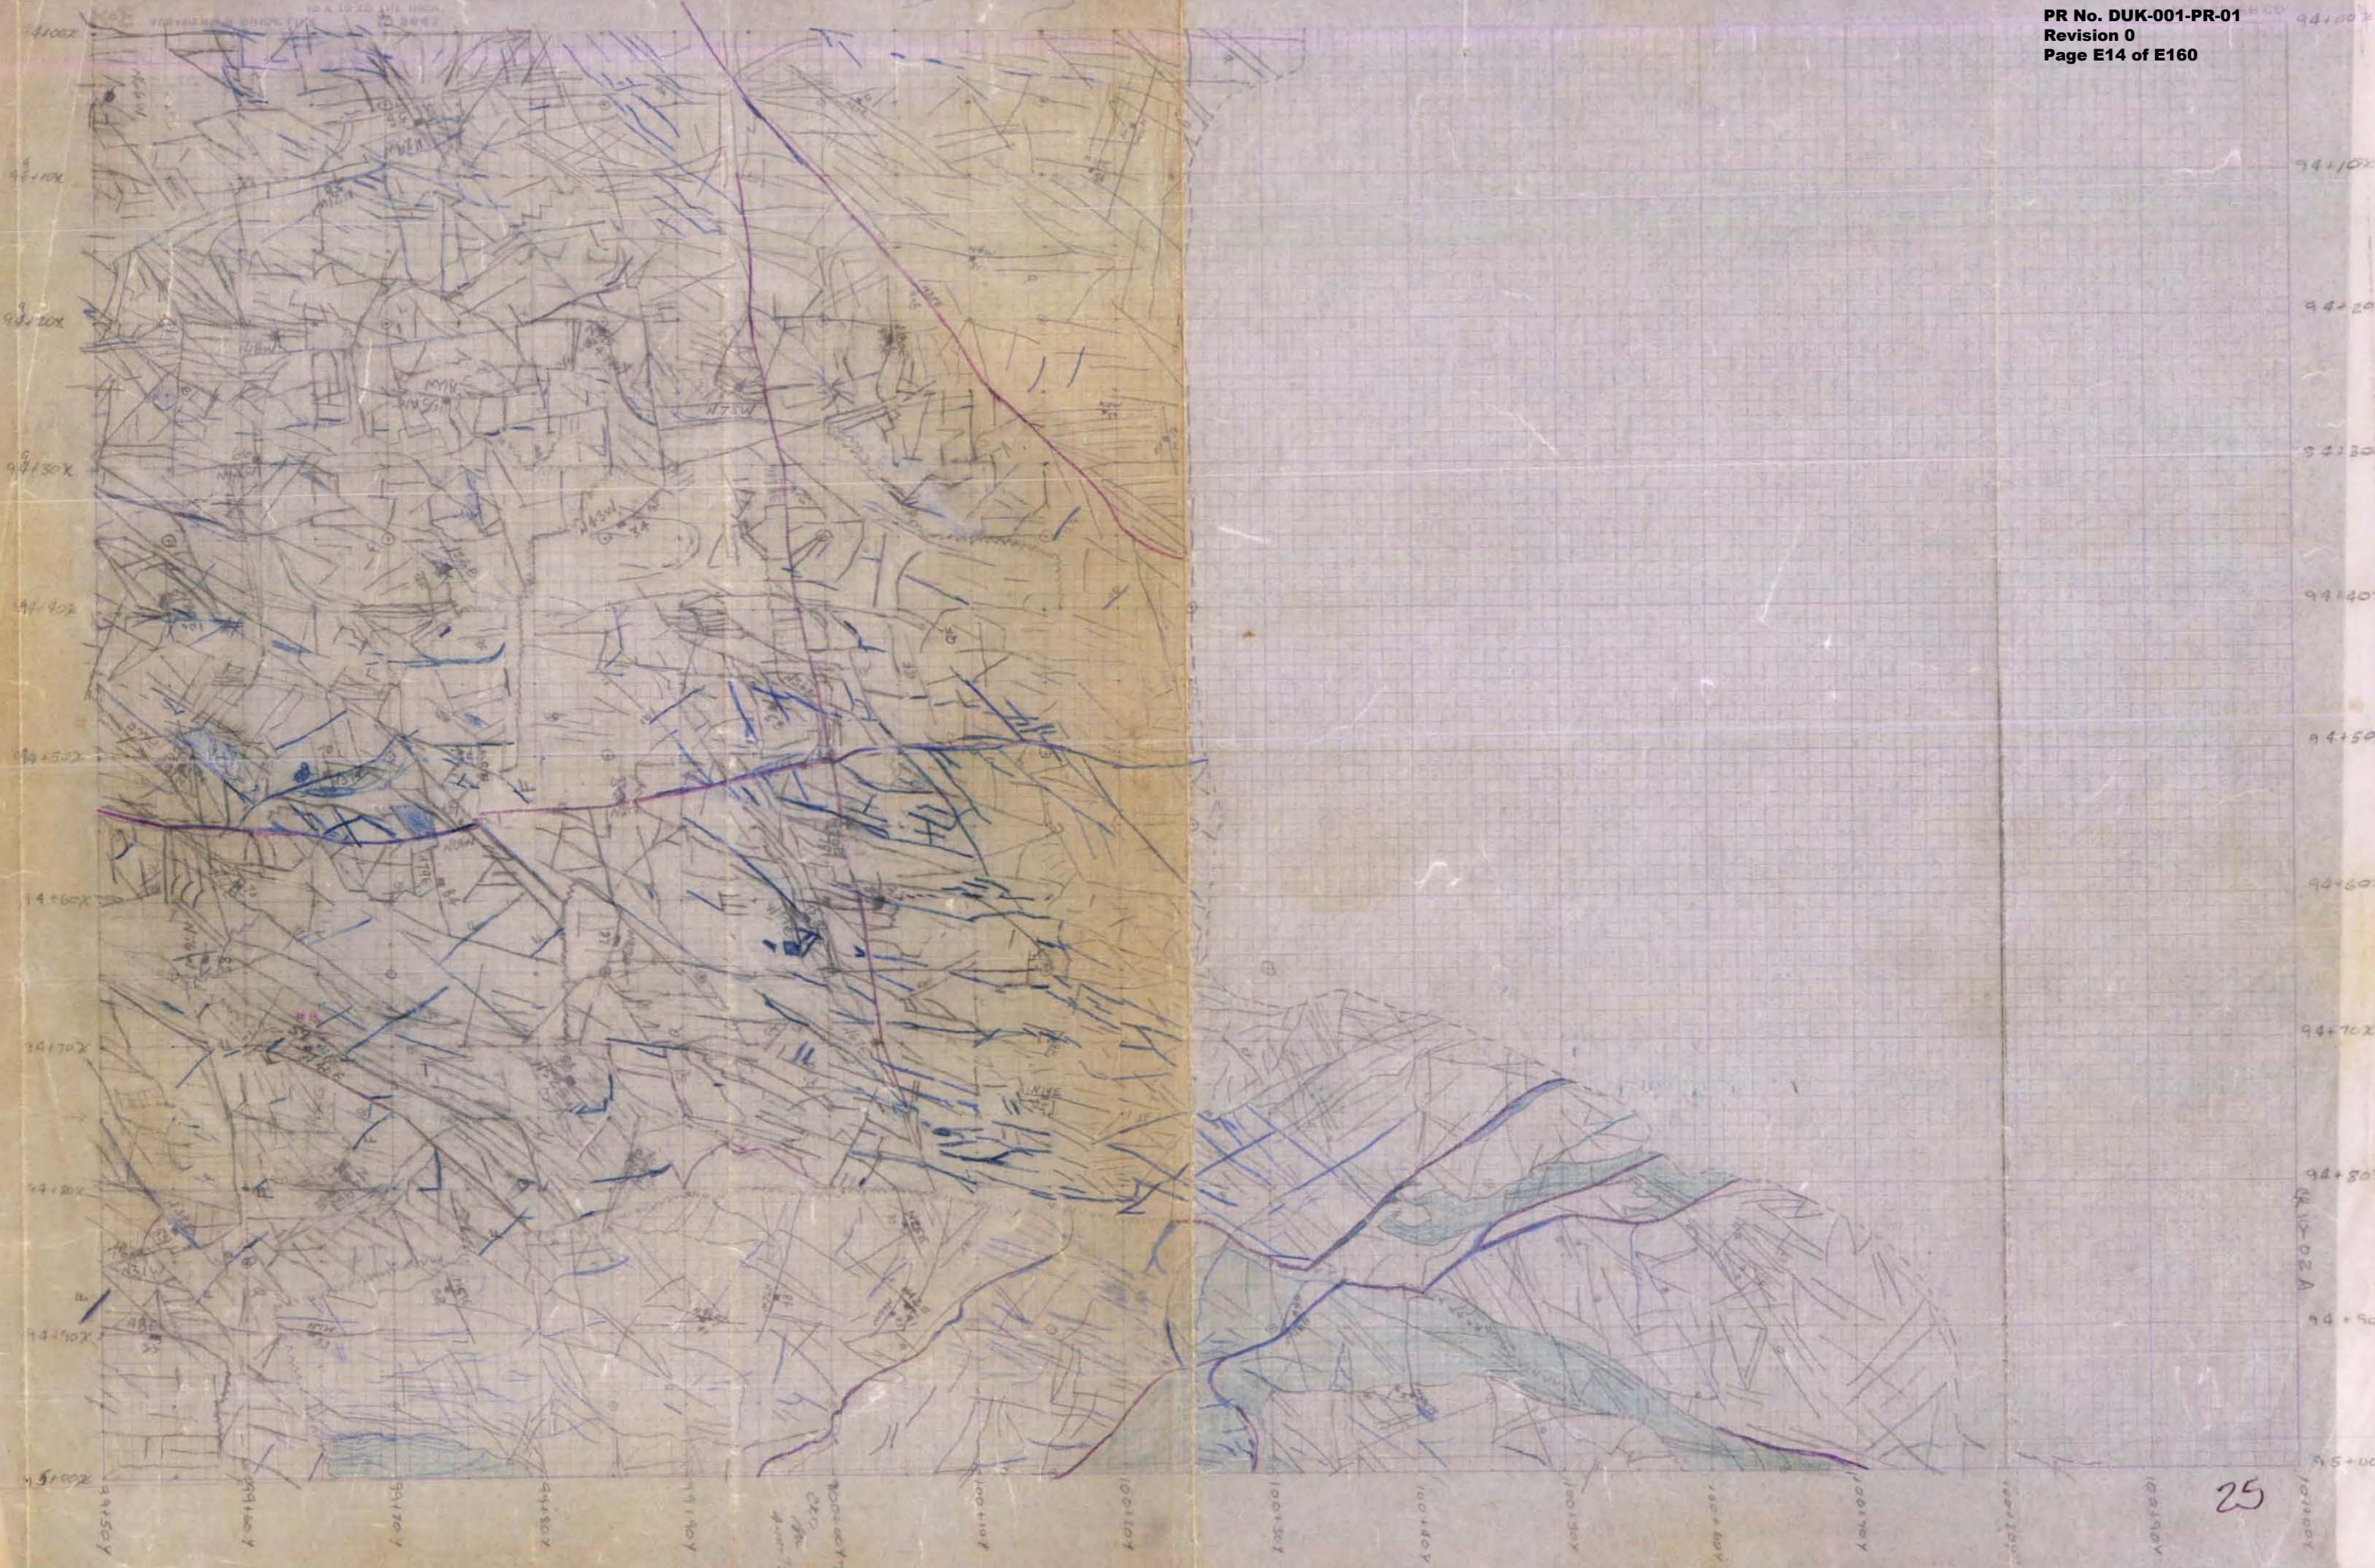

105766

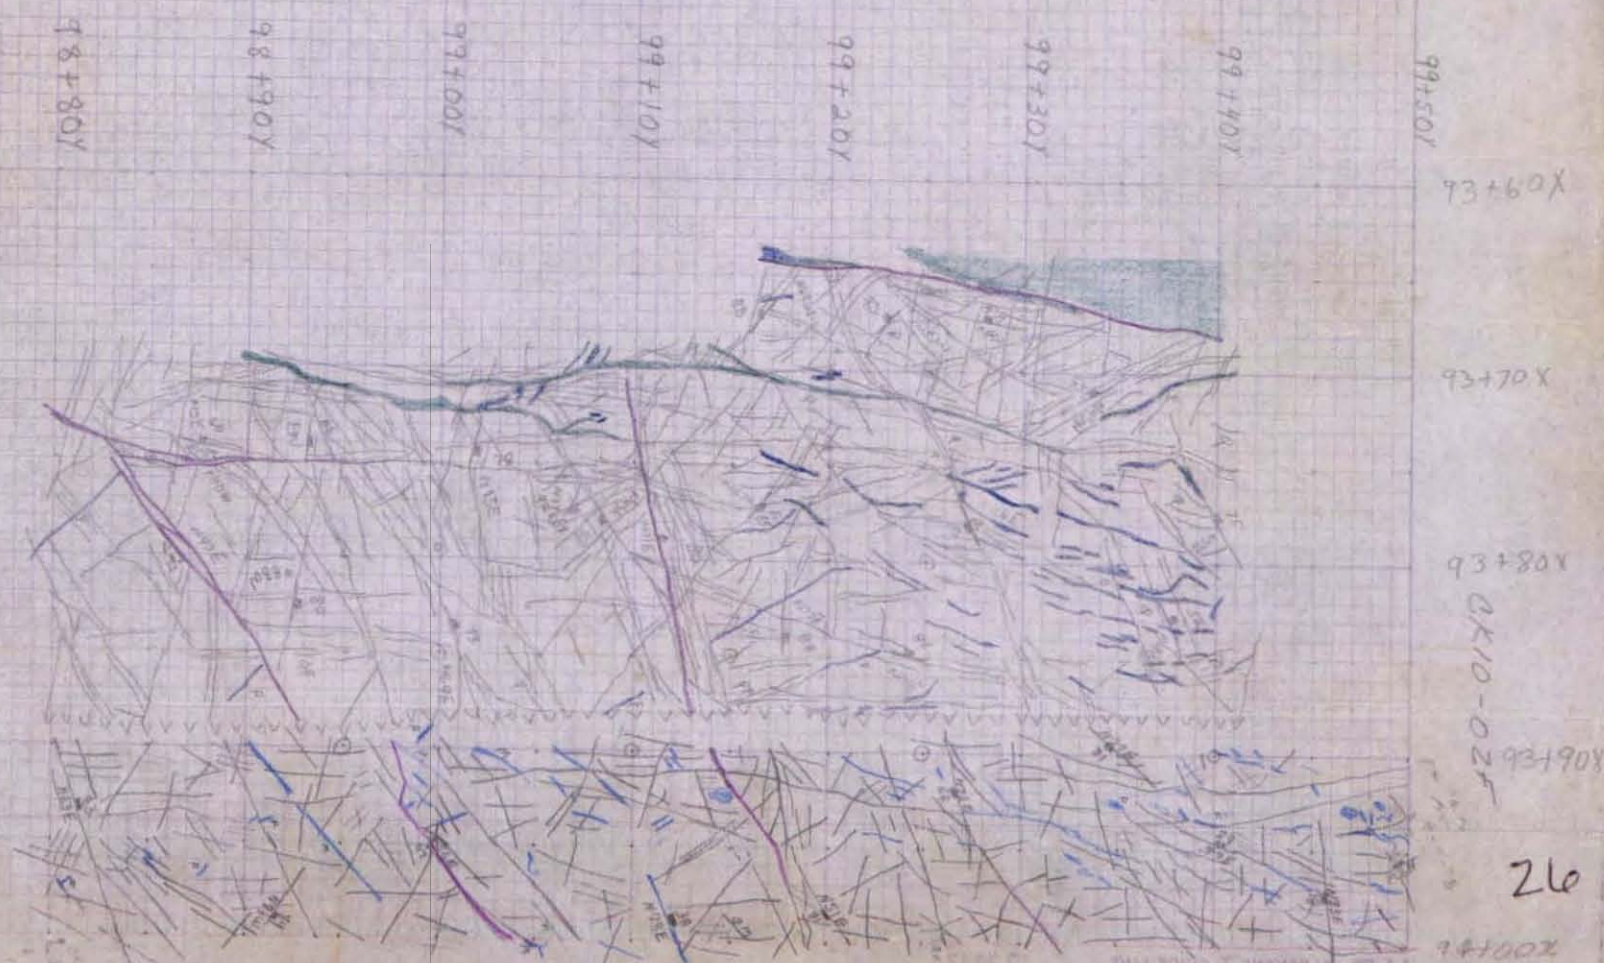

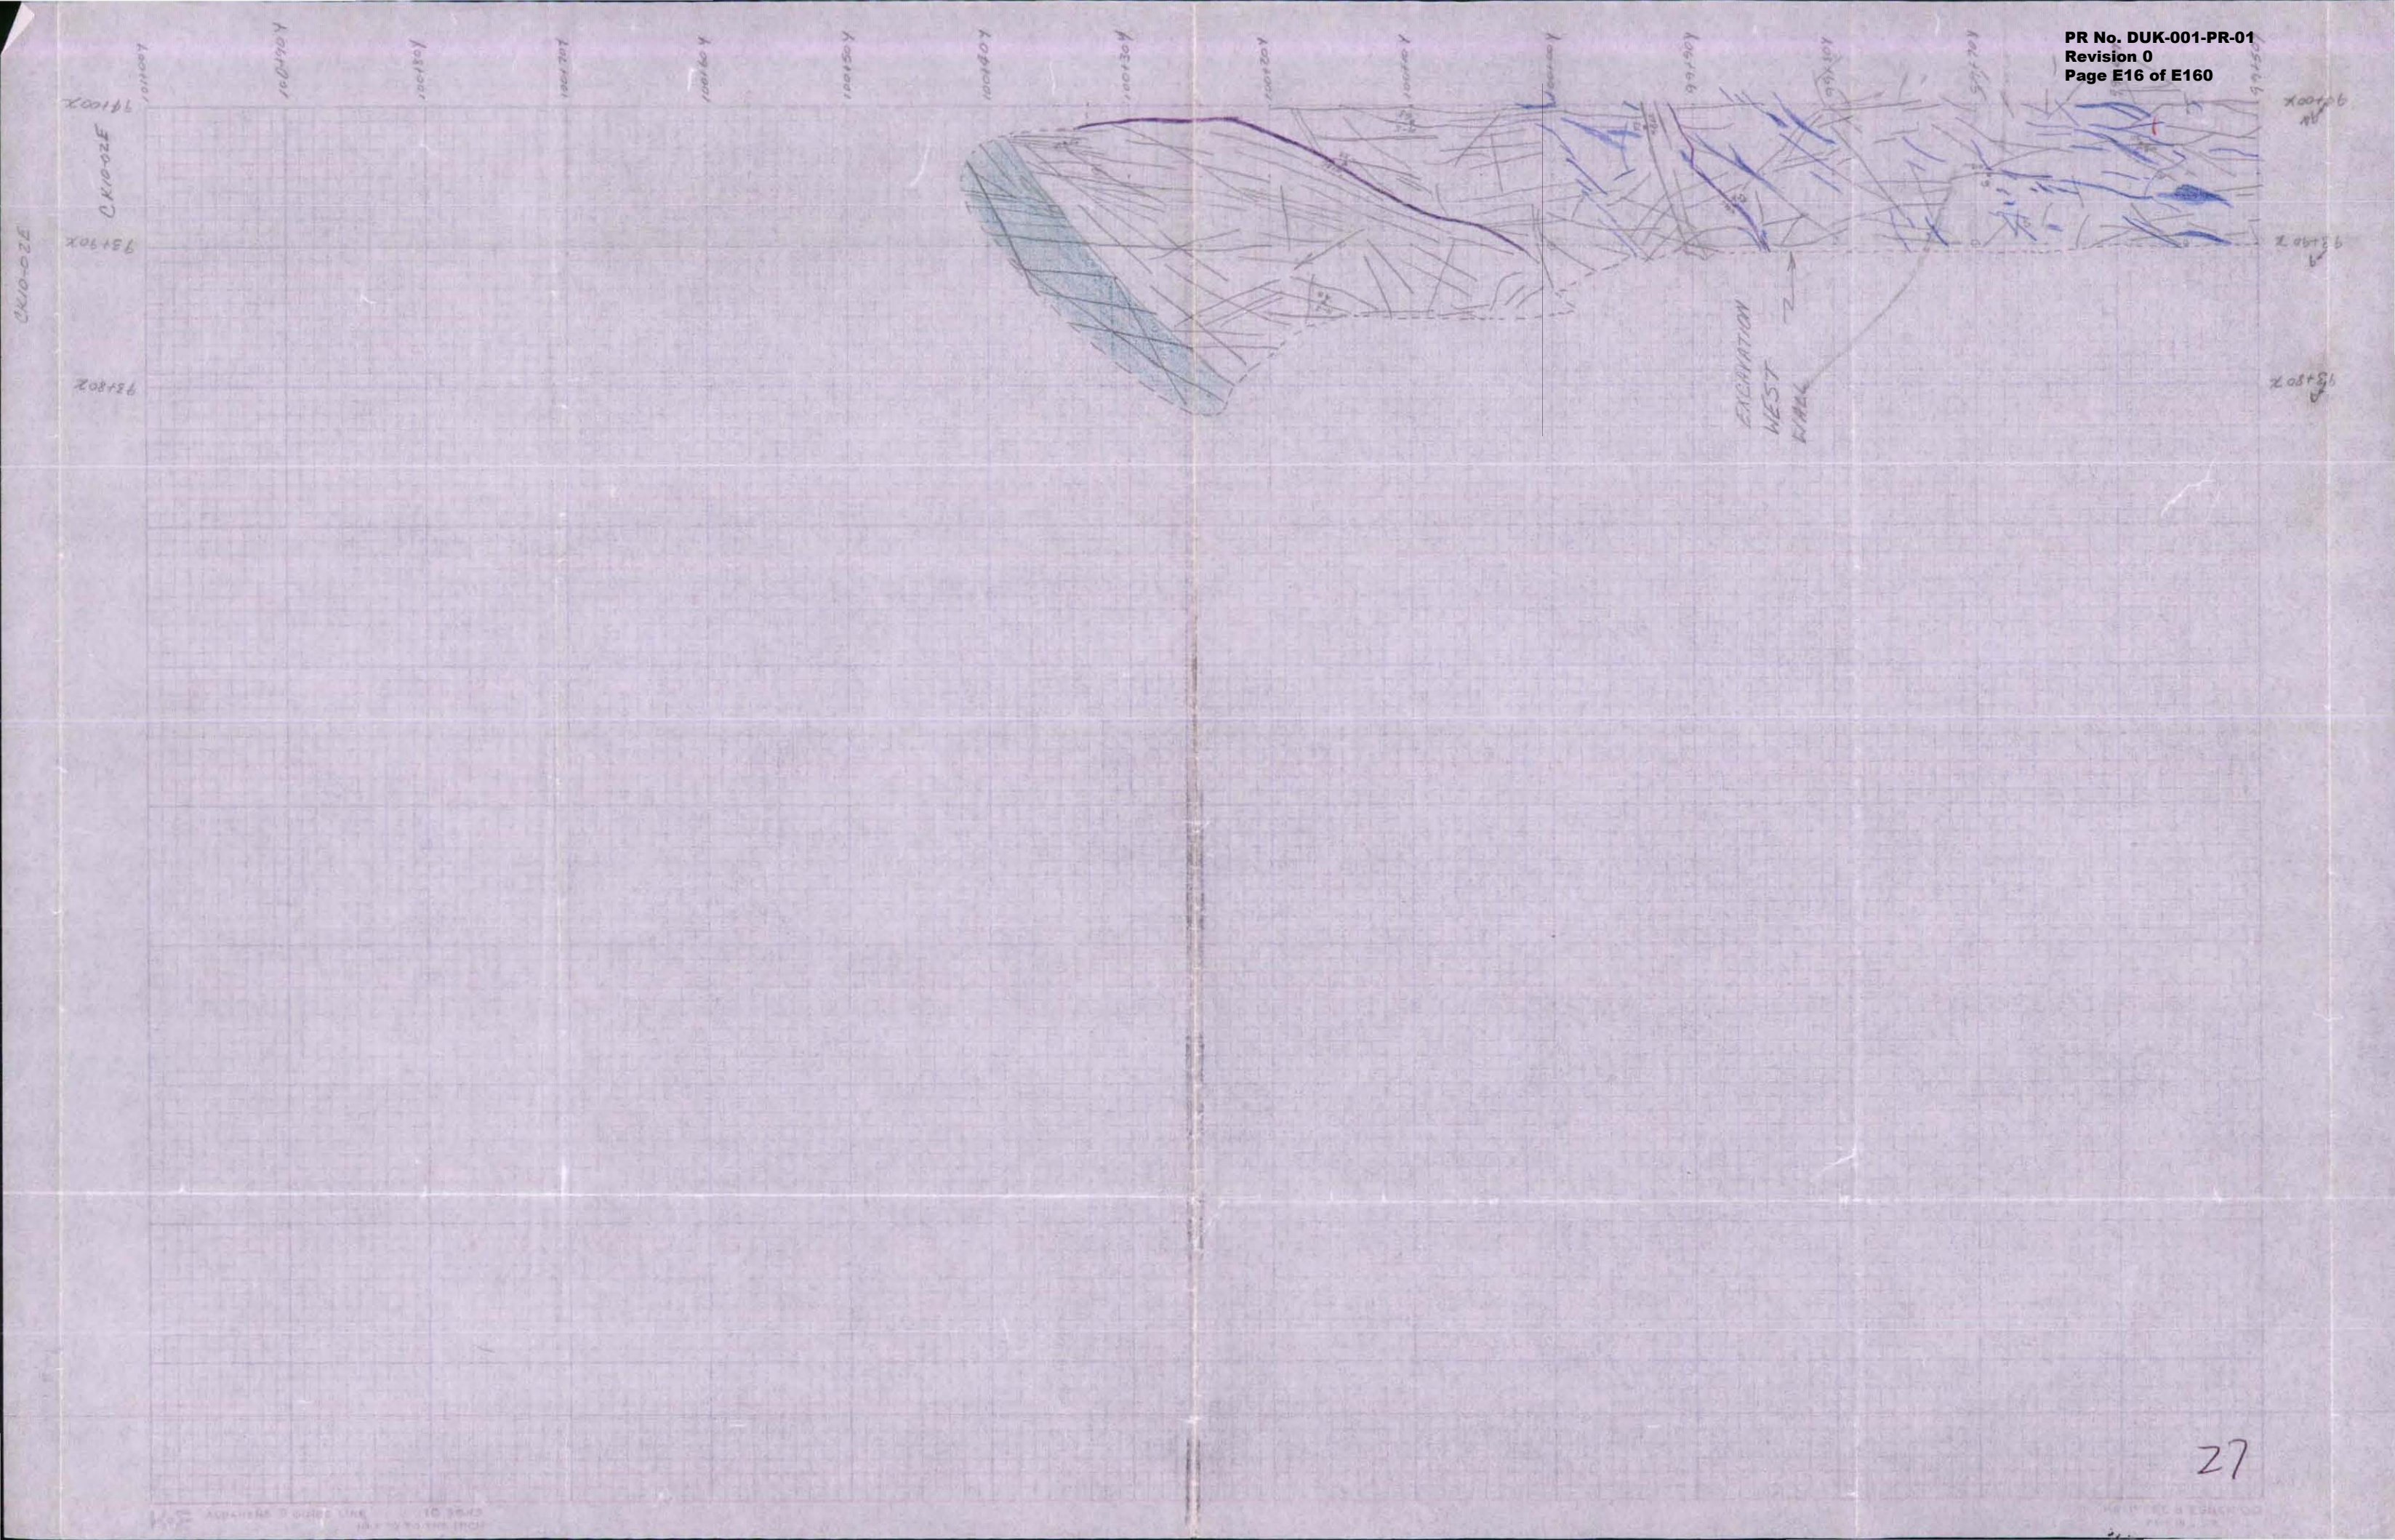



By No. 517/1000 of
at 94+100
94+100

94+00X
94+10X
94+20X
94+30X
94+40X
94+50X
94+60X
94+70X
94+80X
94+90X


CR10
28

93+00X

93+10X

93+10X

93+20X

93+20X

93+30X

93+30X

93+40X

93+40X

93+50X

93+50X

93+60X

93+60X

93+70X

93+70X

93+80X


93+80X

93+90X

93+90X

94+00X


94+00X

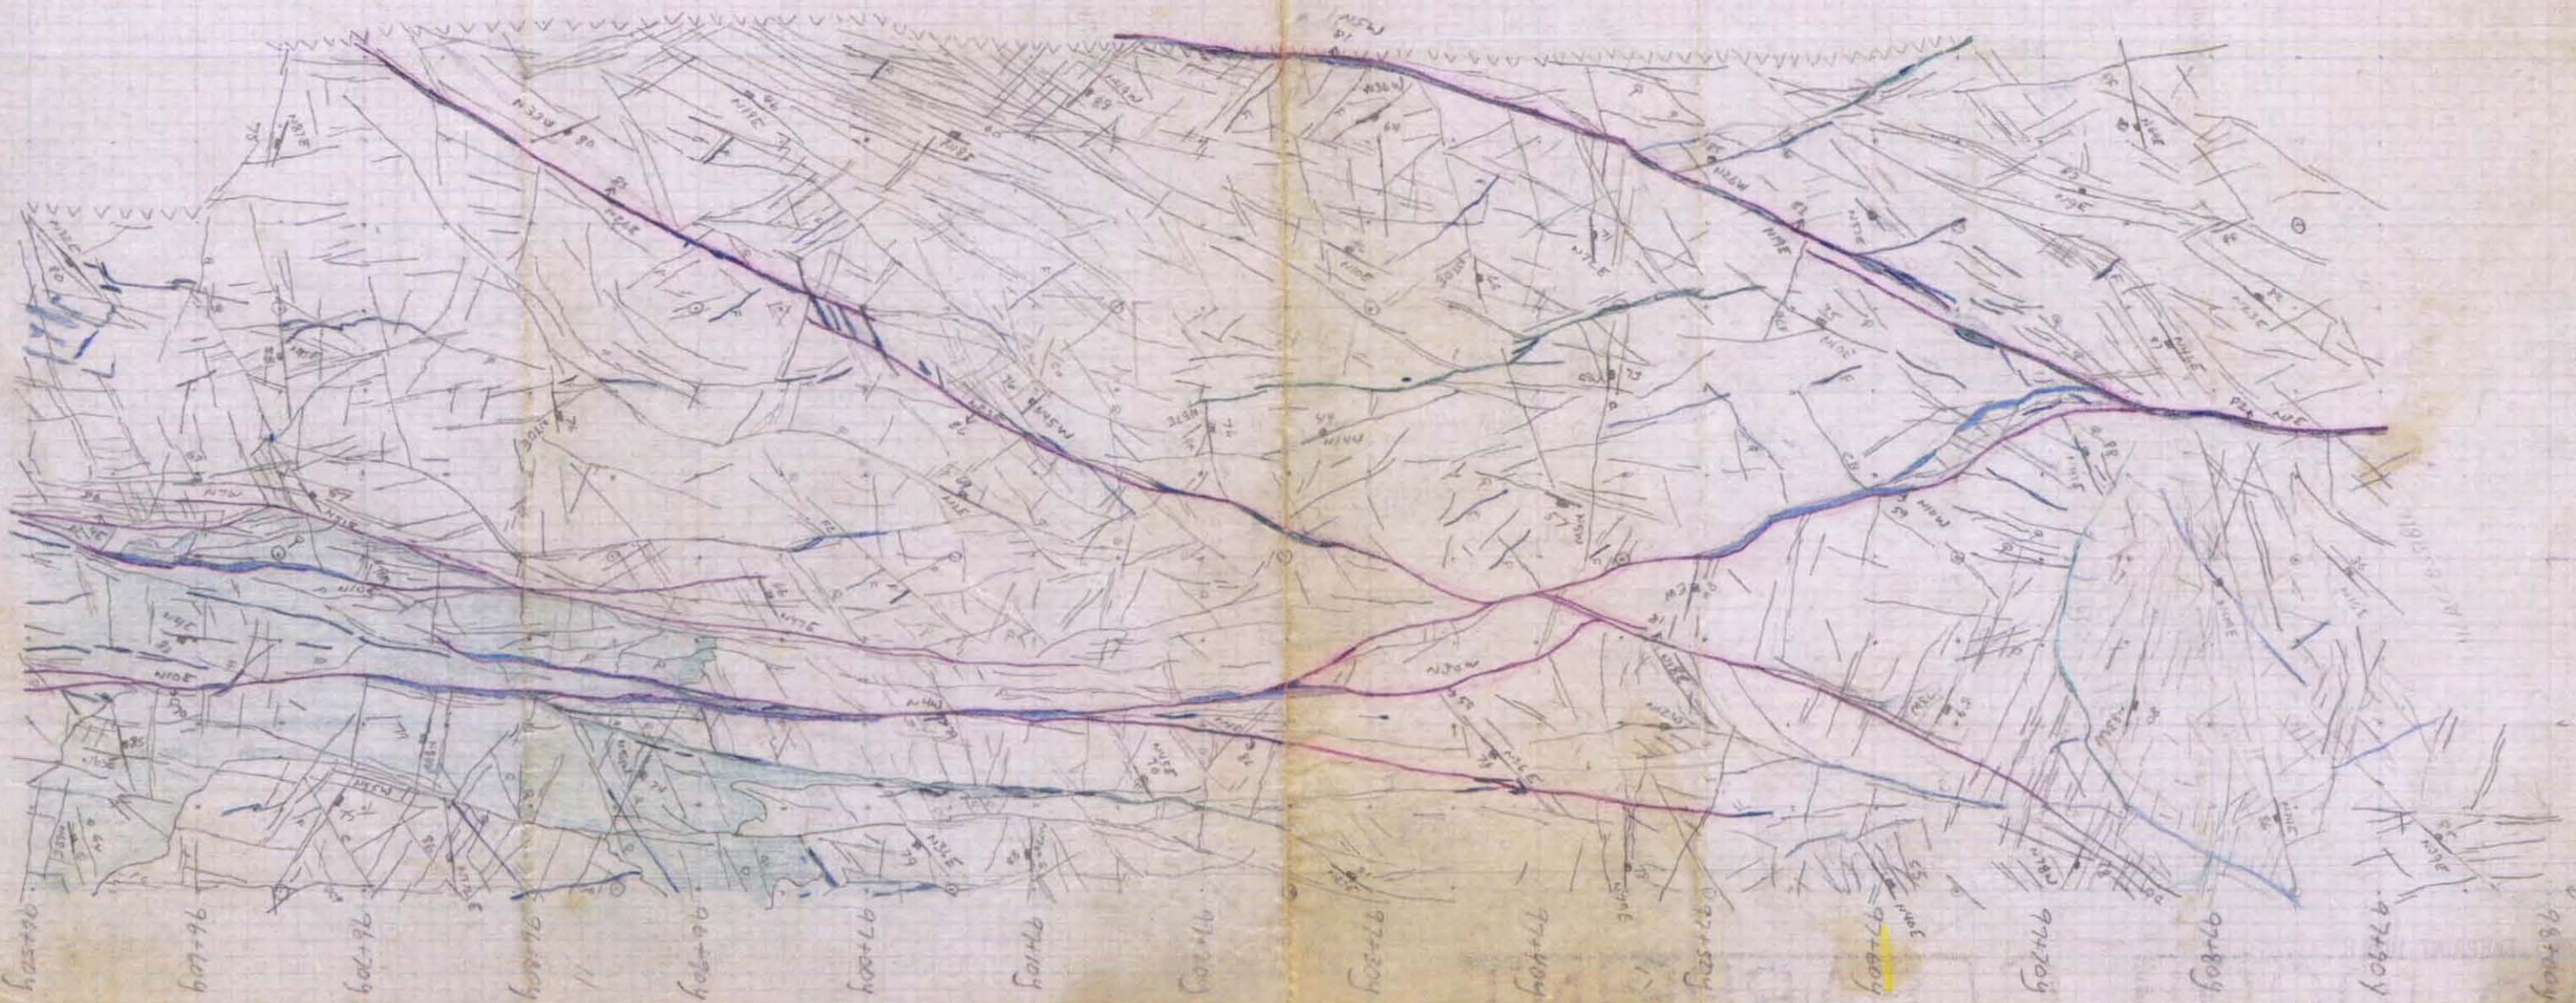

CR10-03A

CR10-03A



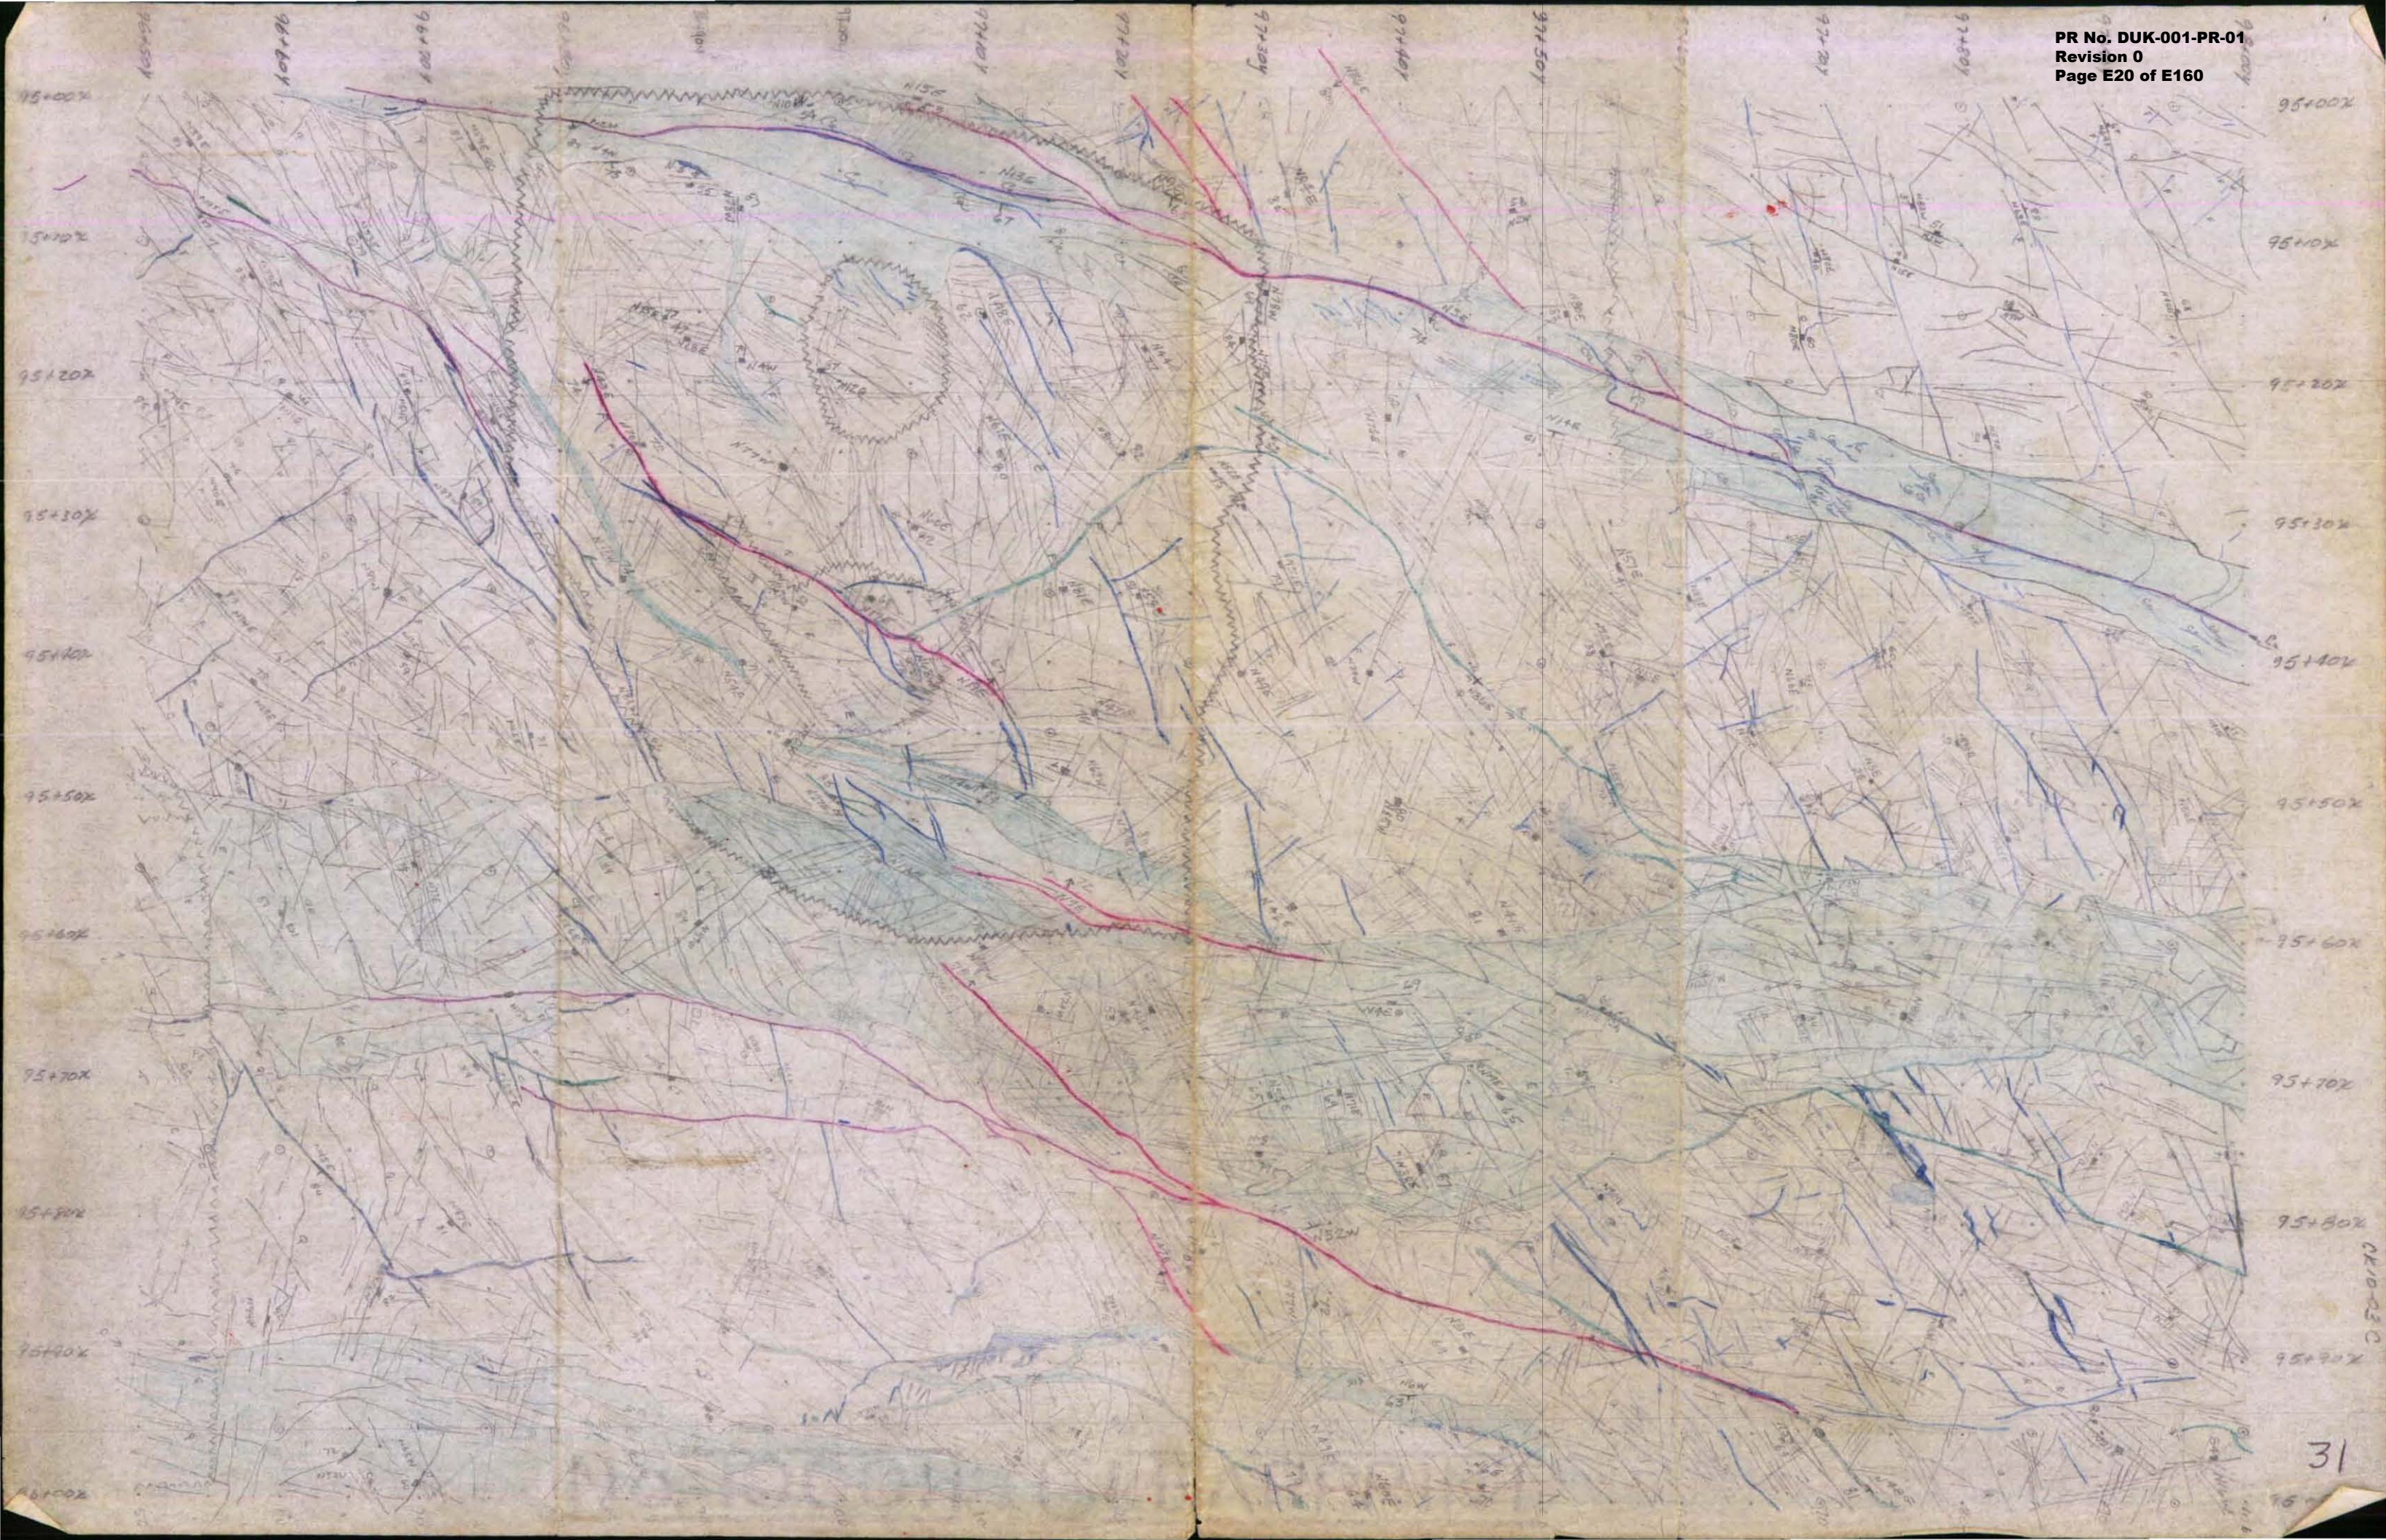

93+00X

93+10X

93+20X

93+30X

93+40X

93+50X

93+60X

93+70X

93+80X

93+90X

94+00X

32

93+00X

93+10X

93+20X

93+30X

93+40X

93+50X

93+60X


93+70X

93+80X

93+90X

94+00X

32

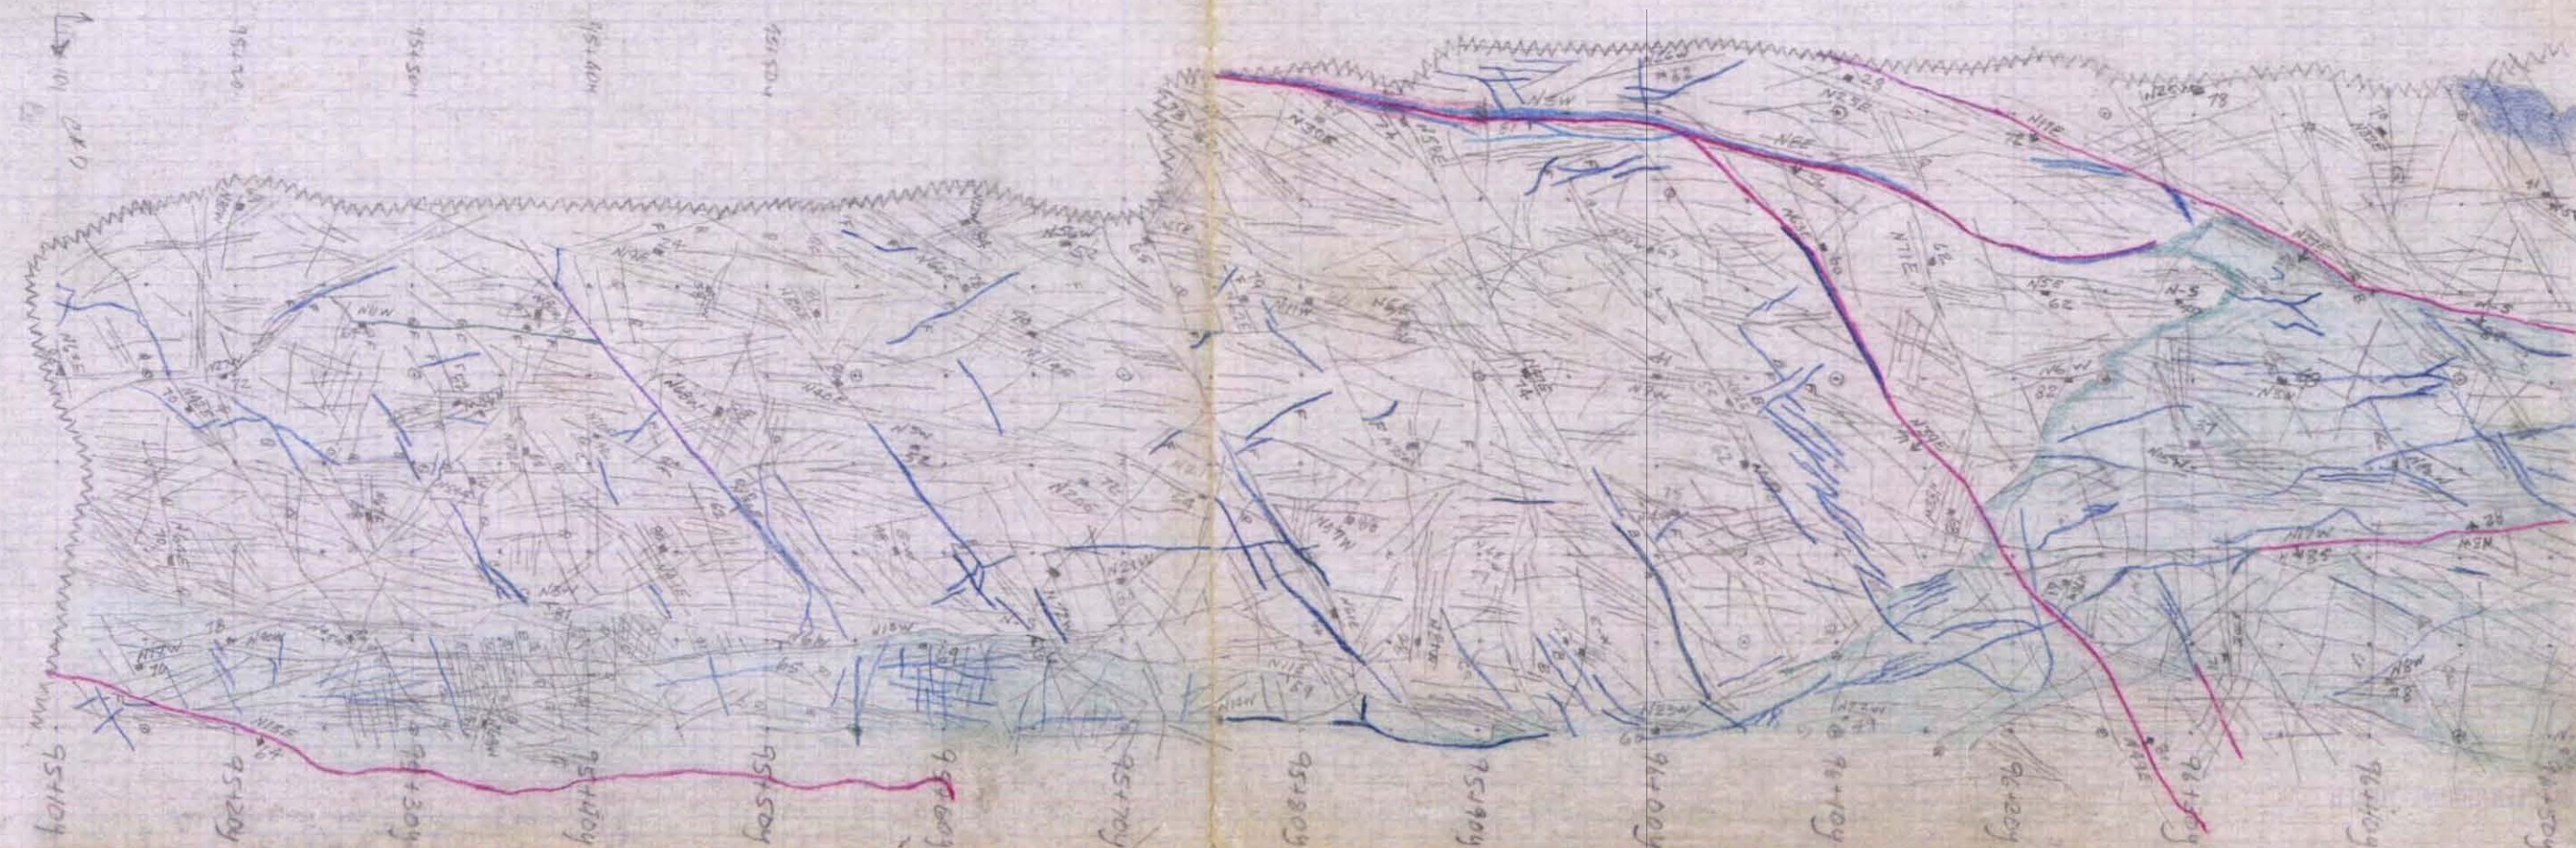

CK10-03D

CK10-03D



94+00 X

94+10 X

94+20 X

94+30 X

94+40 X

94+50 X

94+60 X

94+70 X

94+80 X

94+90 X

95+00 X

DK10-03E

94+00 X

94+10 X

94+20 X

94+30 X

94+40 X

94+50 X

94+60 X

94+70 X


94+80 X

94+90 X

95+00 X

DK10-03E

33

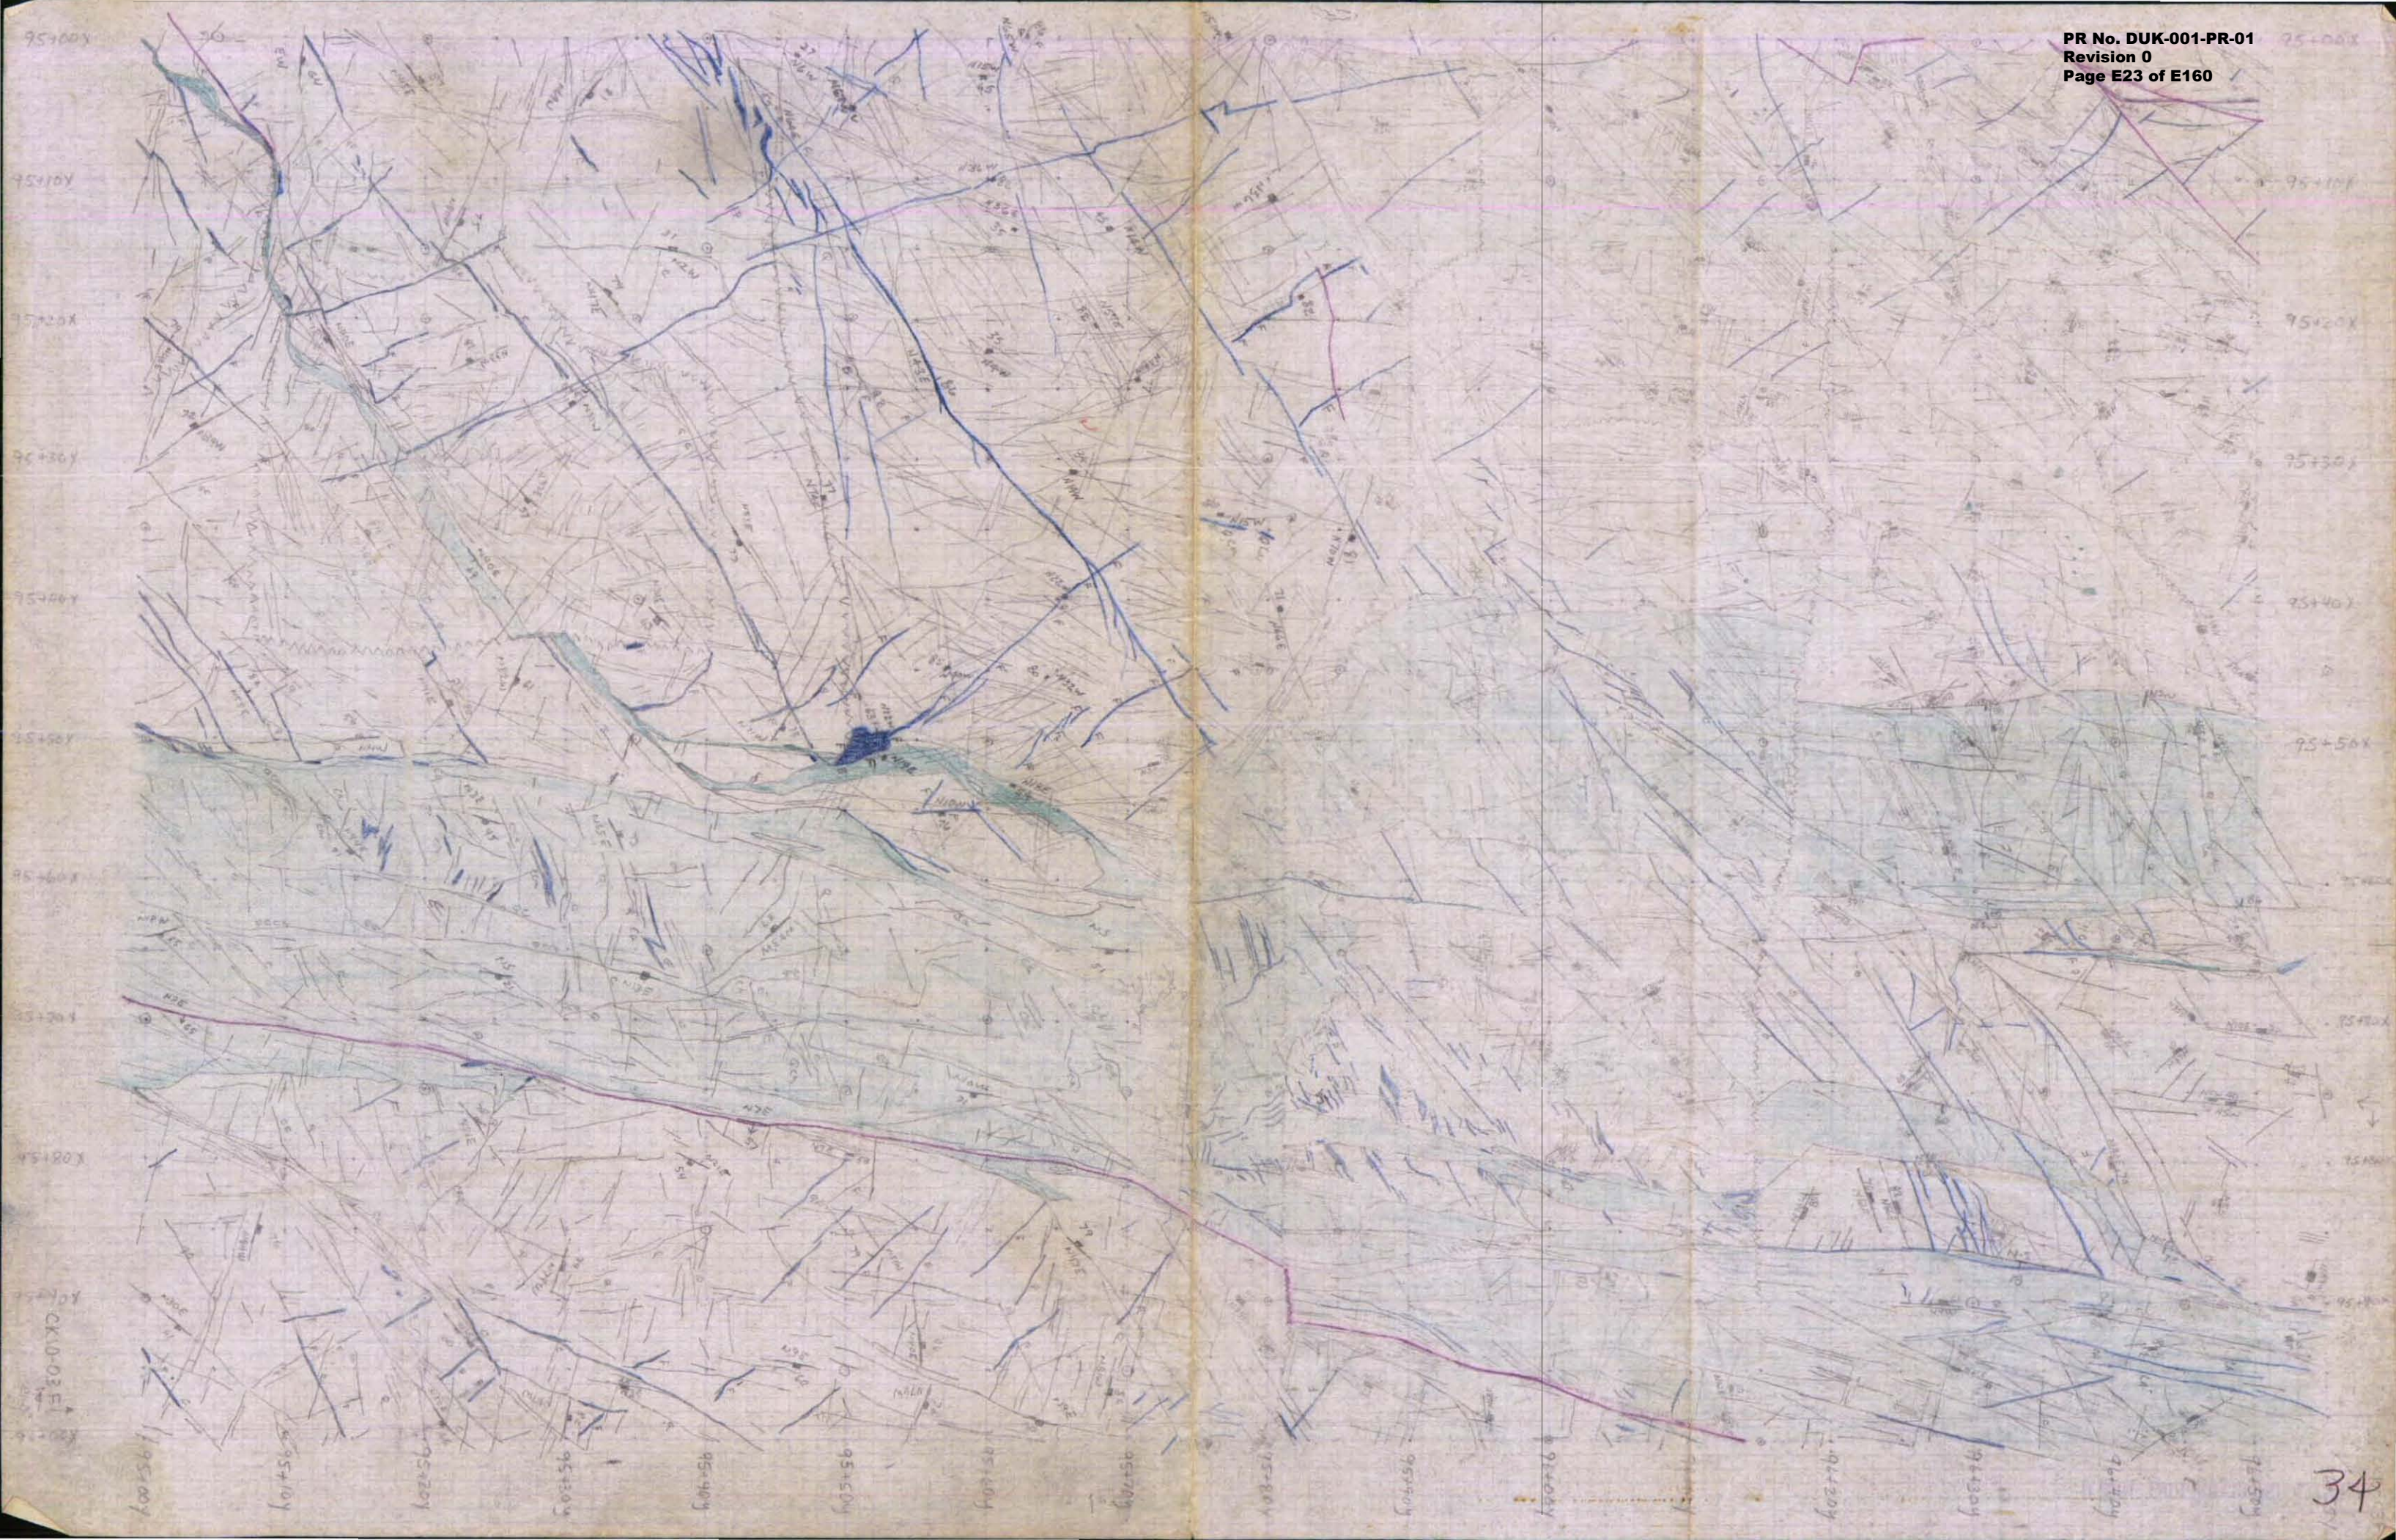

95+00Y
95+10Y
95+20Y
95+30Y
95+40Y
95+50Y
95+60Y
95+70Y
95+80Y
95+90Y

95+00X
95+10X
95+20X
95+30X
95+40X
95+50X
95+60X
95+70X
95+80X
95+90X



CR10-04 A


CK10-04B



96+00 X
95+90 X
95+80 X
95+70 X
95+60 X
95+50 X
95+40 X
95+30 X
95+20 X
95+10 X
95+00 X
36

94+00X
94+10X
94+20X
94+30X
94+40X
94+50X
94+60X
94+70X
94+80X
94+90X
95+00X


94+00X
94+10X
94+20X
94+30X
94+40X
94+50X
94+60X
94+70X
94+80X
94+90X
95+00X


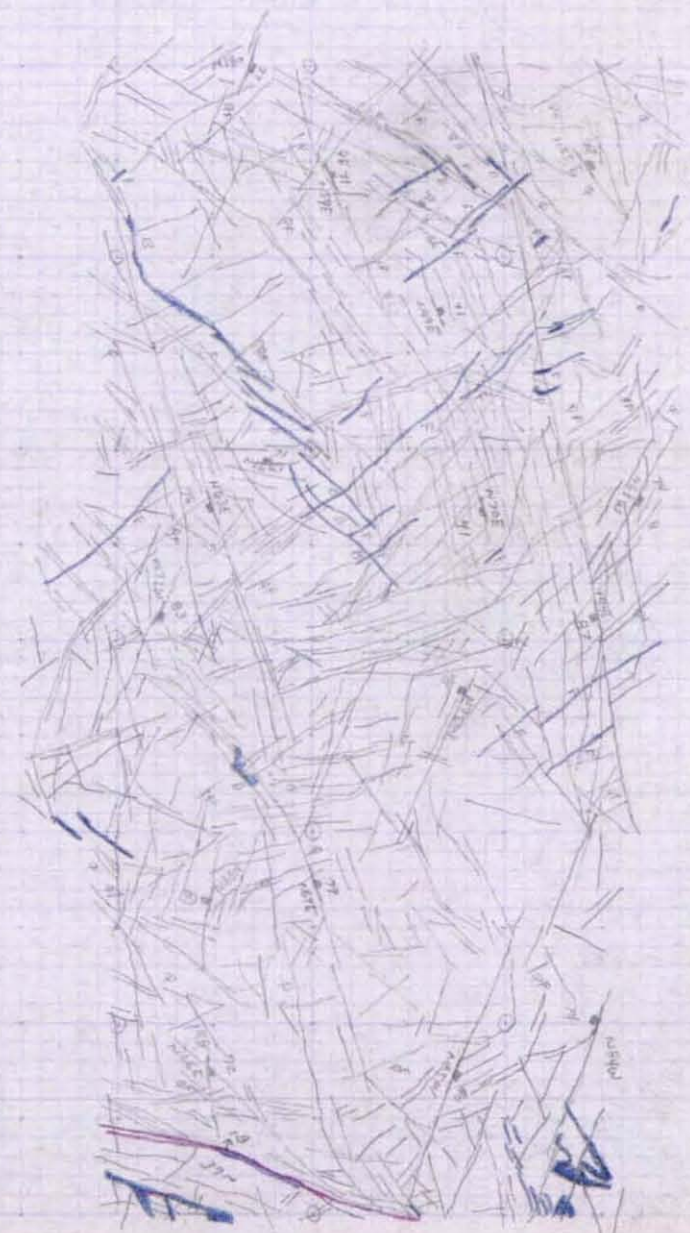



37

95+00X
95+10X
95+20X
95+30X
95+40X
95+50X
95+60X
95+70X
95+80X
95+90X
96+00X


95+00X
95+10X
95+20X
95+30X
95+40X
95+50X
95+60X
95+70X
95+80X
95+90X
96+00X

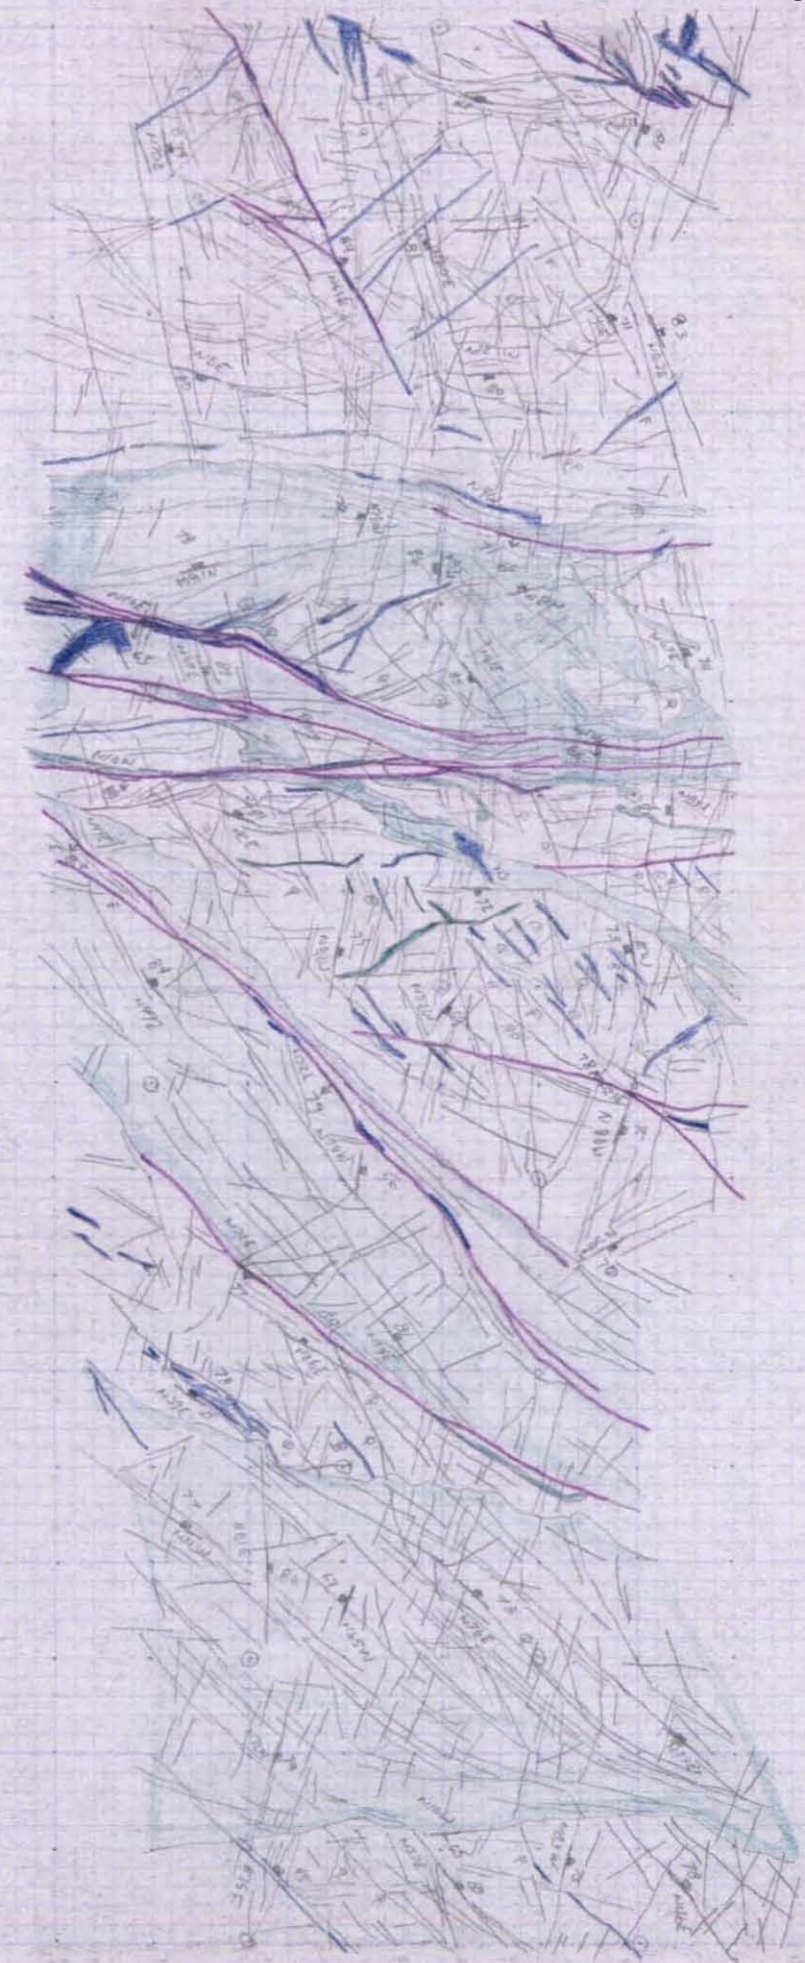

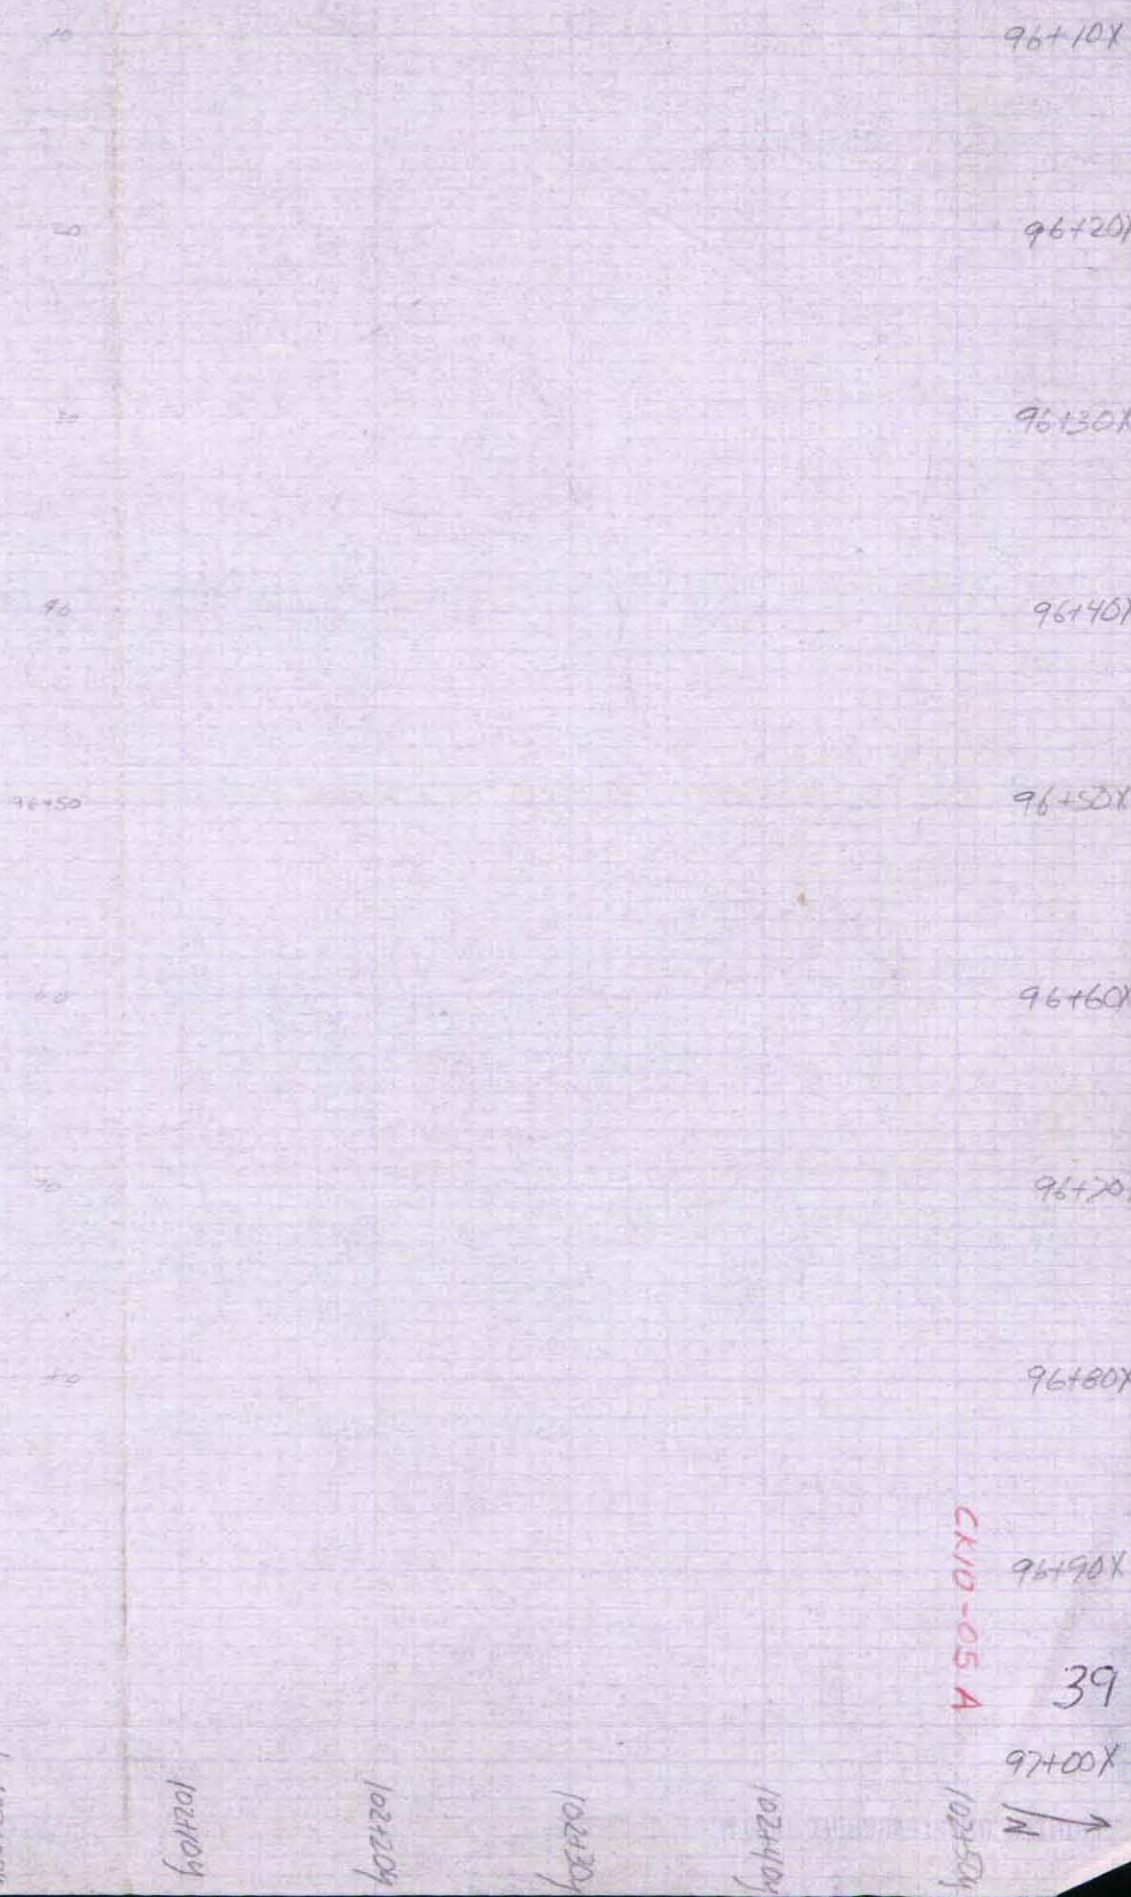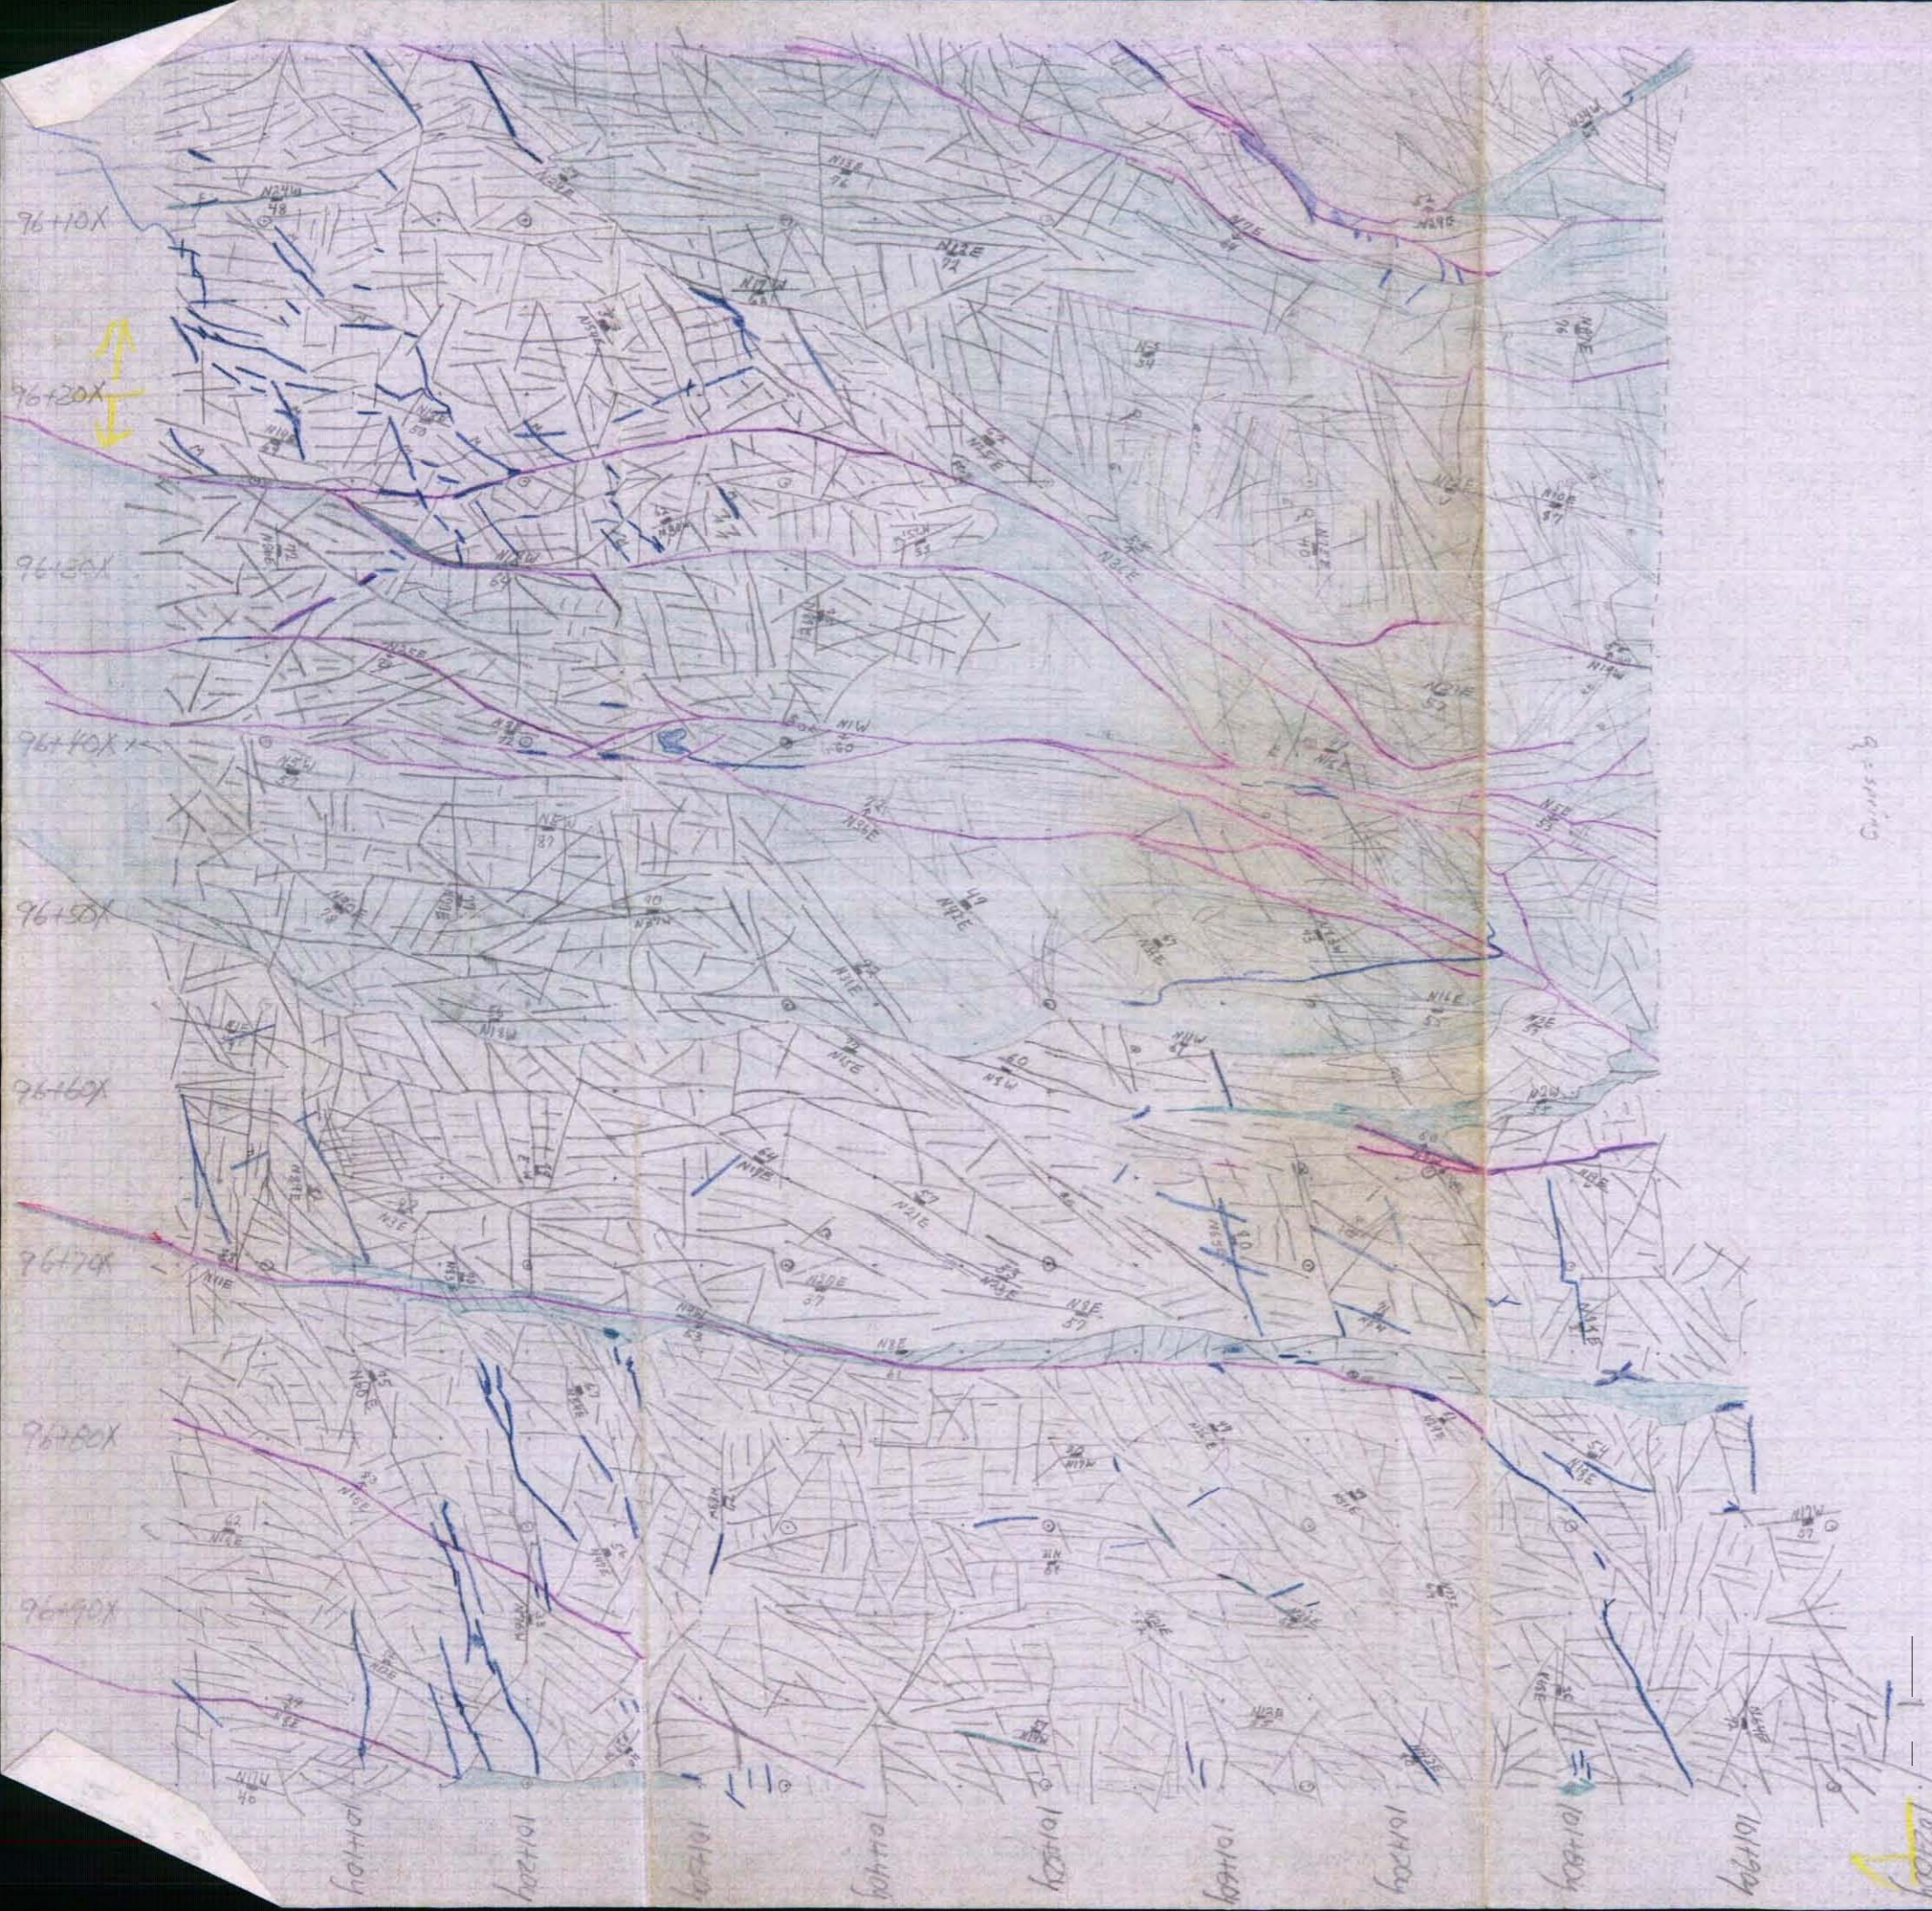

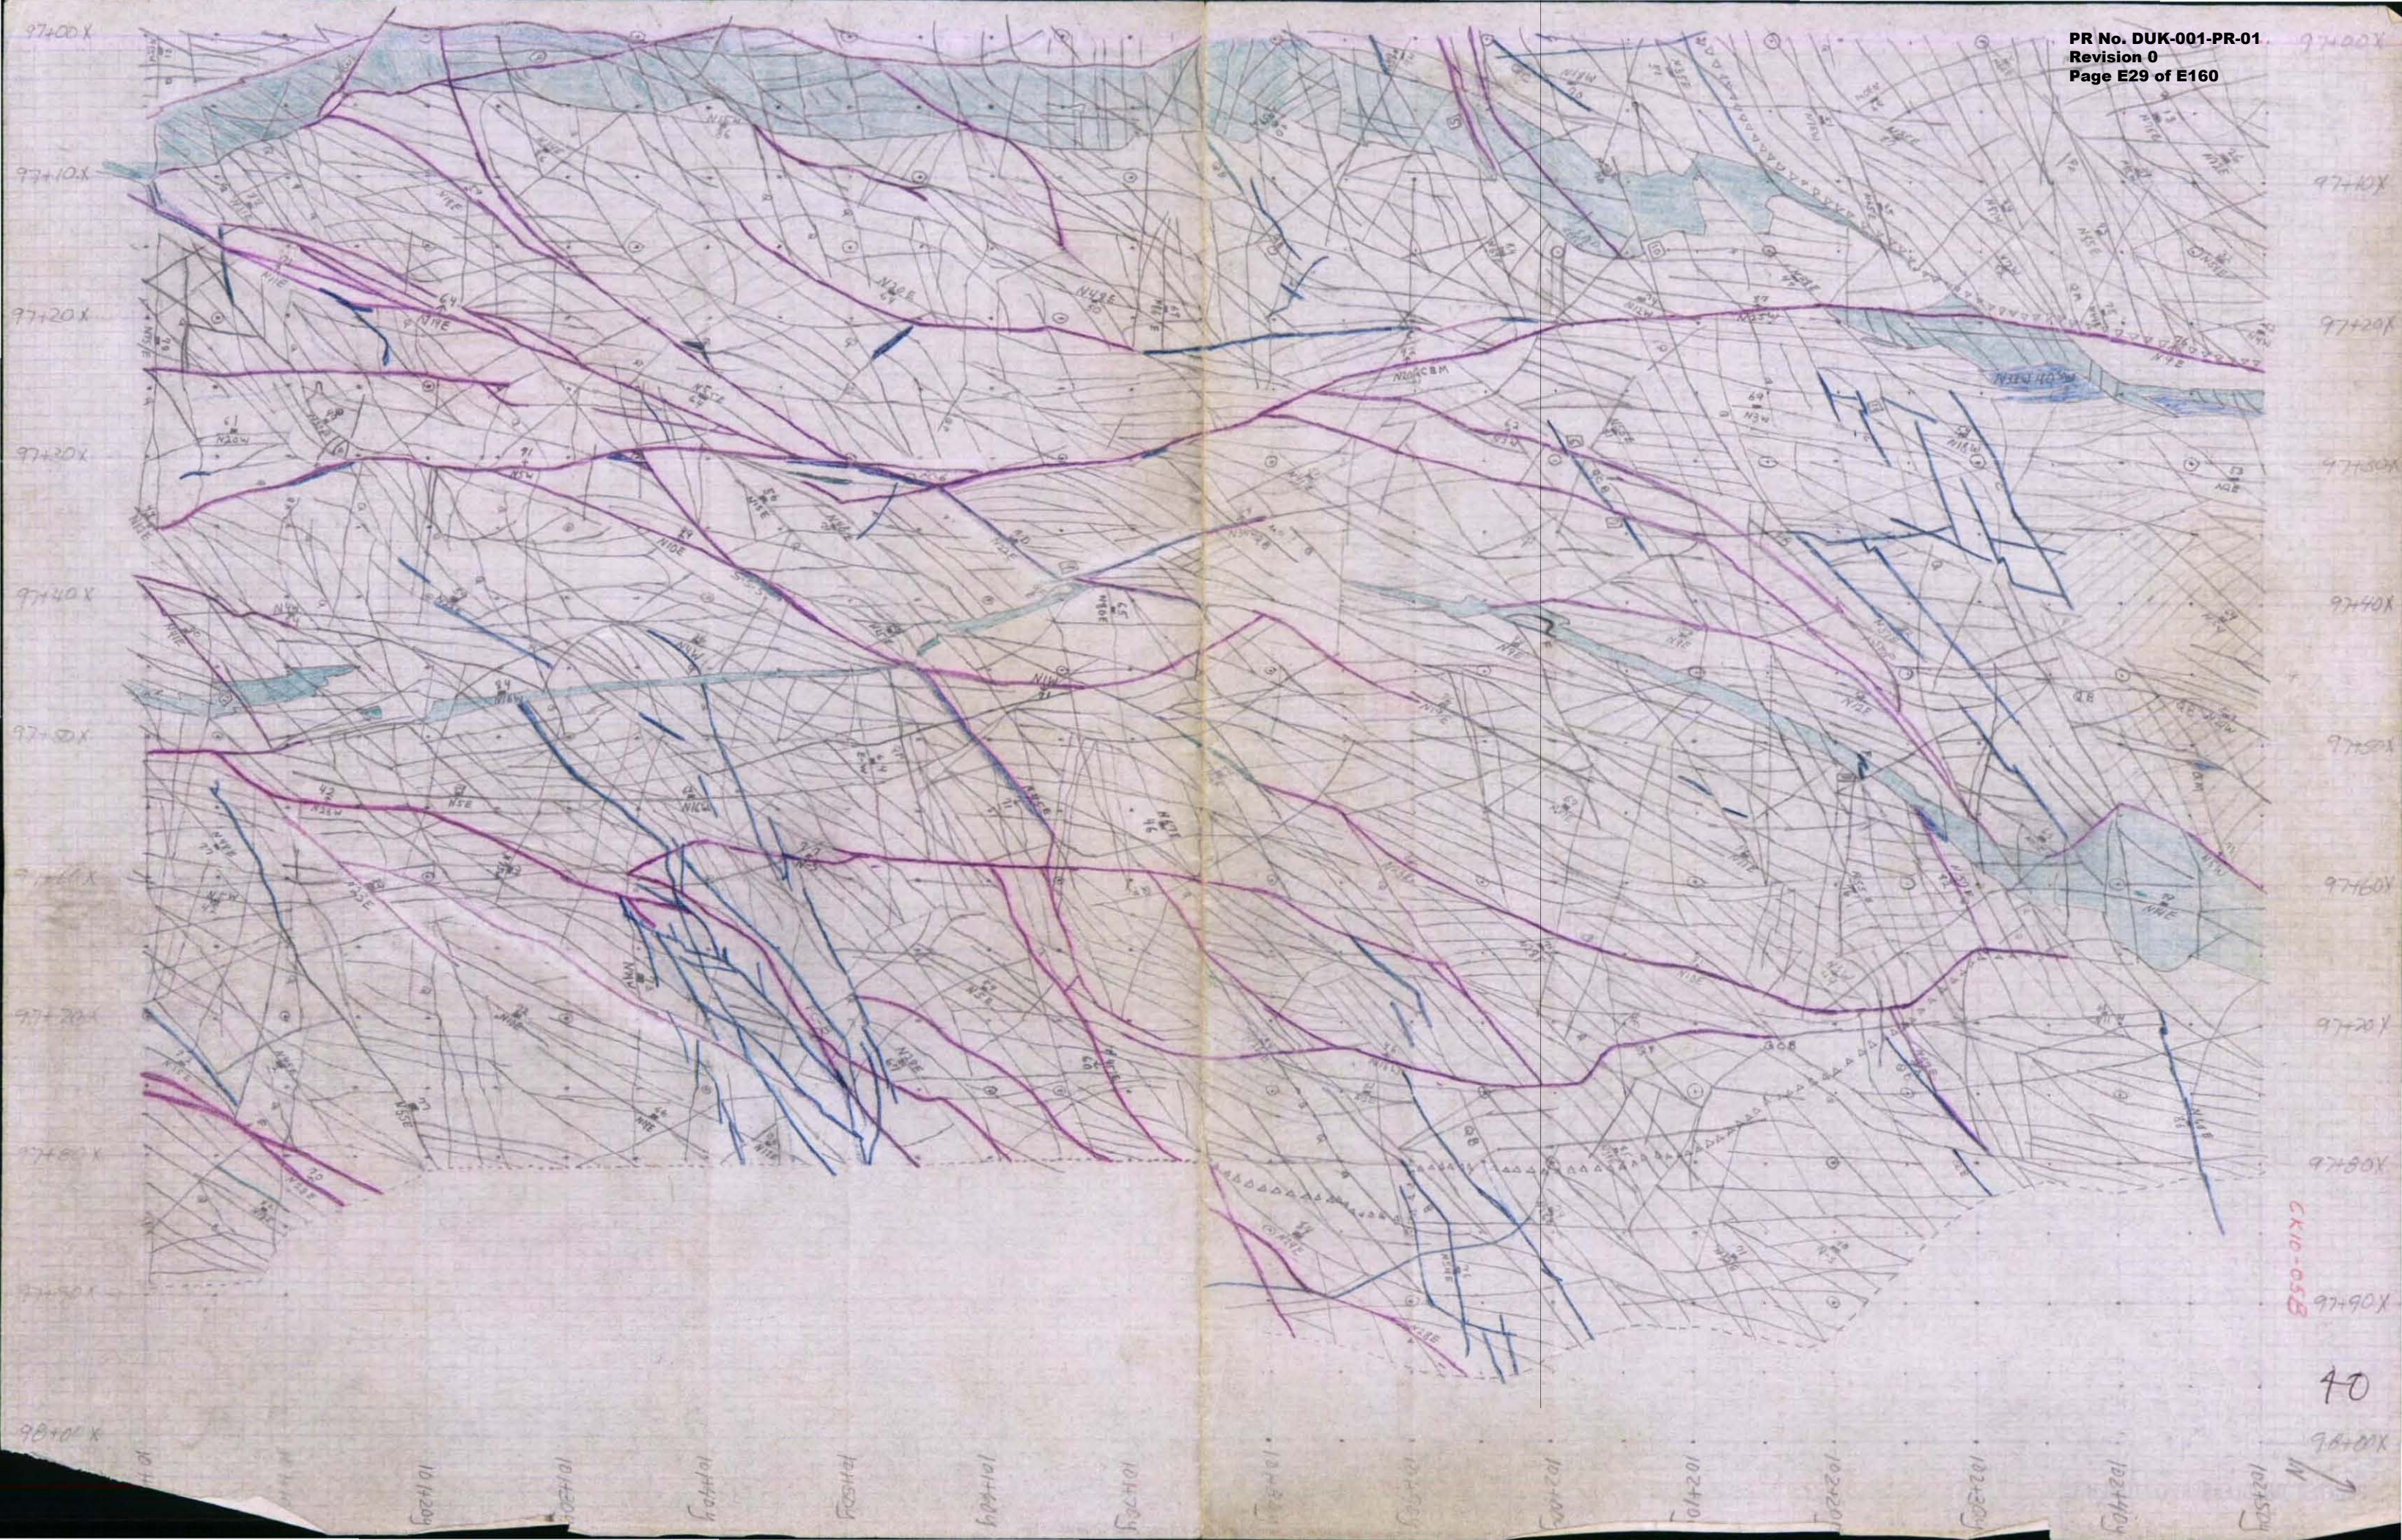

97+00X
97+10X
97+20X
97+30X
97+40X
97+50X
97+60X
97+70X
97+80X
97+90X
98+00X
CR10-05B
40
98+00X
101+00
101+20
101+40
101+60
101+80
102+00
102+20
102+40
102+60
102+80
102+50

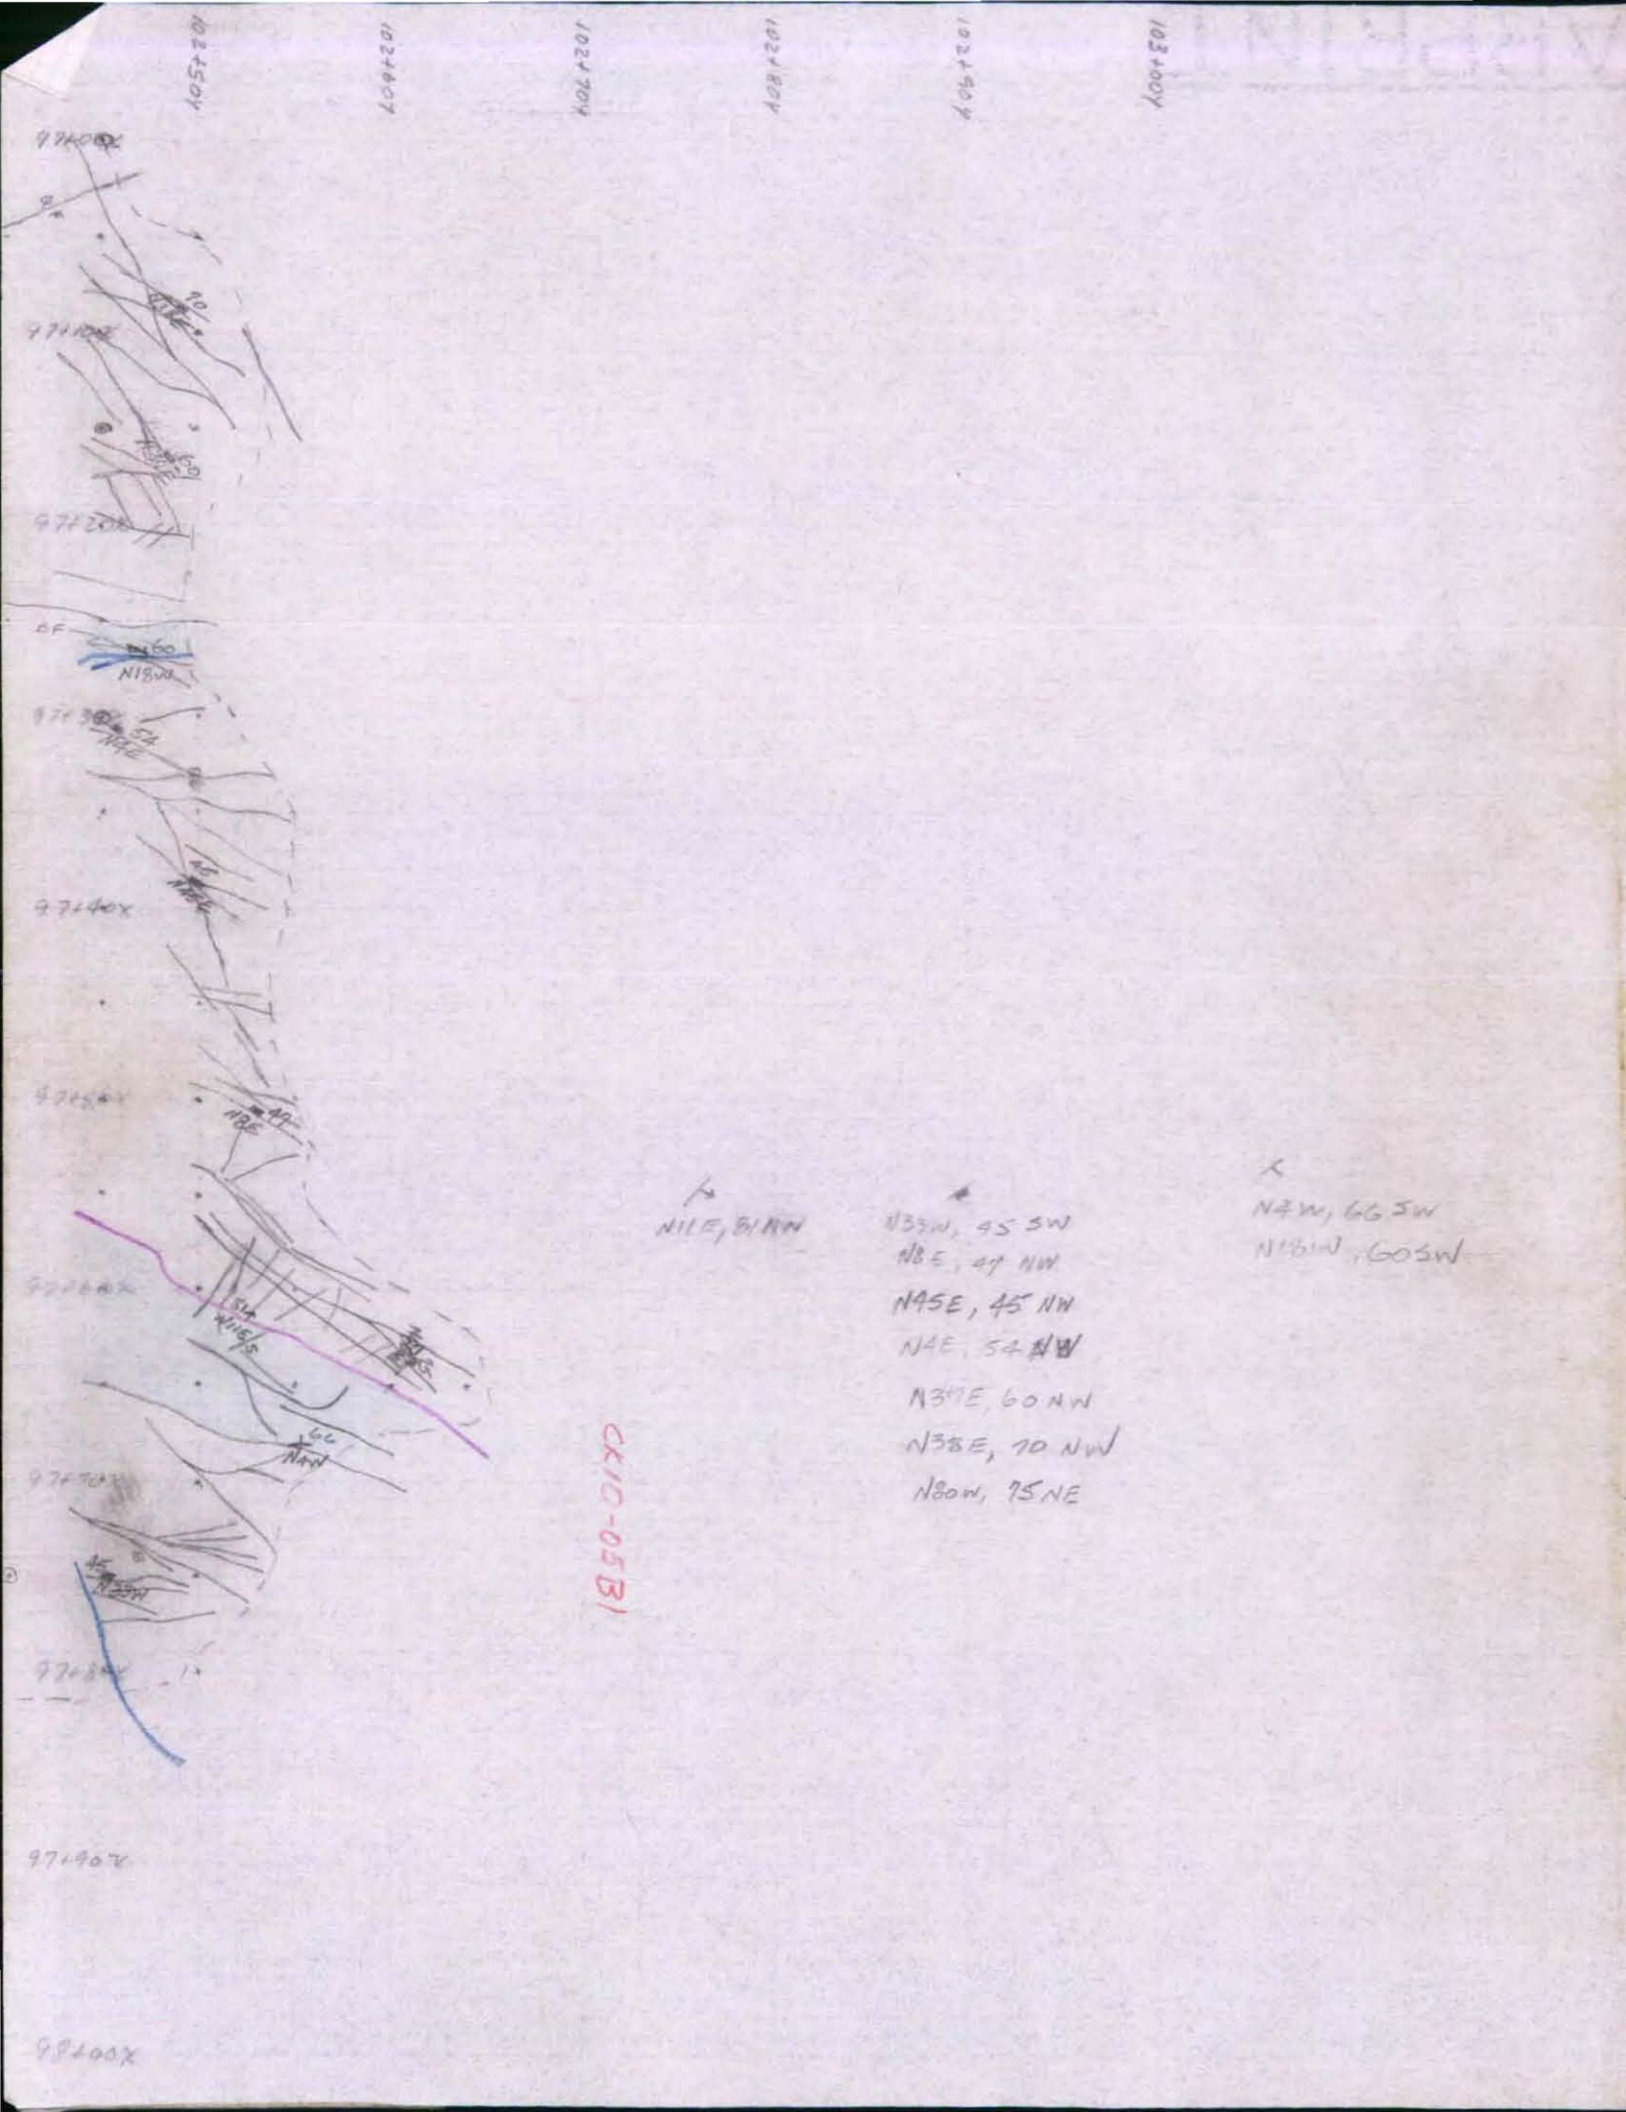


h
N15E, 81NW


h
N35W, 45 SW
N8E, 41 NW
N45E, 45 NW
N4E, 54 NW
N31E, 60 NW
N38E, 70 NW
N80W, 75 NE

x
N4W, 66 SW
N16W, 60 SW

CK10-05B1

41
CK10-05C

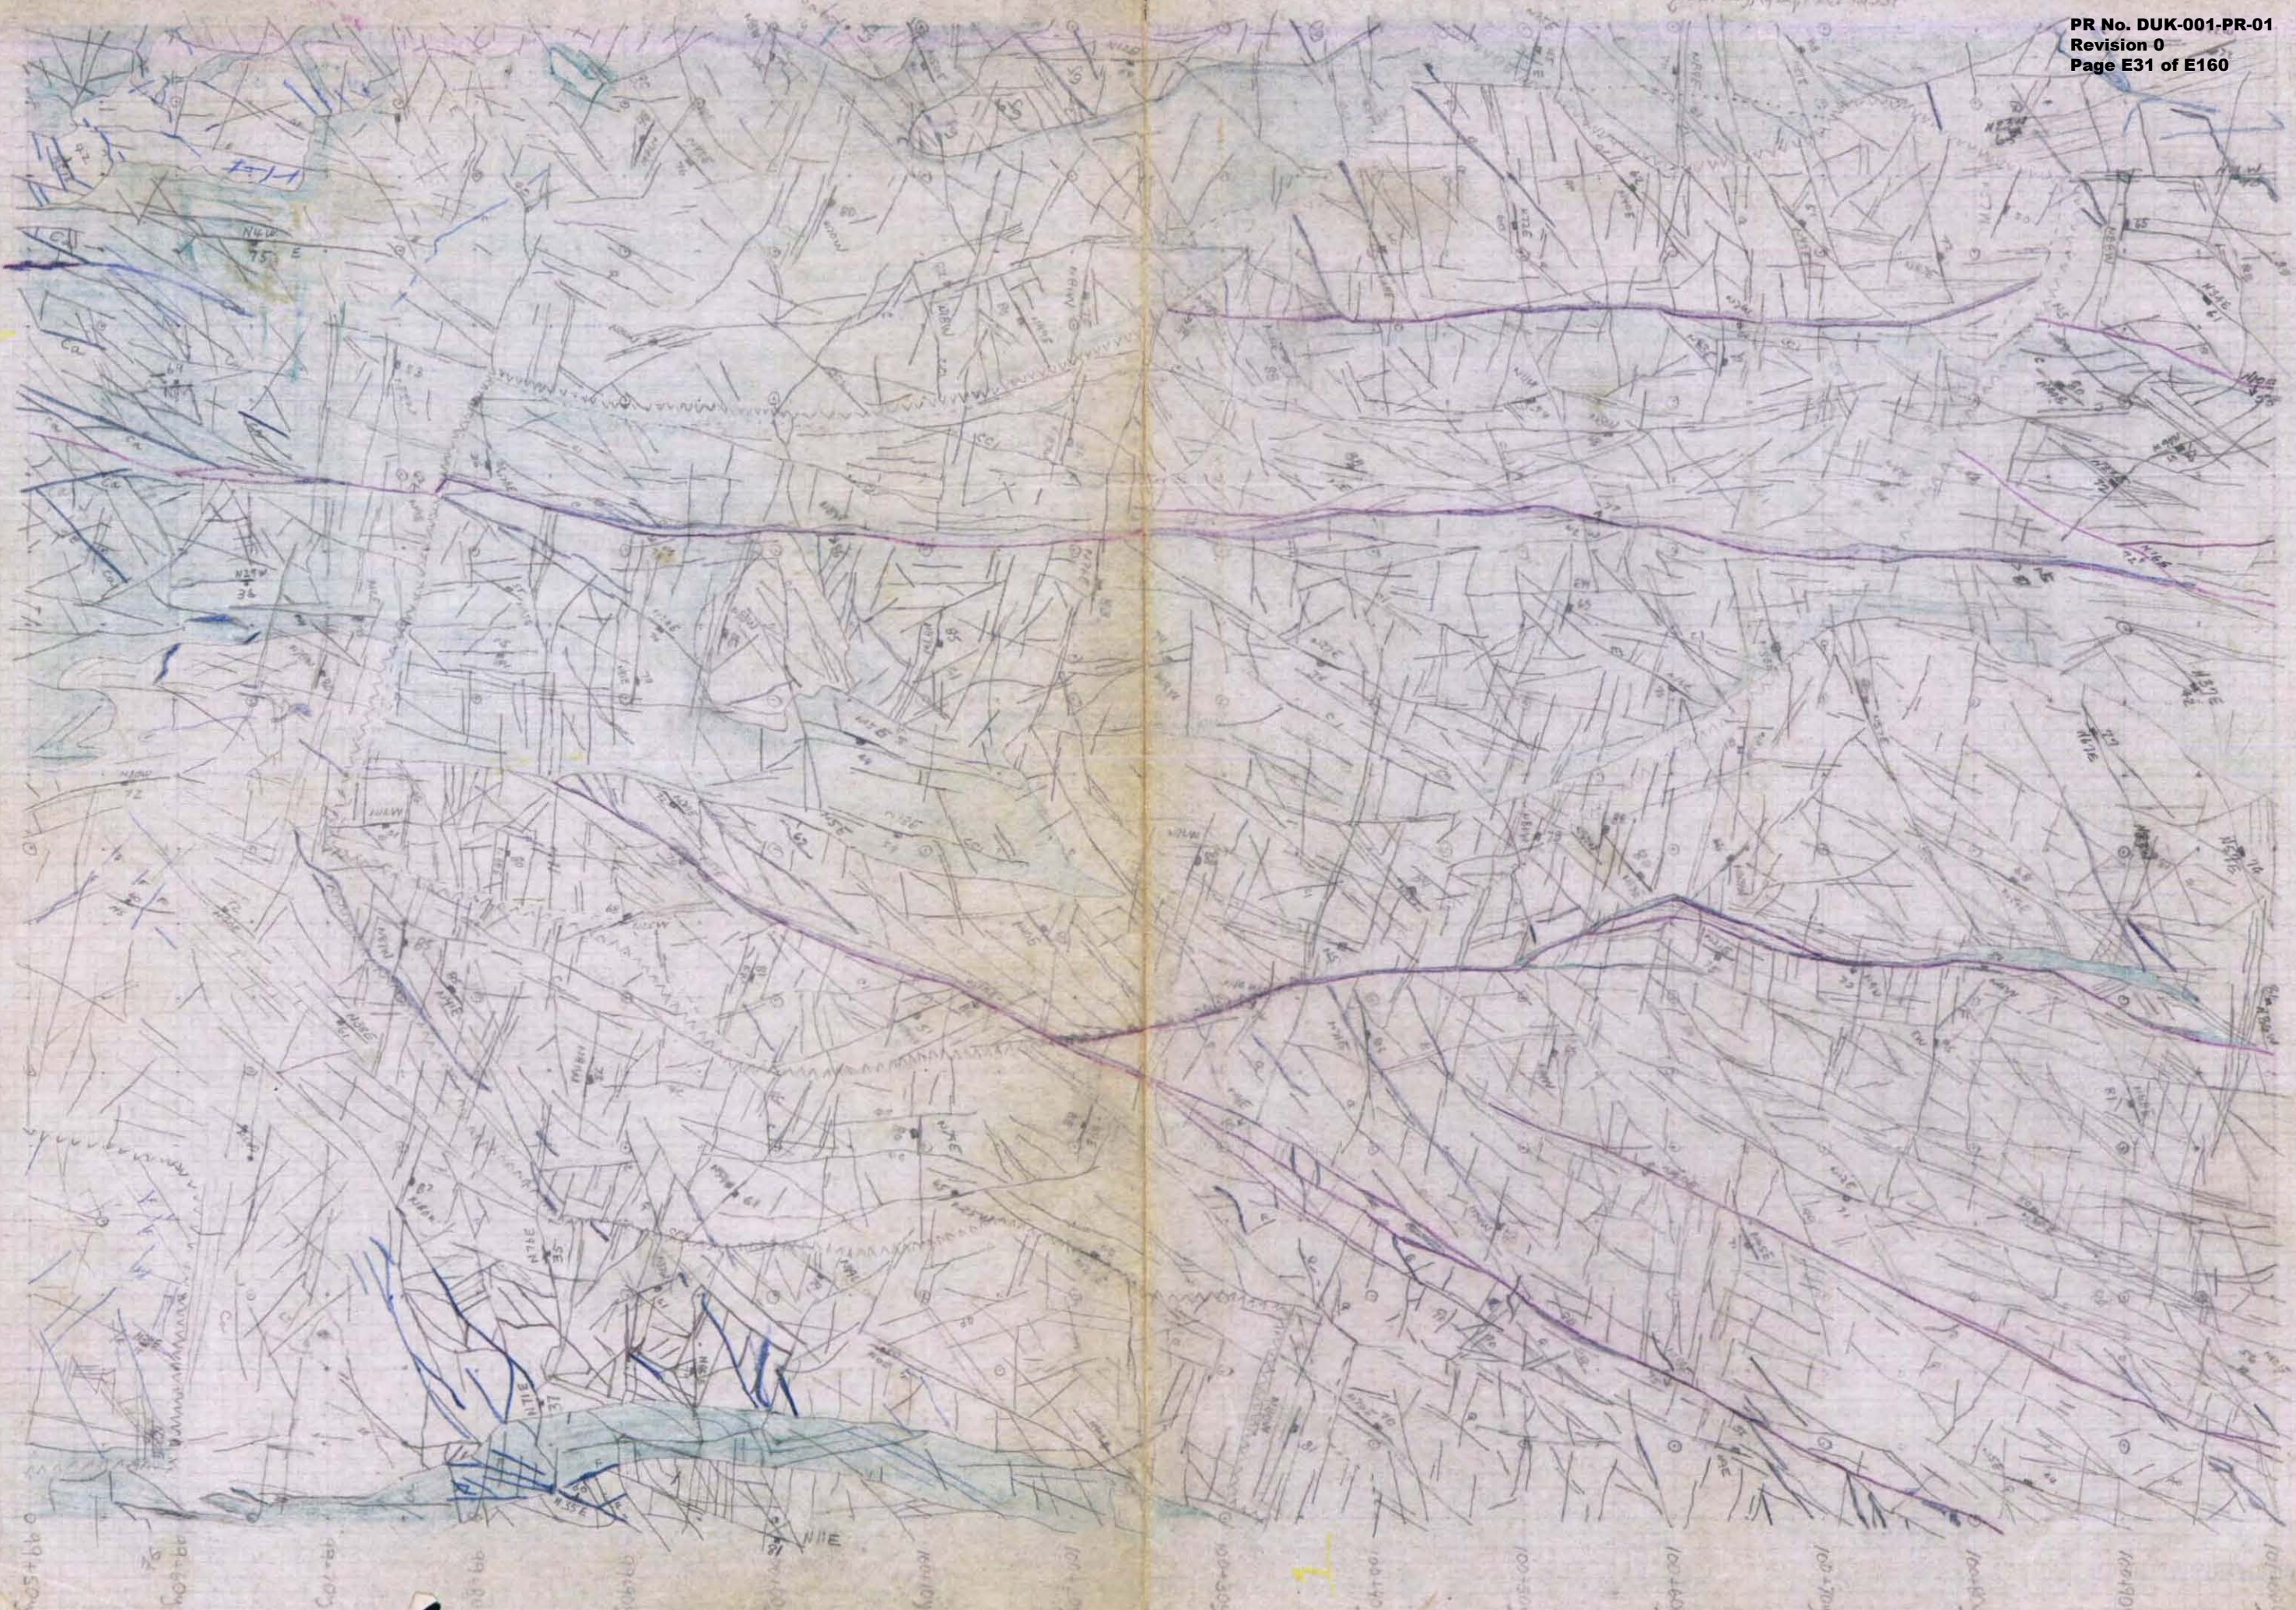


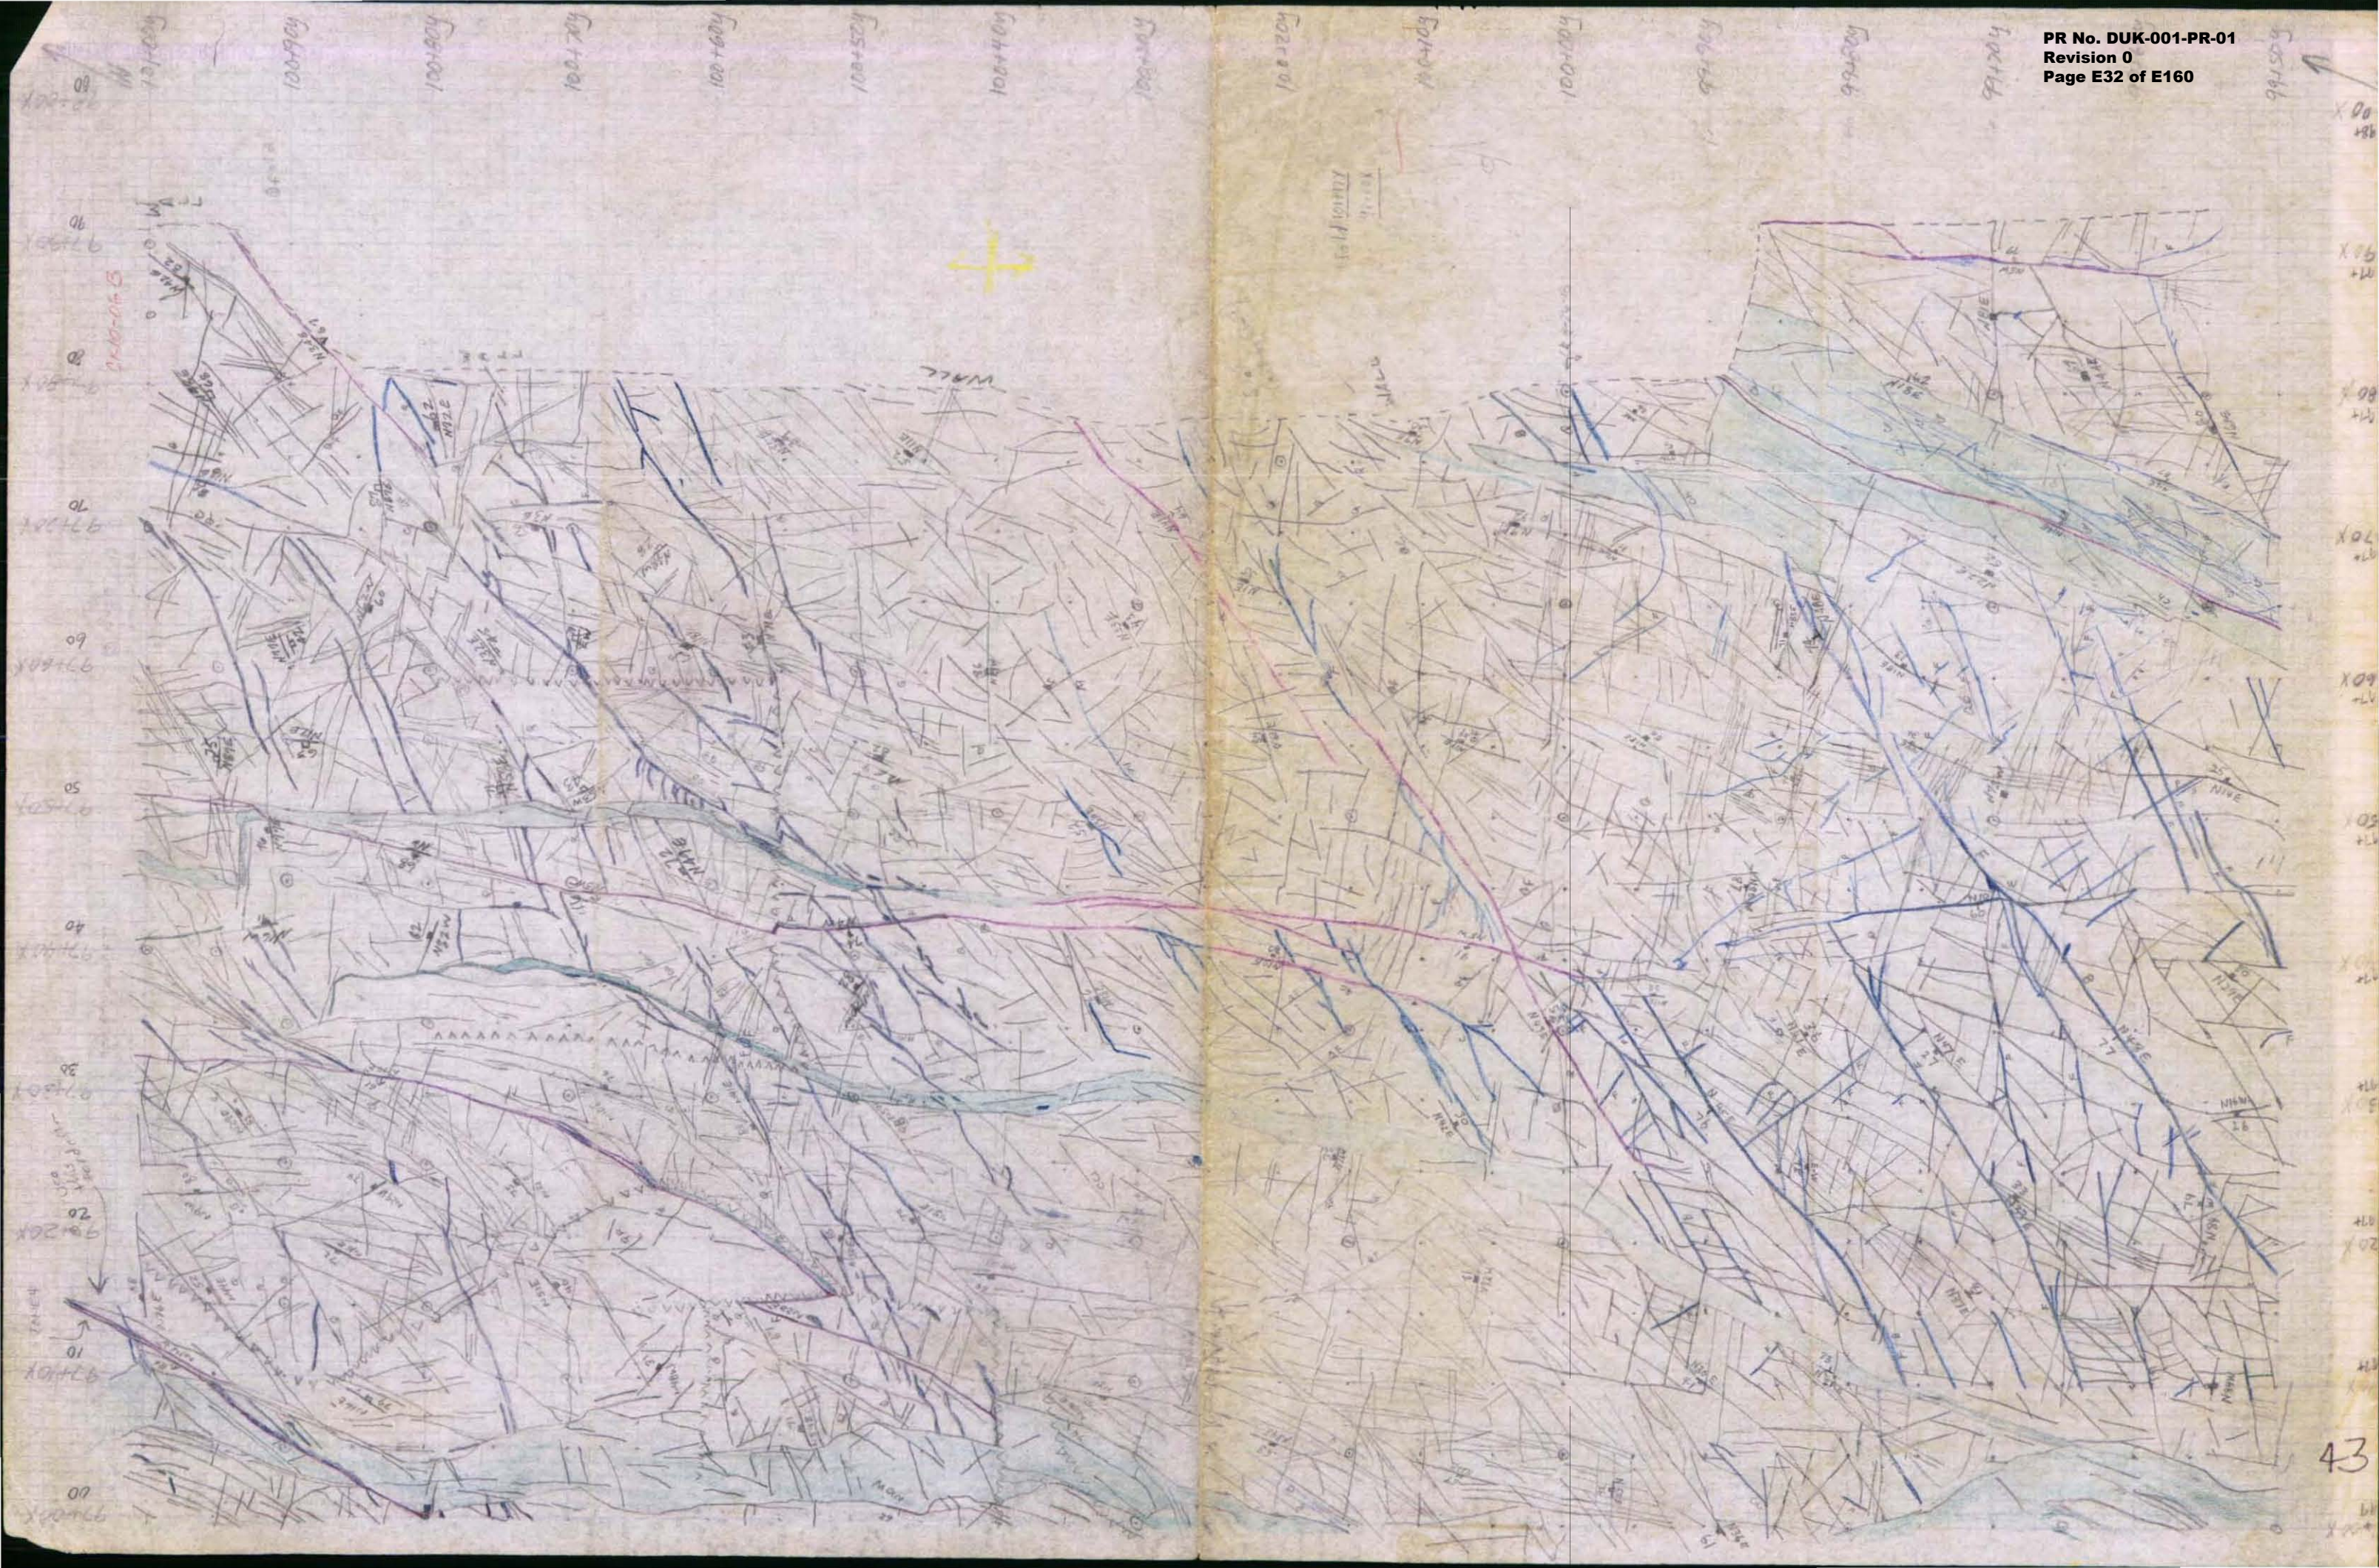





NOTES
CR. SHEARS ?
SWAMPY PATCH

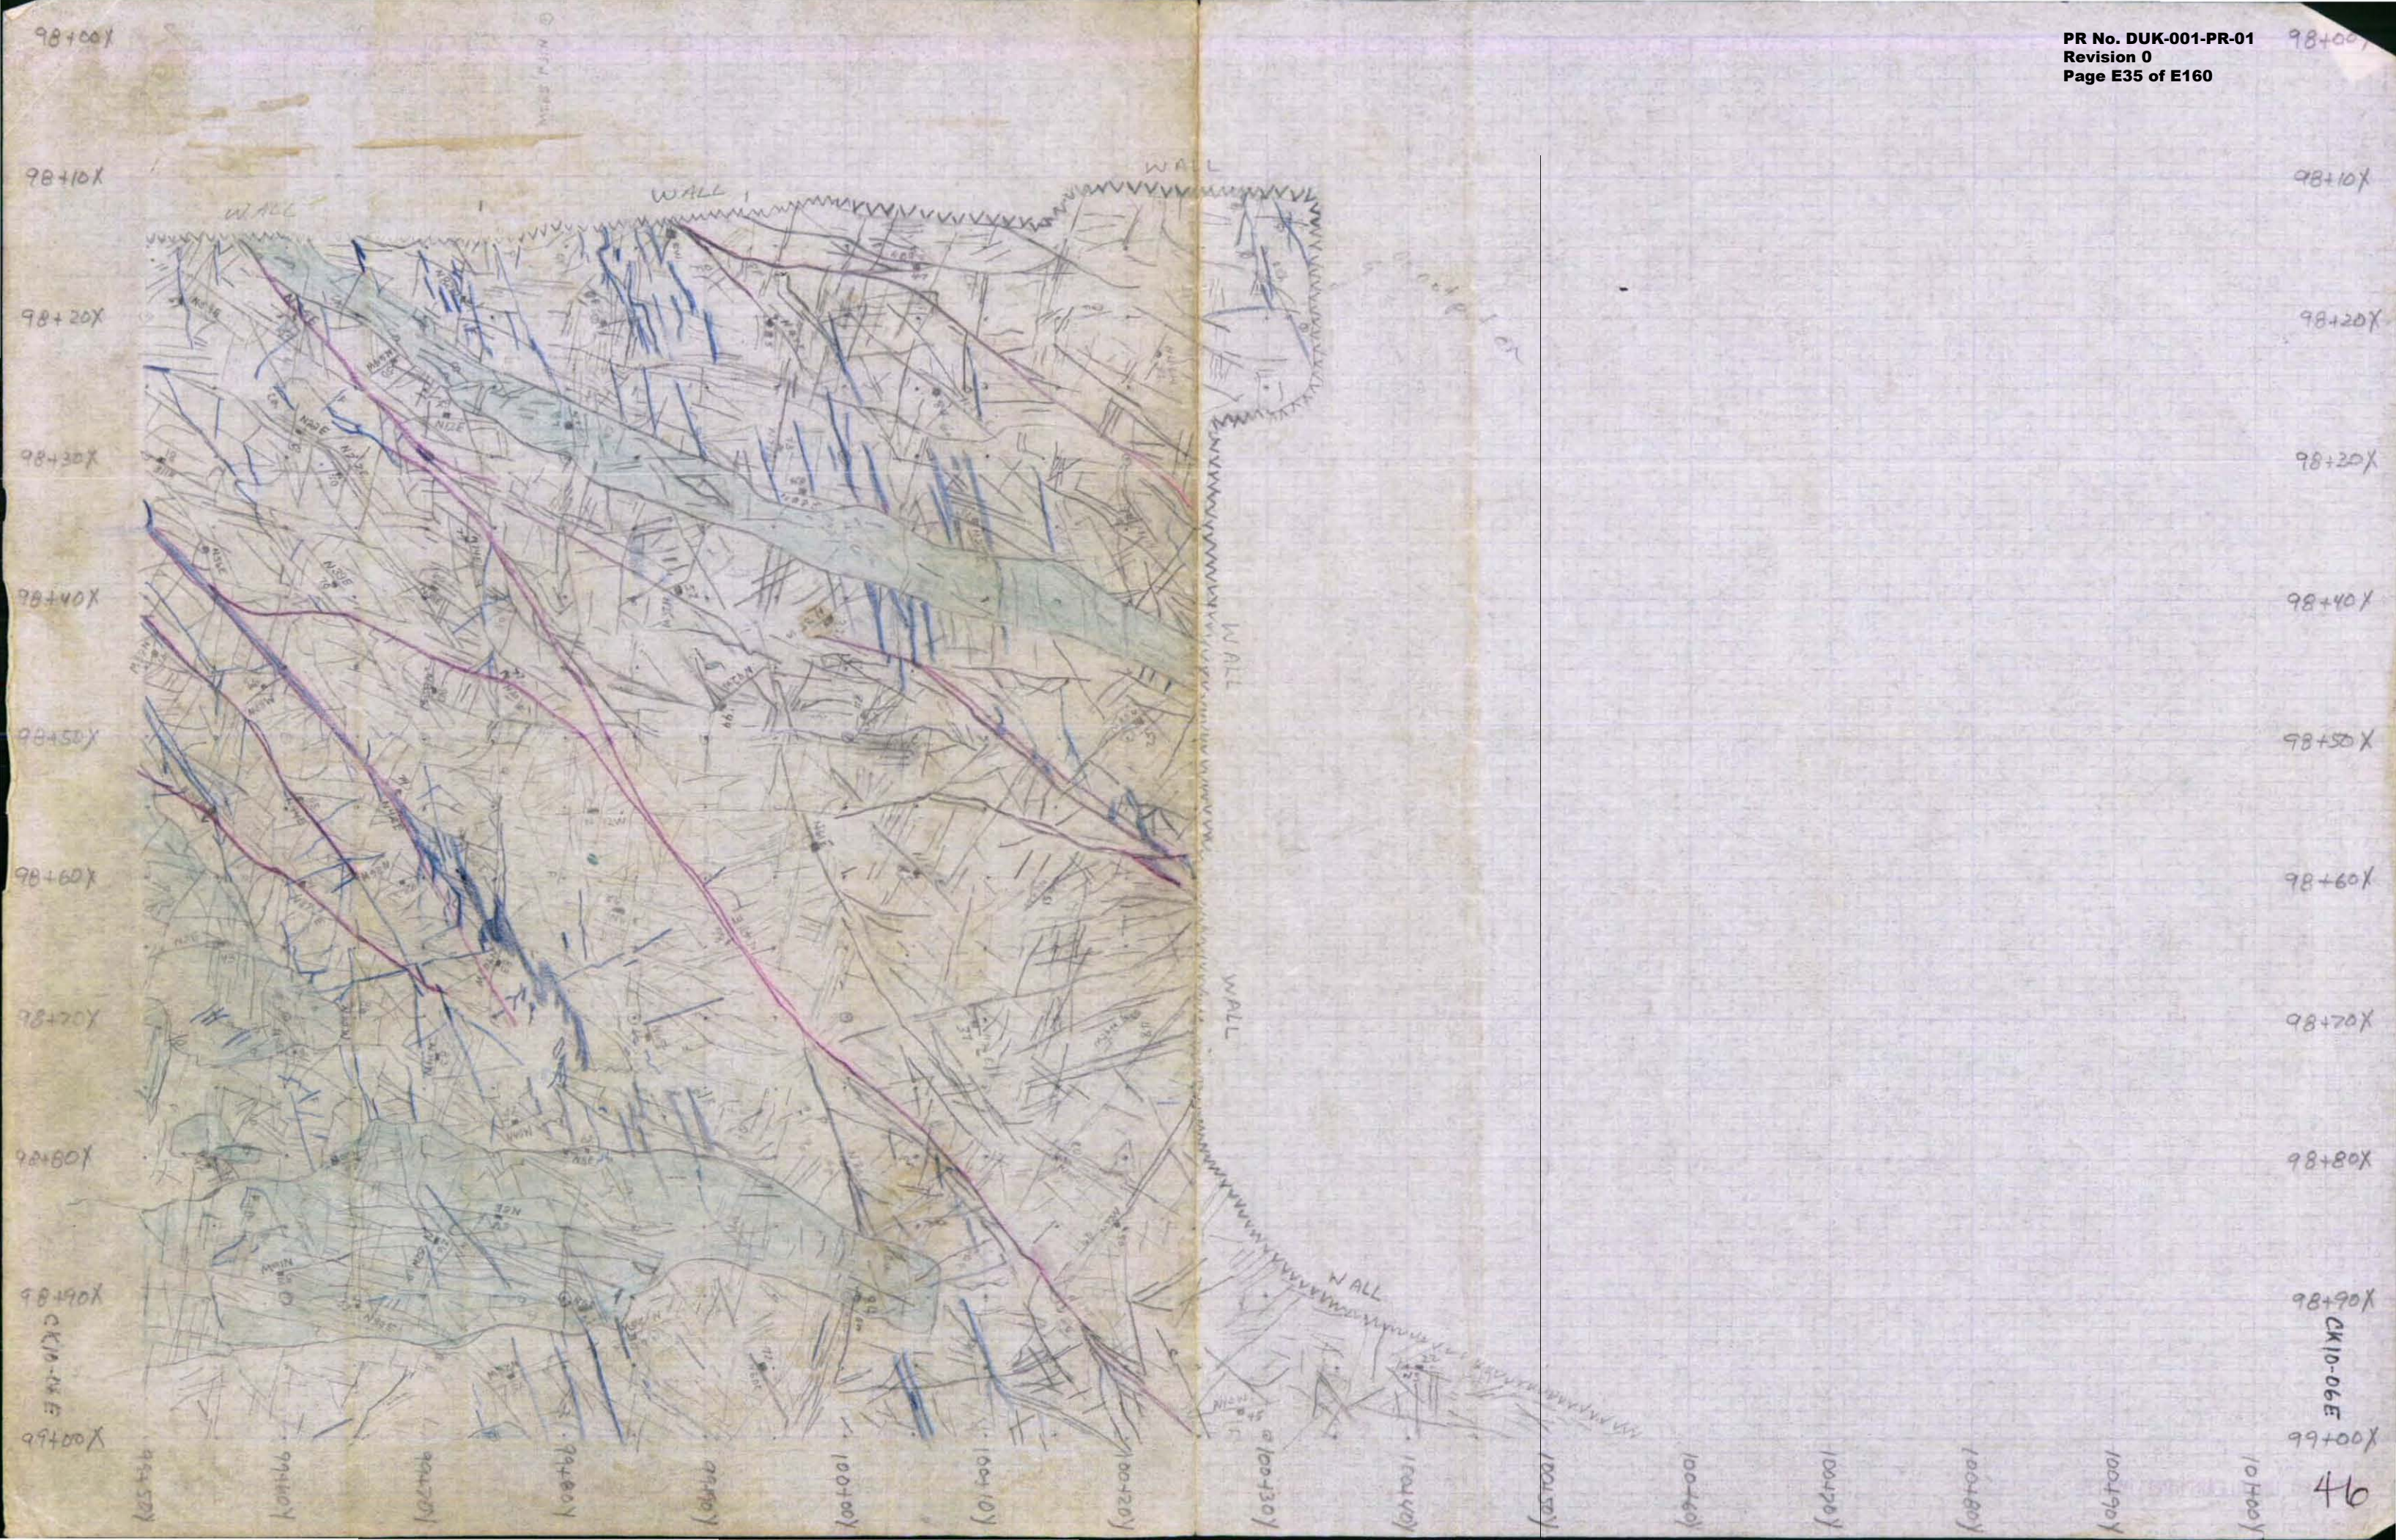

98100X

98100X

98100X

98100X

98200X

98200X

98300X

98300X

98400X

98400X

98500X

98500X

98600X

98600X

98700X

98700X

98800X


98800X

98900X

98900X

99000X


99000X

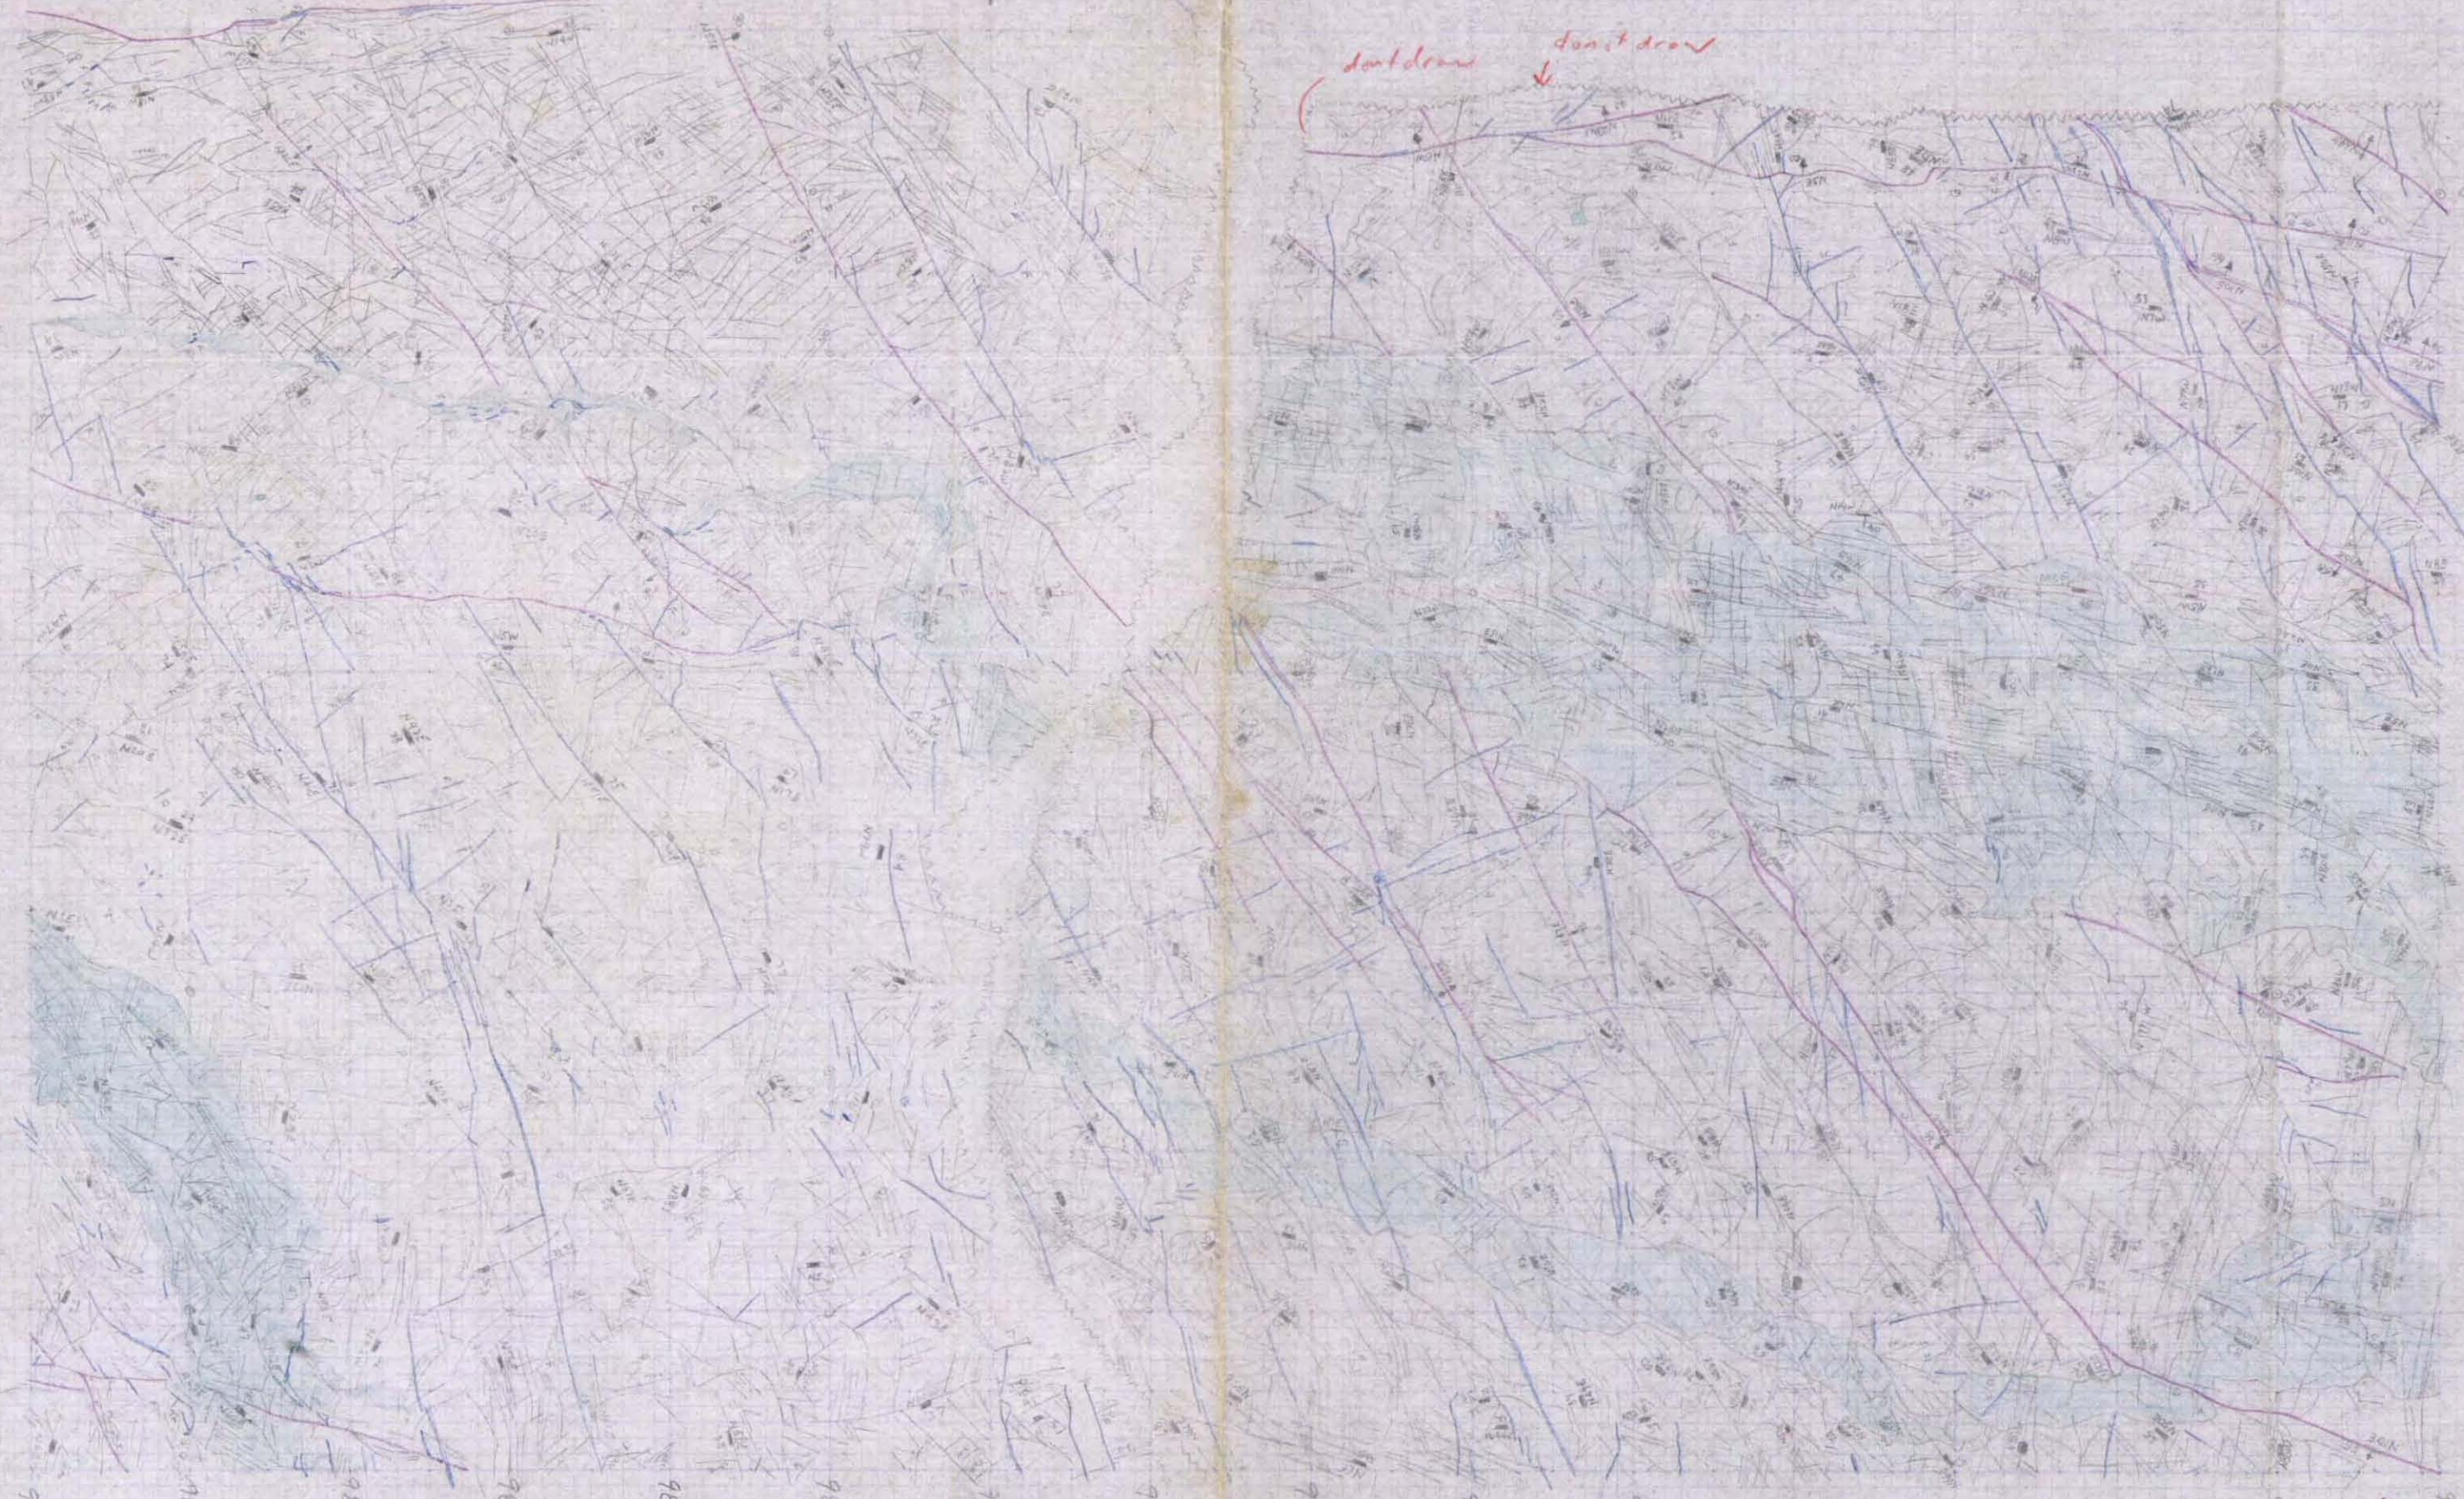

don't draw
↓
don't draw


OKID-06H

OKID-06H

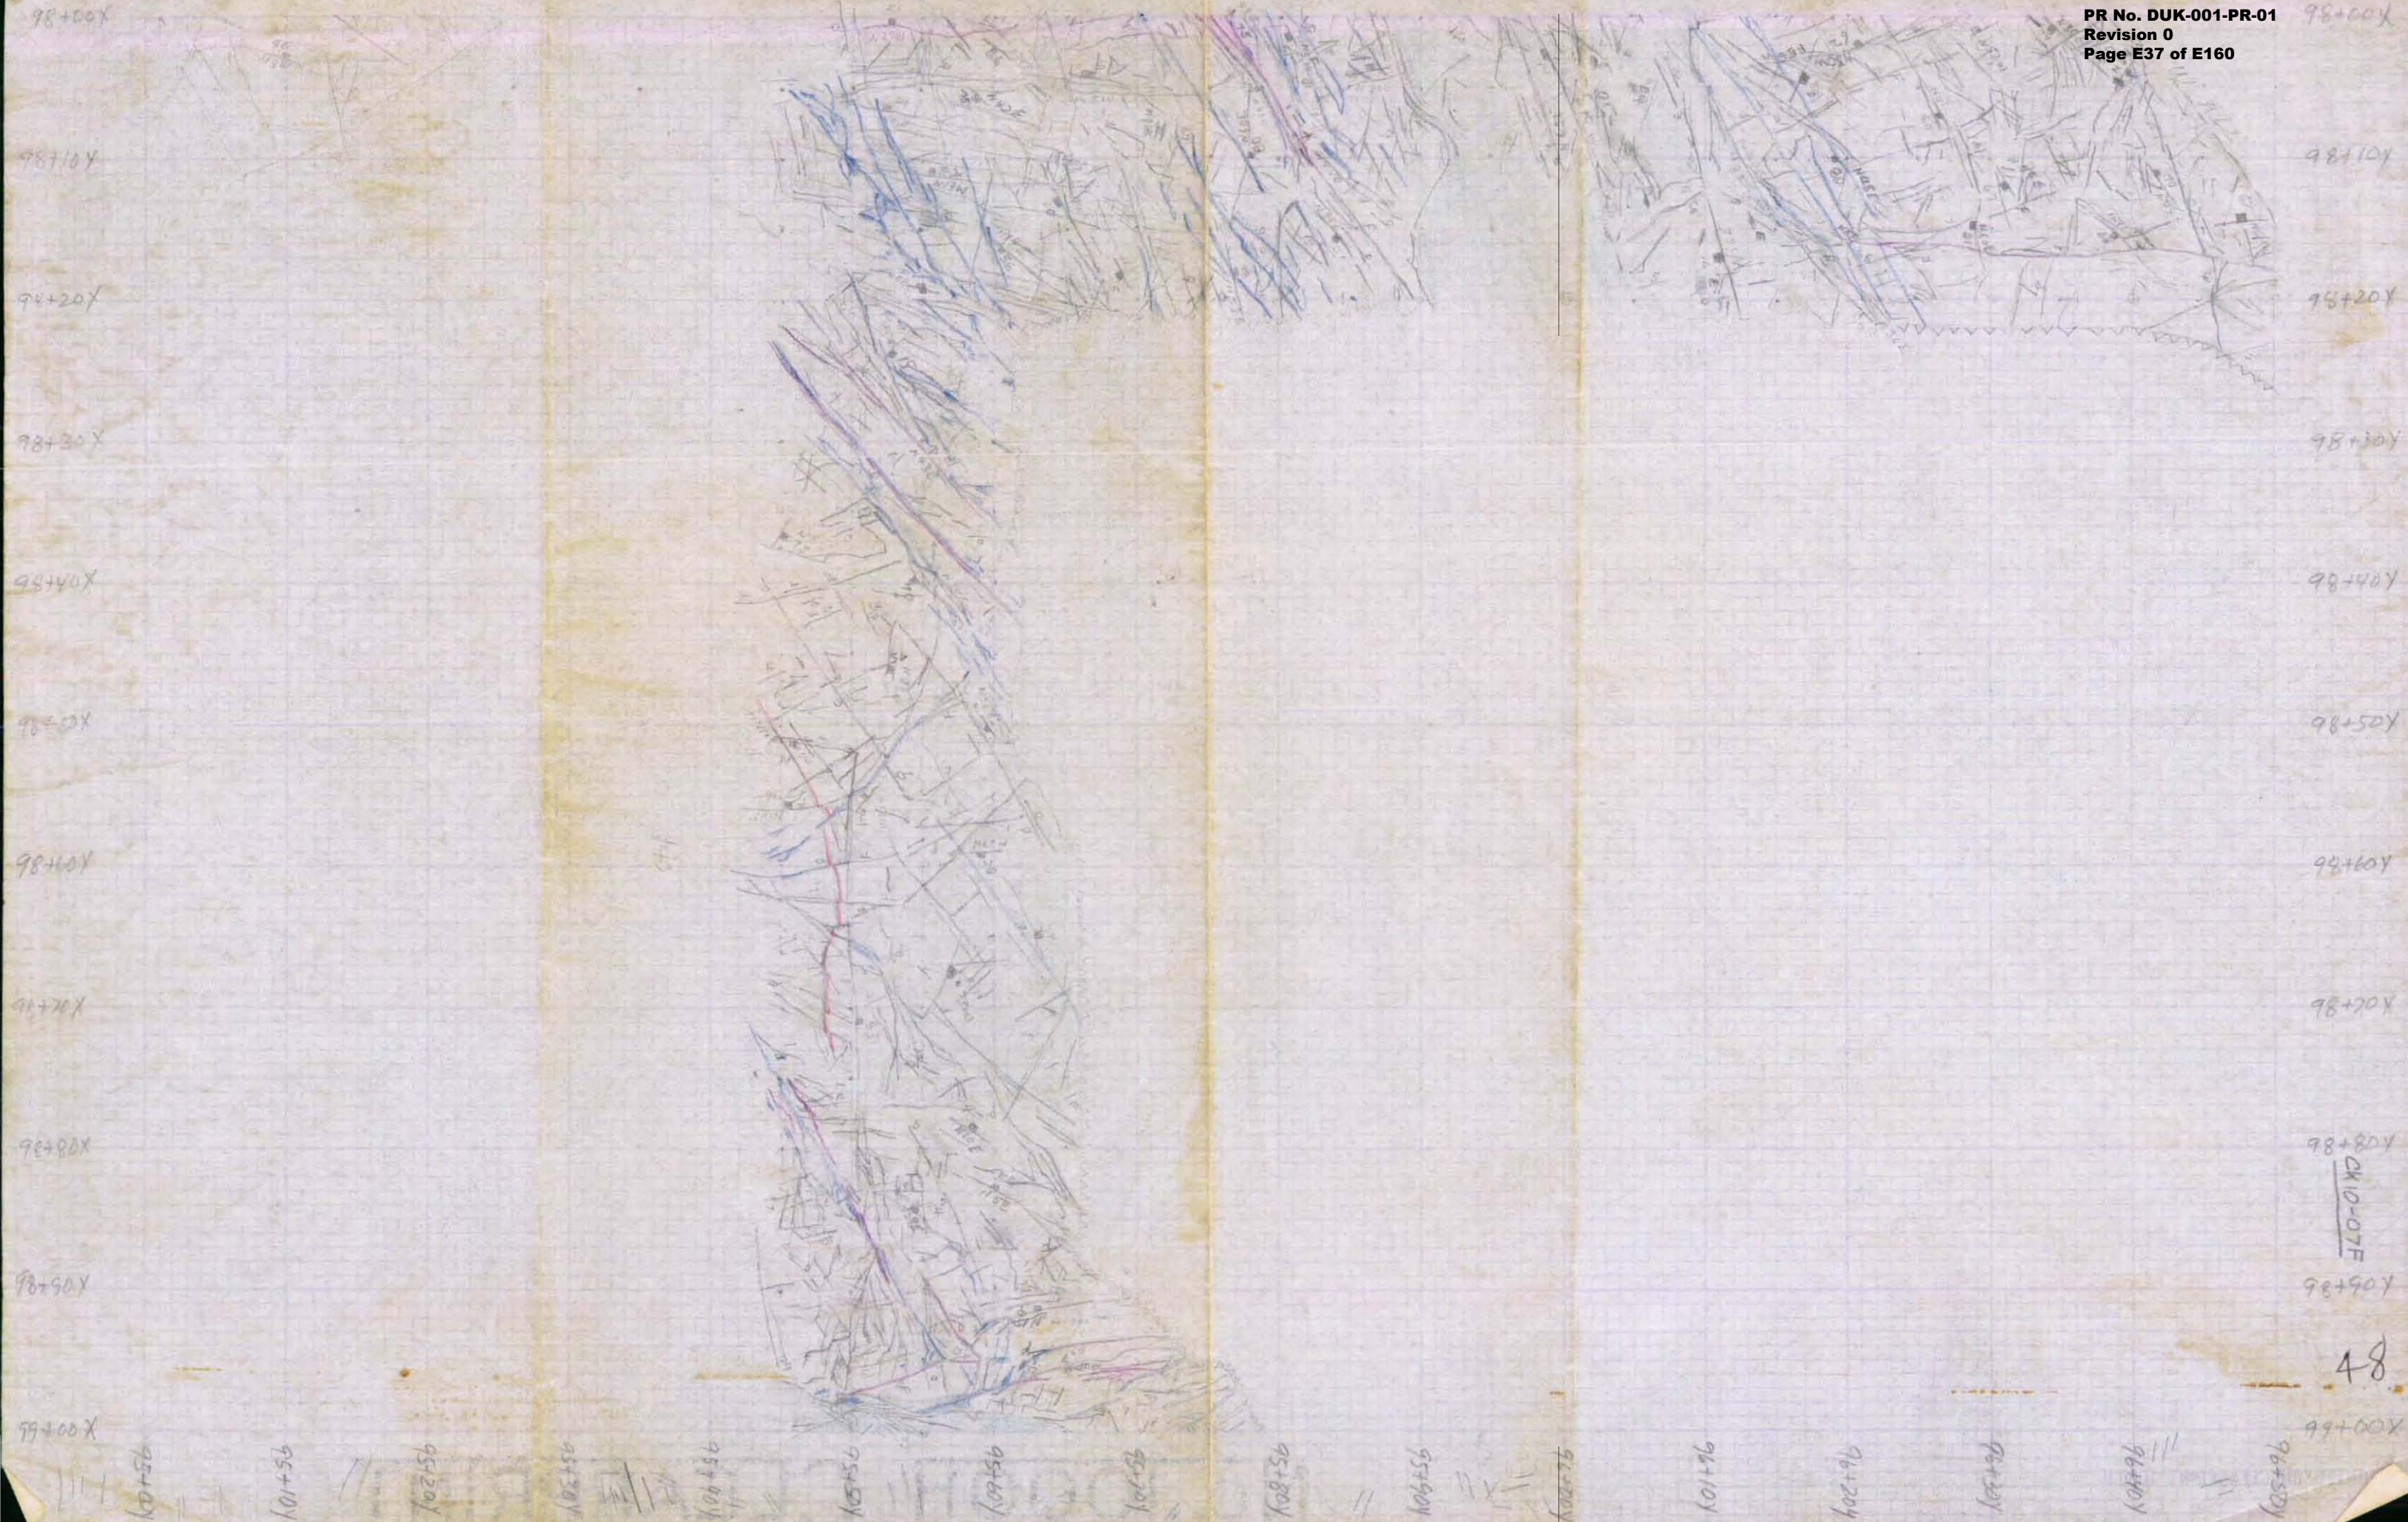

98+00Y
98+10Y
98+20Y
98+30Y
98+40Y
98+50Y
98+60Y
98+70Y
98+80Y
98+90Y
99+00Y
48
98+00Y
98+10Y
98+20Y
98+30Y
98+40Y
98+50Y
98+60Y
98+70Y
98+80Y
98+90Y
99+00Y

98+00X
98+10X
98+20X
98+30X
98+40X
98+50X
98+60X
98+70X
98+80X
98+90X
99+00X
95+01
95+10
95+20
95+30
95+40
95+50
95+60
95+70
95+80
95+90
96+00
96+10
96+20
96+30
96+40
96+50

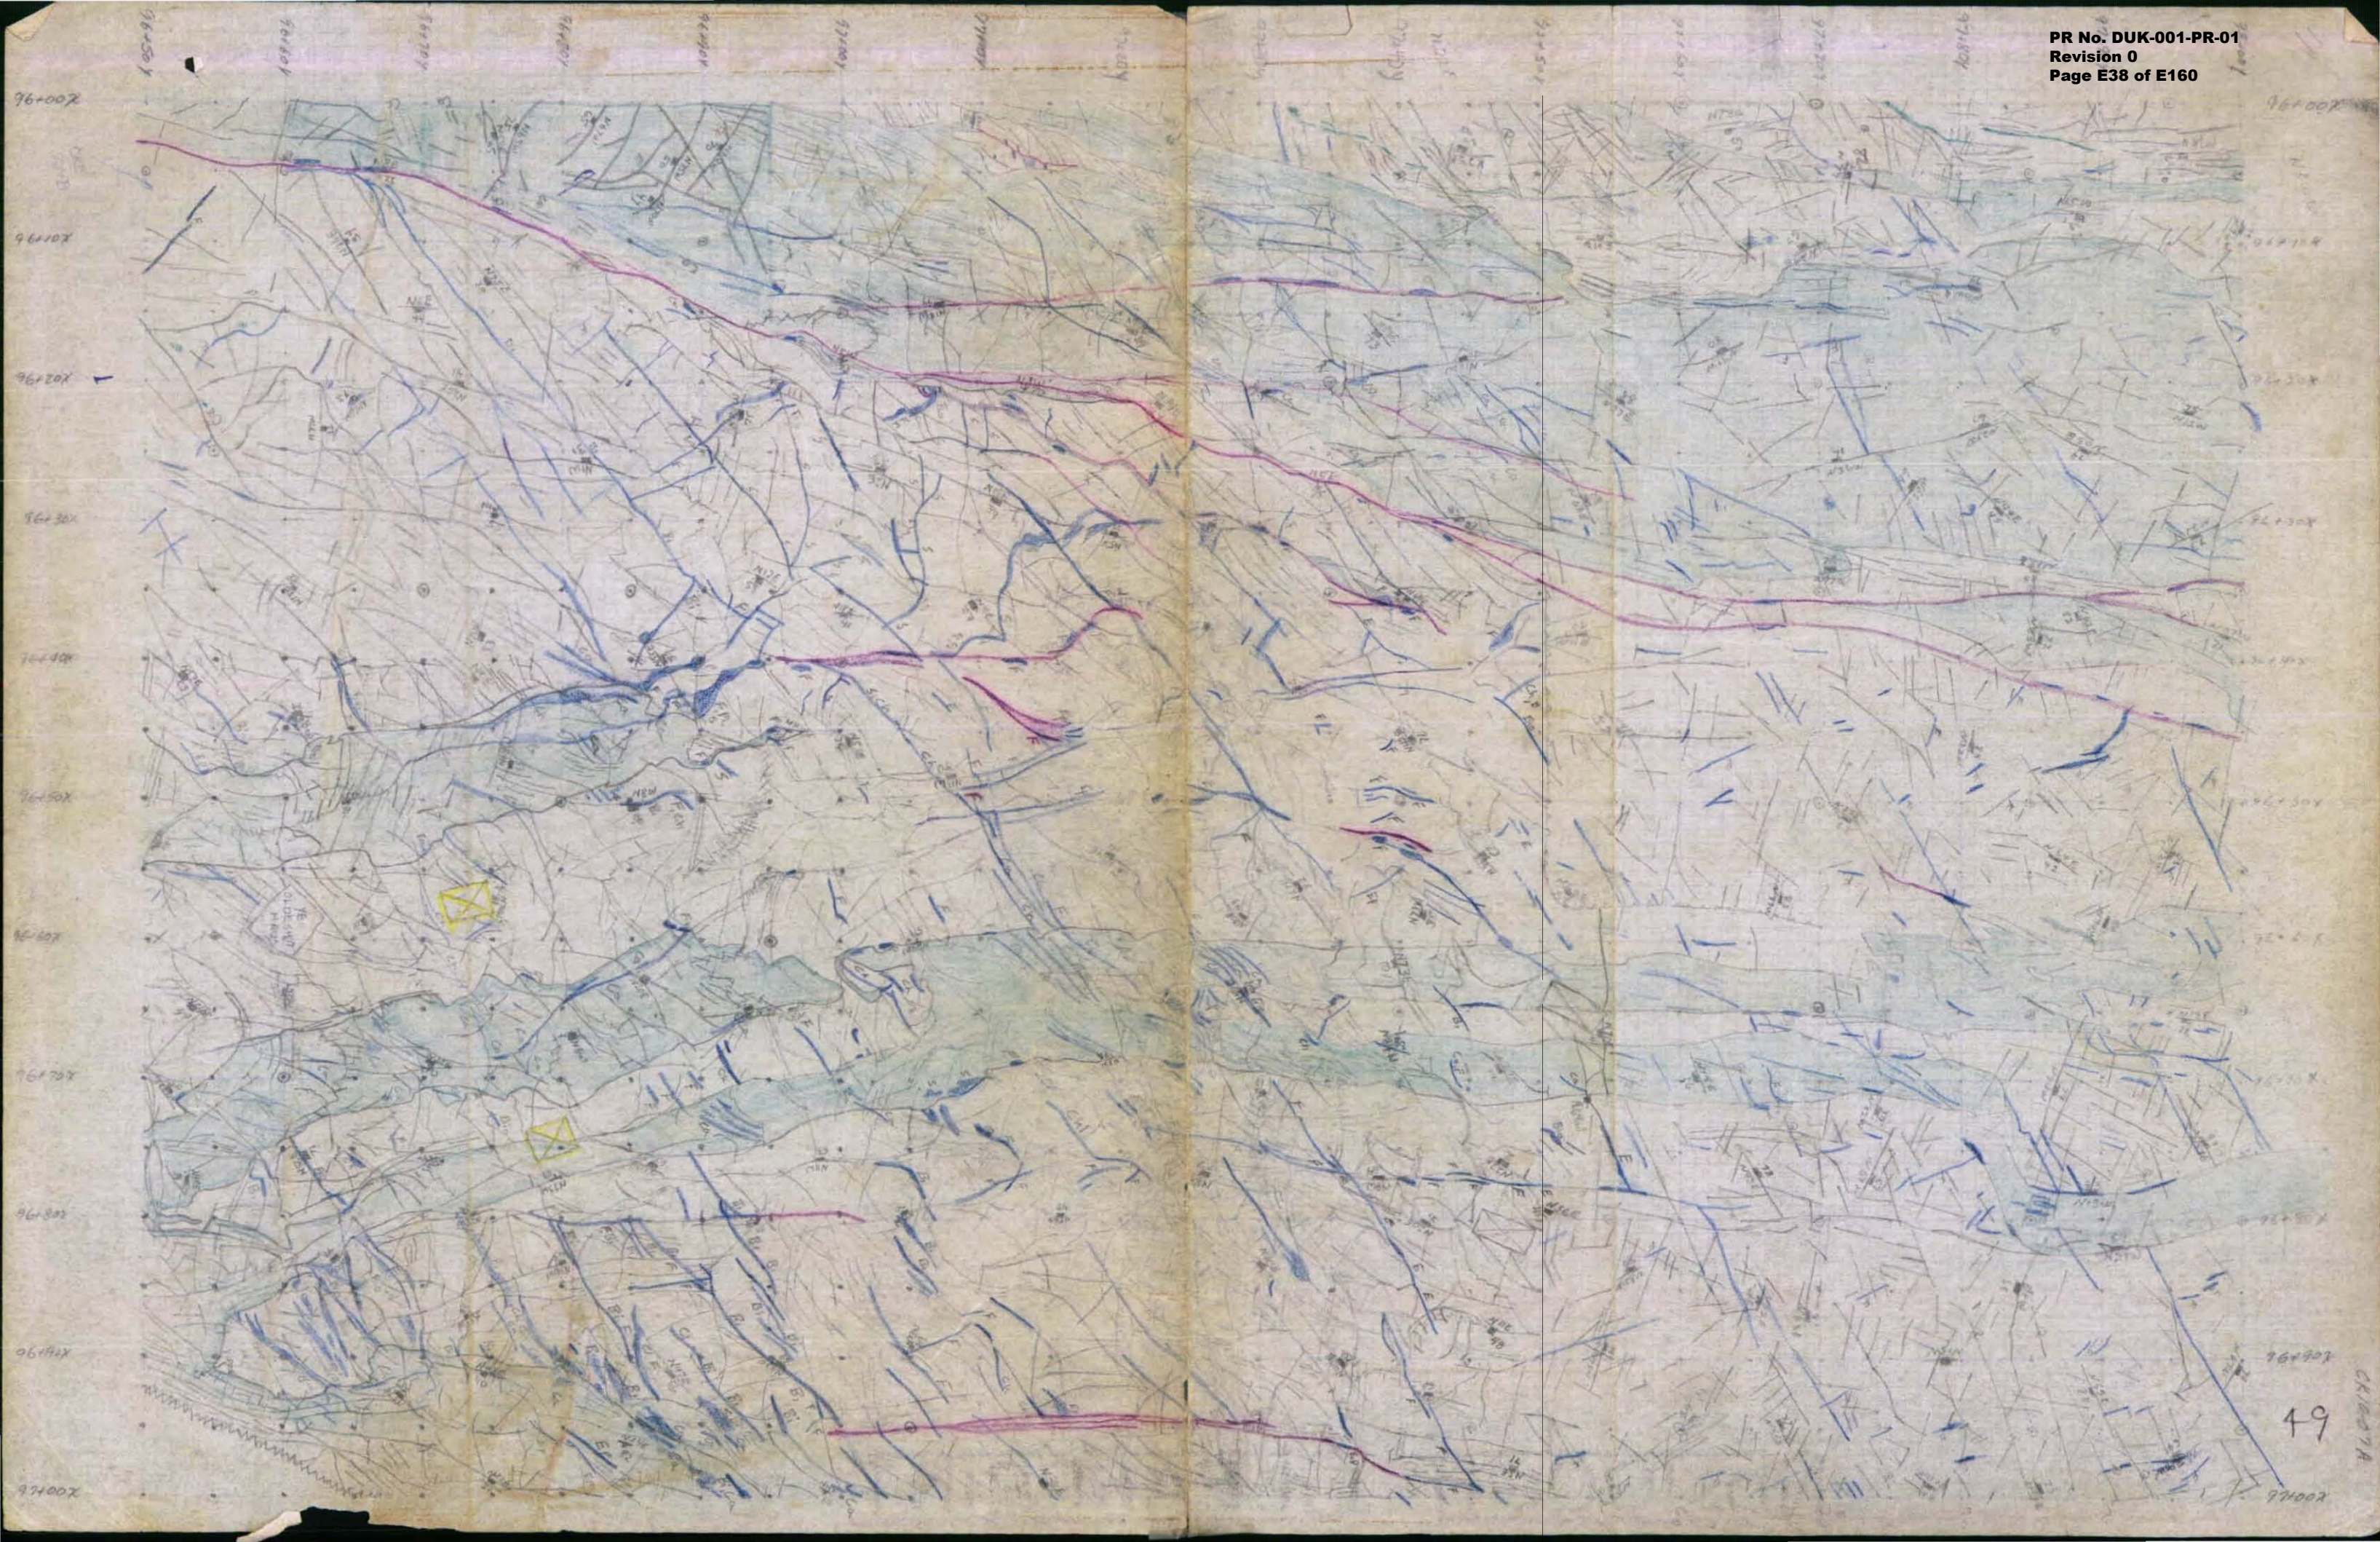




DKM-01B

50

98100X

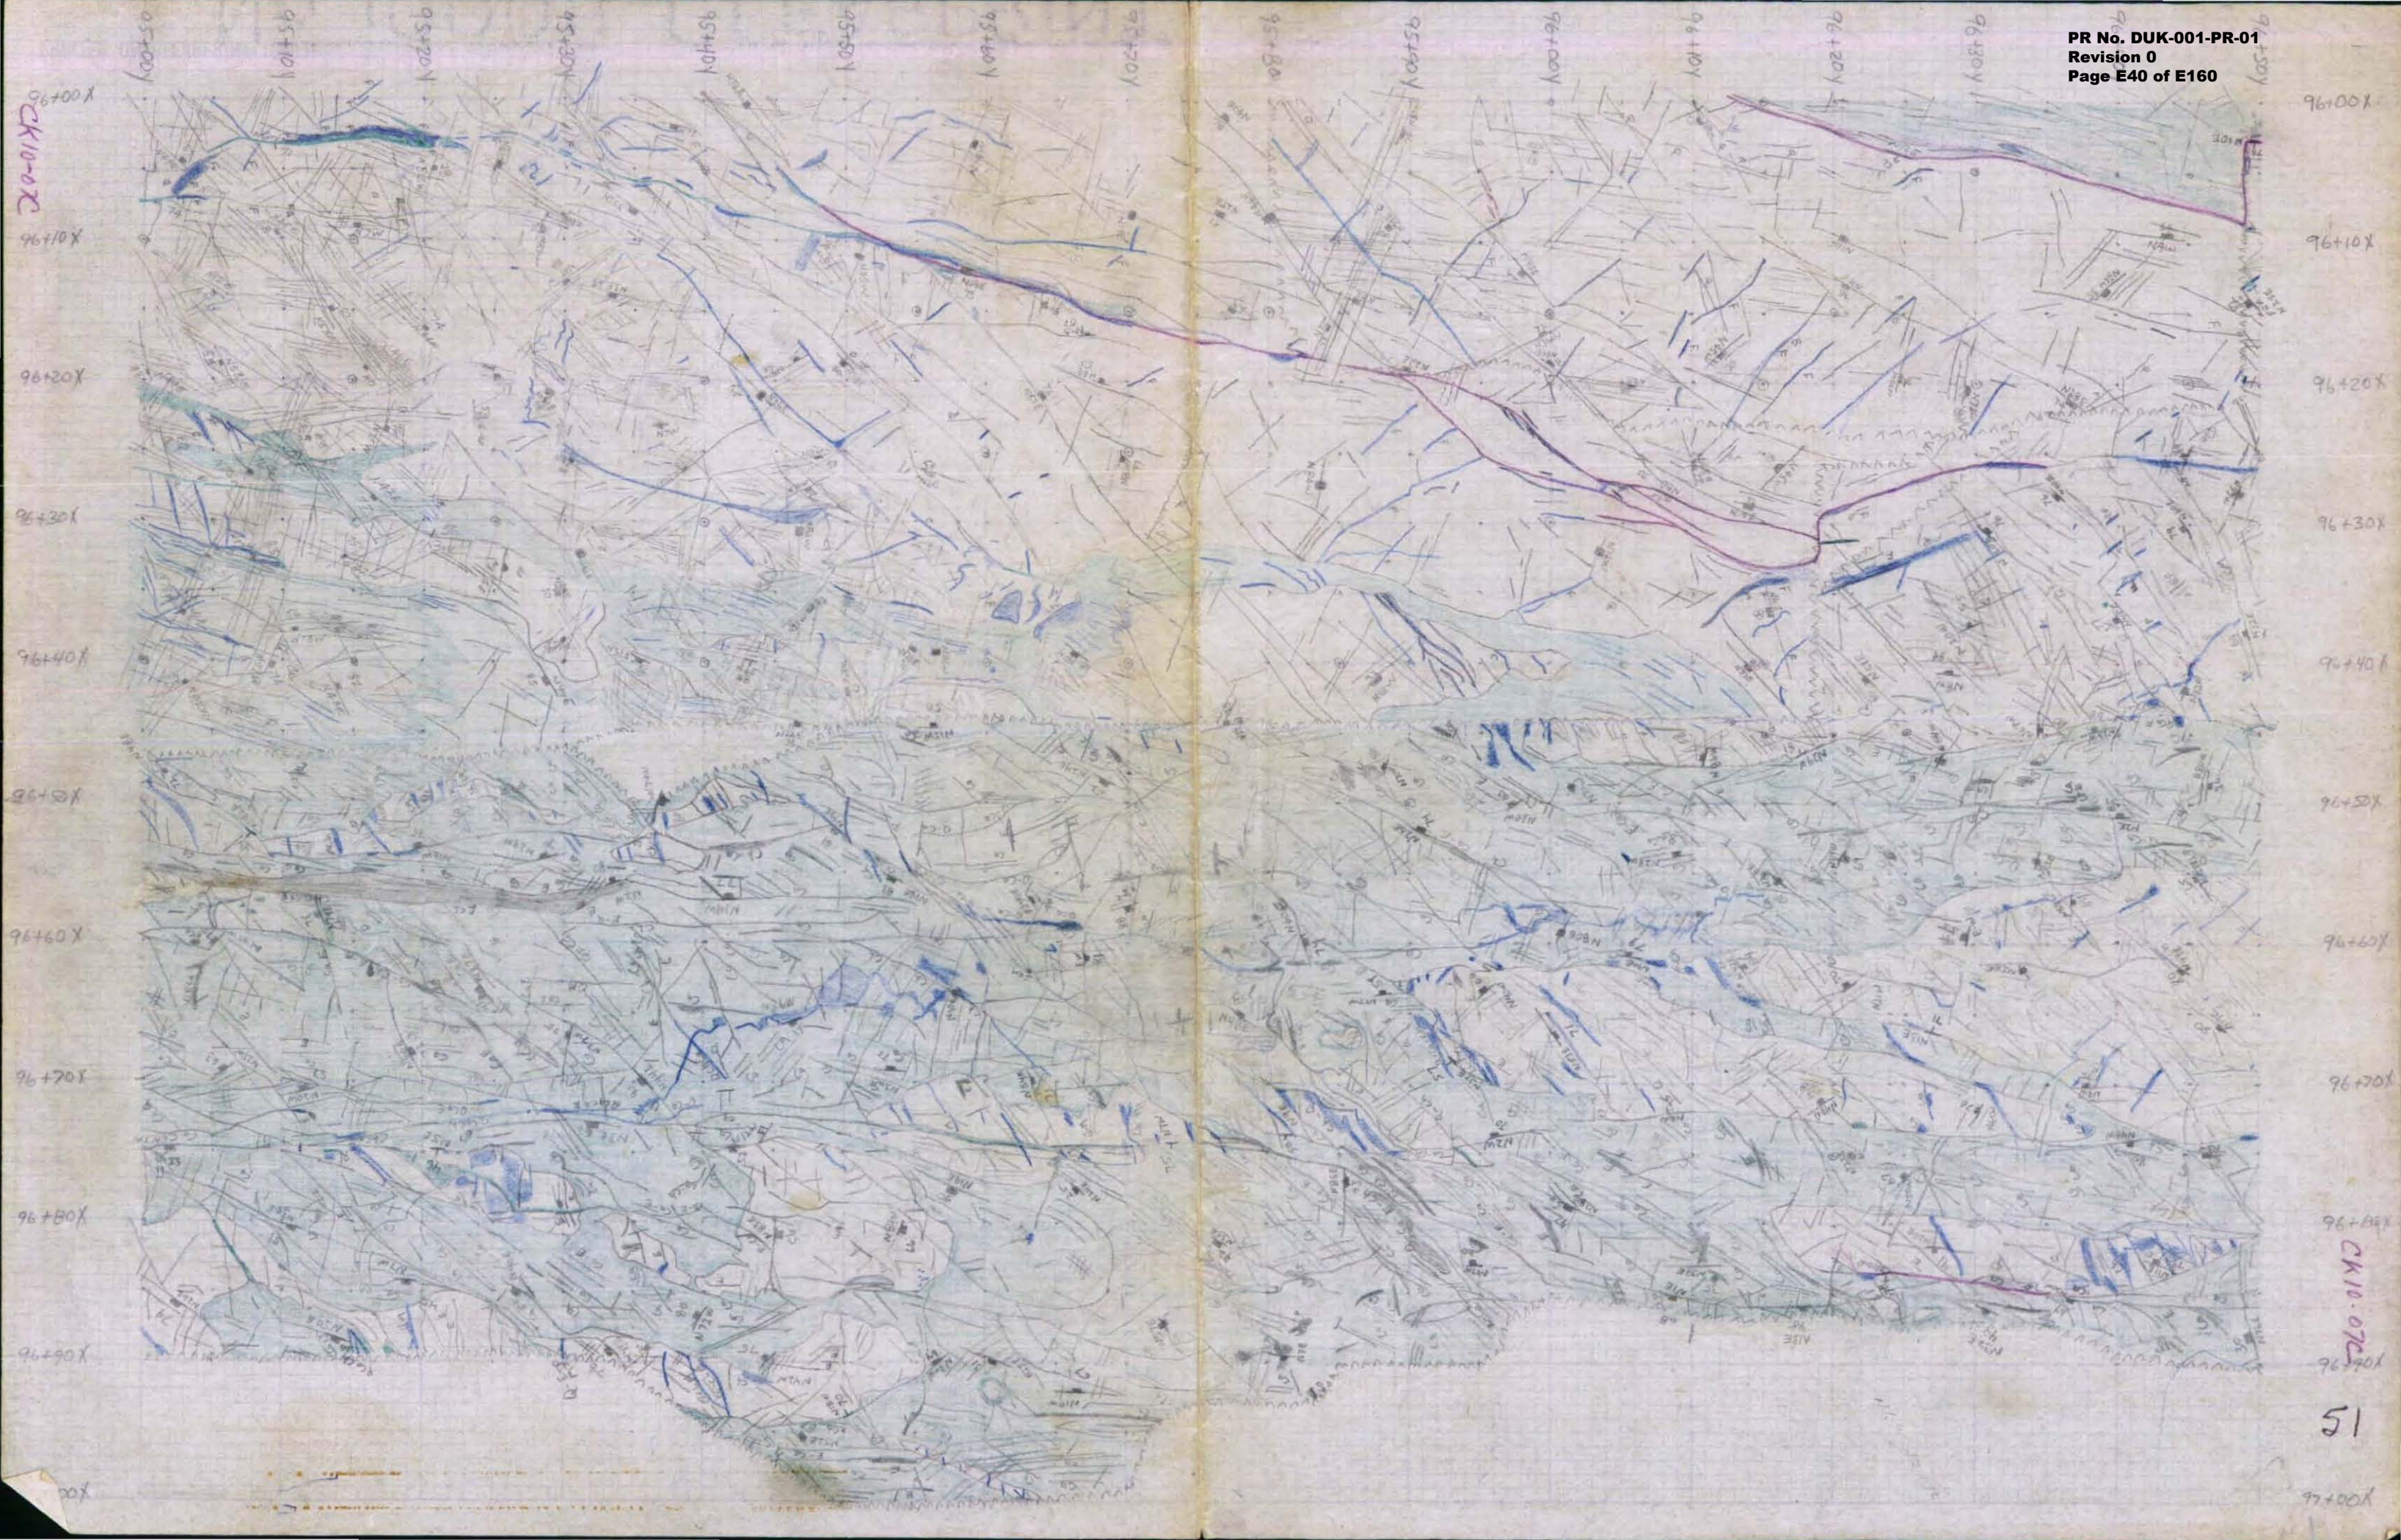

96+00X
96+10X
96+20X
96+30X
96+40X
96+50X
96+60X
96+70X
96+80X
96+90X

96+00X
96+10X
96+20X
96+30X
96+40X
96+50X
96+60X
96+70X
96+80X
96+90X

CK10-07C
51

97+00X

97+00X

97+10X

97+10X

97+20X

97+20X

97+30X

97+30X

97+40X

97+40X

97+50X

97+50X

97+60X

97+60X

97+70X

97+70X

97+80X


97+80X

97+90X

97+90X


98+00X


98+00X

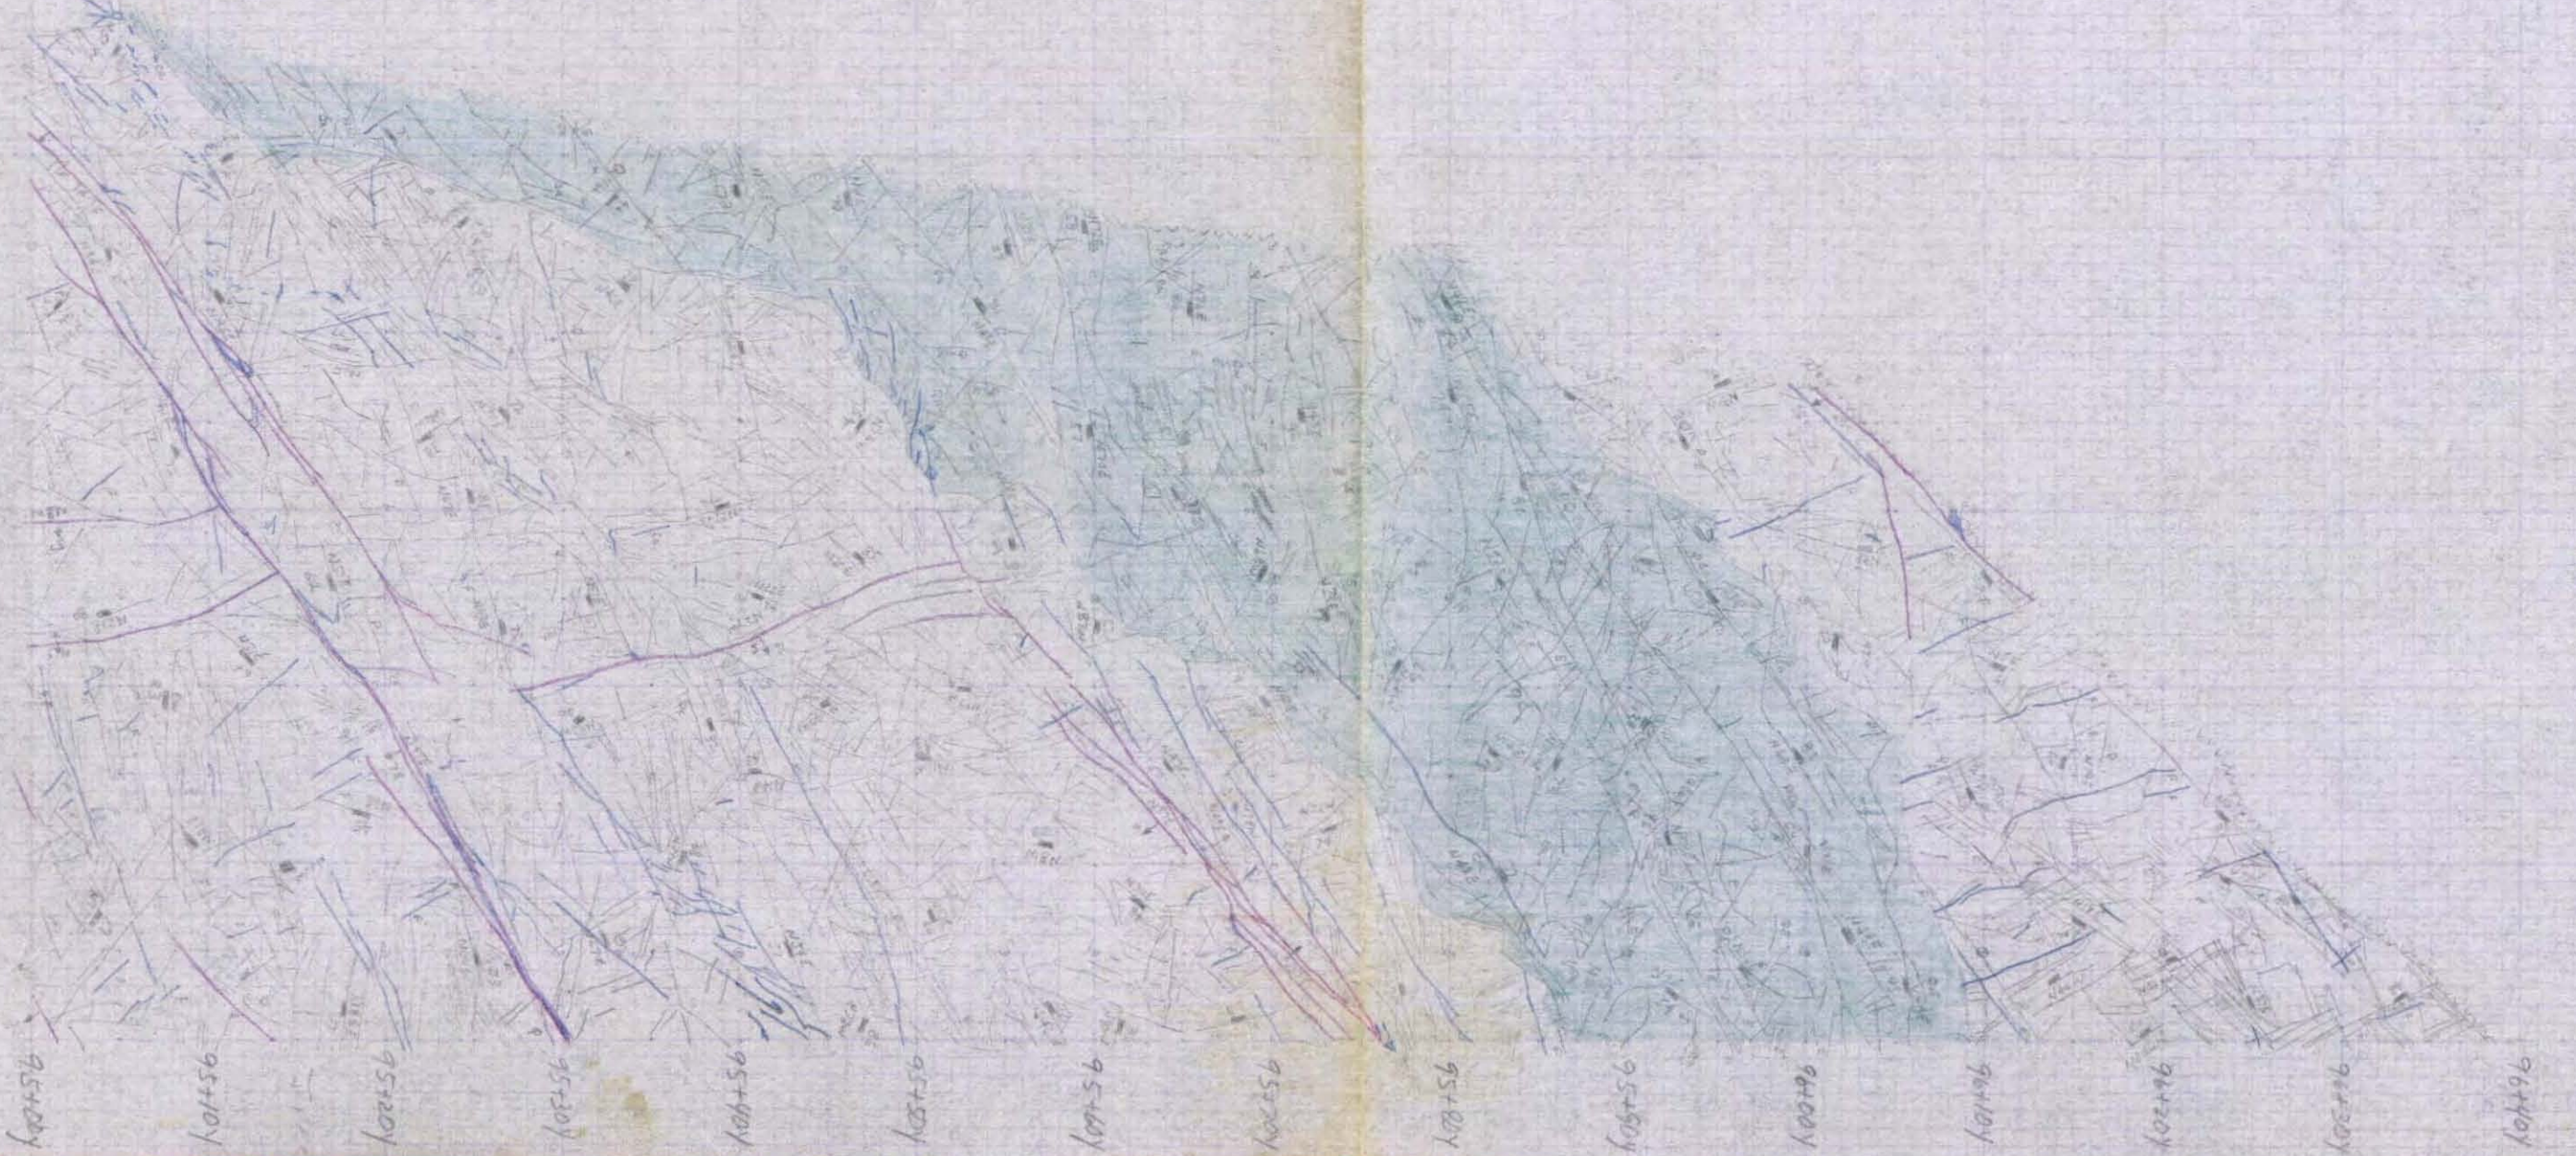

CR10-07D

52

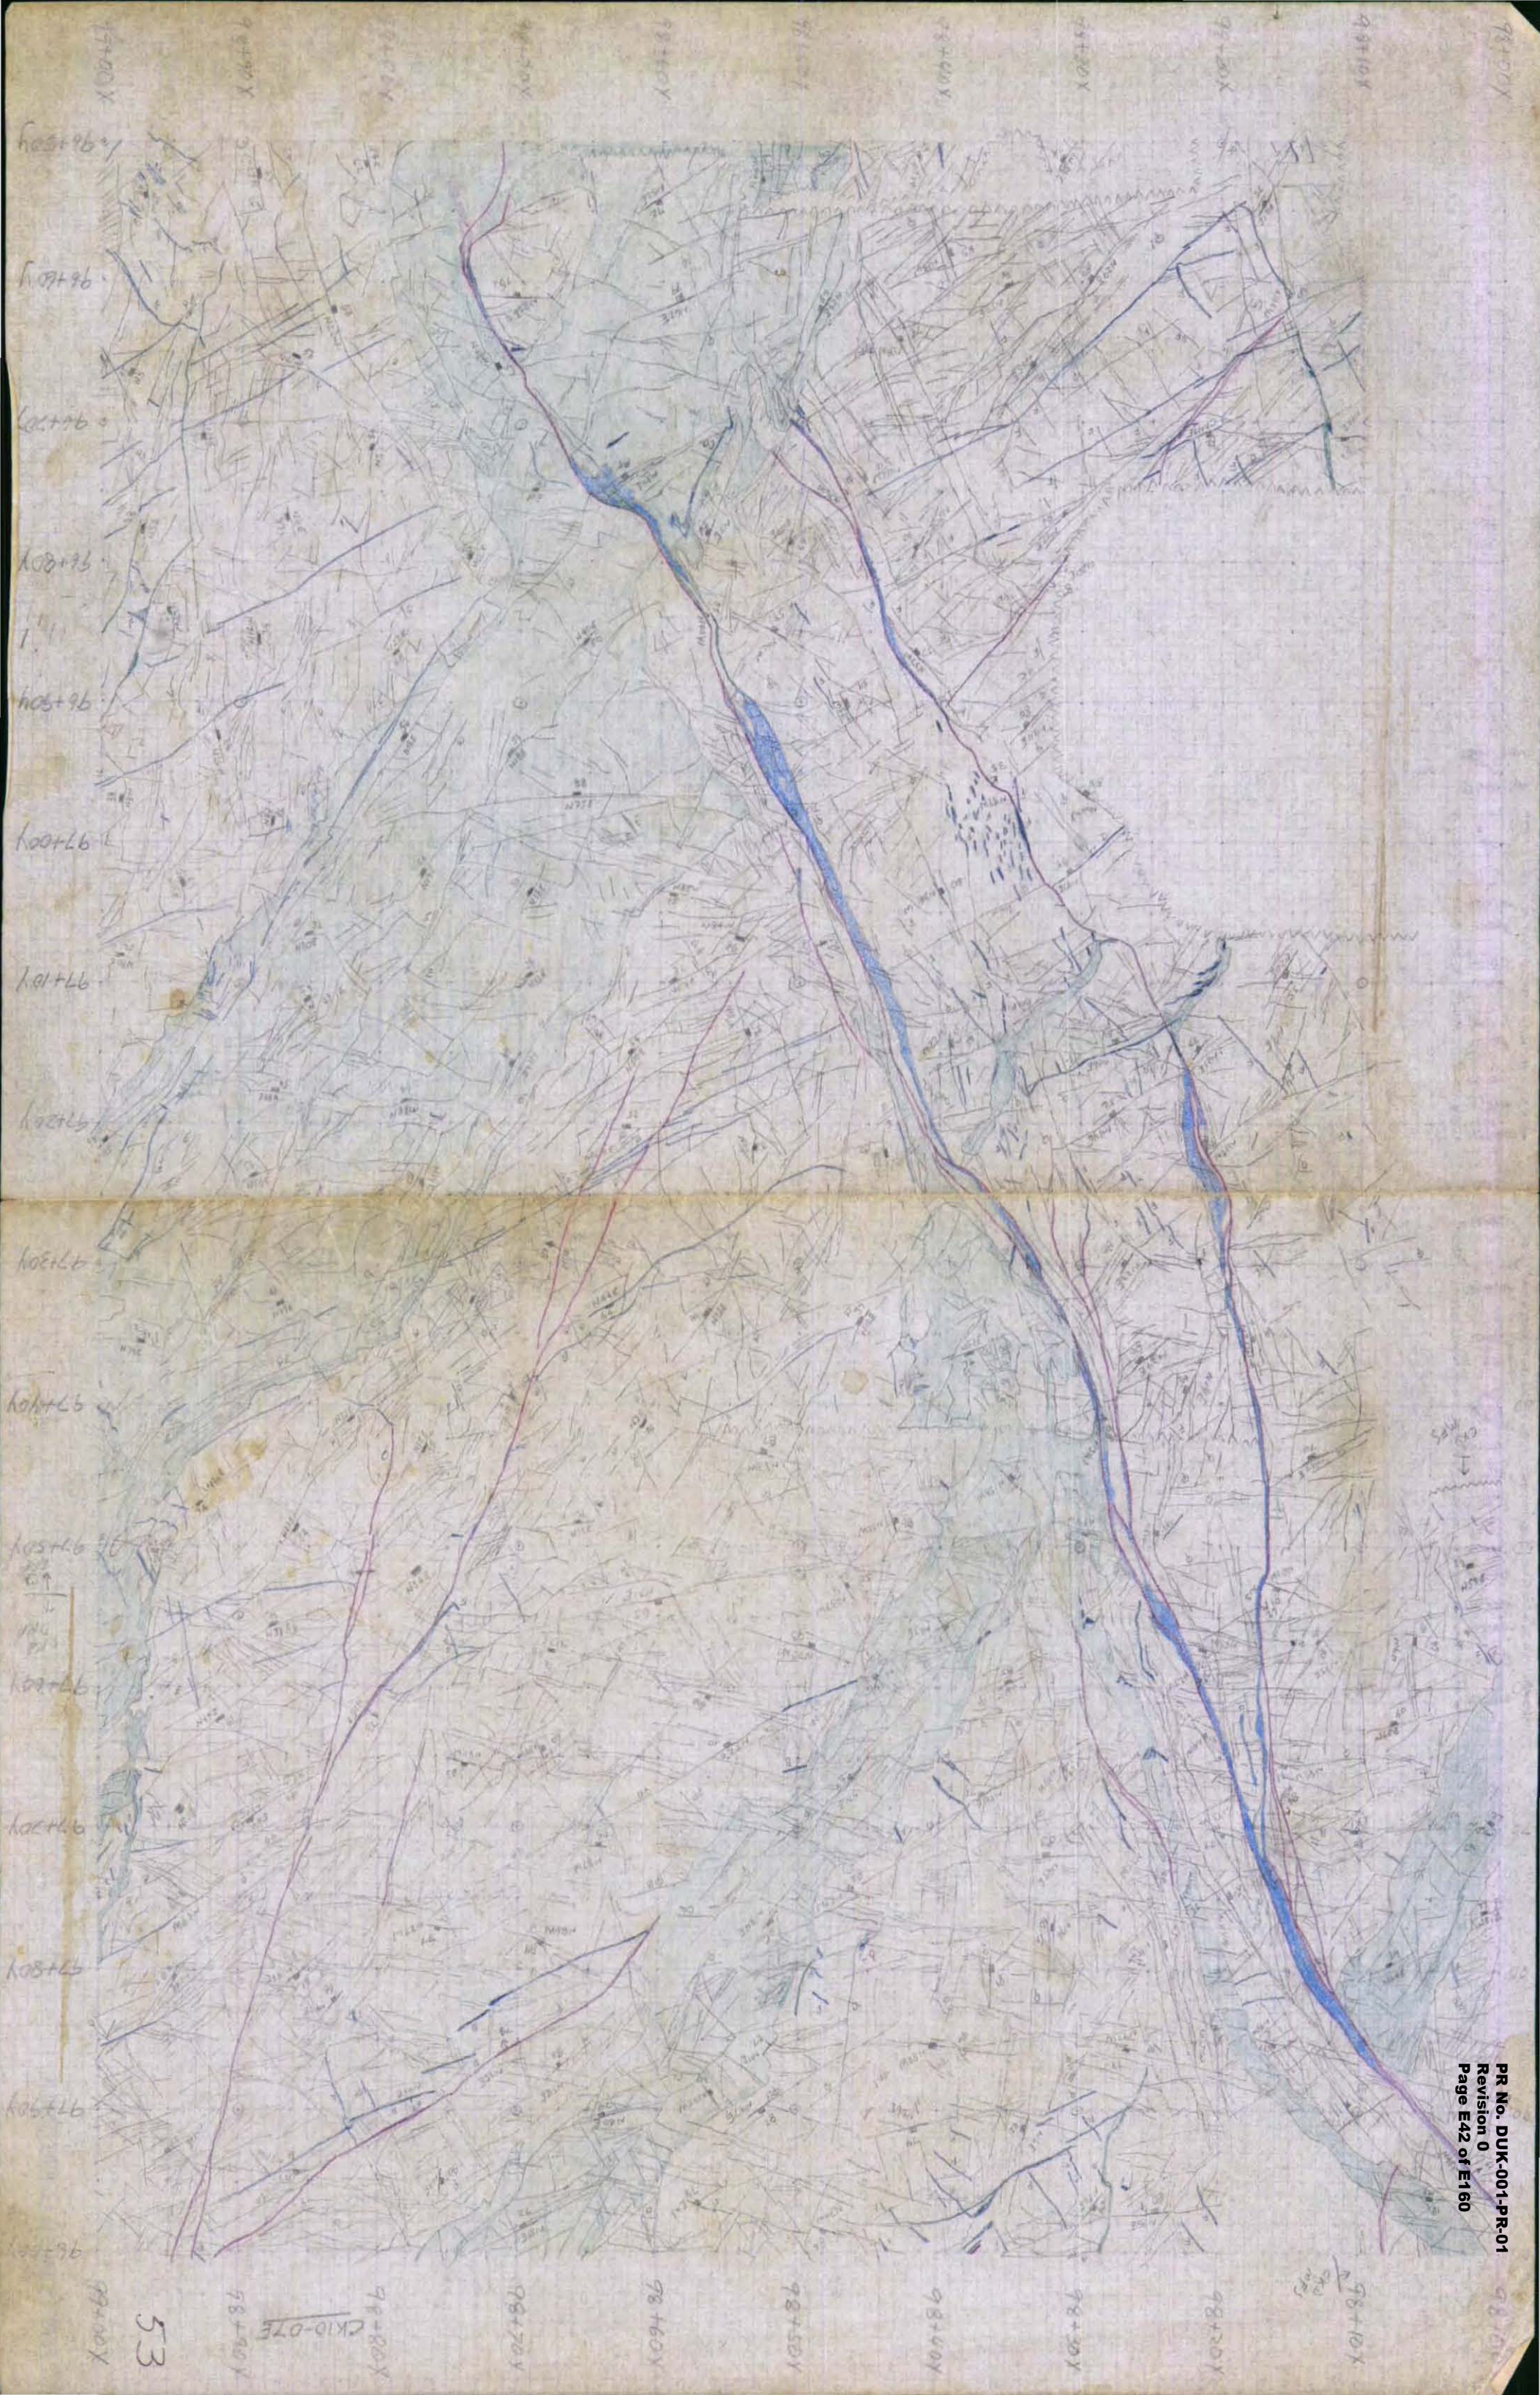

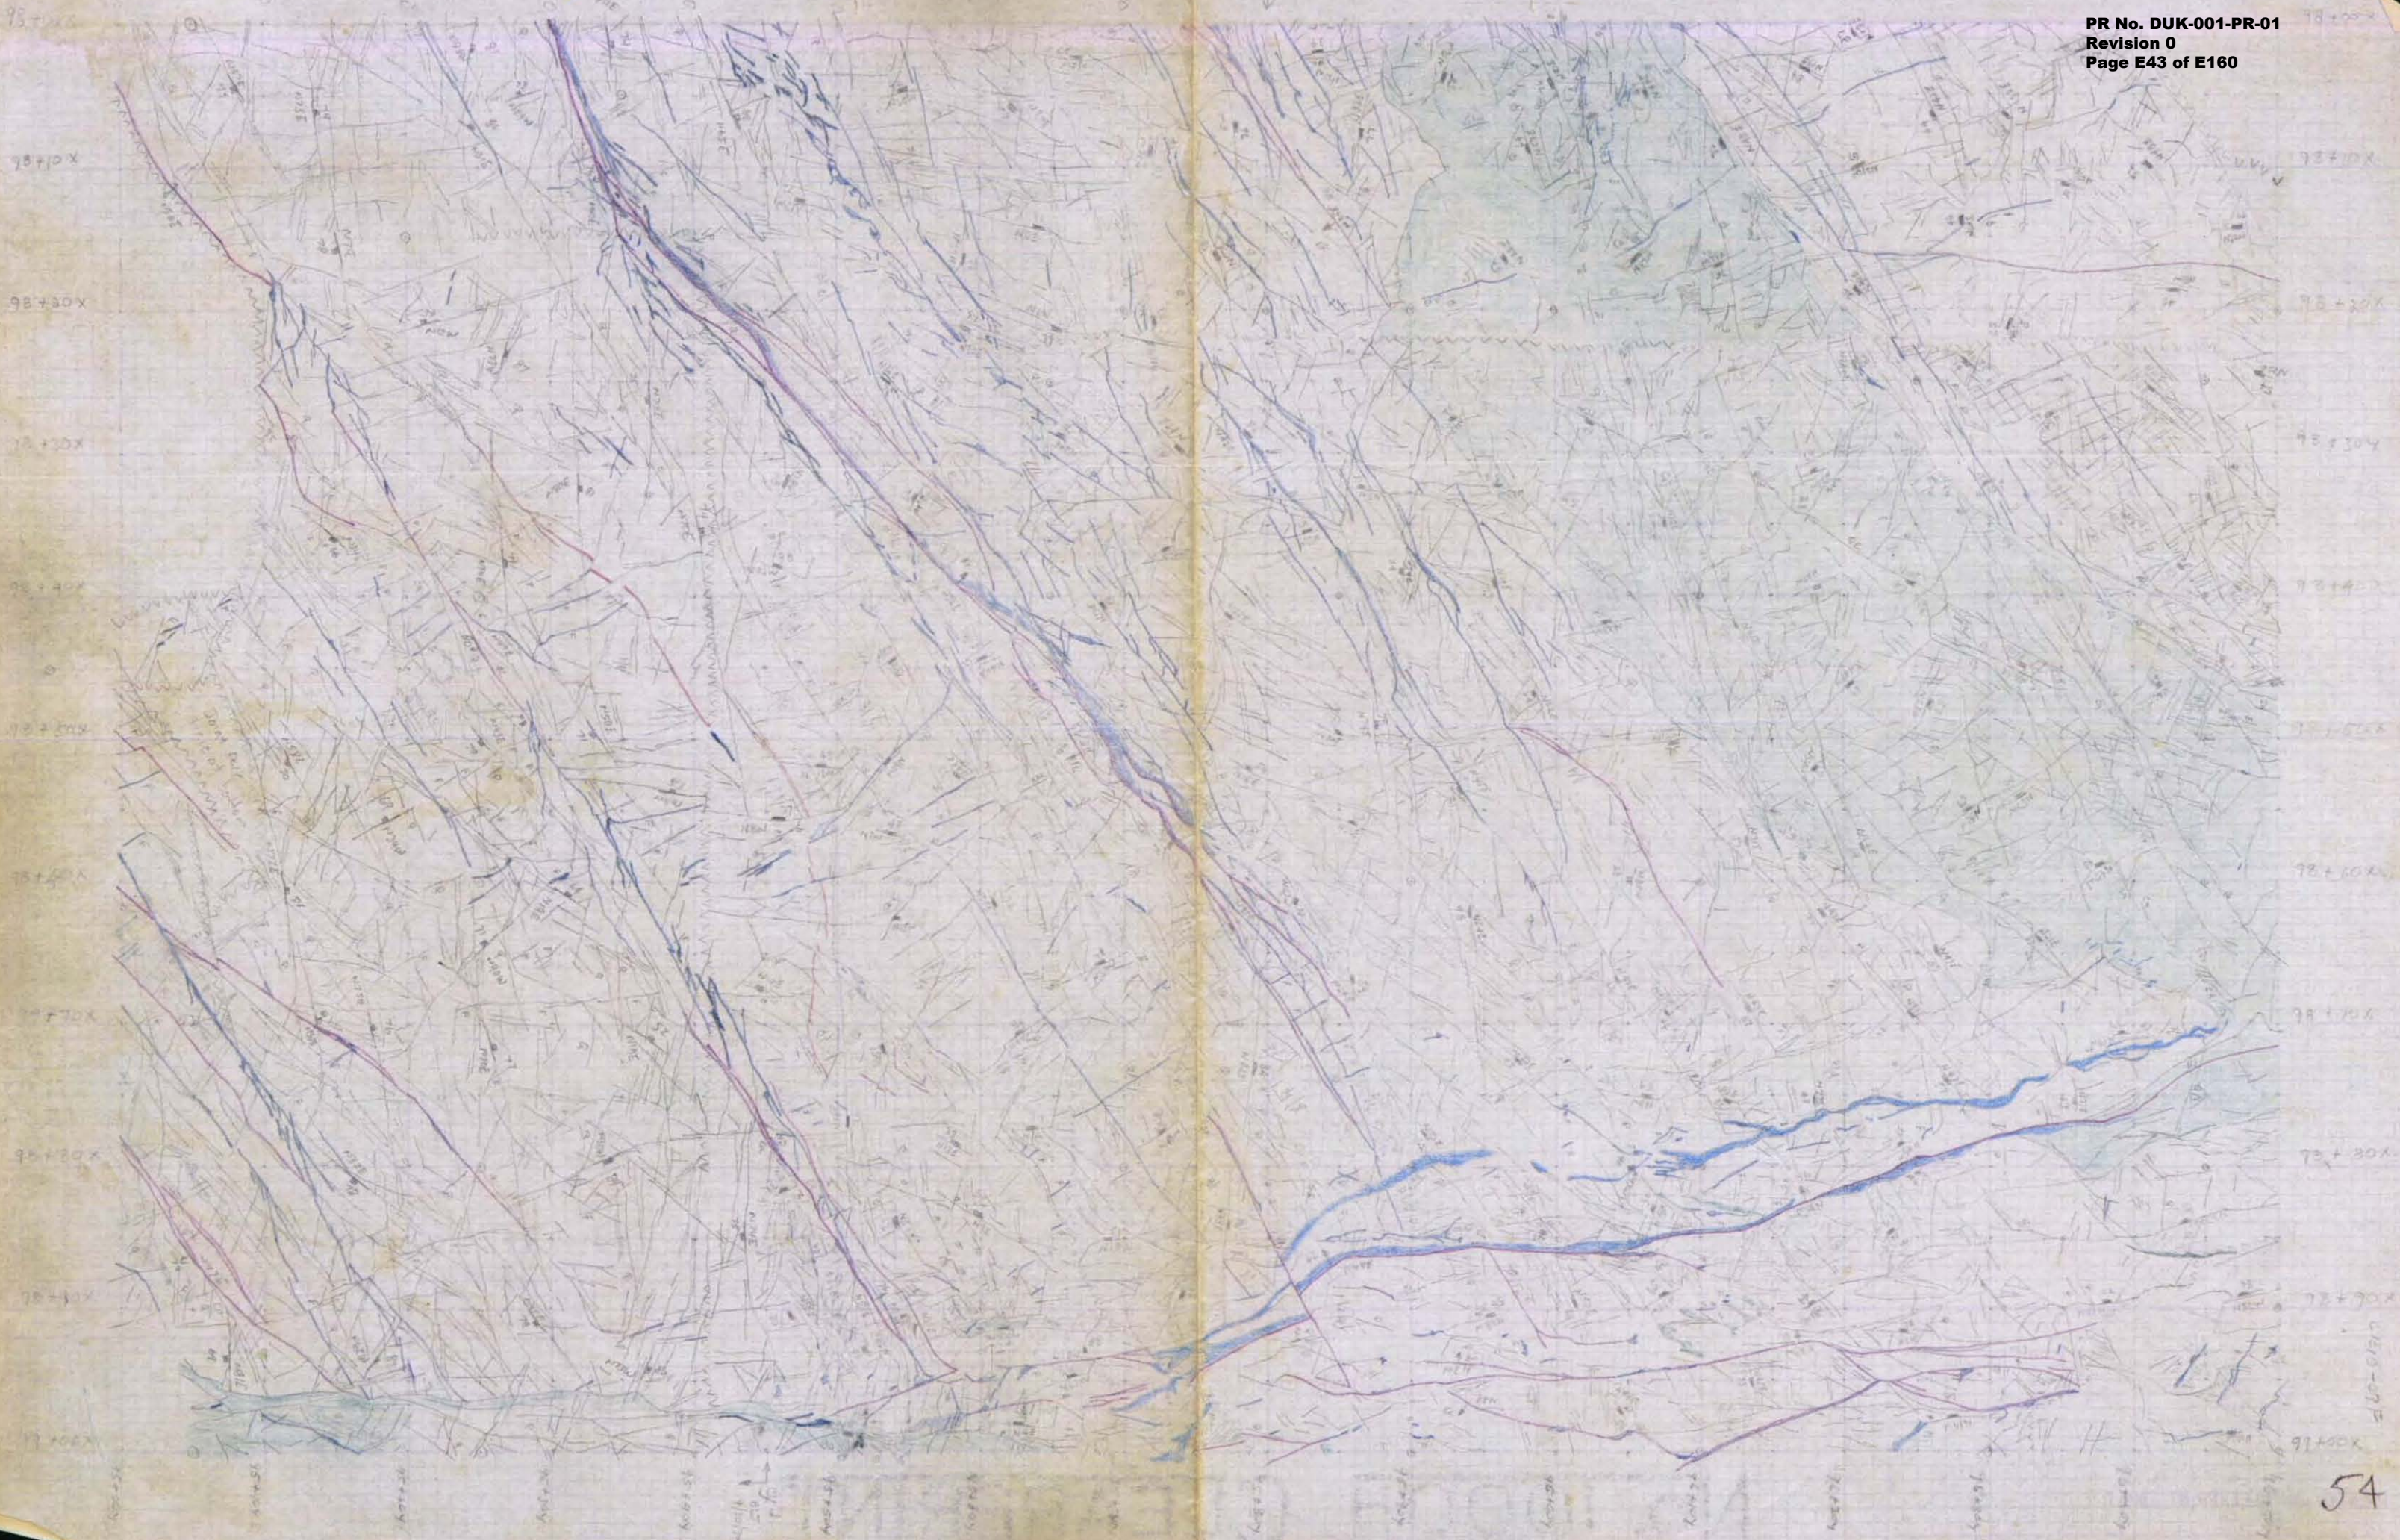

98+00X

98+00X

98+10Y

98+10Y

98+20Y

98+20Y

98+30Y

98+30Y

98+40Y

98+40Y

98+50Y

98+50Y

98+60Y

98+60Y

98+70Y

98+70Y

98+80Y

98+80Y

98+90Y

98+90Y

99+00Y

99+00Y

55

98+00Y



96+00X

96+00X

96+10X

96+10X

96+20X

96+20X

96+30X

96+30X

96+40X

96+40X

96+50X

96+50X

96+60X

96+60X

96+70X

96+70X

96+80X


96+80X

96+90X

96+90X

97+00X

97+00X

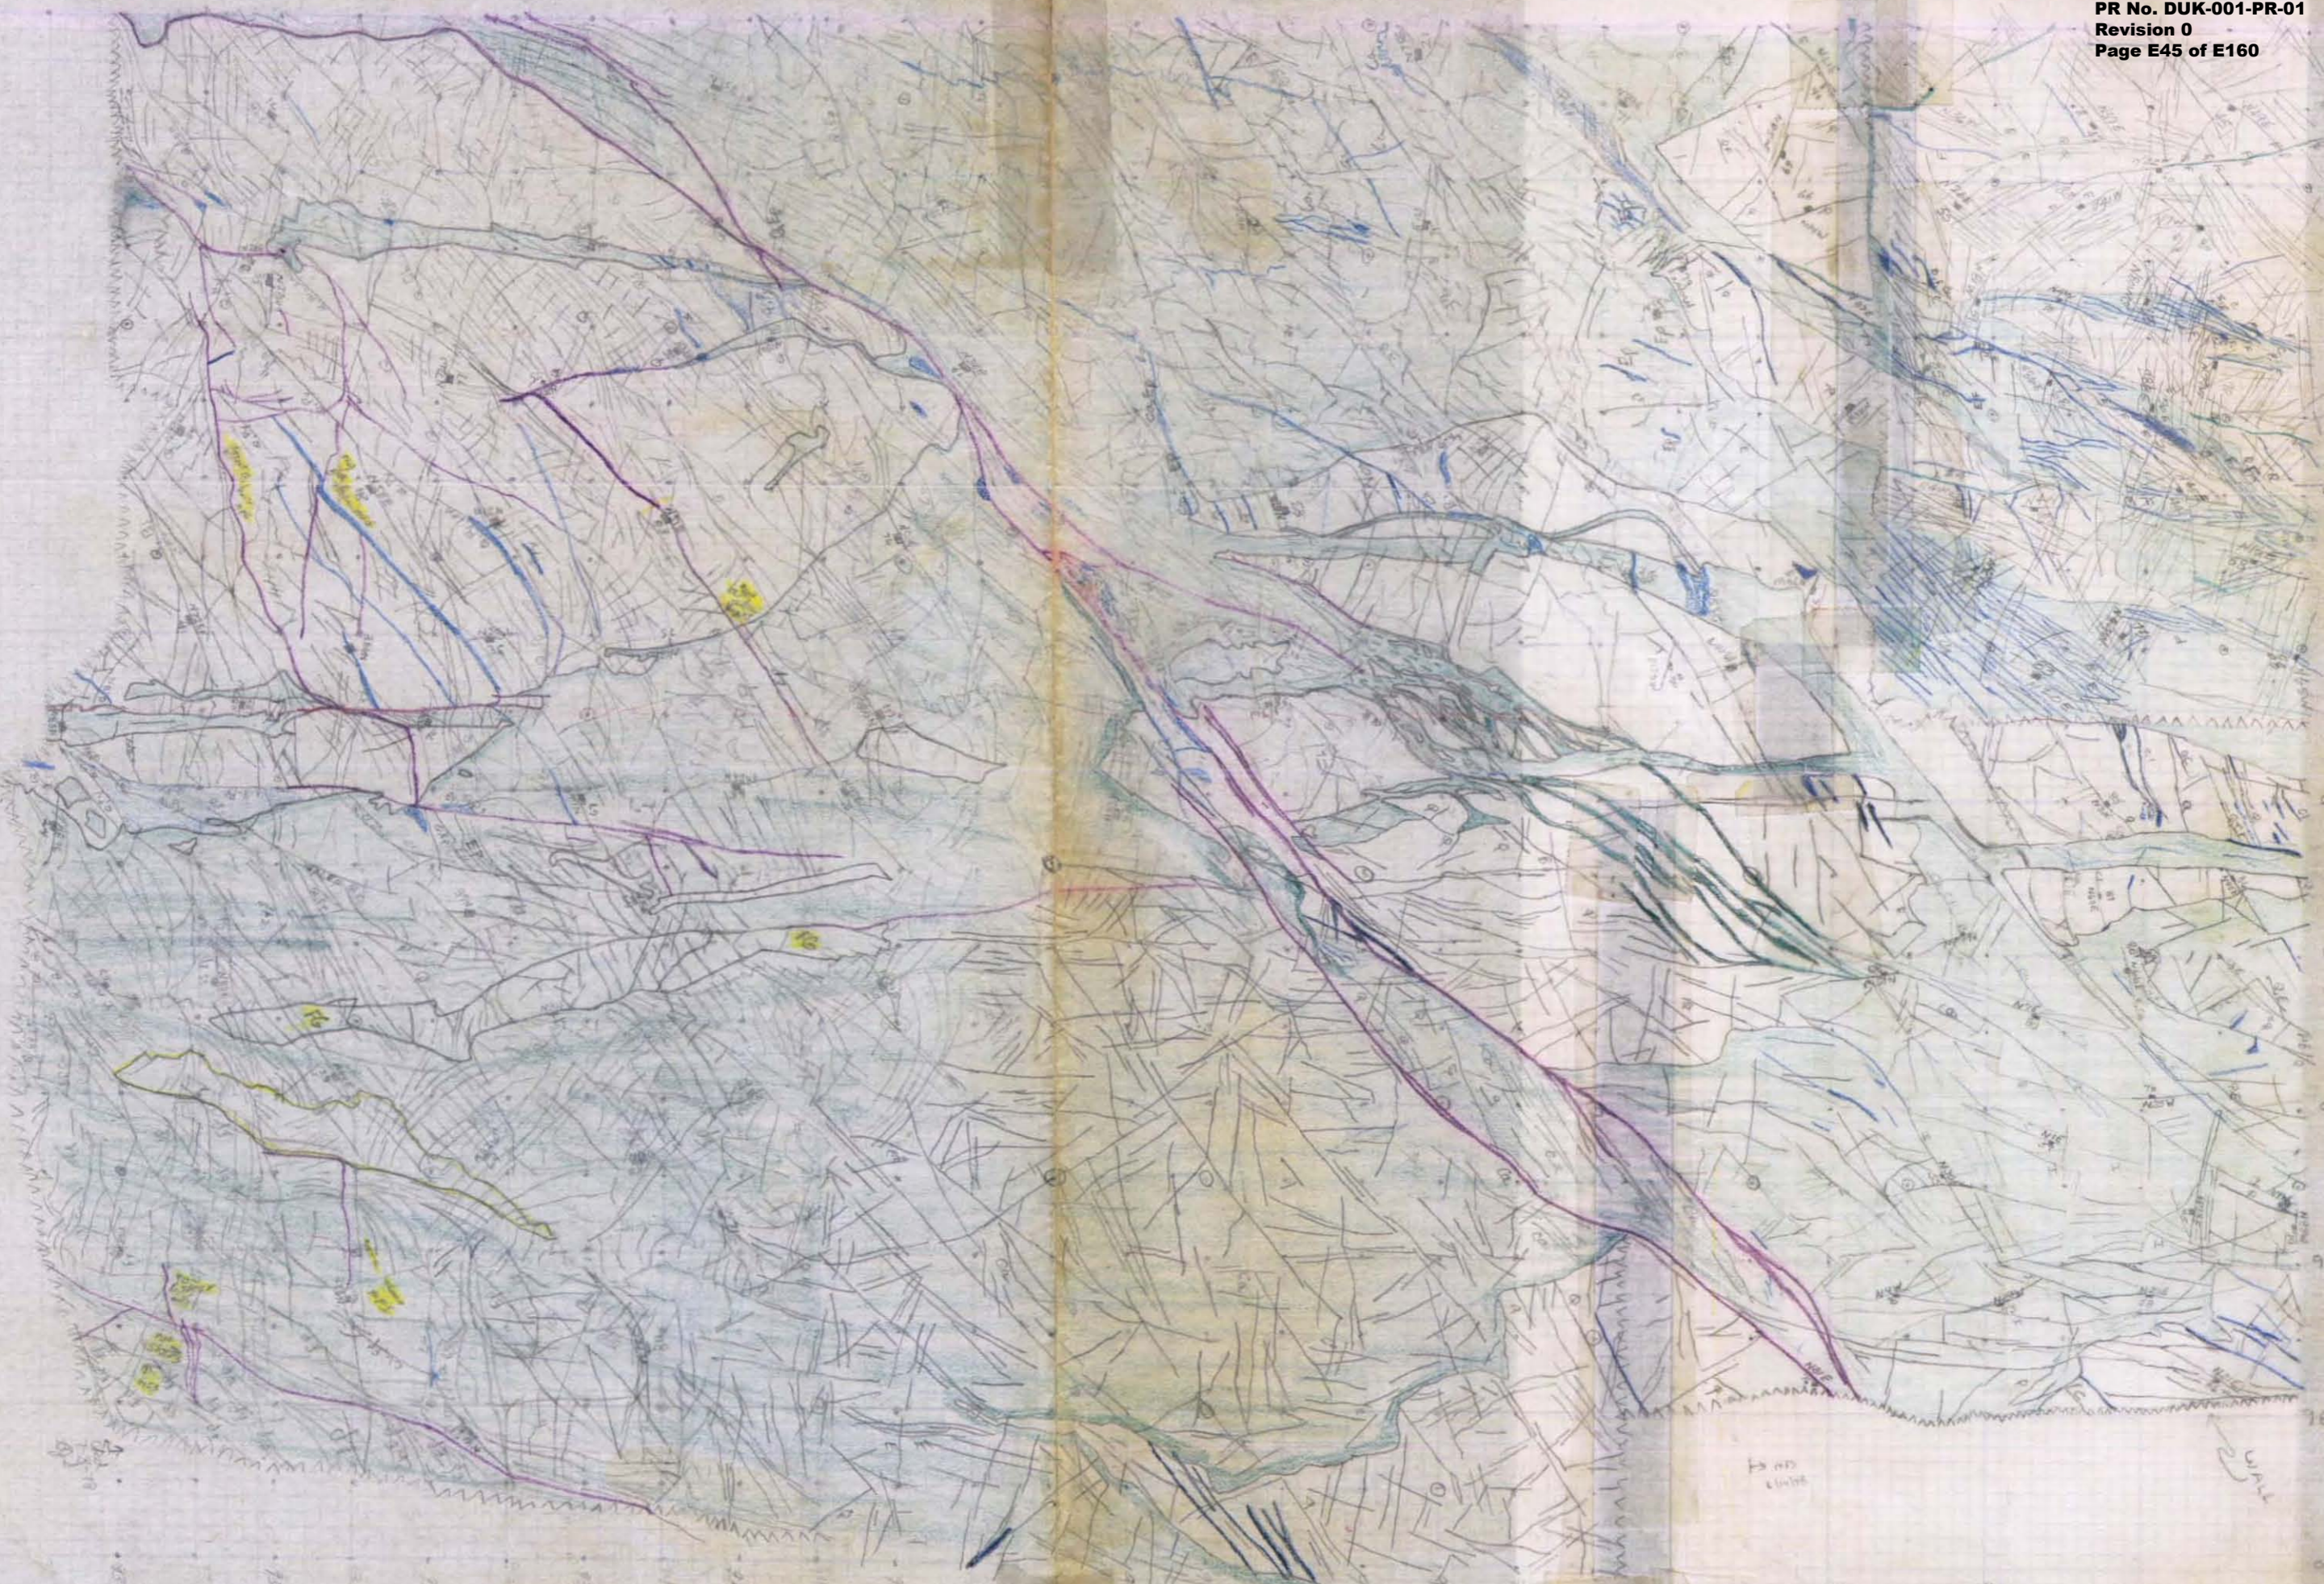

56

75-05A

97+00X
97+10X
97+20X
97+30X
97+40X
97+50X
97+60X
97+70X
97+80X
97+90X
98+00X

97+00X
97+10X
97+20X
97+30X
97+40X
97+50X
97+60X
97+70X
97+80X
97+90X
98+00X

93+50Y
93+60Y
93+70Y
93+80Y
93+90Y
94+00Y
94+10Y
94+20Y
94+30Y
94+40Y
94+50Y
94+60Y
94+70Y
94+80Y
94+90Y
95+00Y




CKID-08B
97+90Y

96+00X
96+10X
96+20X
96+30X
96+40X
96+50X
96+60X
96+70X
96+80X
96+90X
97+00X

96+00X
96+10X
96+20X
96+30X
96+40X
96+50X
96+60X
96+70X
96+80X
96+90X
97+00X



OKD-08A
96+80X

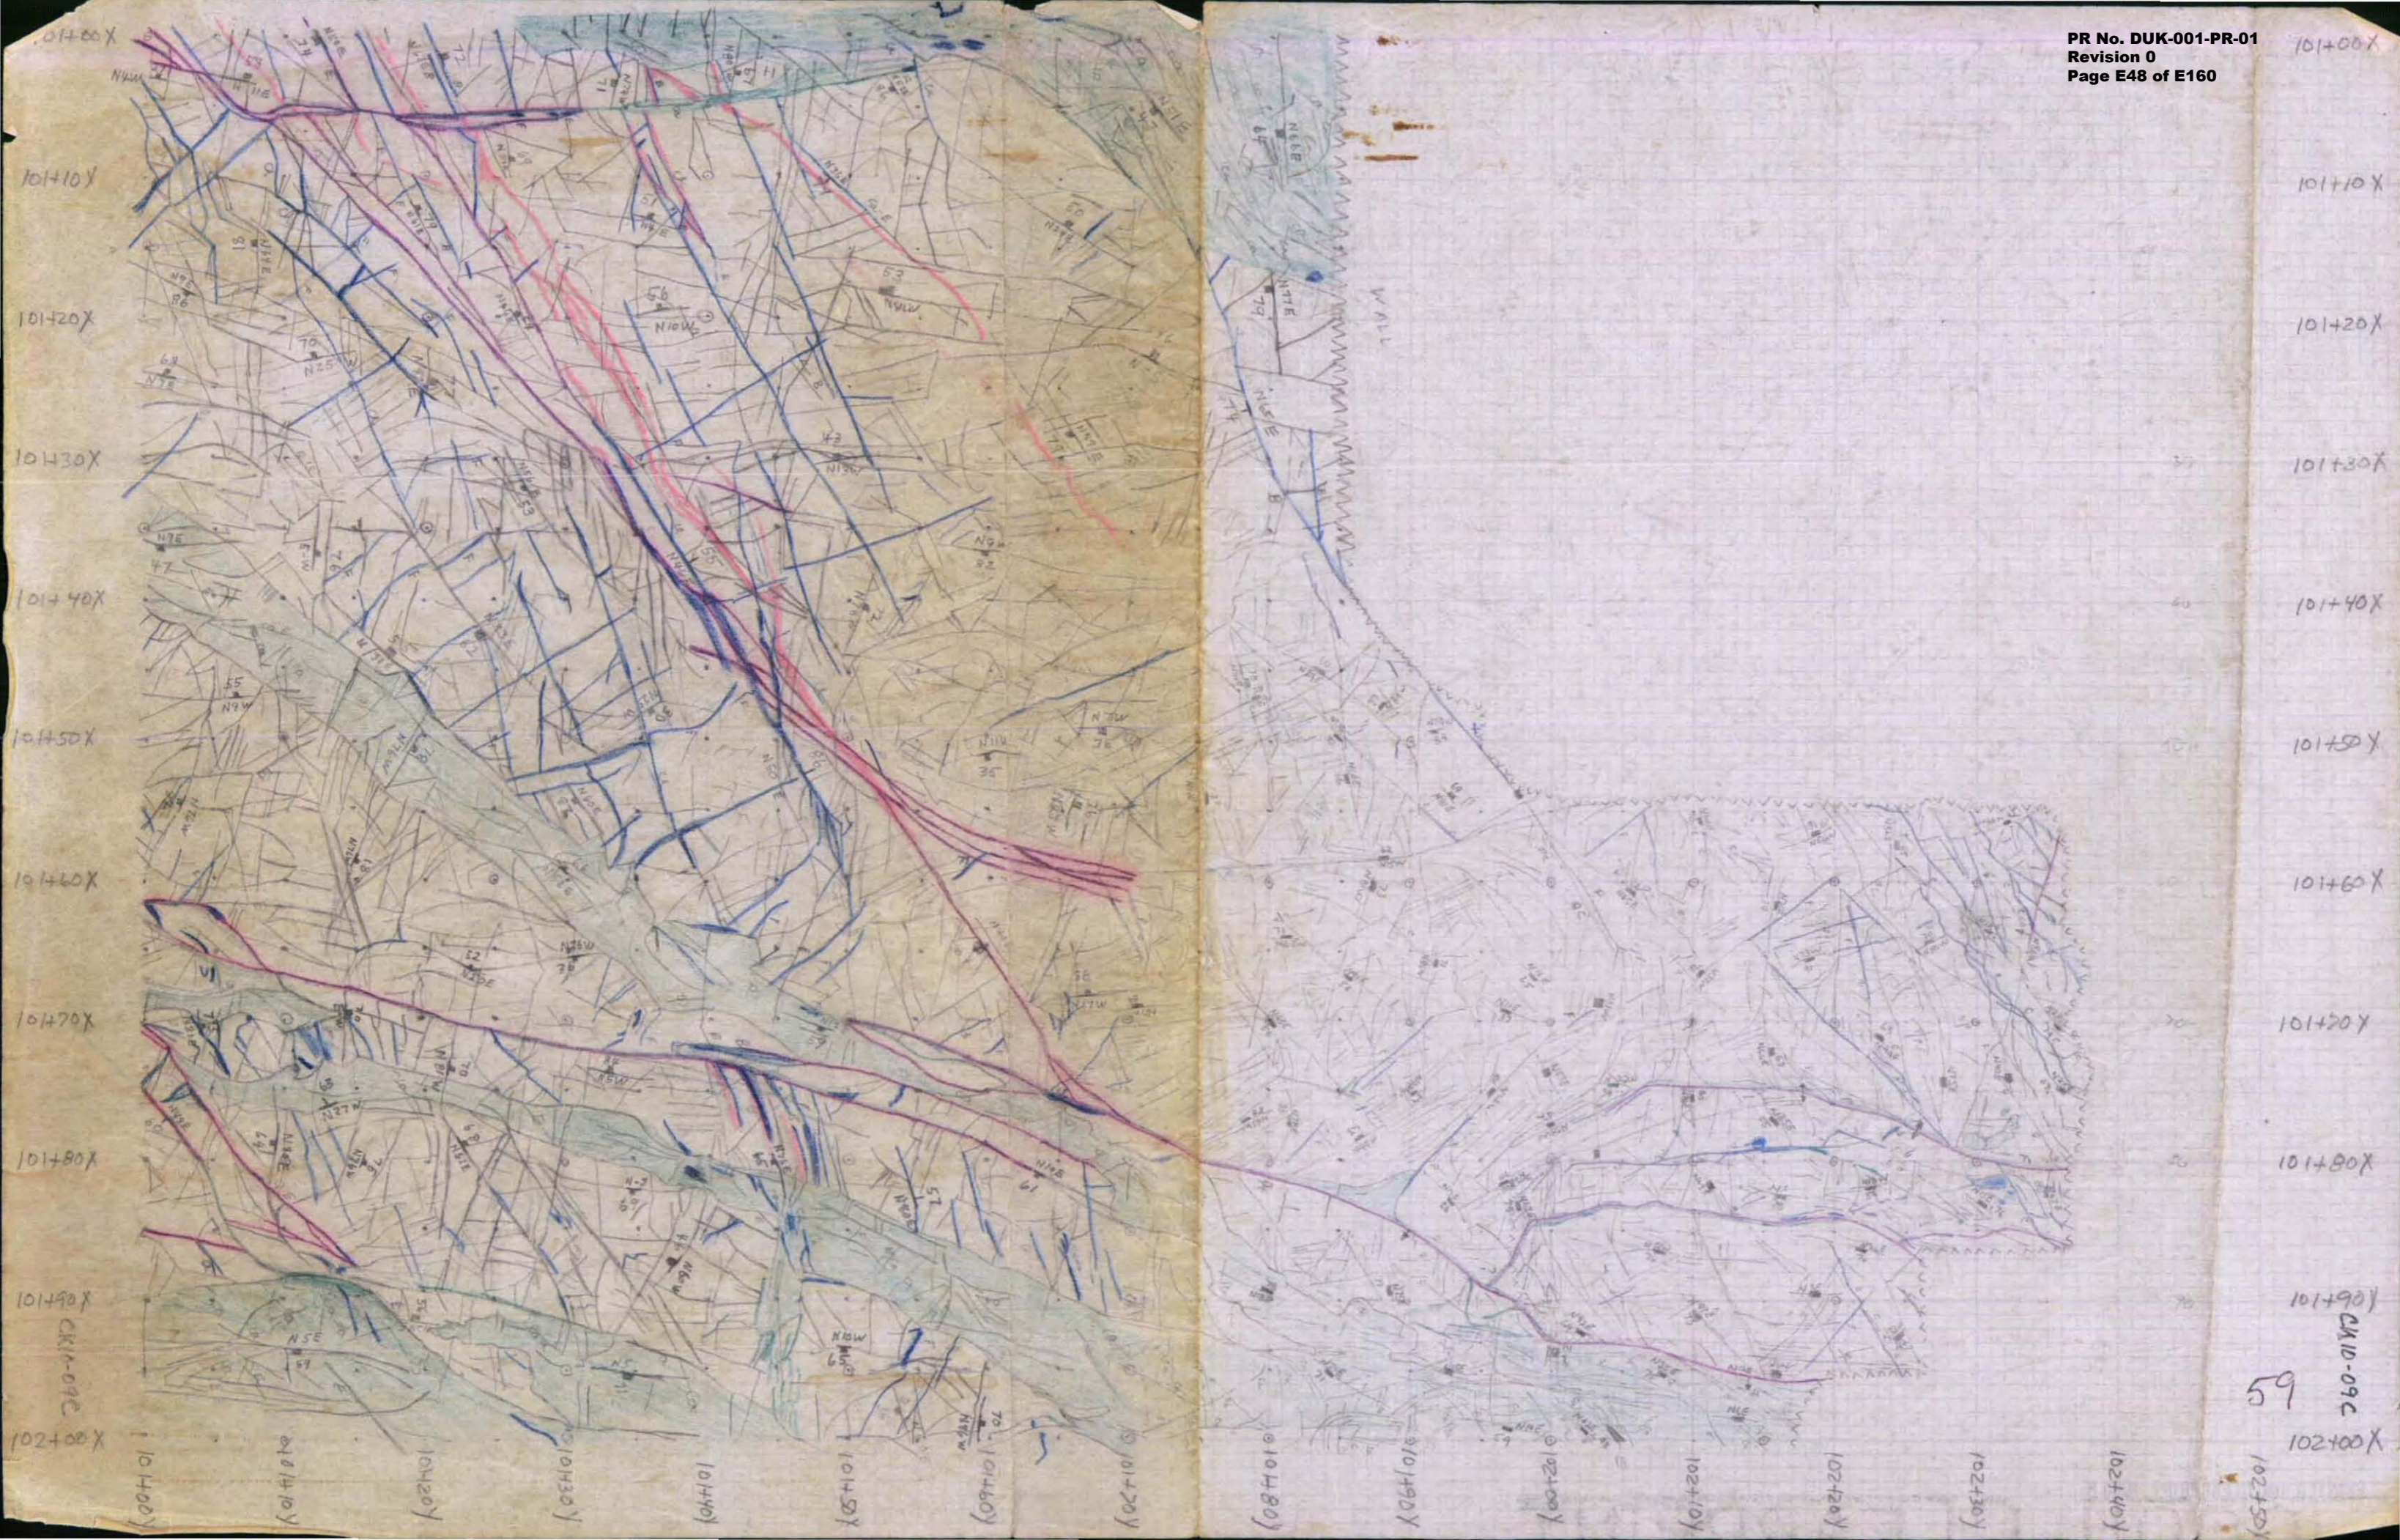


59

102+20X
102+50Y
102+20Y
102+30Y
102+40Y
102+50Y

101+00X
101+10Y
101+20X
101+30Y
101+40X
101+50Y
101+60X
101+70Y
101+80X
101+90Y
102+00X
101+00Y
101+10Y
101+20Y
101+30Y
101+40Y
101+50Y
101+60Y
101+70Y
101+80Y
101+90Y
102+00Y




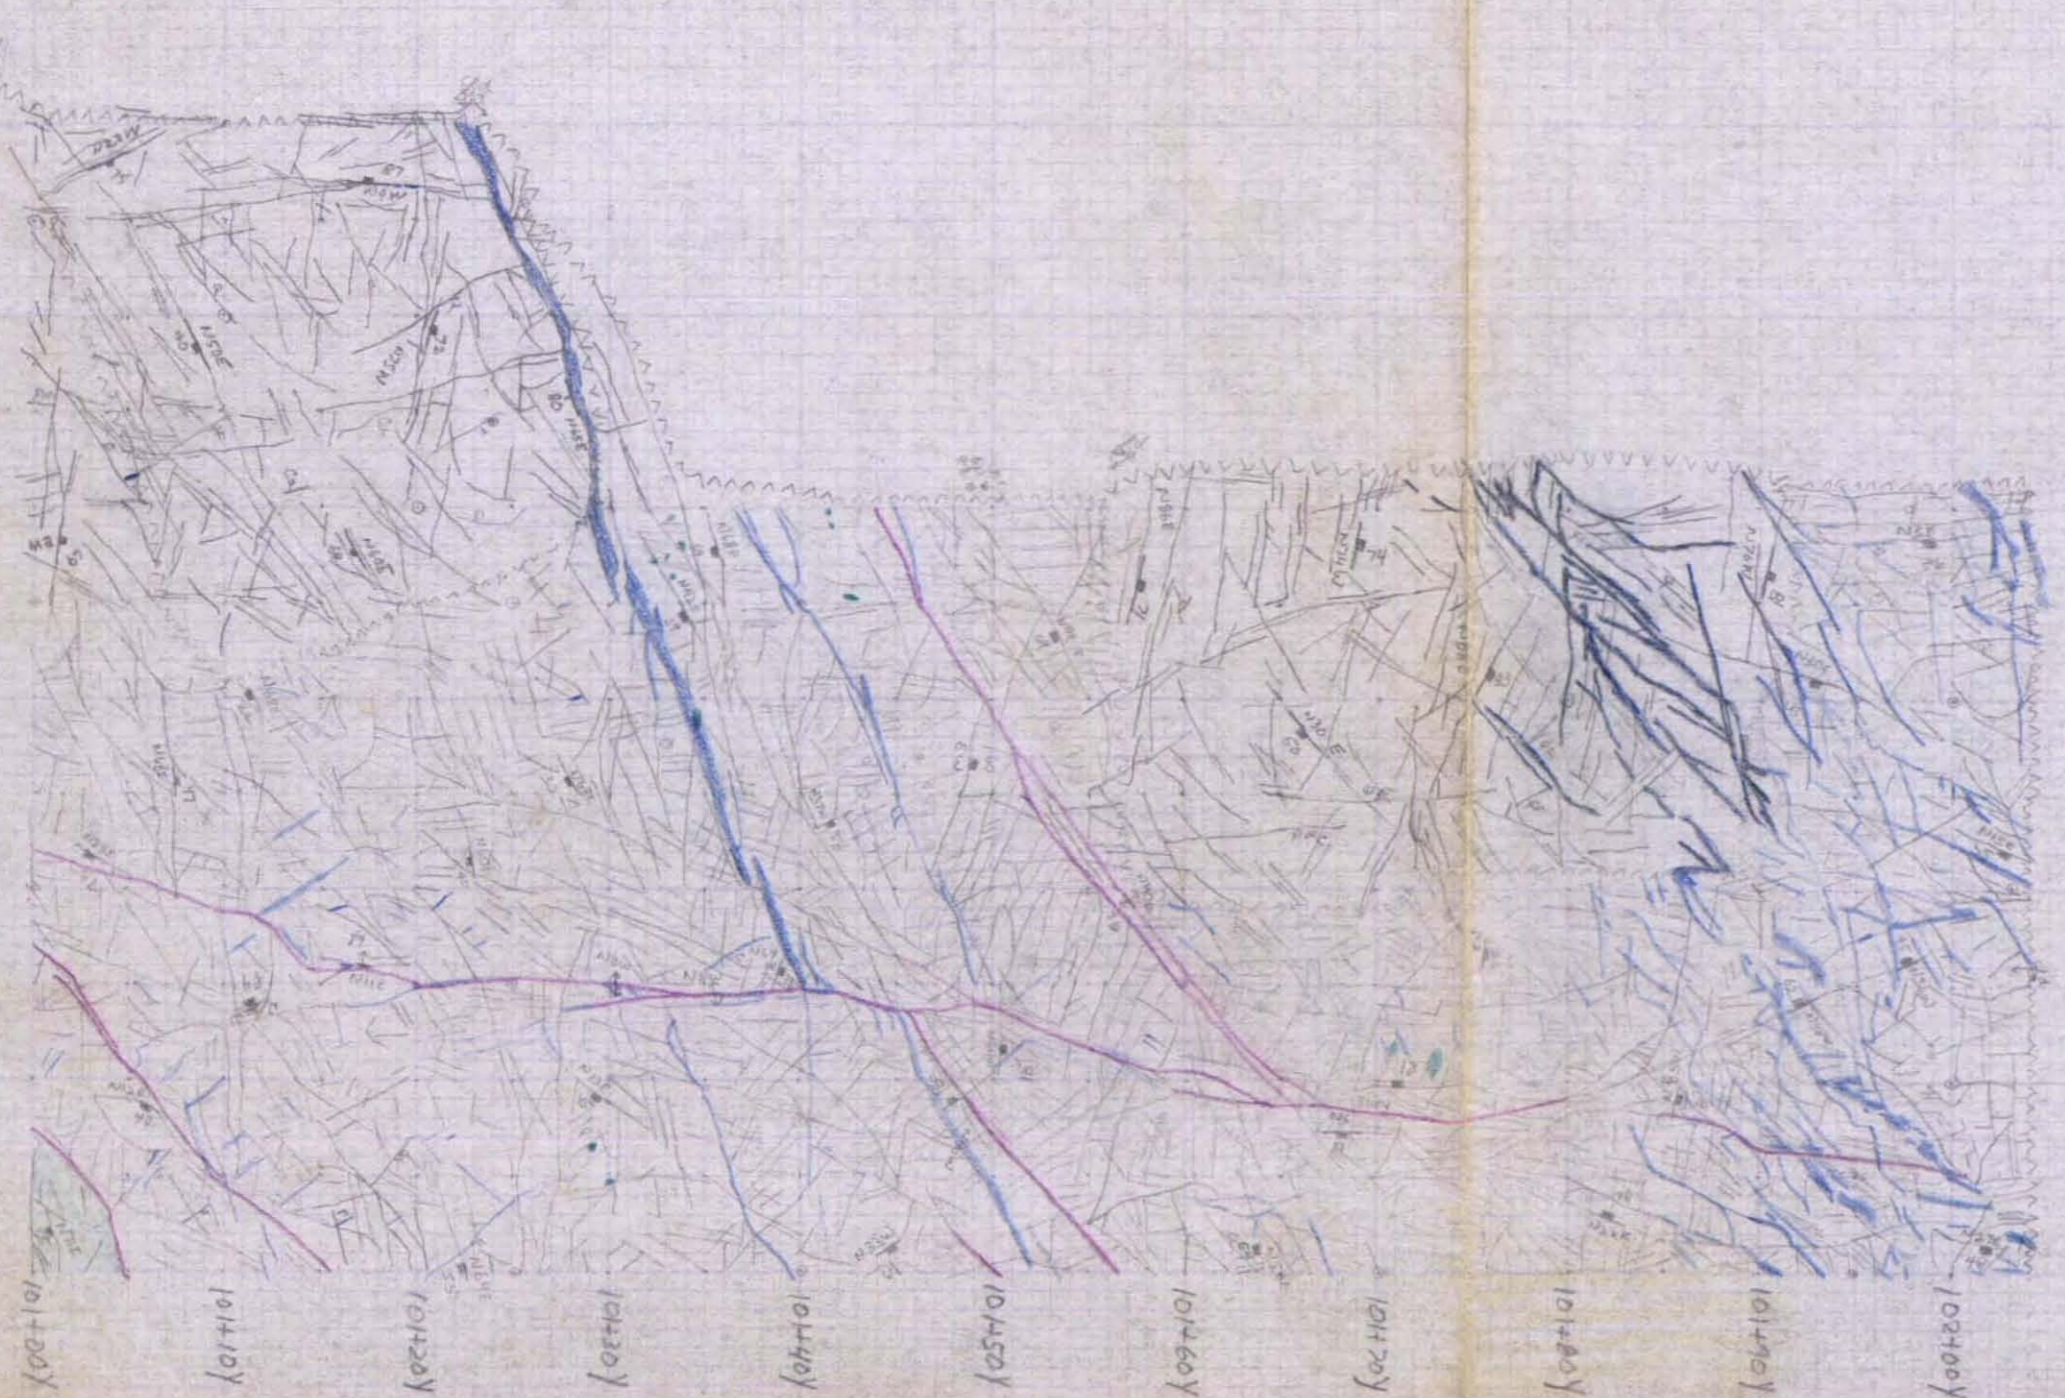

CK10-09A

60

CK10-09A

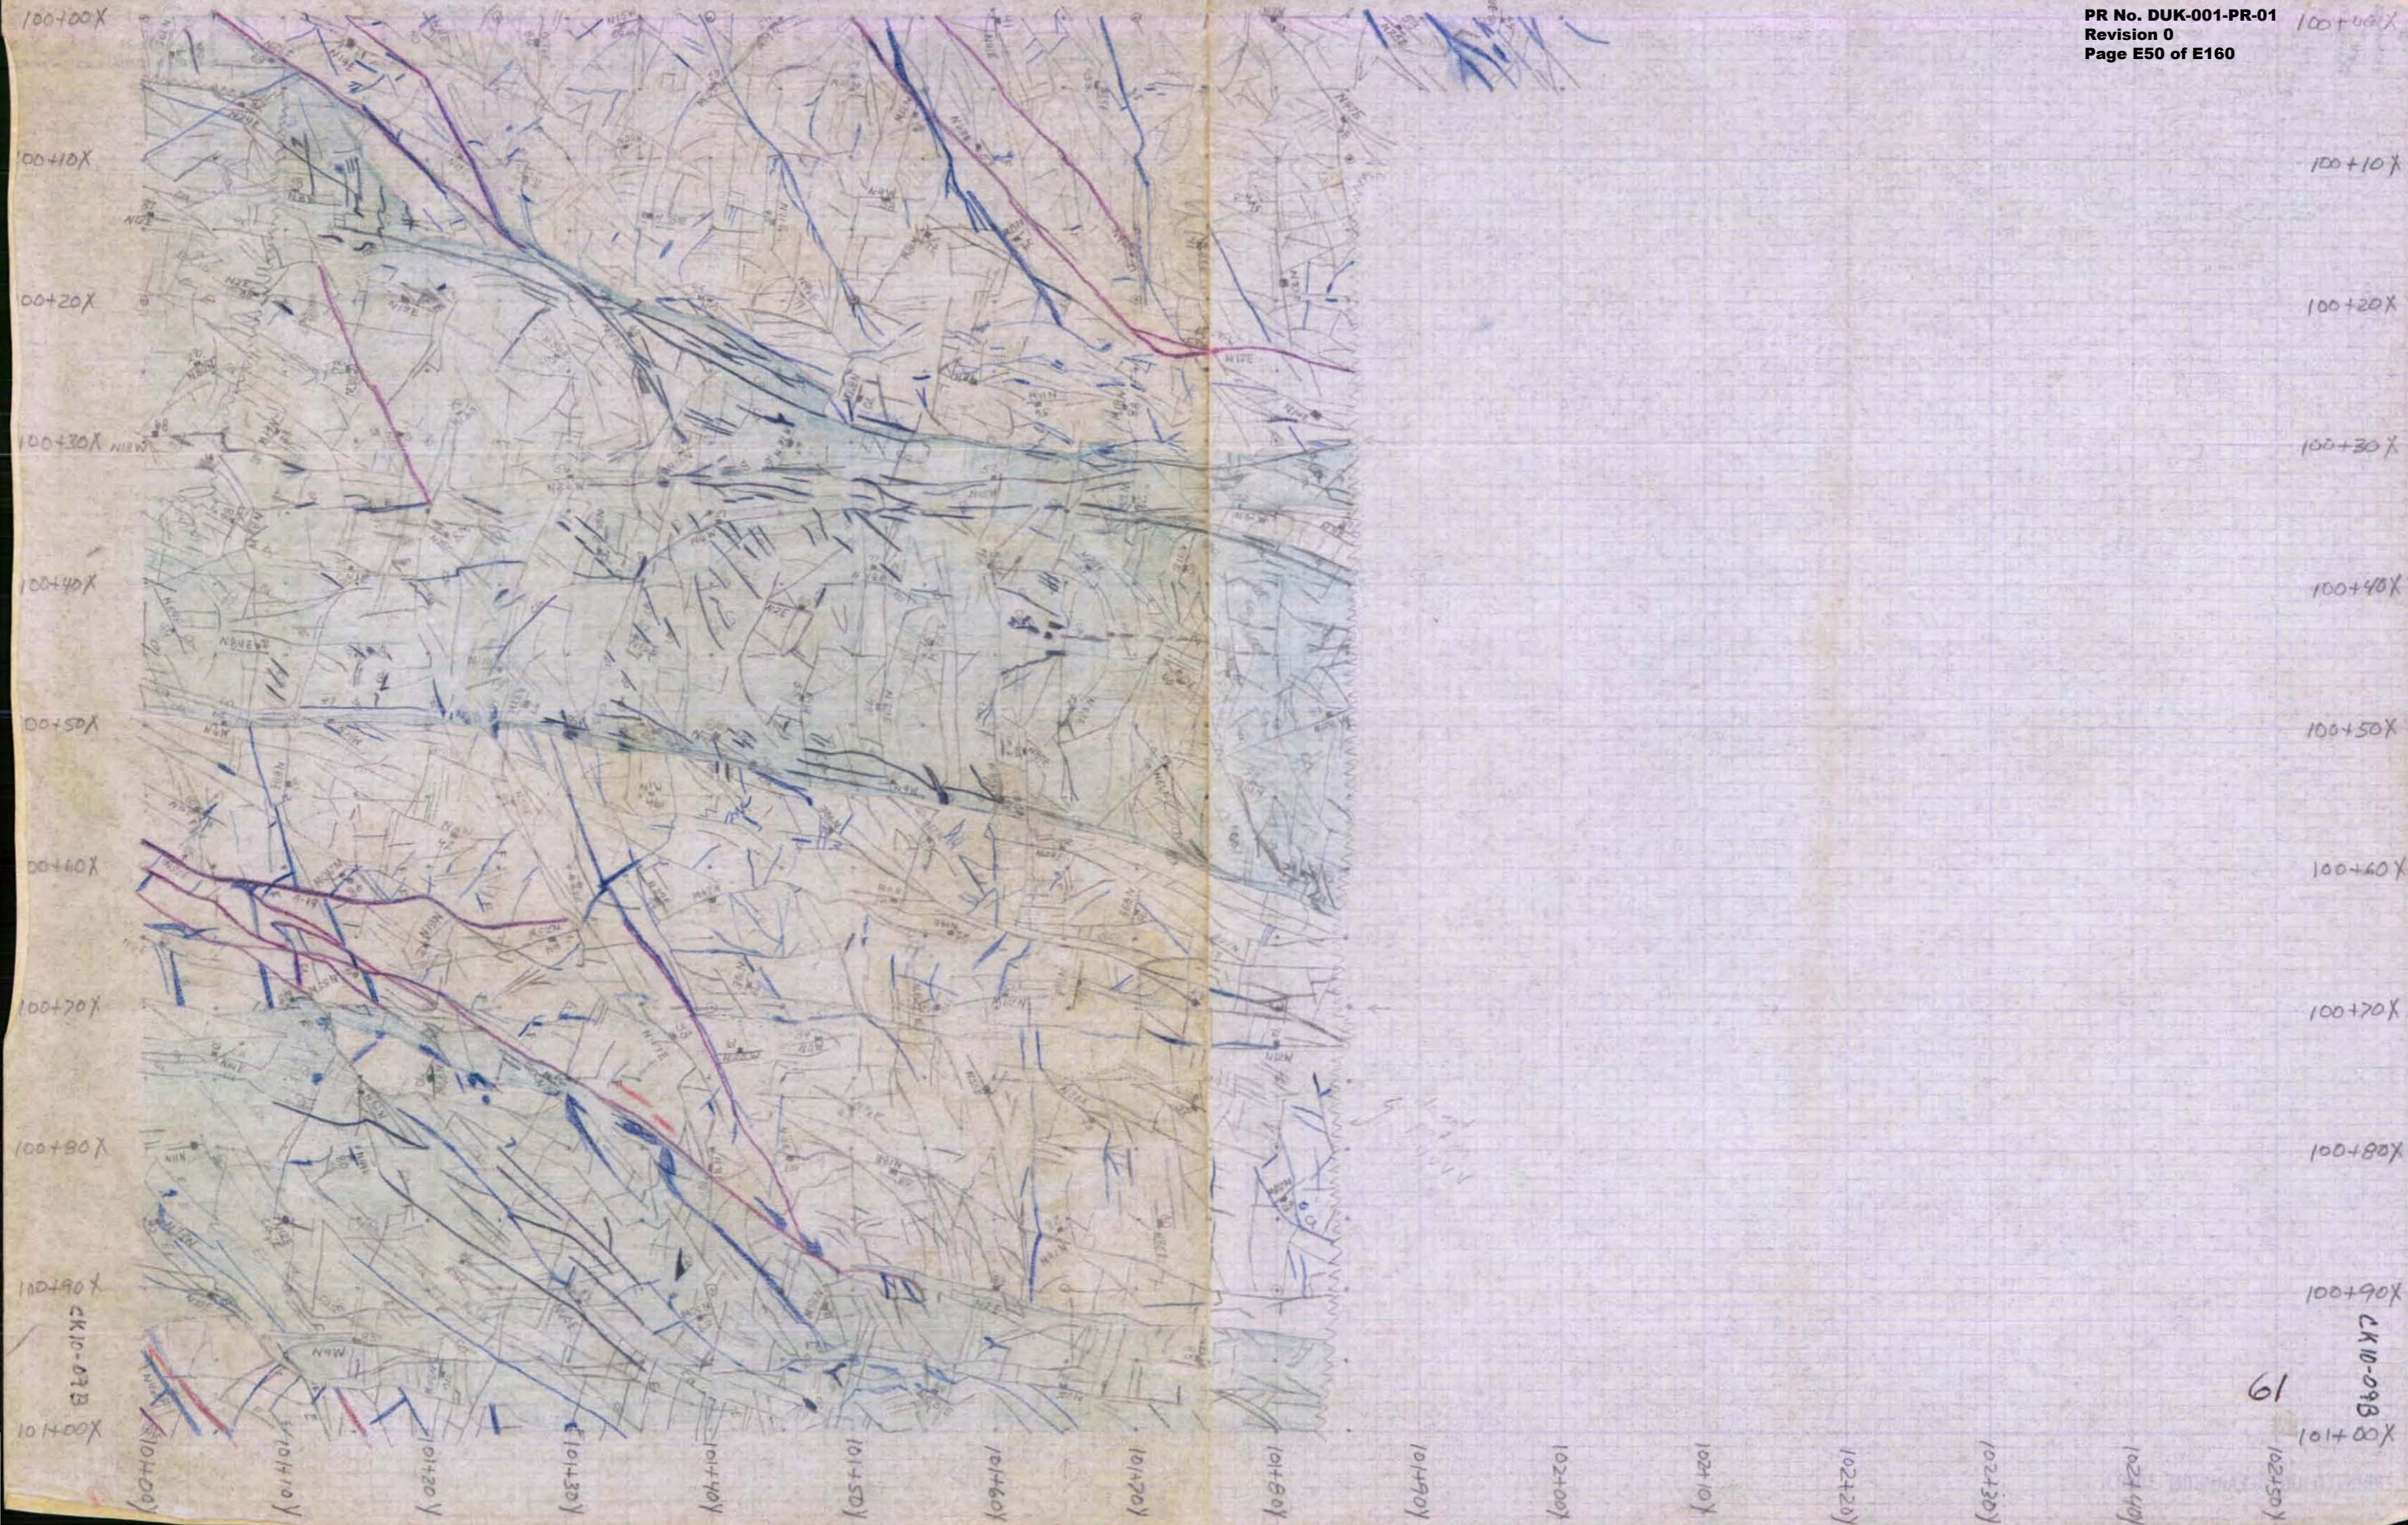

61

CK 10-09B

CK 10-09B





100+100X
100+10X
100+20X
100+30X
100+40X
100+50X
100+60X
100+70X
100+80X
100+90X
101+00X


100+100X
100+10X
100+20X
100+30X
100+40X
100+50X
100+60X
100+70X
100+80X
100+90X
101+00X

105+50
109+60
109+70
108+80
100+00
100+10
100+20
100+30
100+40
100+50
100+60
100+70
100+80
100+90
101+00

CR 10-10 B
29

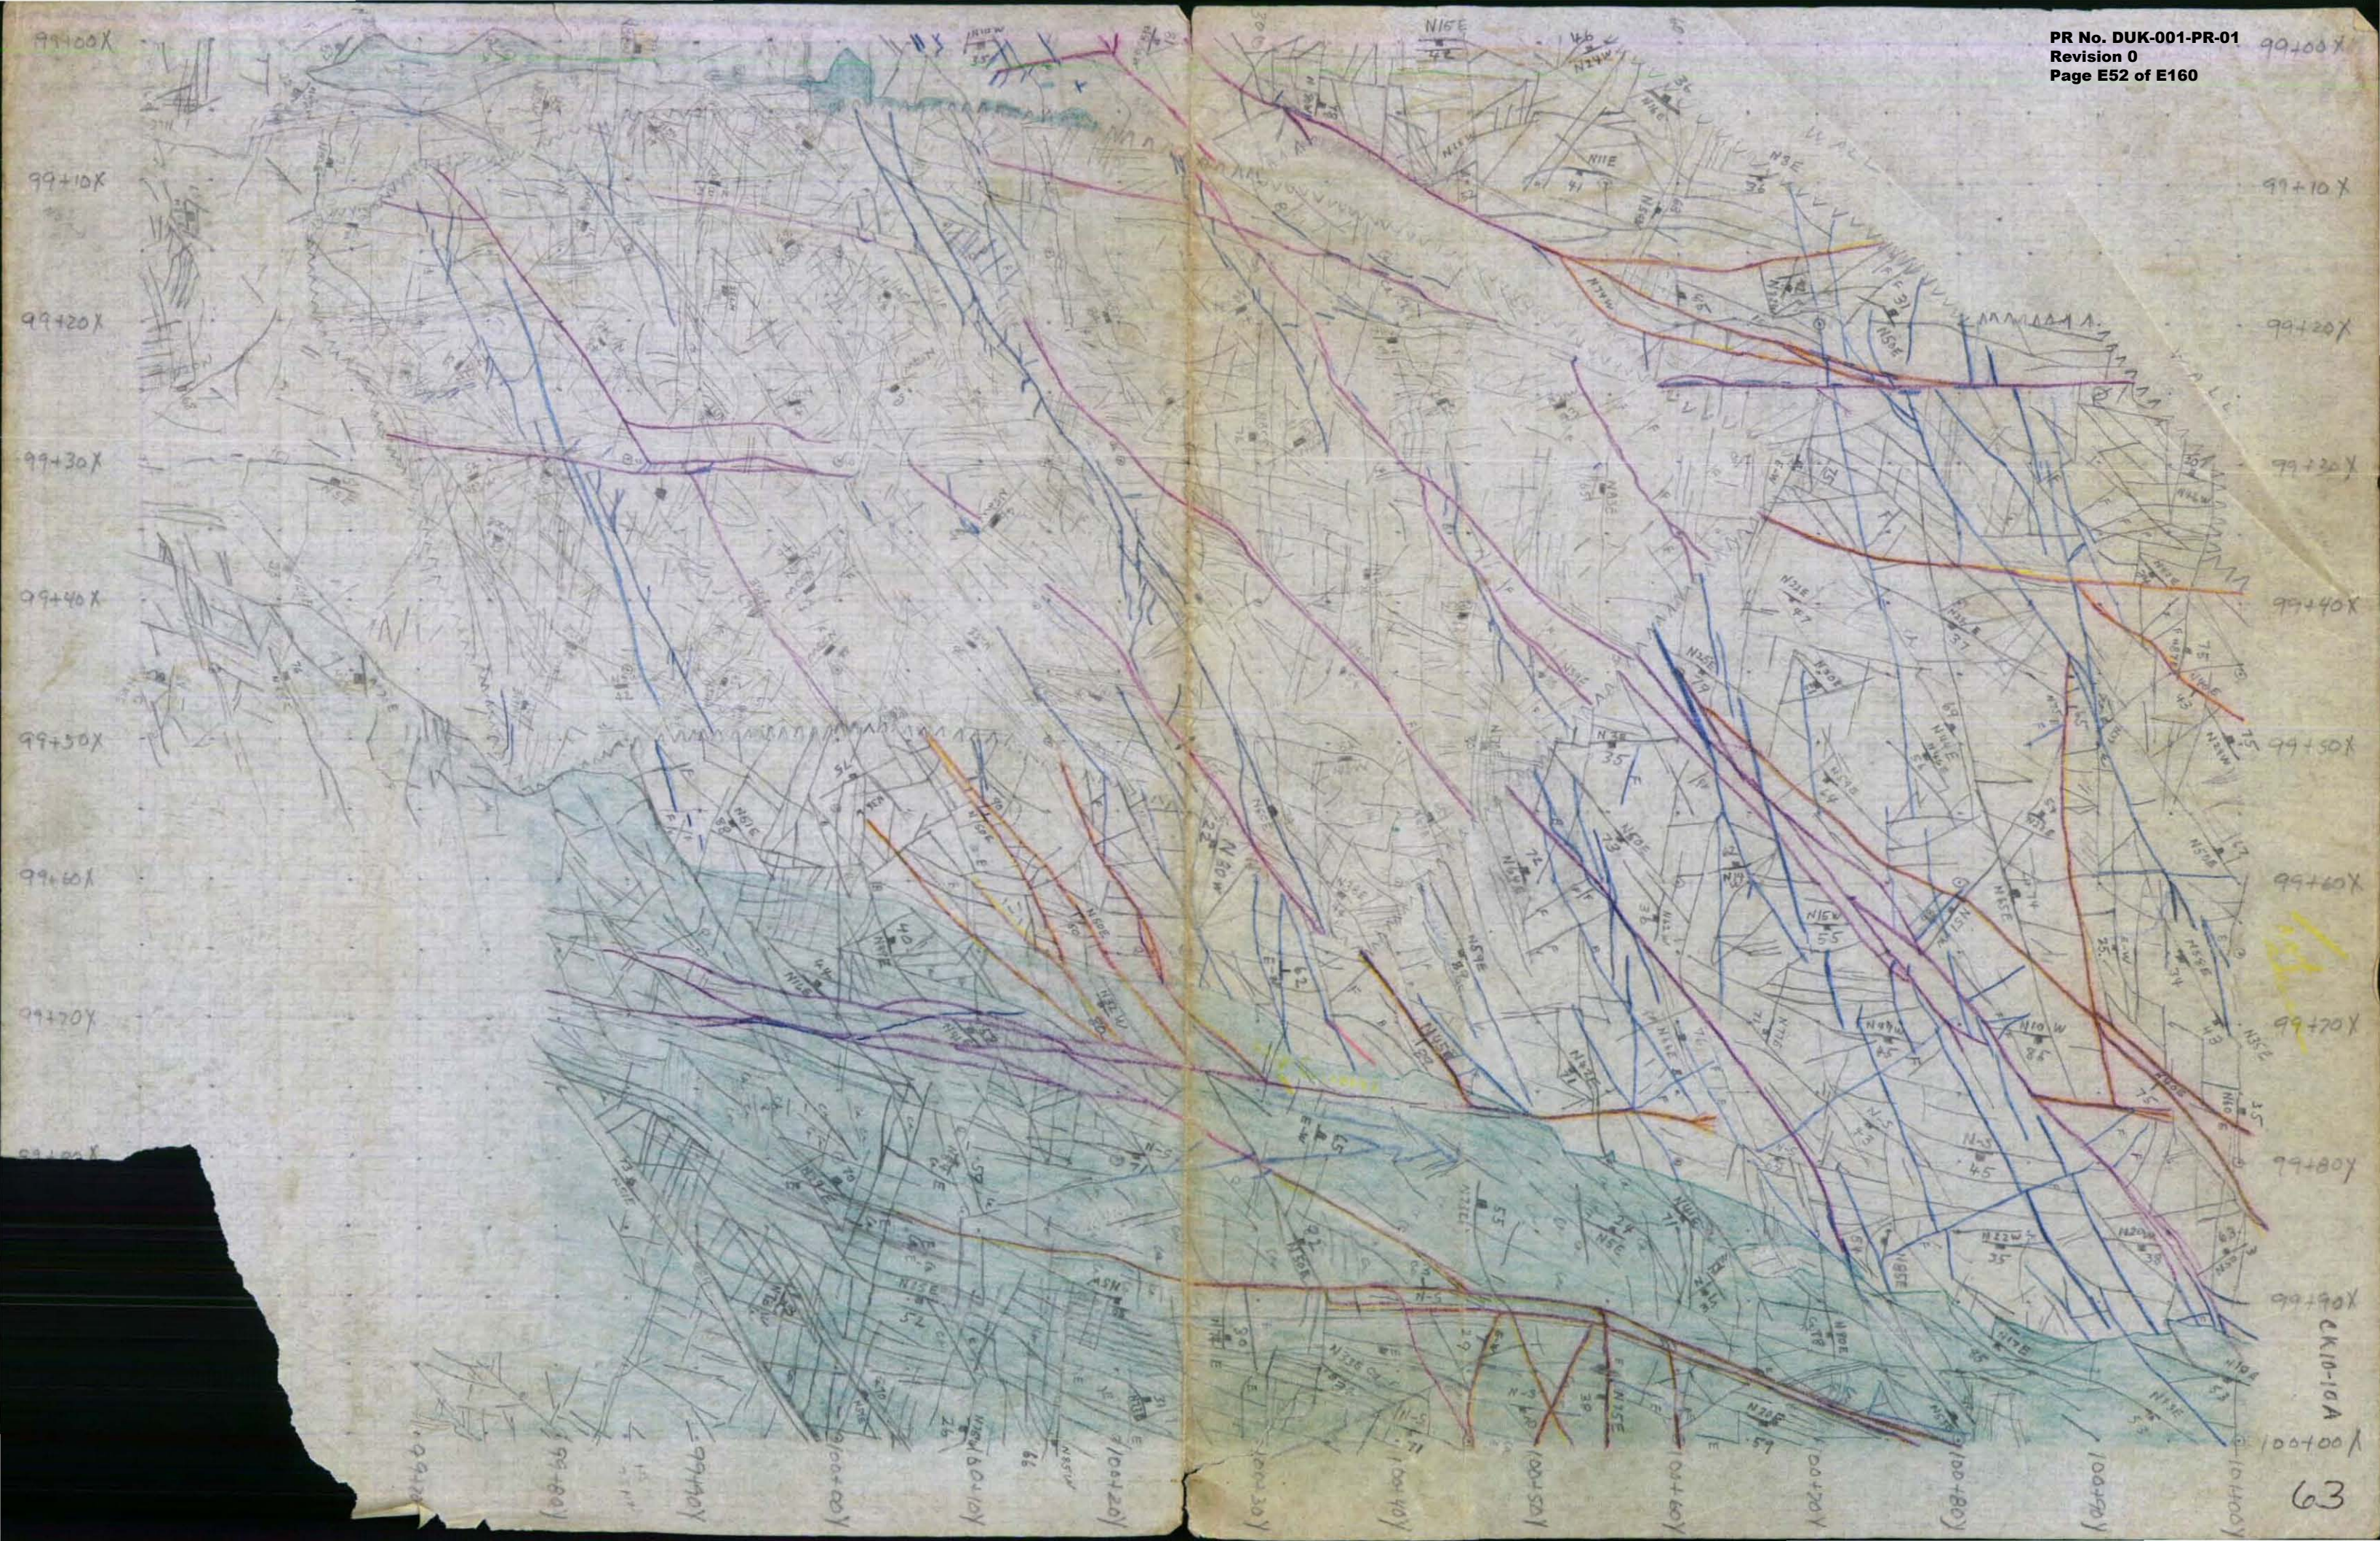

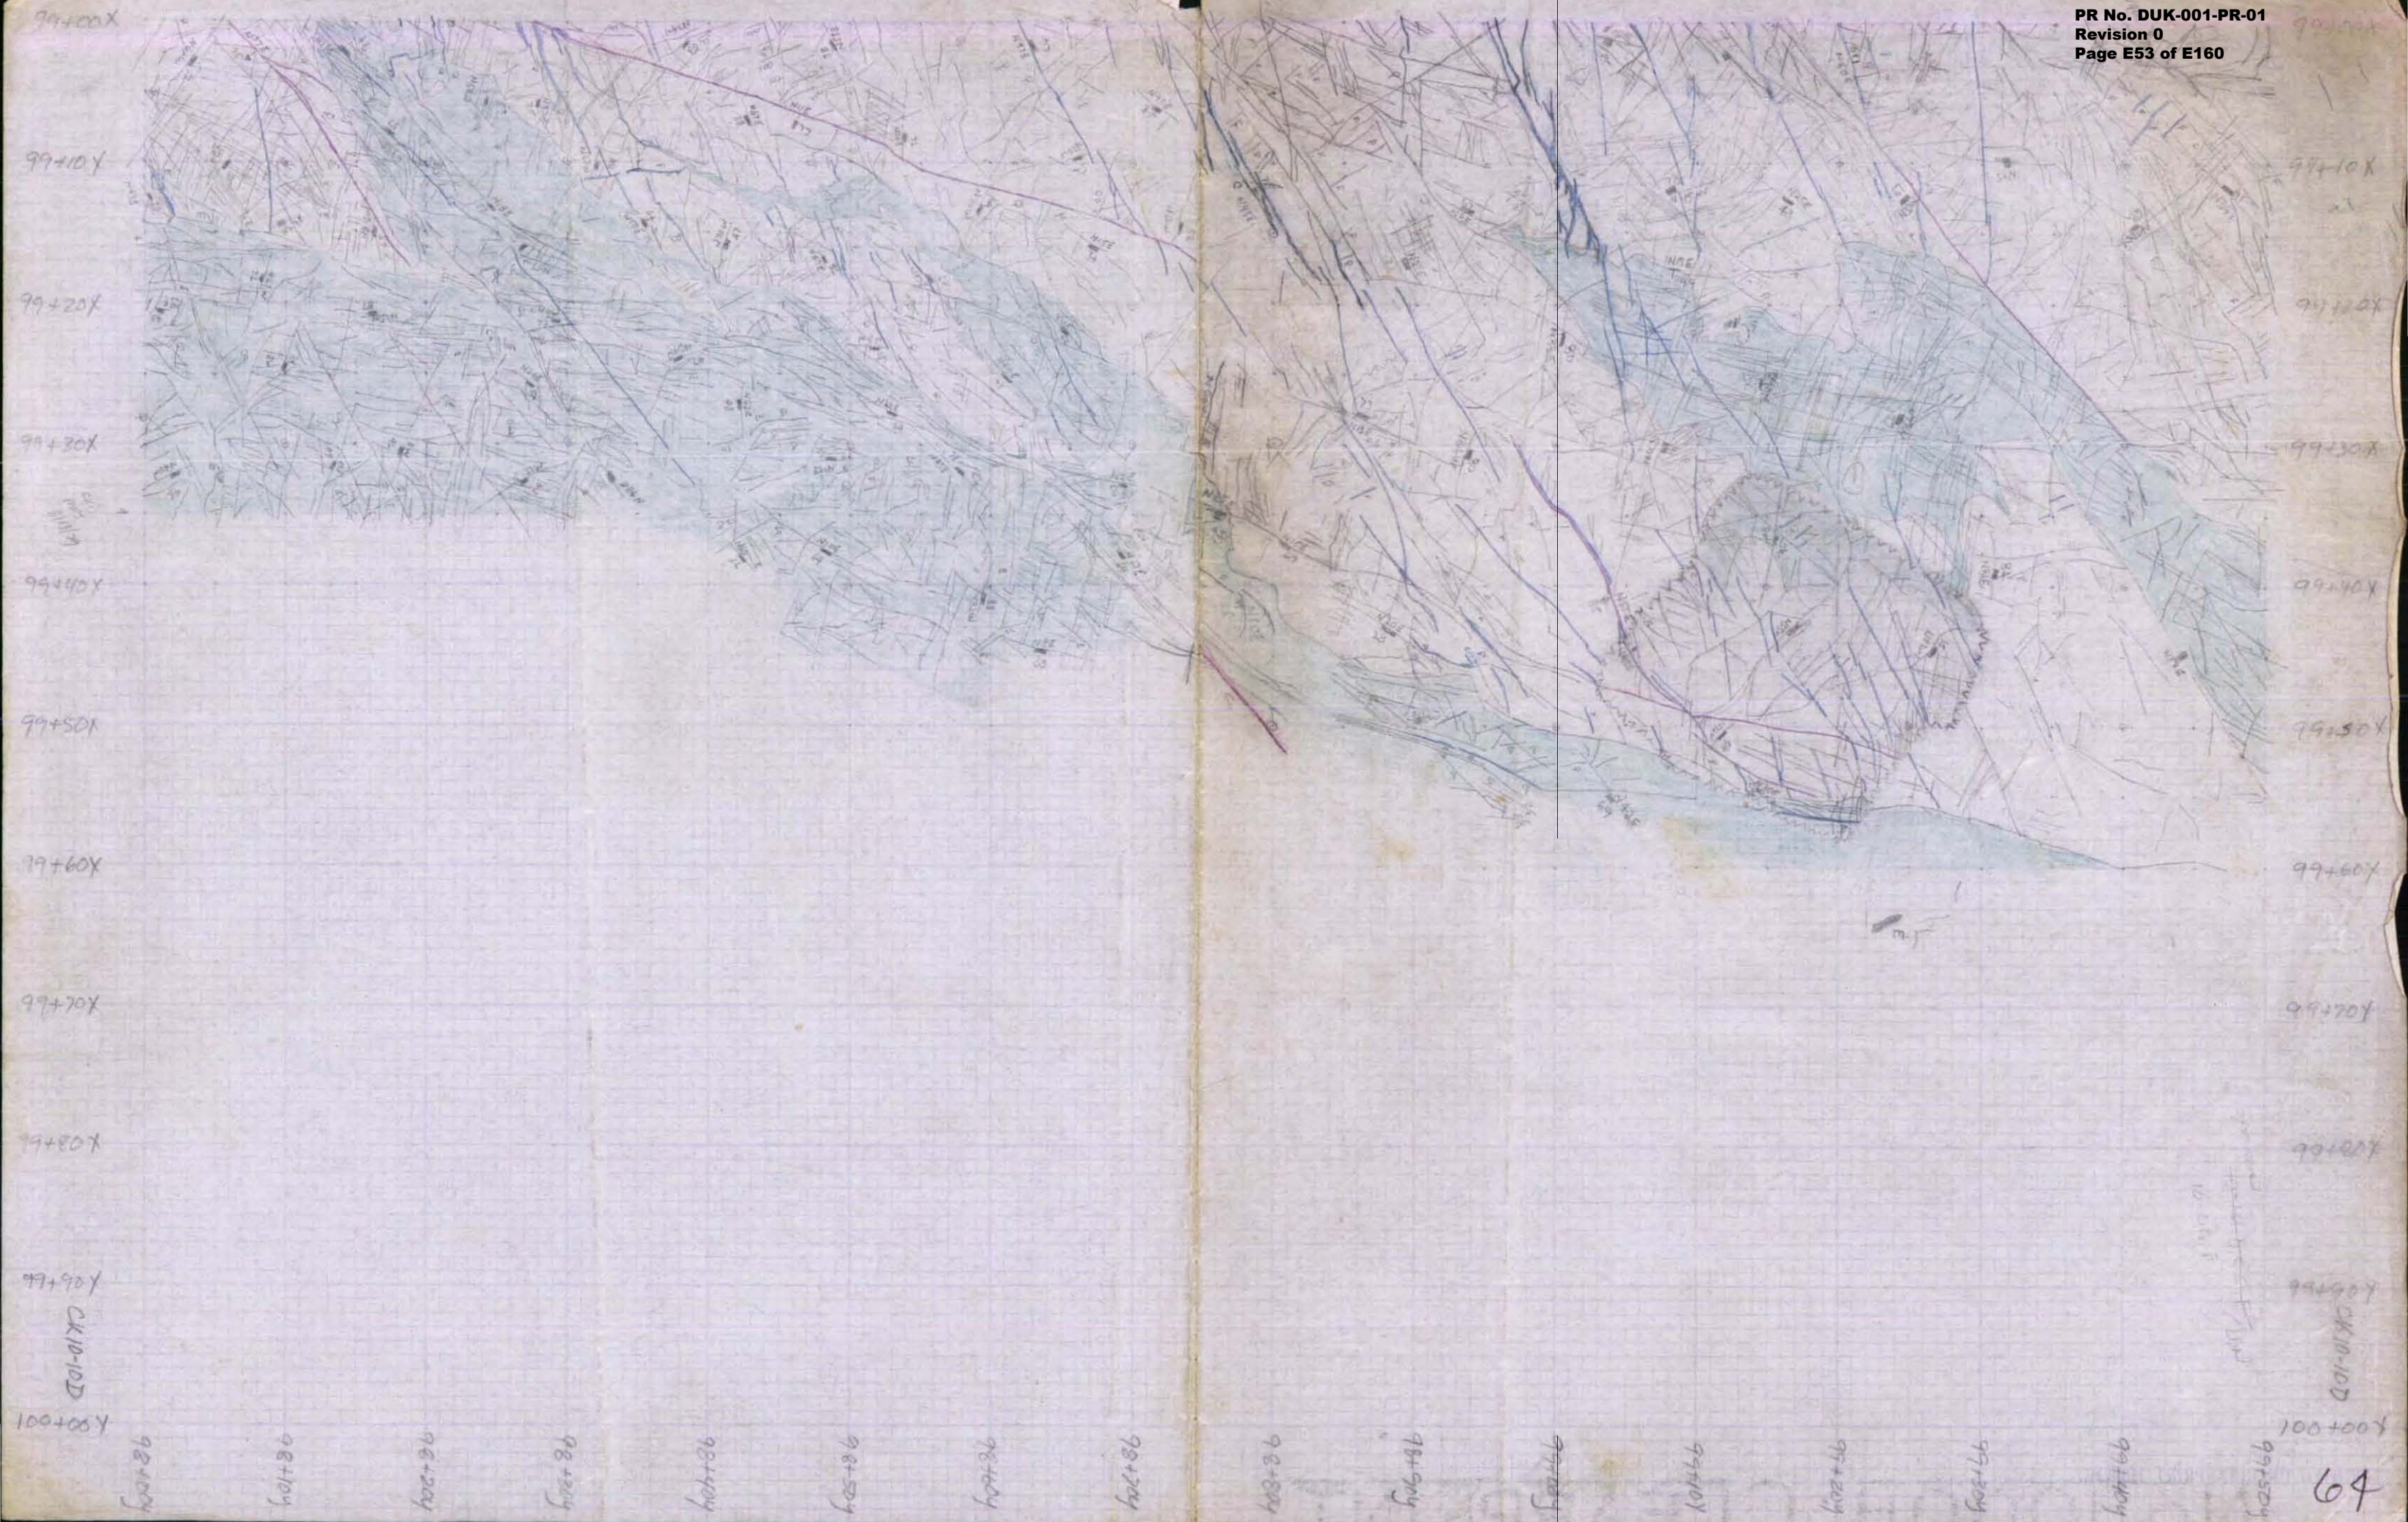

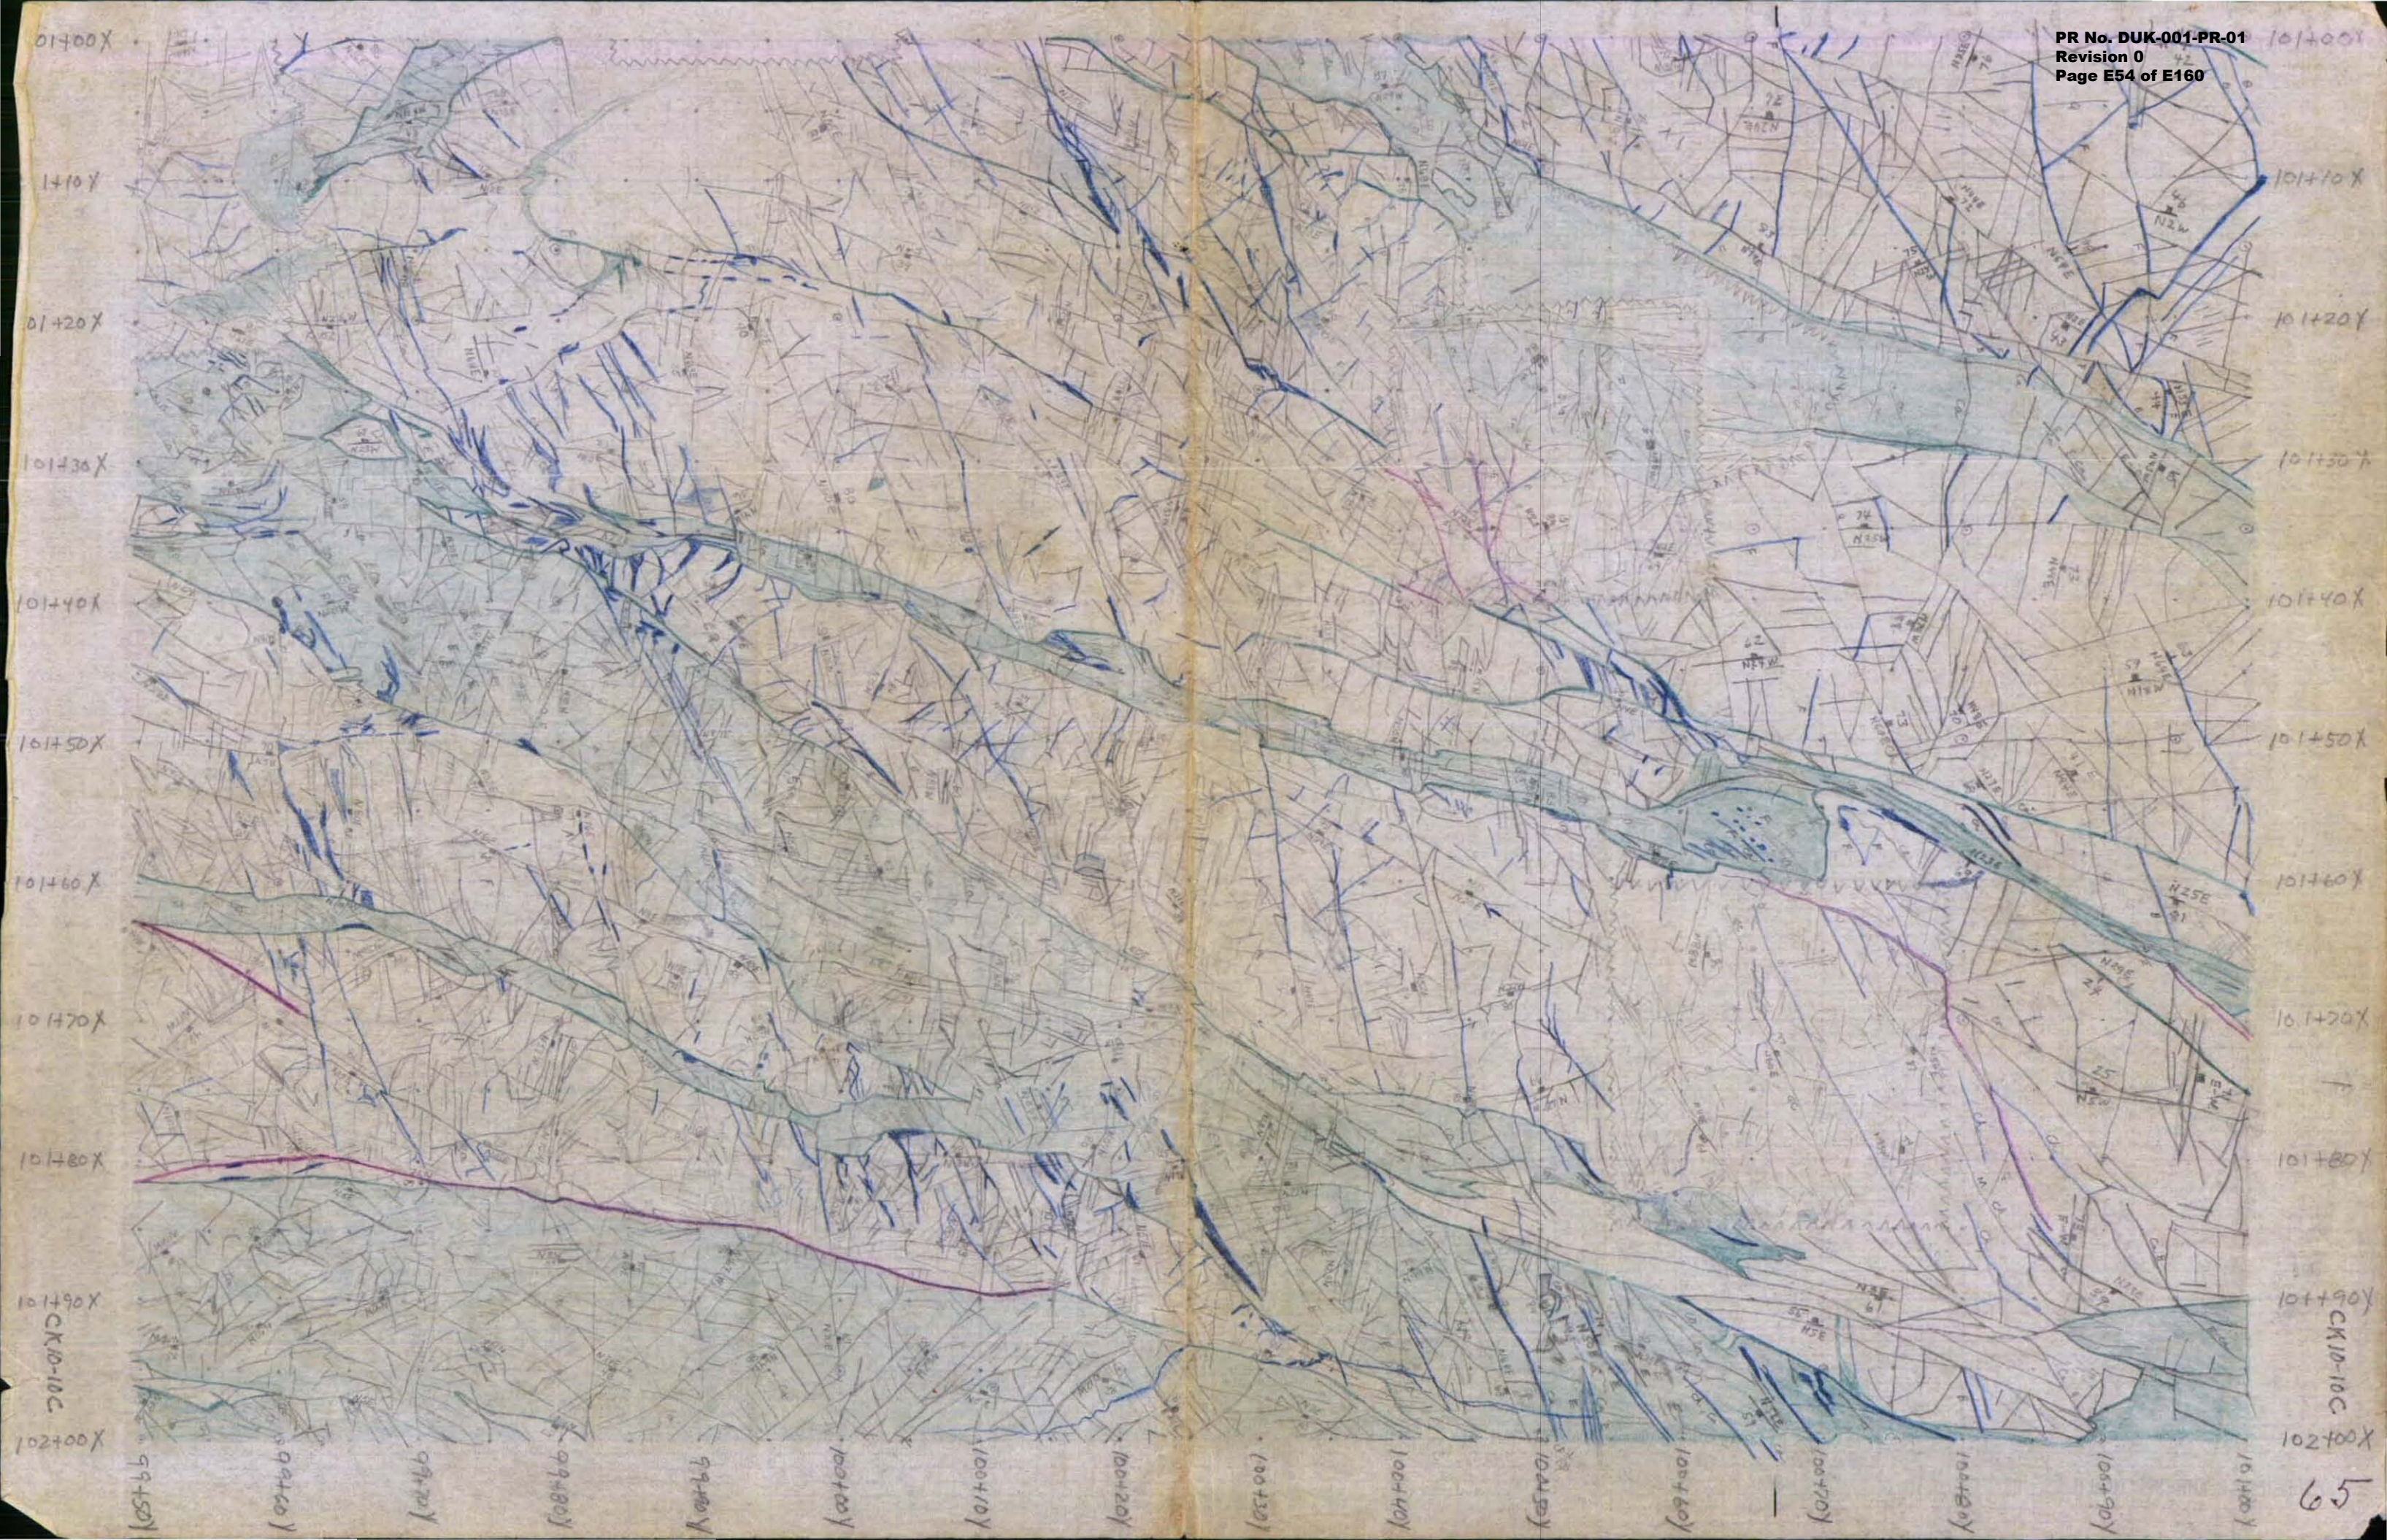

101400X
101410X
101420X
101430X
101440X
101450X
101460X
101470X
101480X
101490X
102+00X

101400X
101410X
101420X
101430X
101440X
101450X
101460X
101470X
101480X
101490X
102+00X

99+50X
99+60X
99+70X
99+80X
99+90X
100+00X
100+10X
100+20X
100+30X
100+40X
100+50X
100+60X
100+70X
100+80X
100+90X
101+00X

CK10-10C


CK10-10C

101+00 X
101+10 X
101+20 X
101+30 X
101+40 X
101+50 X
101+60 X
101+70 X
101+80 X
101+90 X
102+00 X
98+00
98+10
98+20
98+30
98+40
98+50
98+60
98+70
98+80
98+90
99+00
99+10
99+20
99+30
99+40
99+50
99+60
99+70
99+80
99+90
100+00
100+10
100+20
100+30
100+40
100+50
100+60
100+70
100+80
100+90
101+00
101+10
101+20
101+30
101+40
101+50
101+60
101+70
101+80
101+90
102+00




101+00 X
101+10 X
101+20 X
101+30 X
101+40 X
101+50 X
101+60 X
101+70 X
101+80 X
101+90 X
102+00 X
101+00
101+10
101+20
101+30
101+40
101+50
101+60
101+70
101+80
101+90
102+00
66



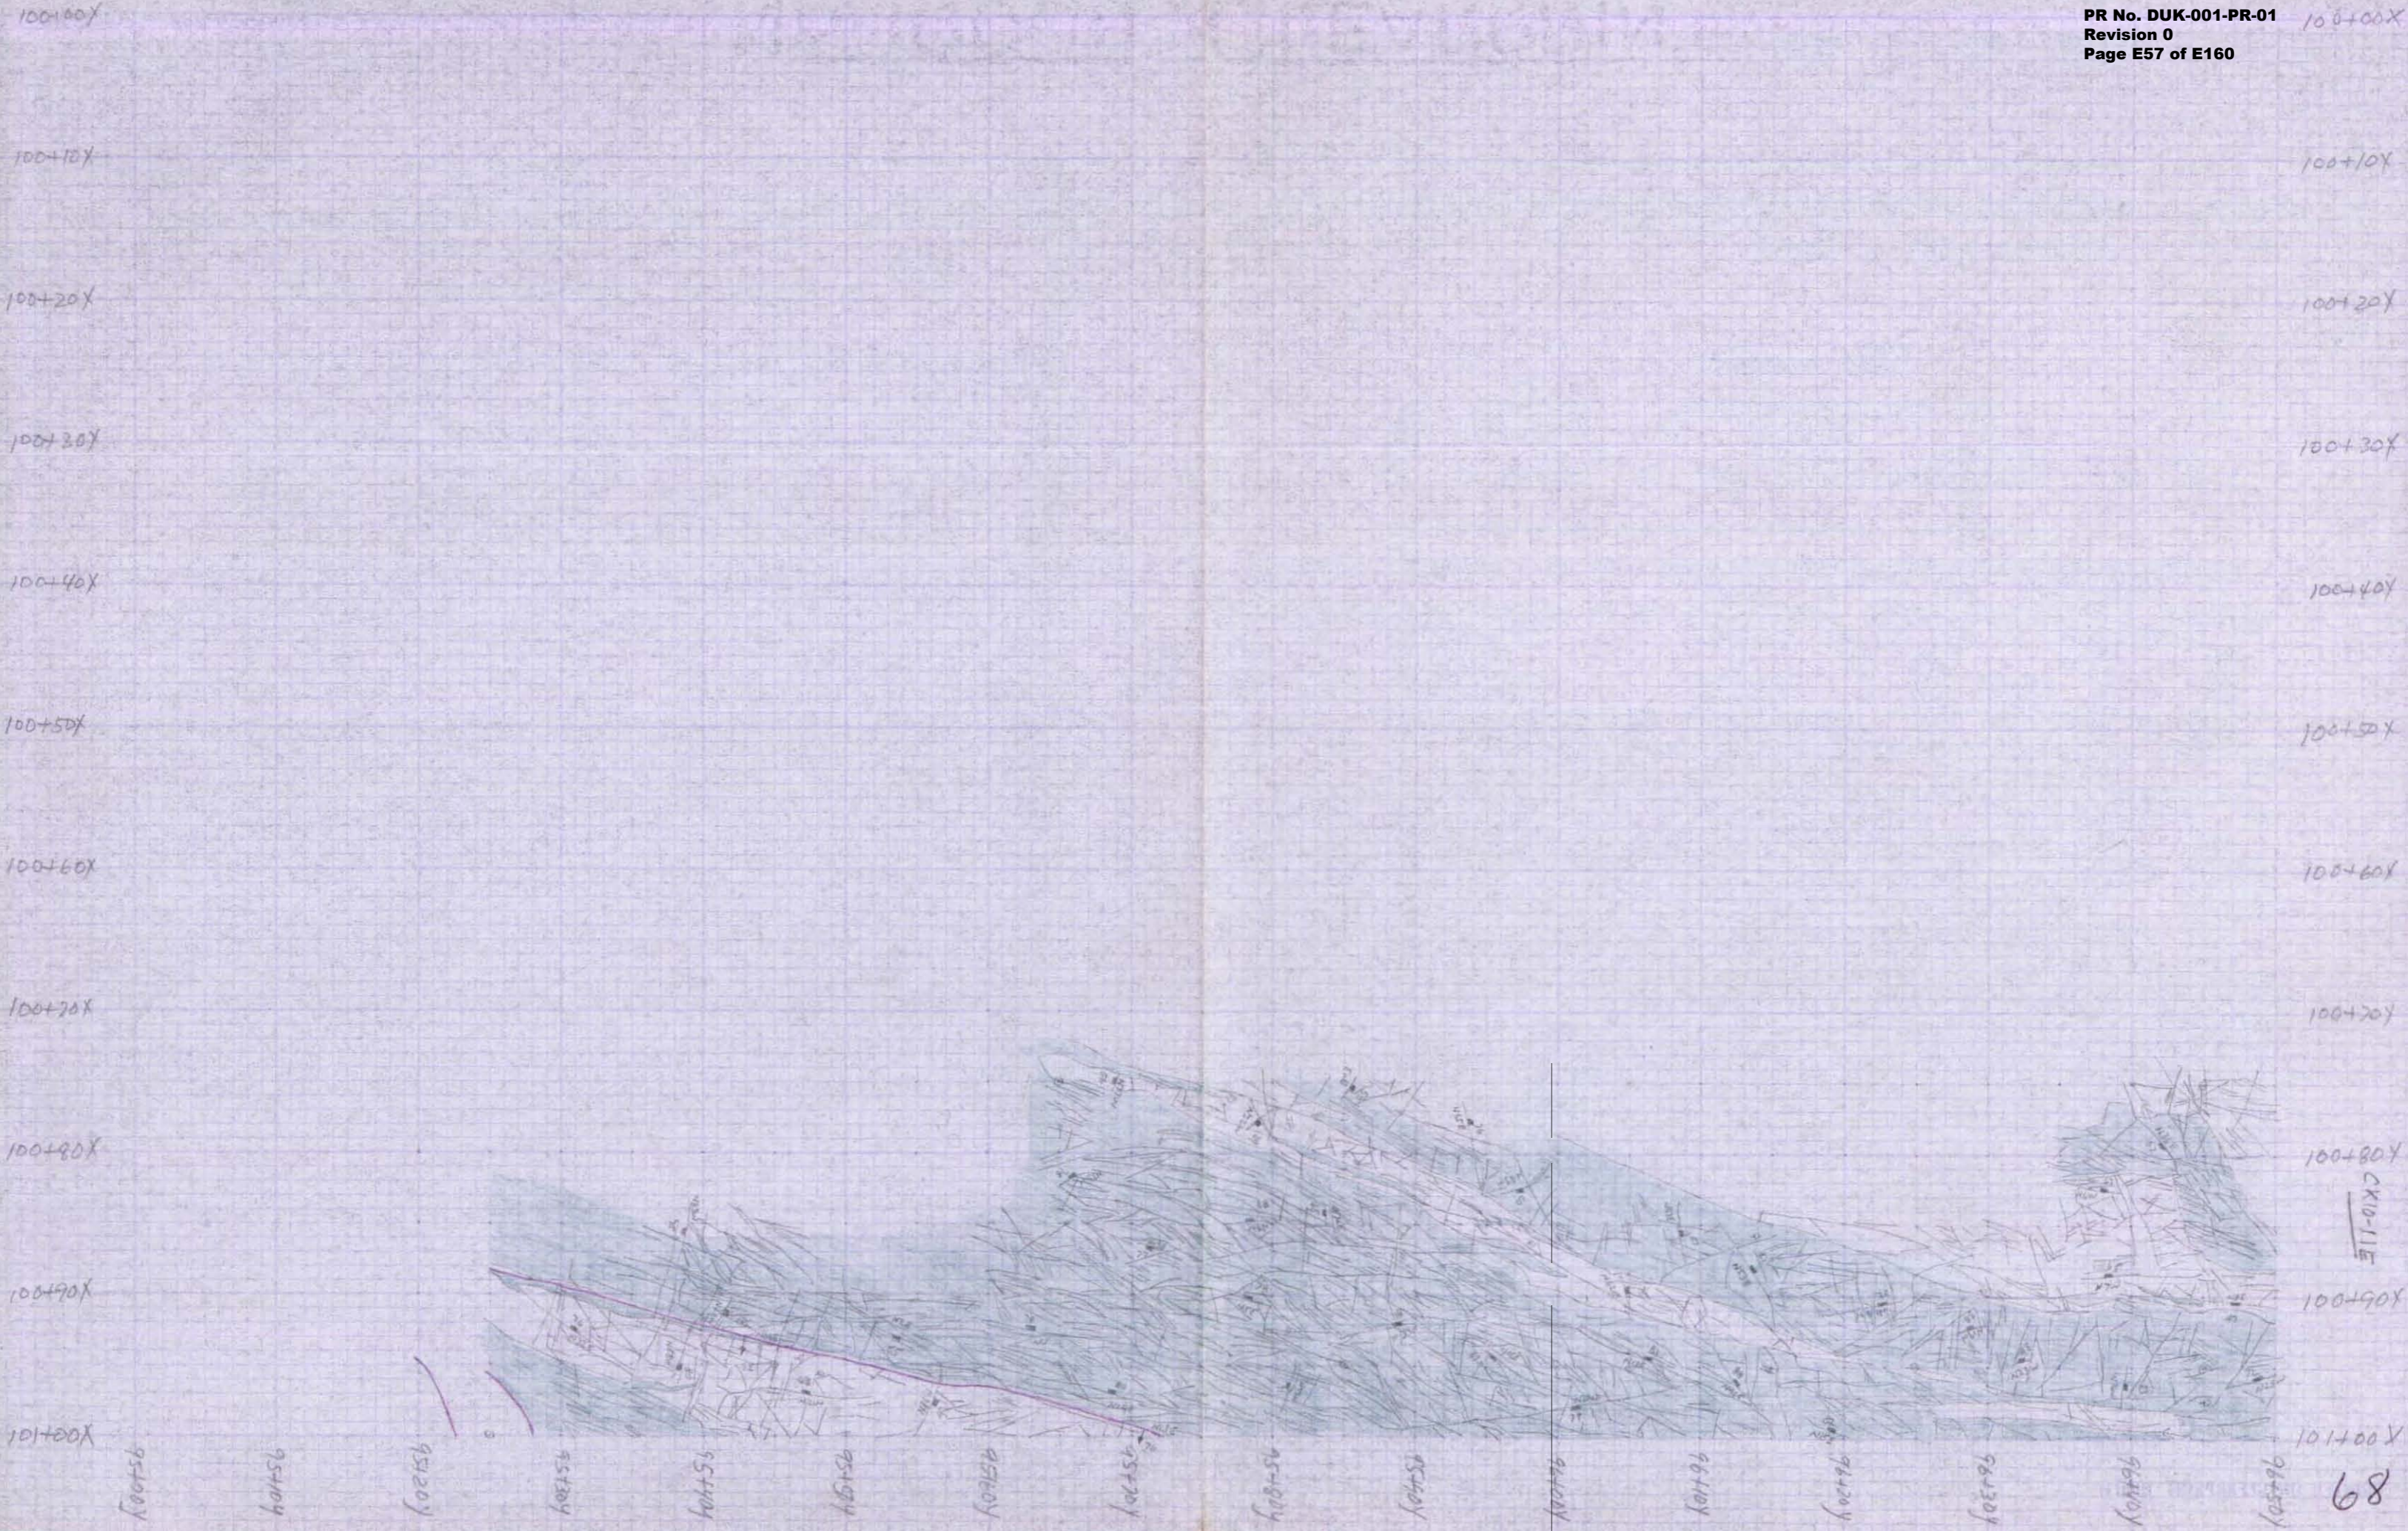

CR10-11E

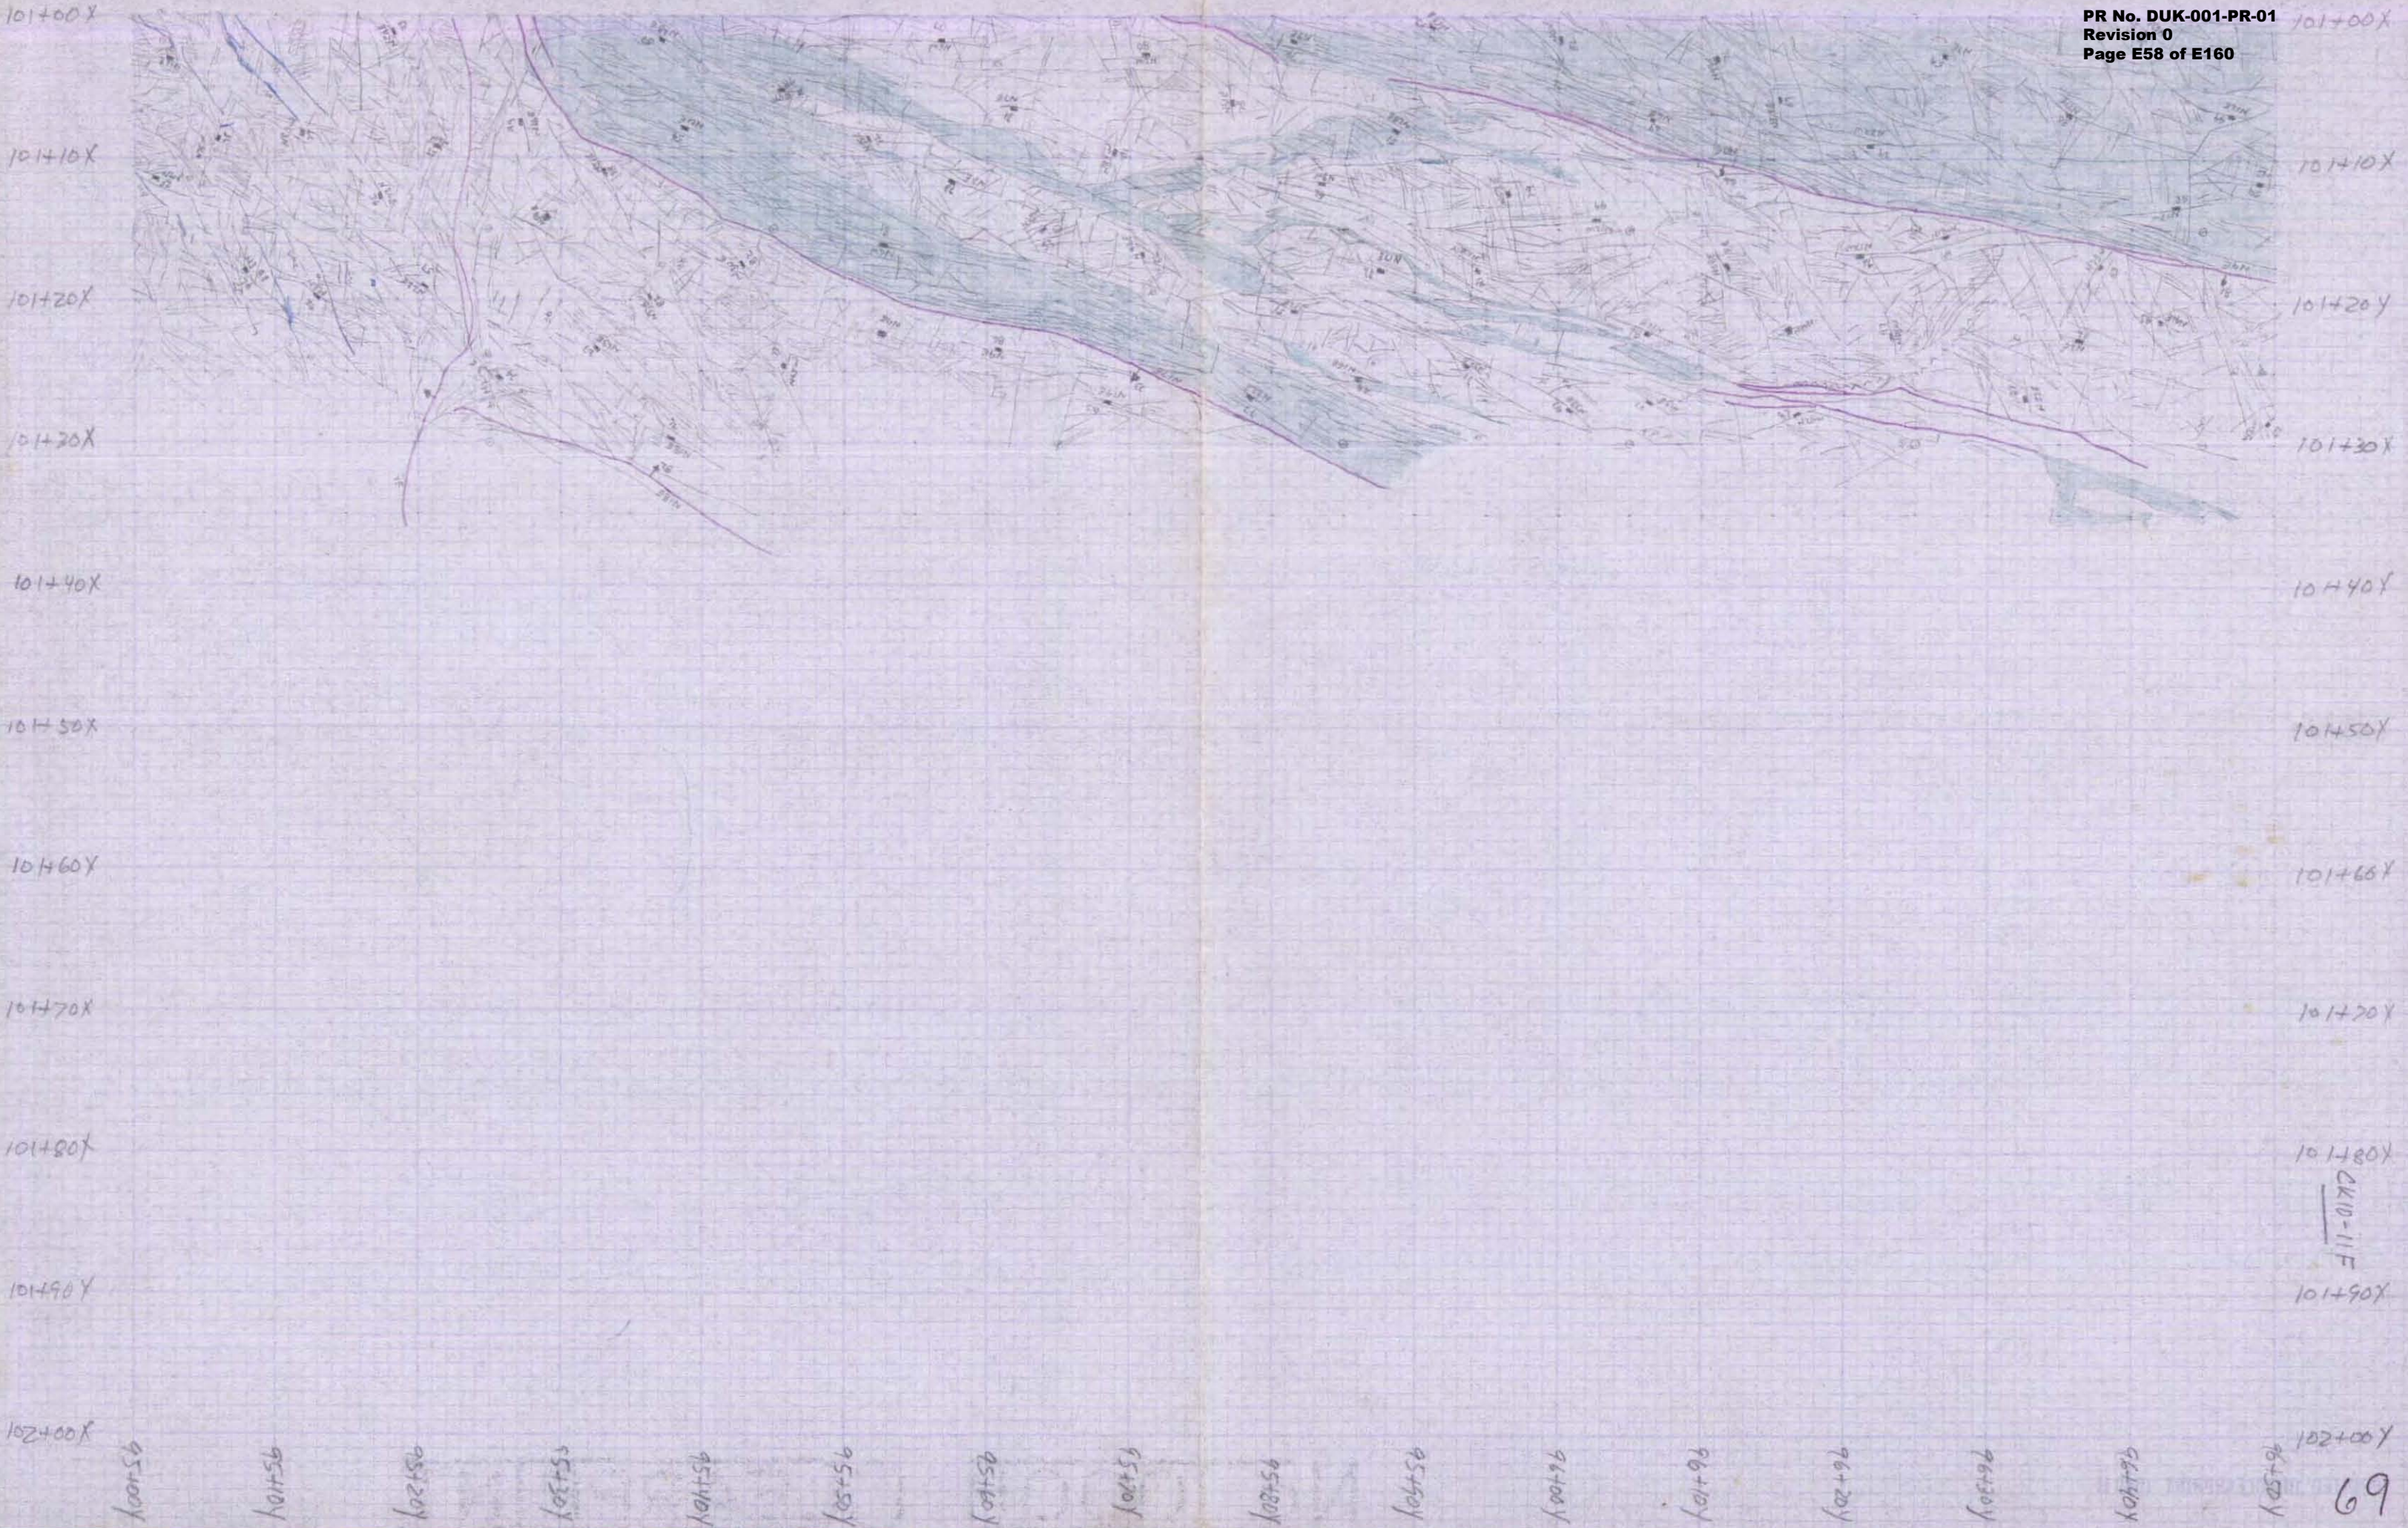

101+00X

101+10X

101+20X

101+30X

101+40X

101+50X

101+60X

101+70X

101+80X

101+90X

102+00X

101+00X

101+10X

101+20X

101+30X

101+40X

101+50X

101+60X

101+70X

101+80X

101+90X

102+00X

2410-11F

69

95+50Y

95+60Y

95+70Y

95+80Y

95+90Y

96+00Y

96+10Y



96+20Y

96+30Y


96+40Y


96+50Y

96+50Y

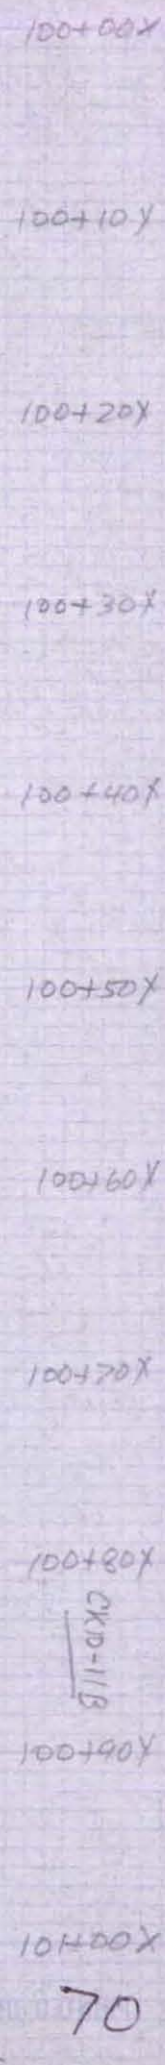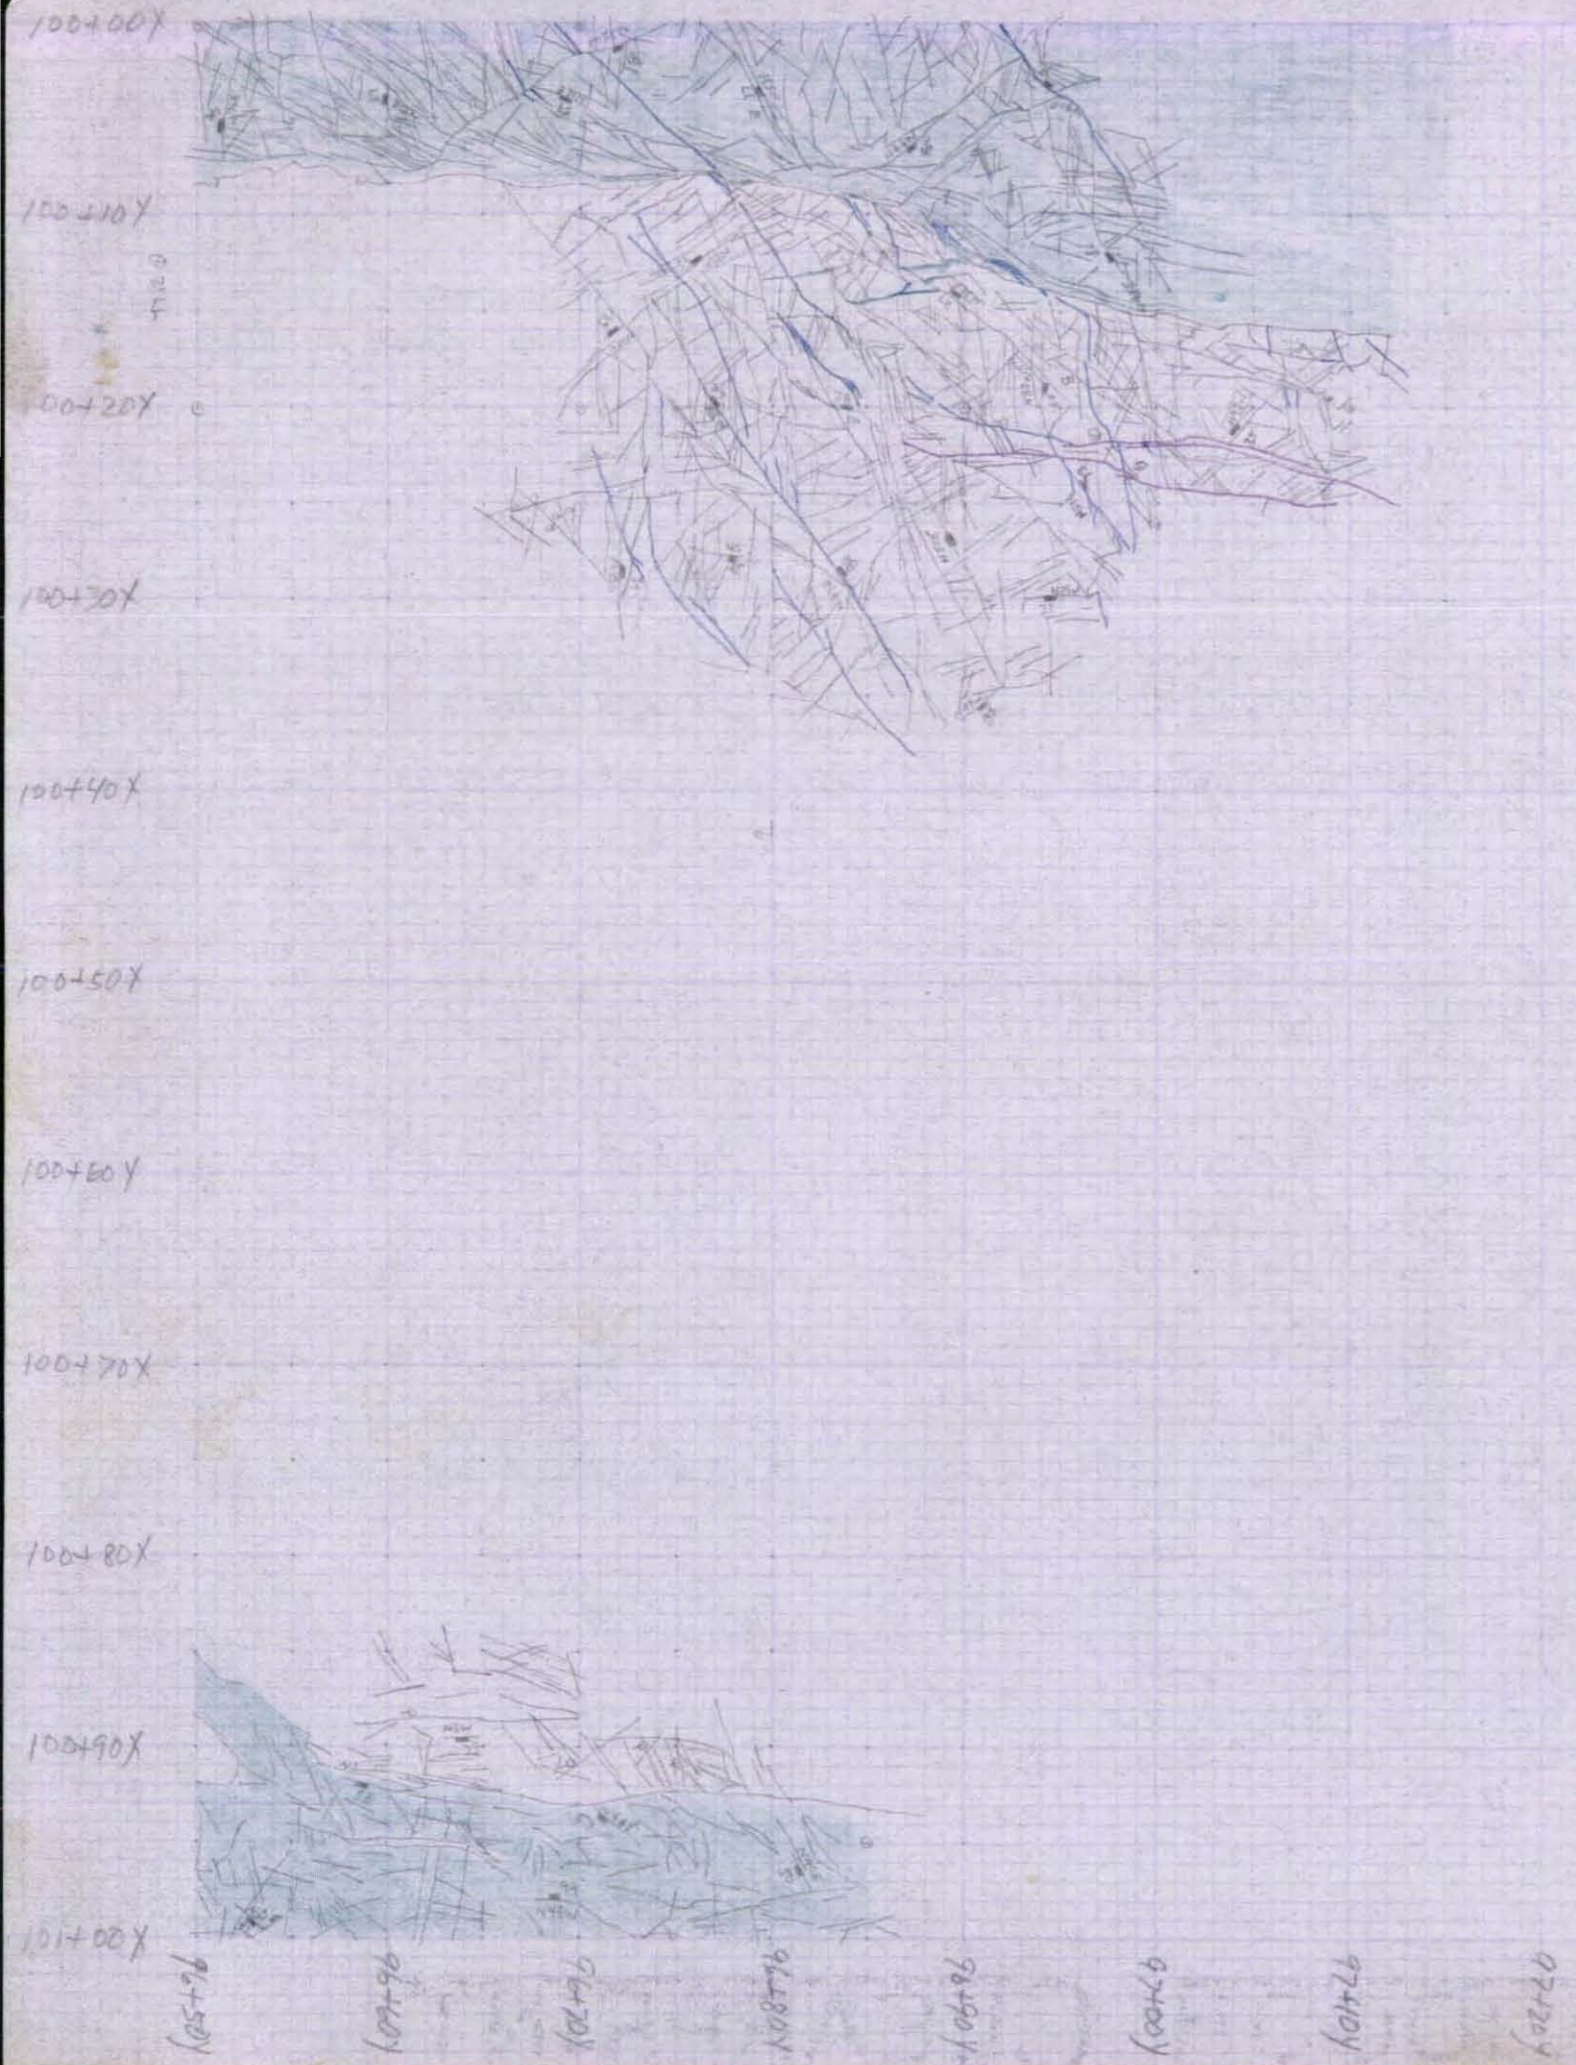

70

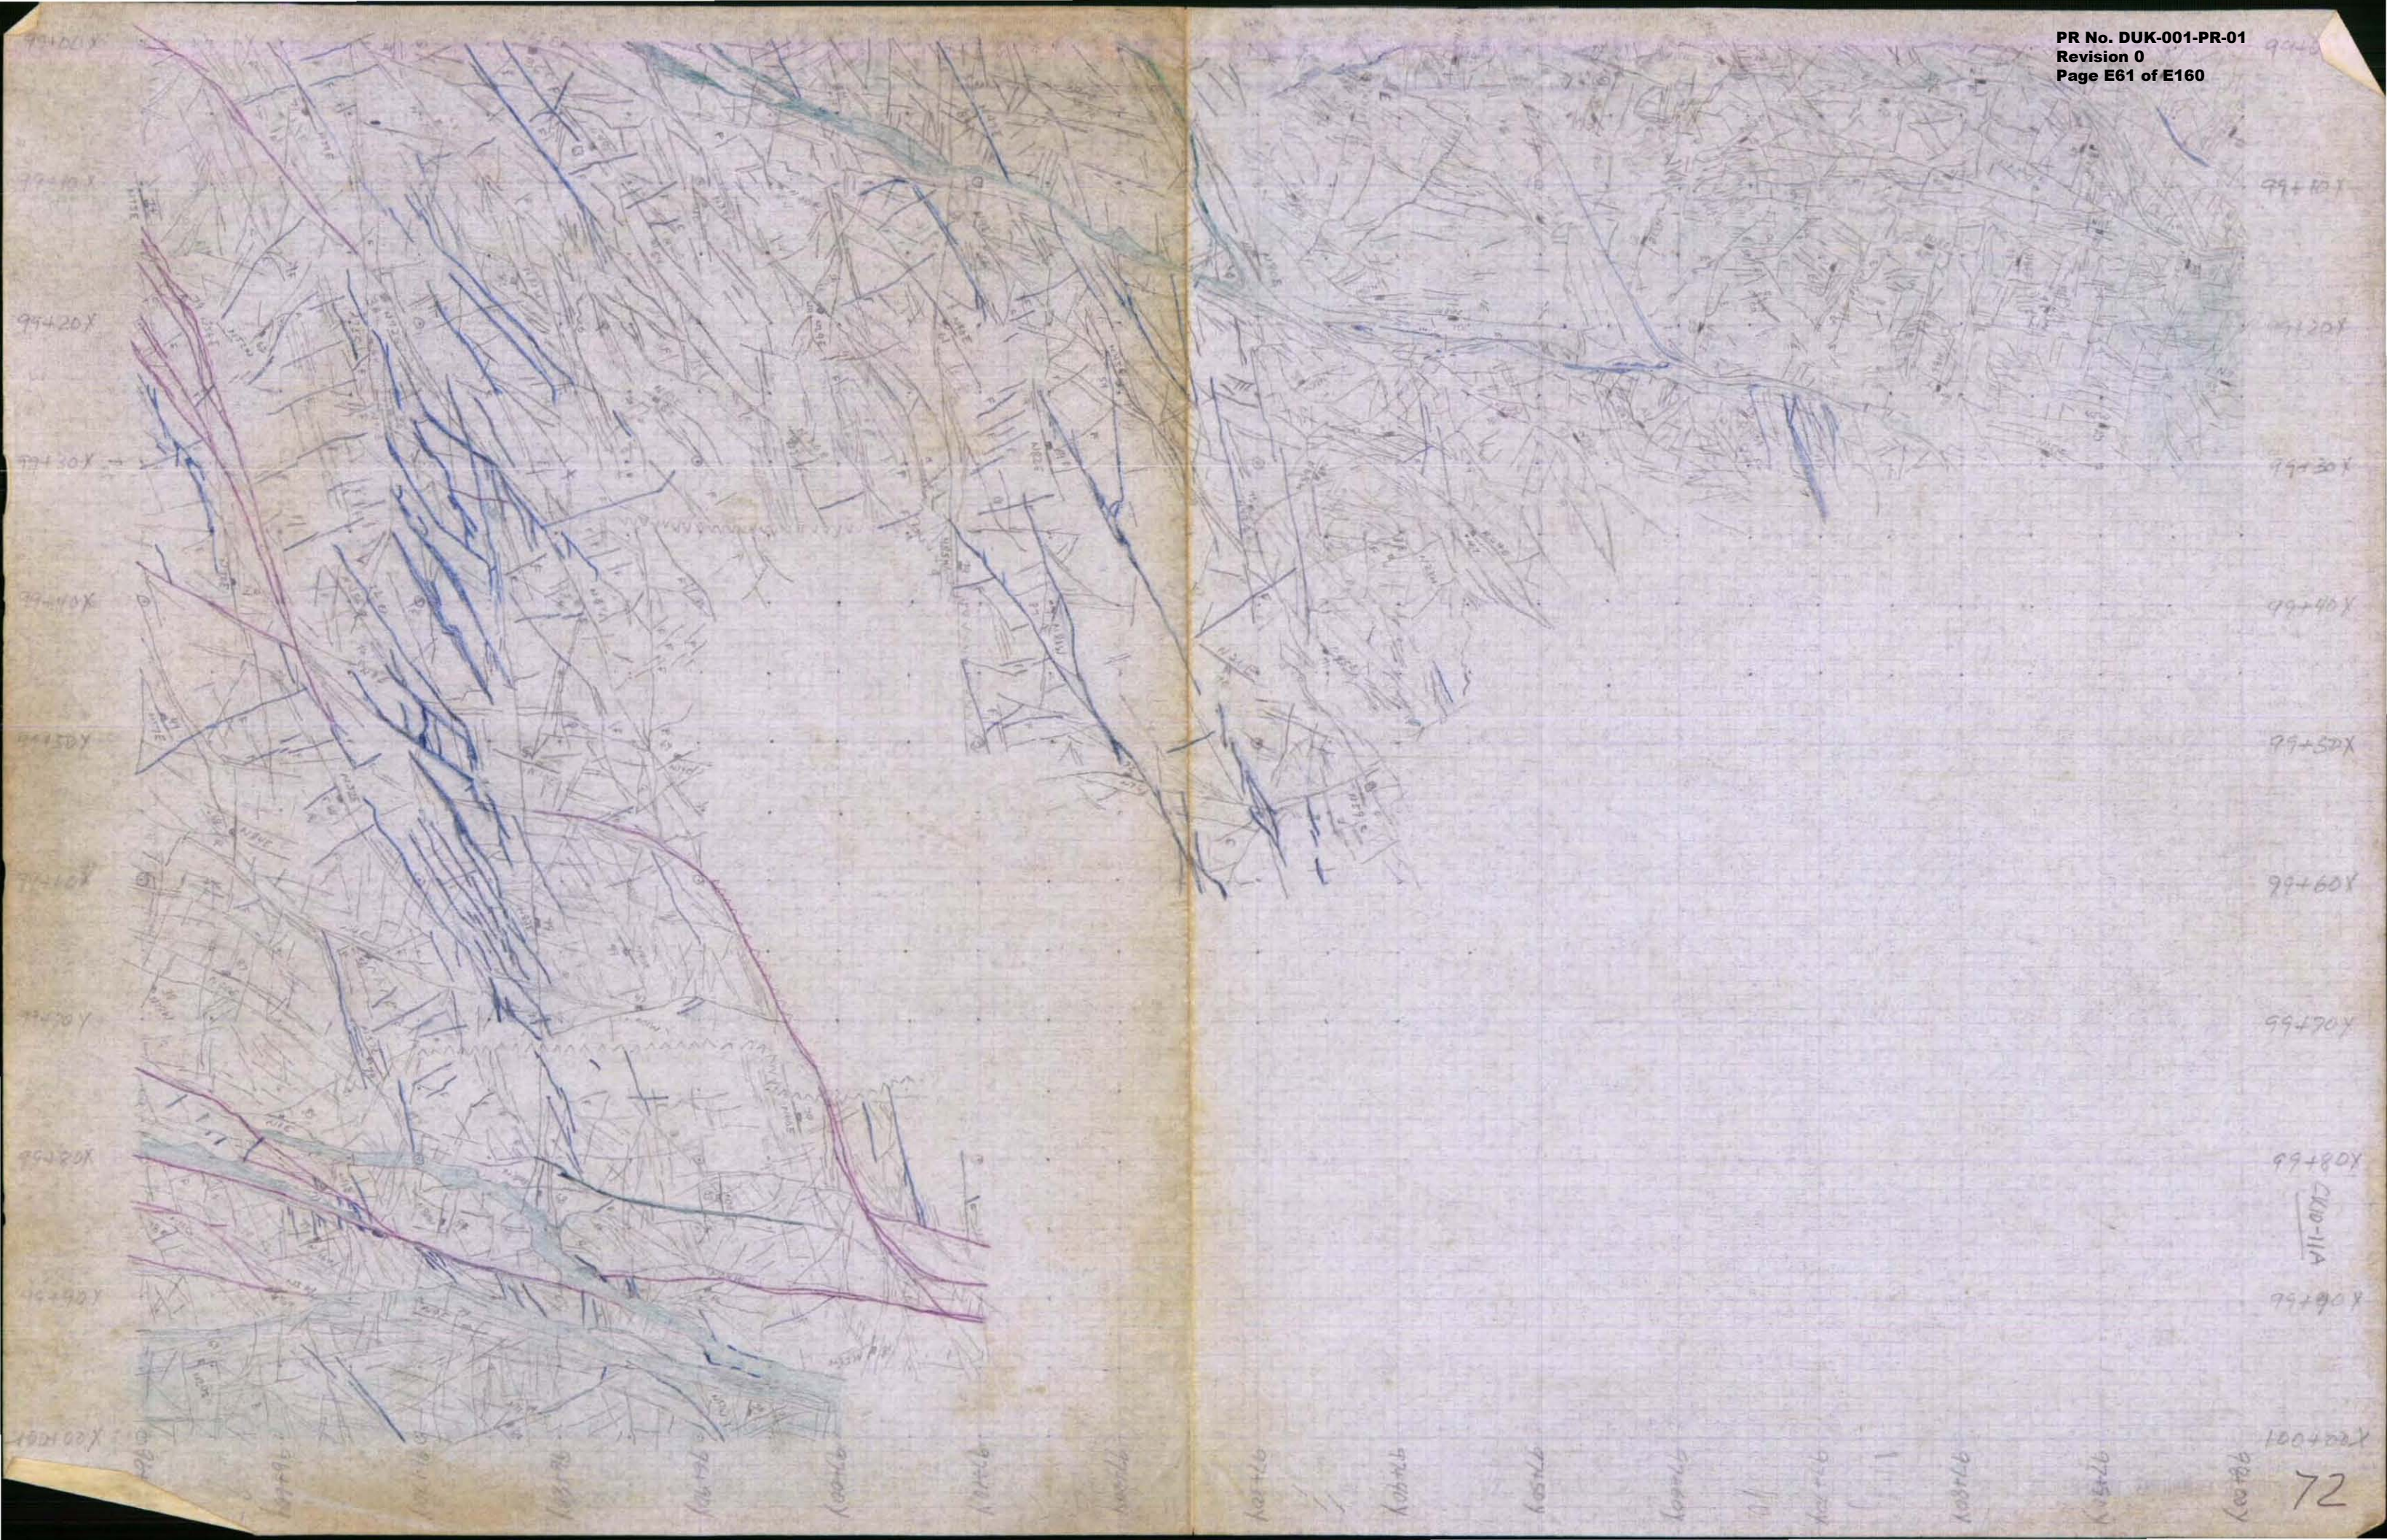

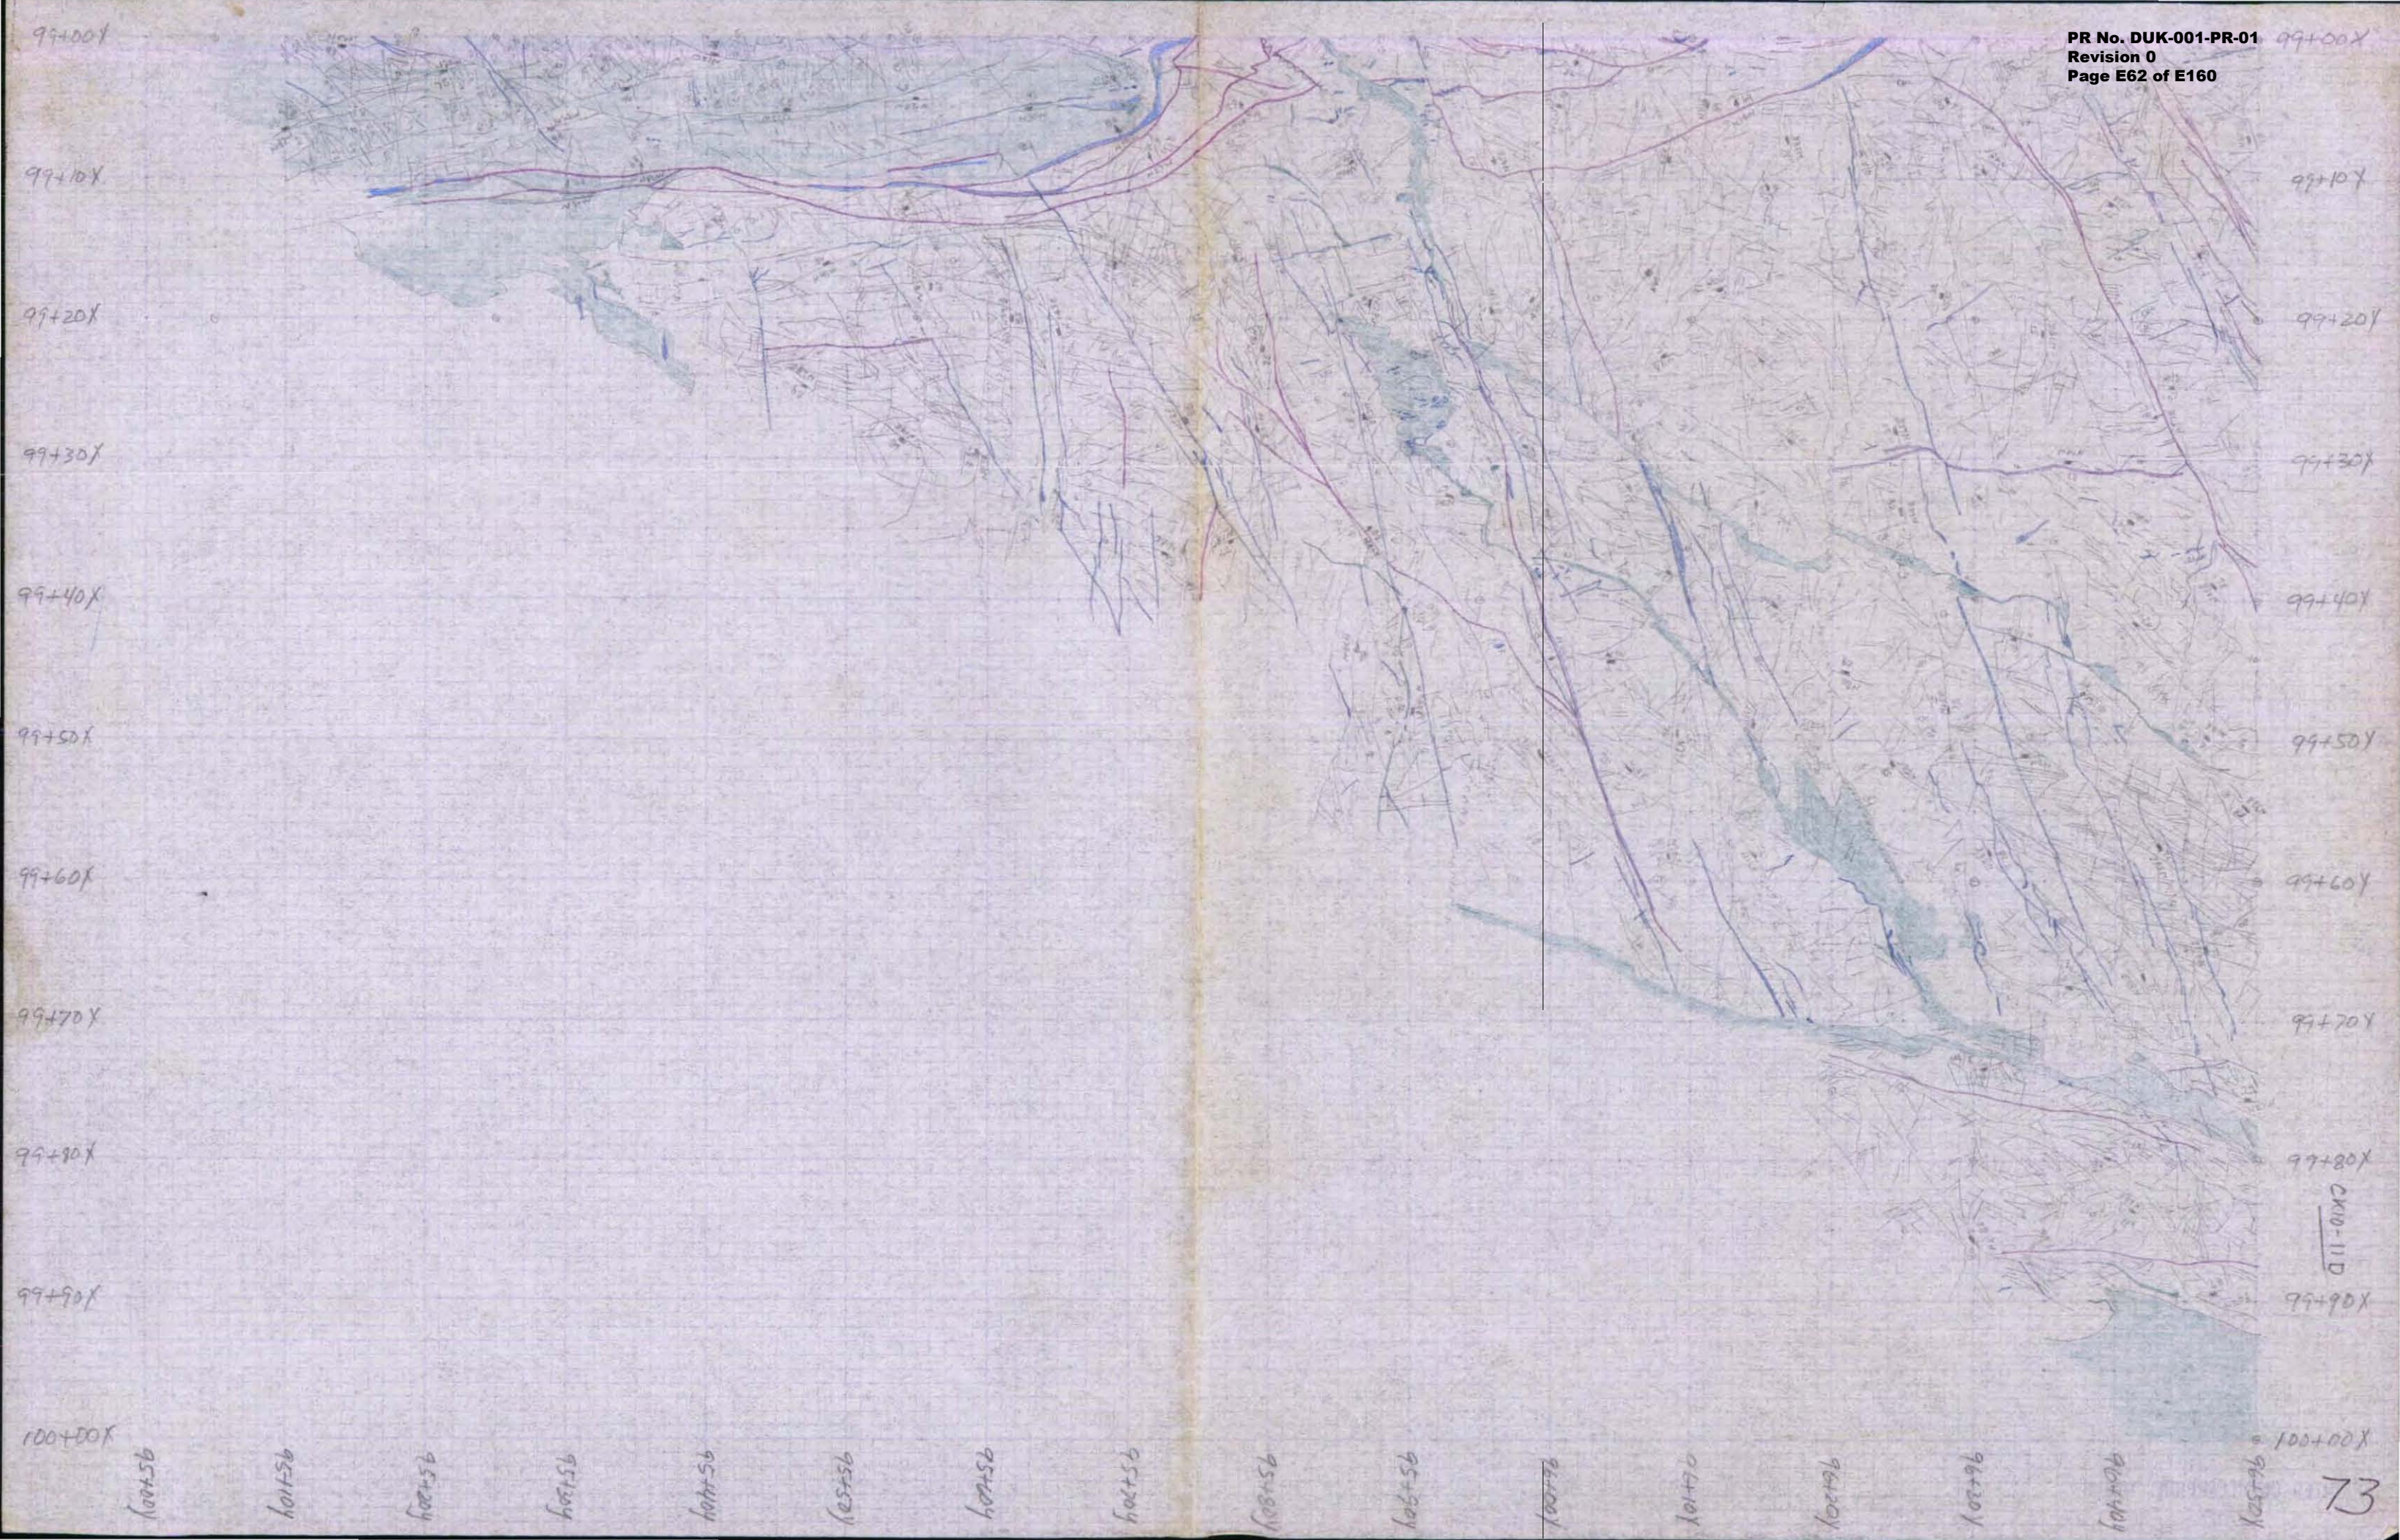

99+00X

99+10X

99+20X

99+30X

99+40X

99+50X

99+60X

99+70X

99+80X

99+90X

100+00X

99+00X

99+10X

99+20X

99+30X

99+40X

99+50X

99+60X

99+70X

99+80X

99+90X

100+00X

100+50

101+00

101+50

102+00

102+50

103+00

103+50

104+00

104+50

105+00

105+50

106+00


106+50

107+00

107+50

108+00

CRD-11D

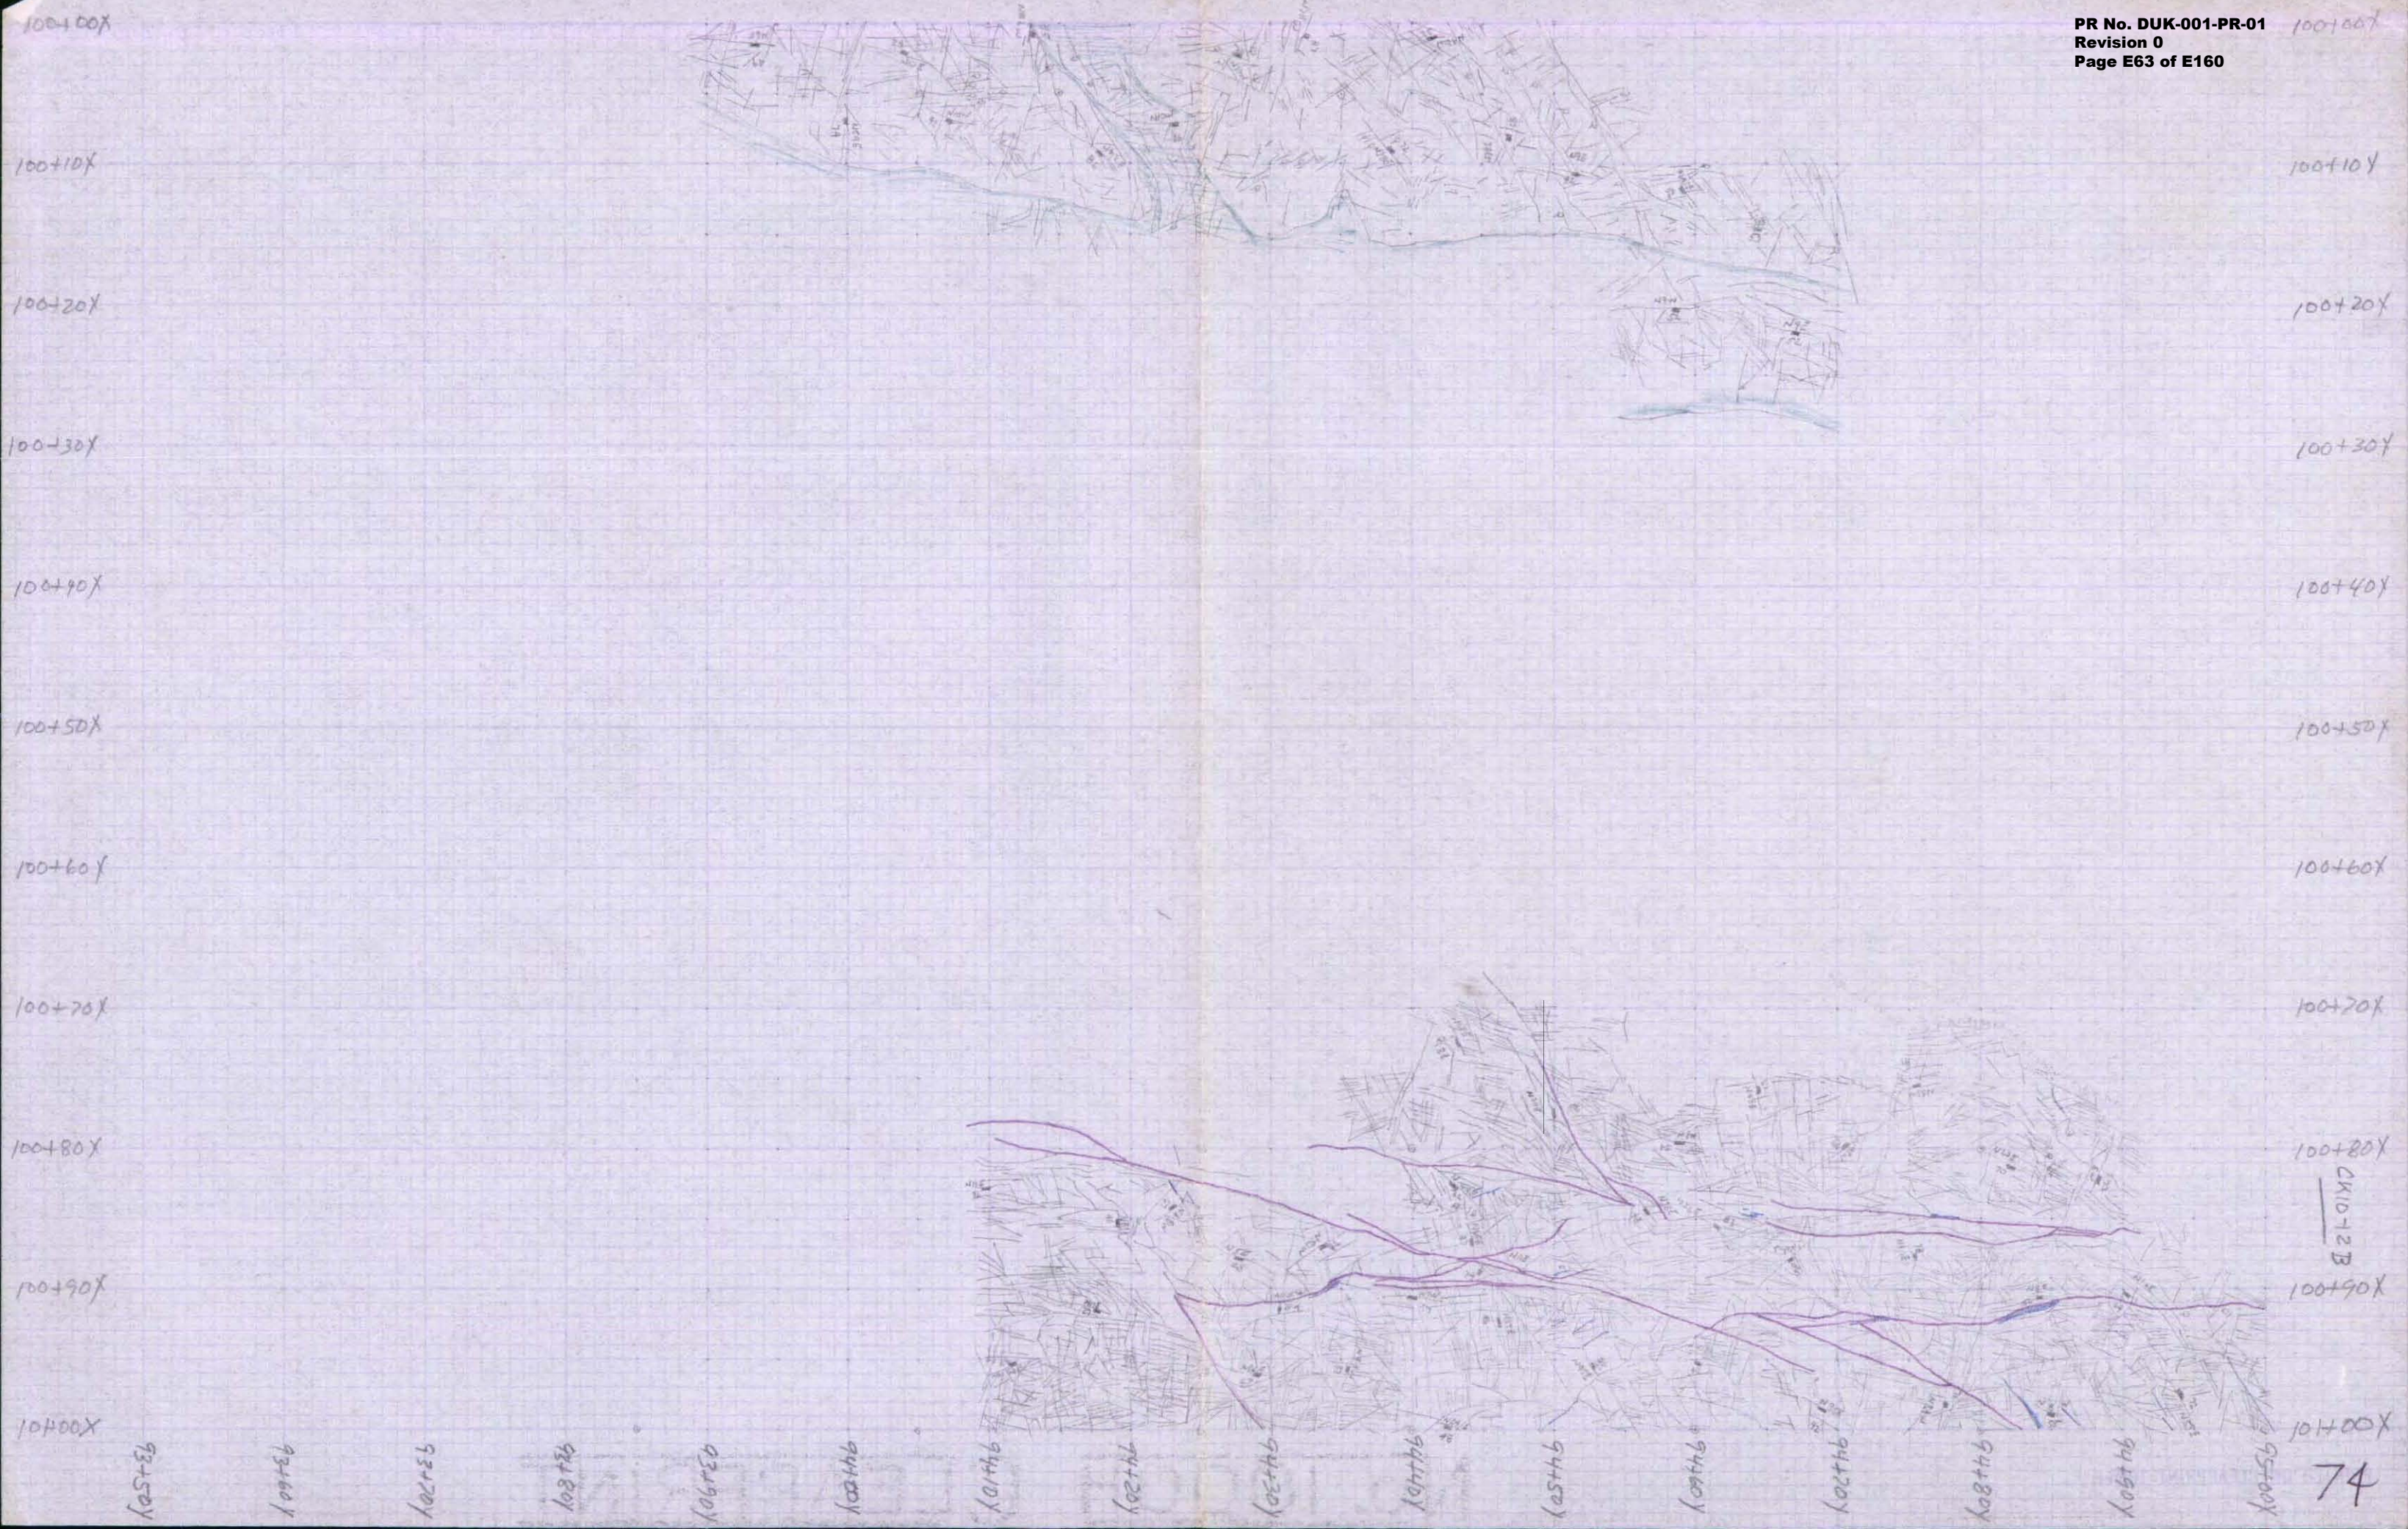

100+00x

100+10x

100+20x

100+30x

100+40x

100+50x

100+60x

100+70x

100+80x

100+90x

100+00x

74

100+00x

100+10x

100+20x

100+30x

100+40x

100+50x

100+60x

100+70x


100+80x

100+90x


100+00x

93+50x
93+60x
93+70x
93+80x
93+90x
94+00x
94+10x
94+20x
94+30x
94+40x
94+50x
94+60x
94+70x
94+80x
94+90x
95+00x

GRID 12 B

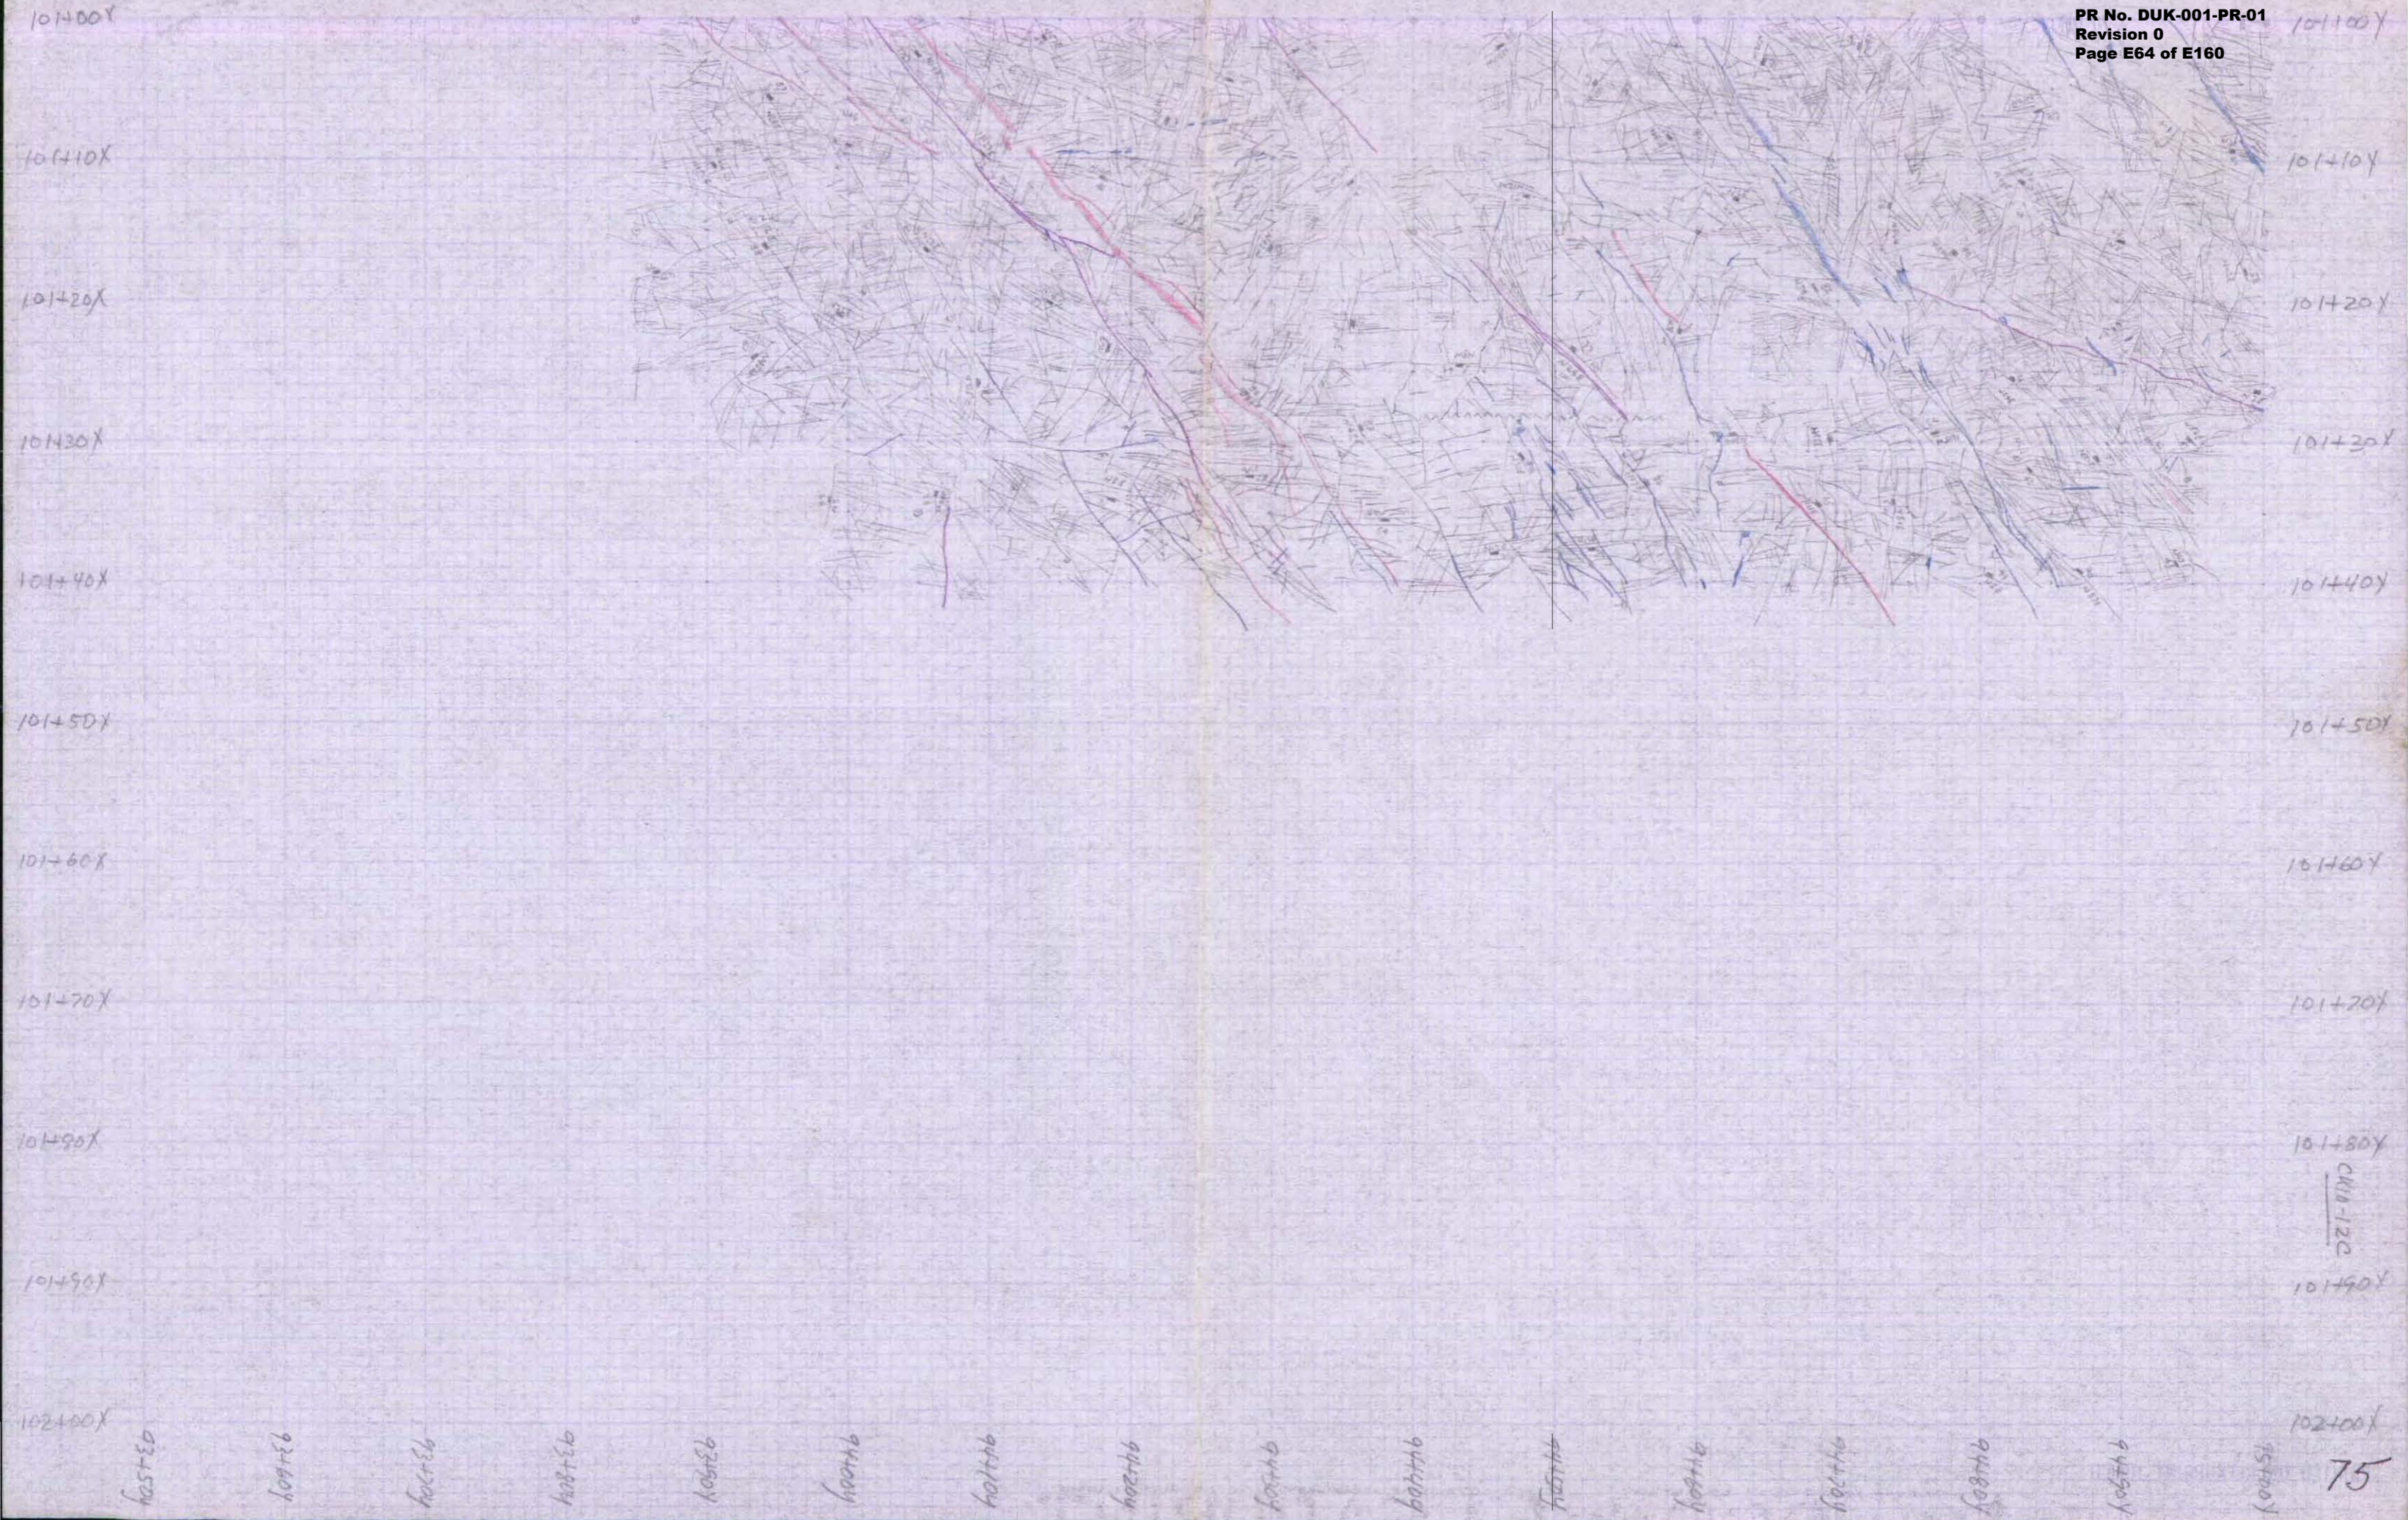

CW10-120

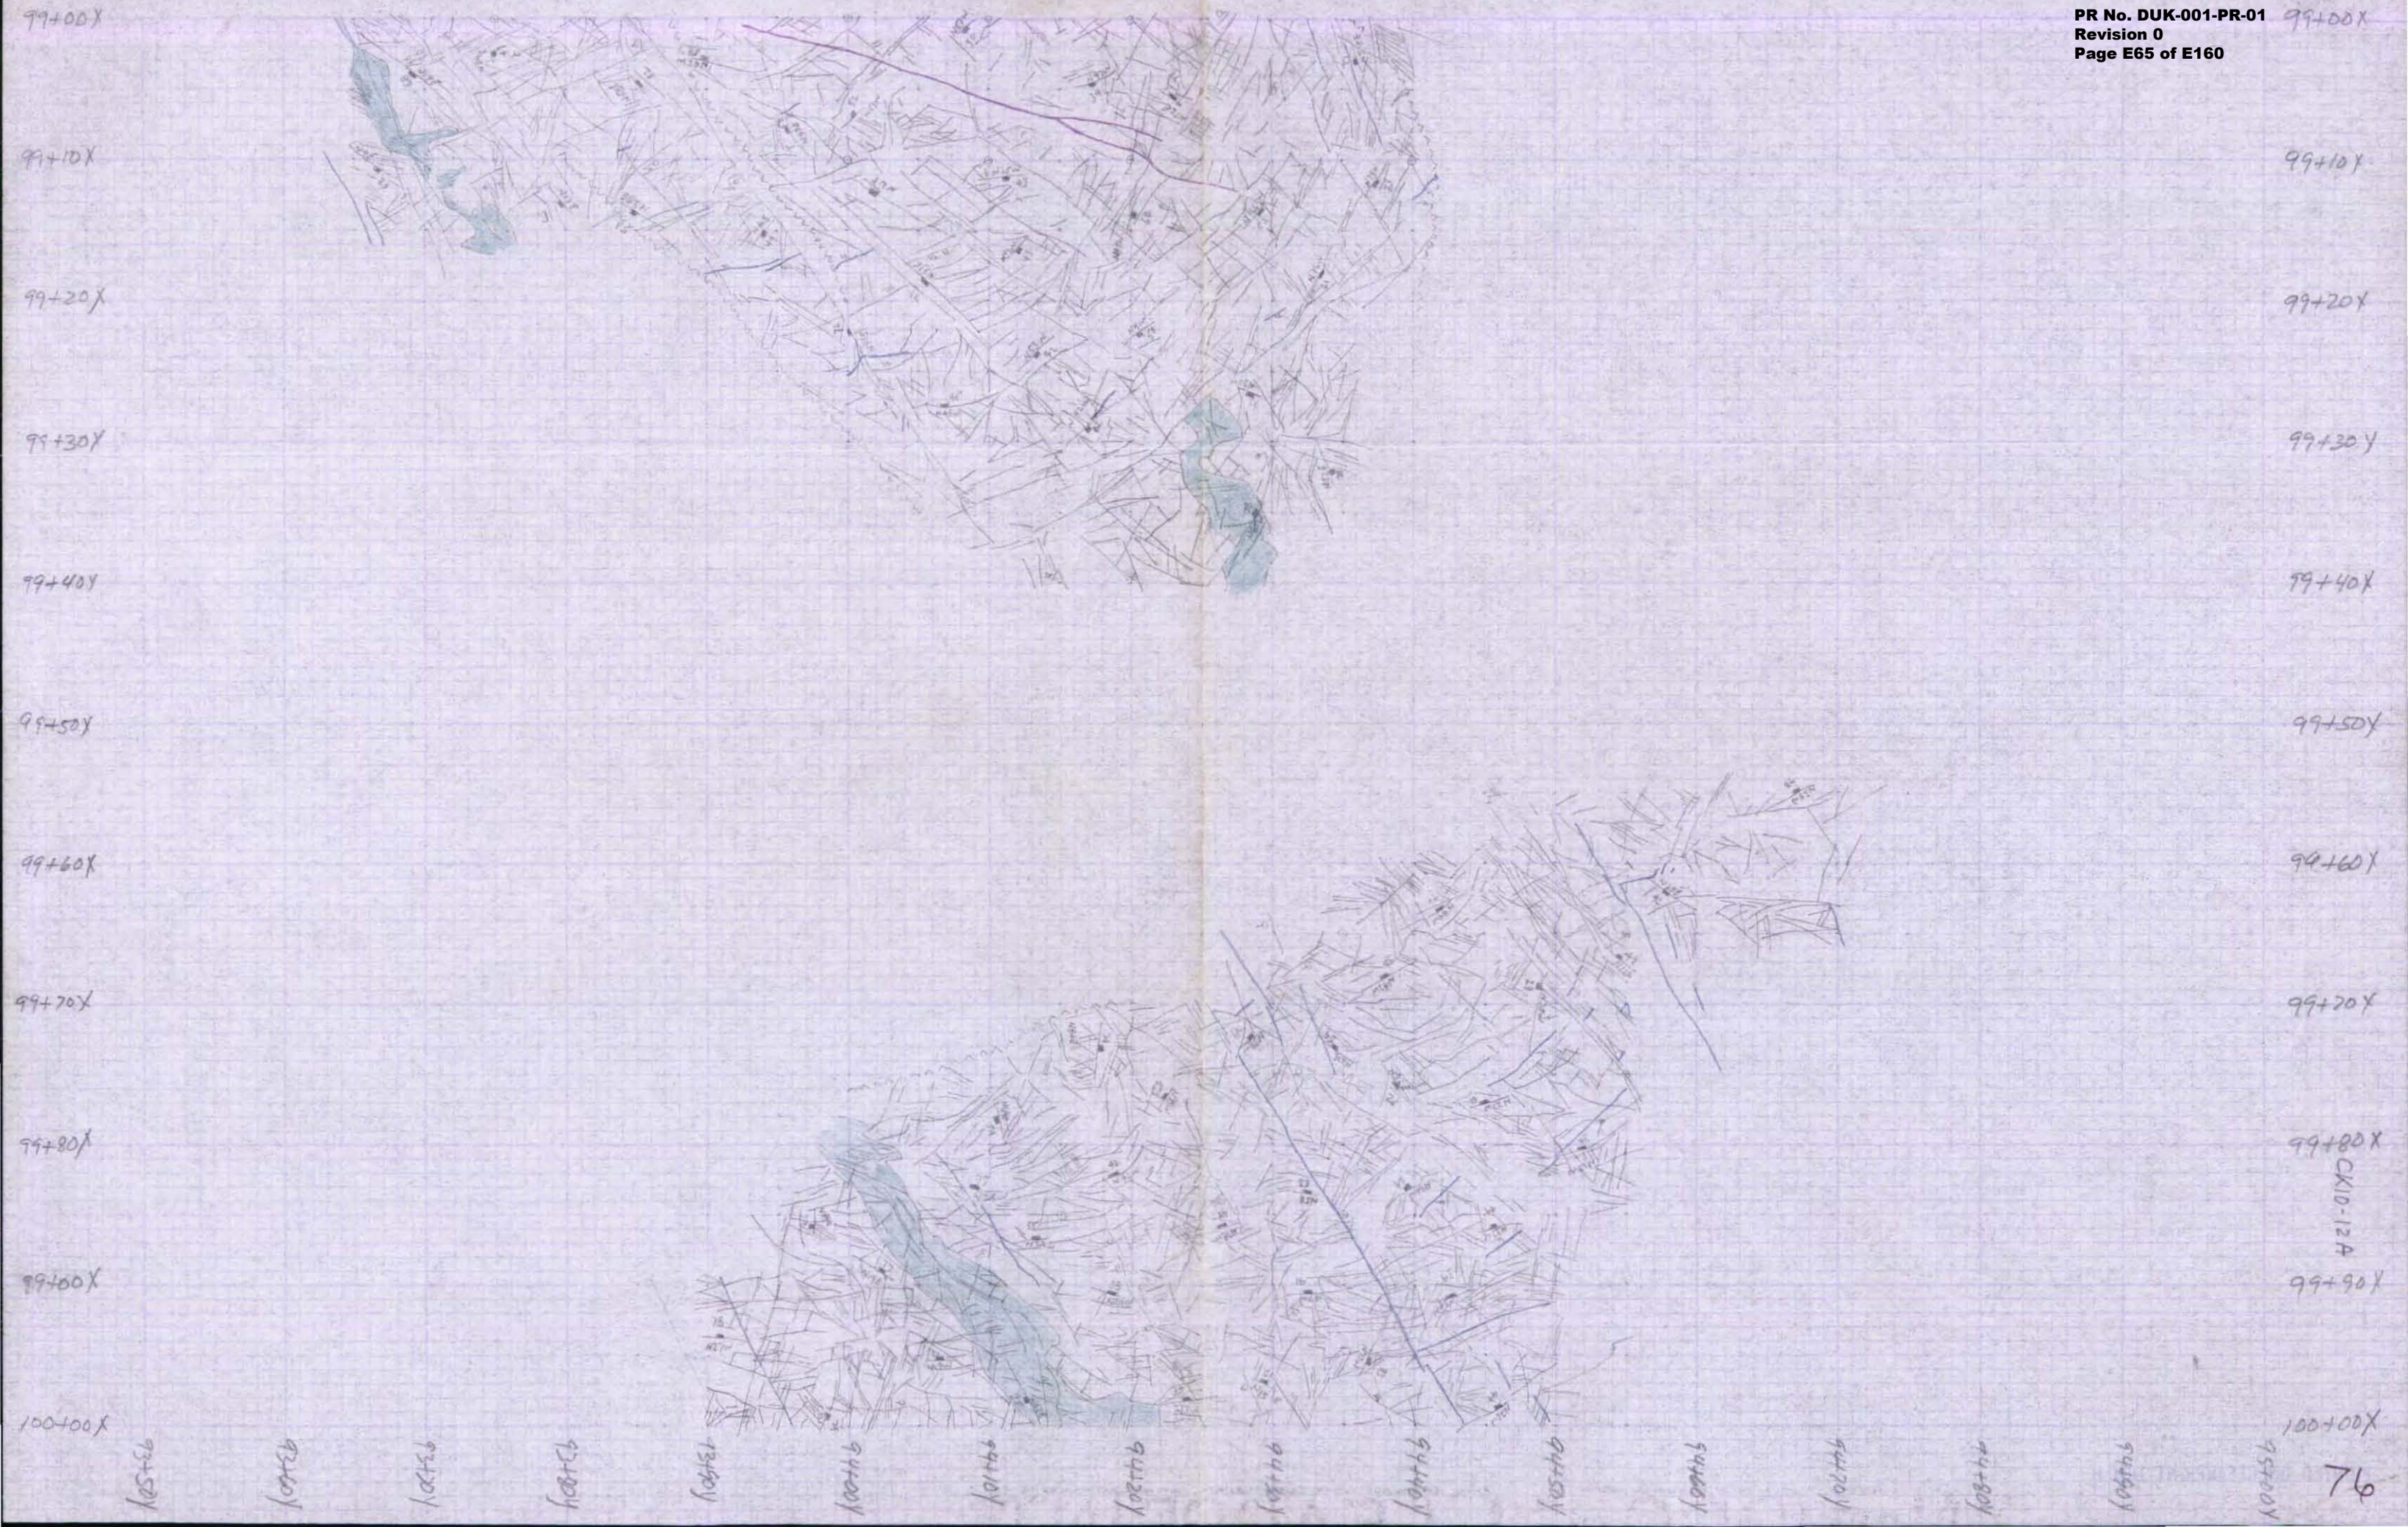




102+00X
102+100X
102+200X
102+300X
102+400X
102+500X
102+600X
102+700X
102+800X
102+900X
103+000X

102+00X
102+100X
102+200X
102+300X
102+400X
102+500X
102+600X
102+700X
102+800X
102+900X
103+000X

CK10-13A

CK10-13A

101+00Y
101+10Y
101+20Y
101+30Y
101+40Y
101+50Y
101+60Y
101+70Y
101+80Y
101+90Y
102+00Y
102+10Y
102+20Y
102+30Y
102+40Y
102+50Y

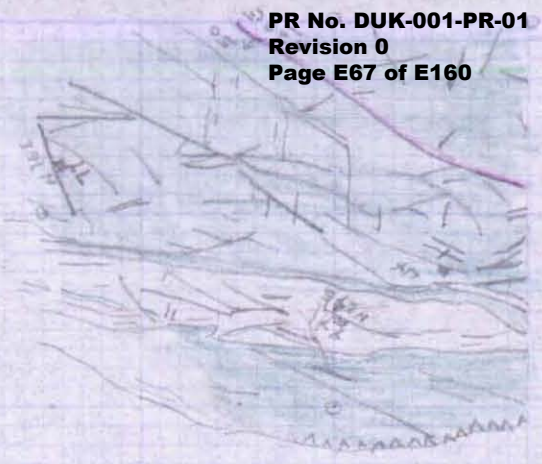

102+00X

102+00X

102+10X

102+10X

102+20X

102+20X

102+30X

102+30X

102+40X

102+40X

102+50X

102+50X

102+60X

102+60X

102+70X

102+70X

102+80X

102+80X

102+90X

102+90X

CK10-14B

CK10-14B

102+00X

102+00X

98100y

98110y

98120y

98130y

98140y

98150y

98160y

98170y

98180y

98190y

98200y

98210y


98220y

98230y

98240y


98250y

78

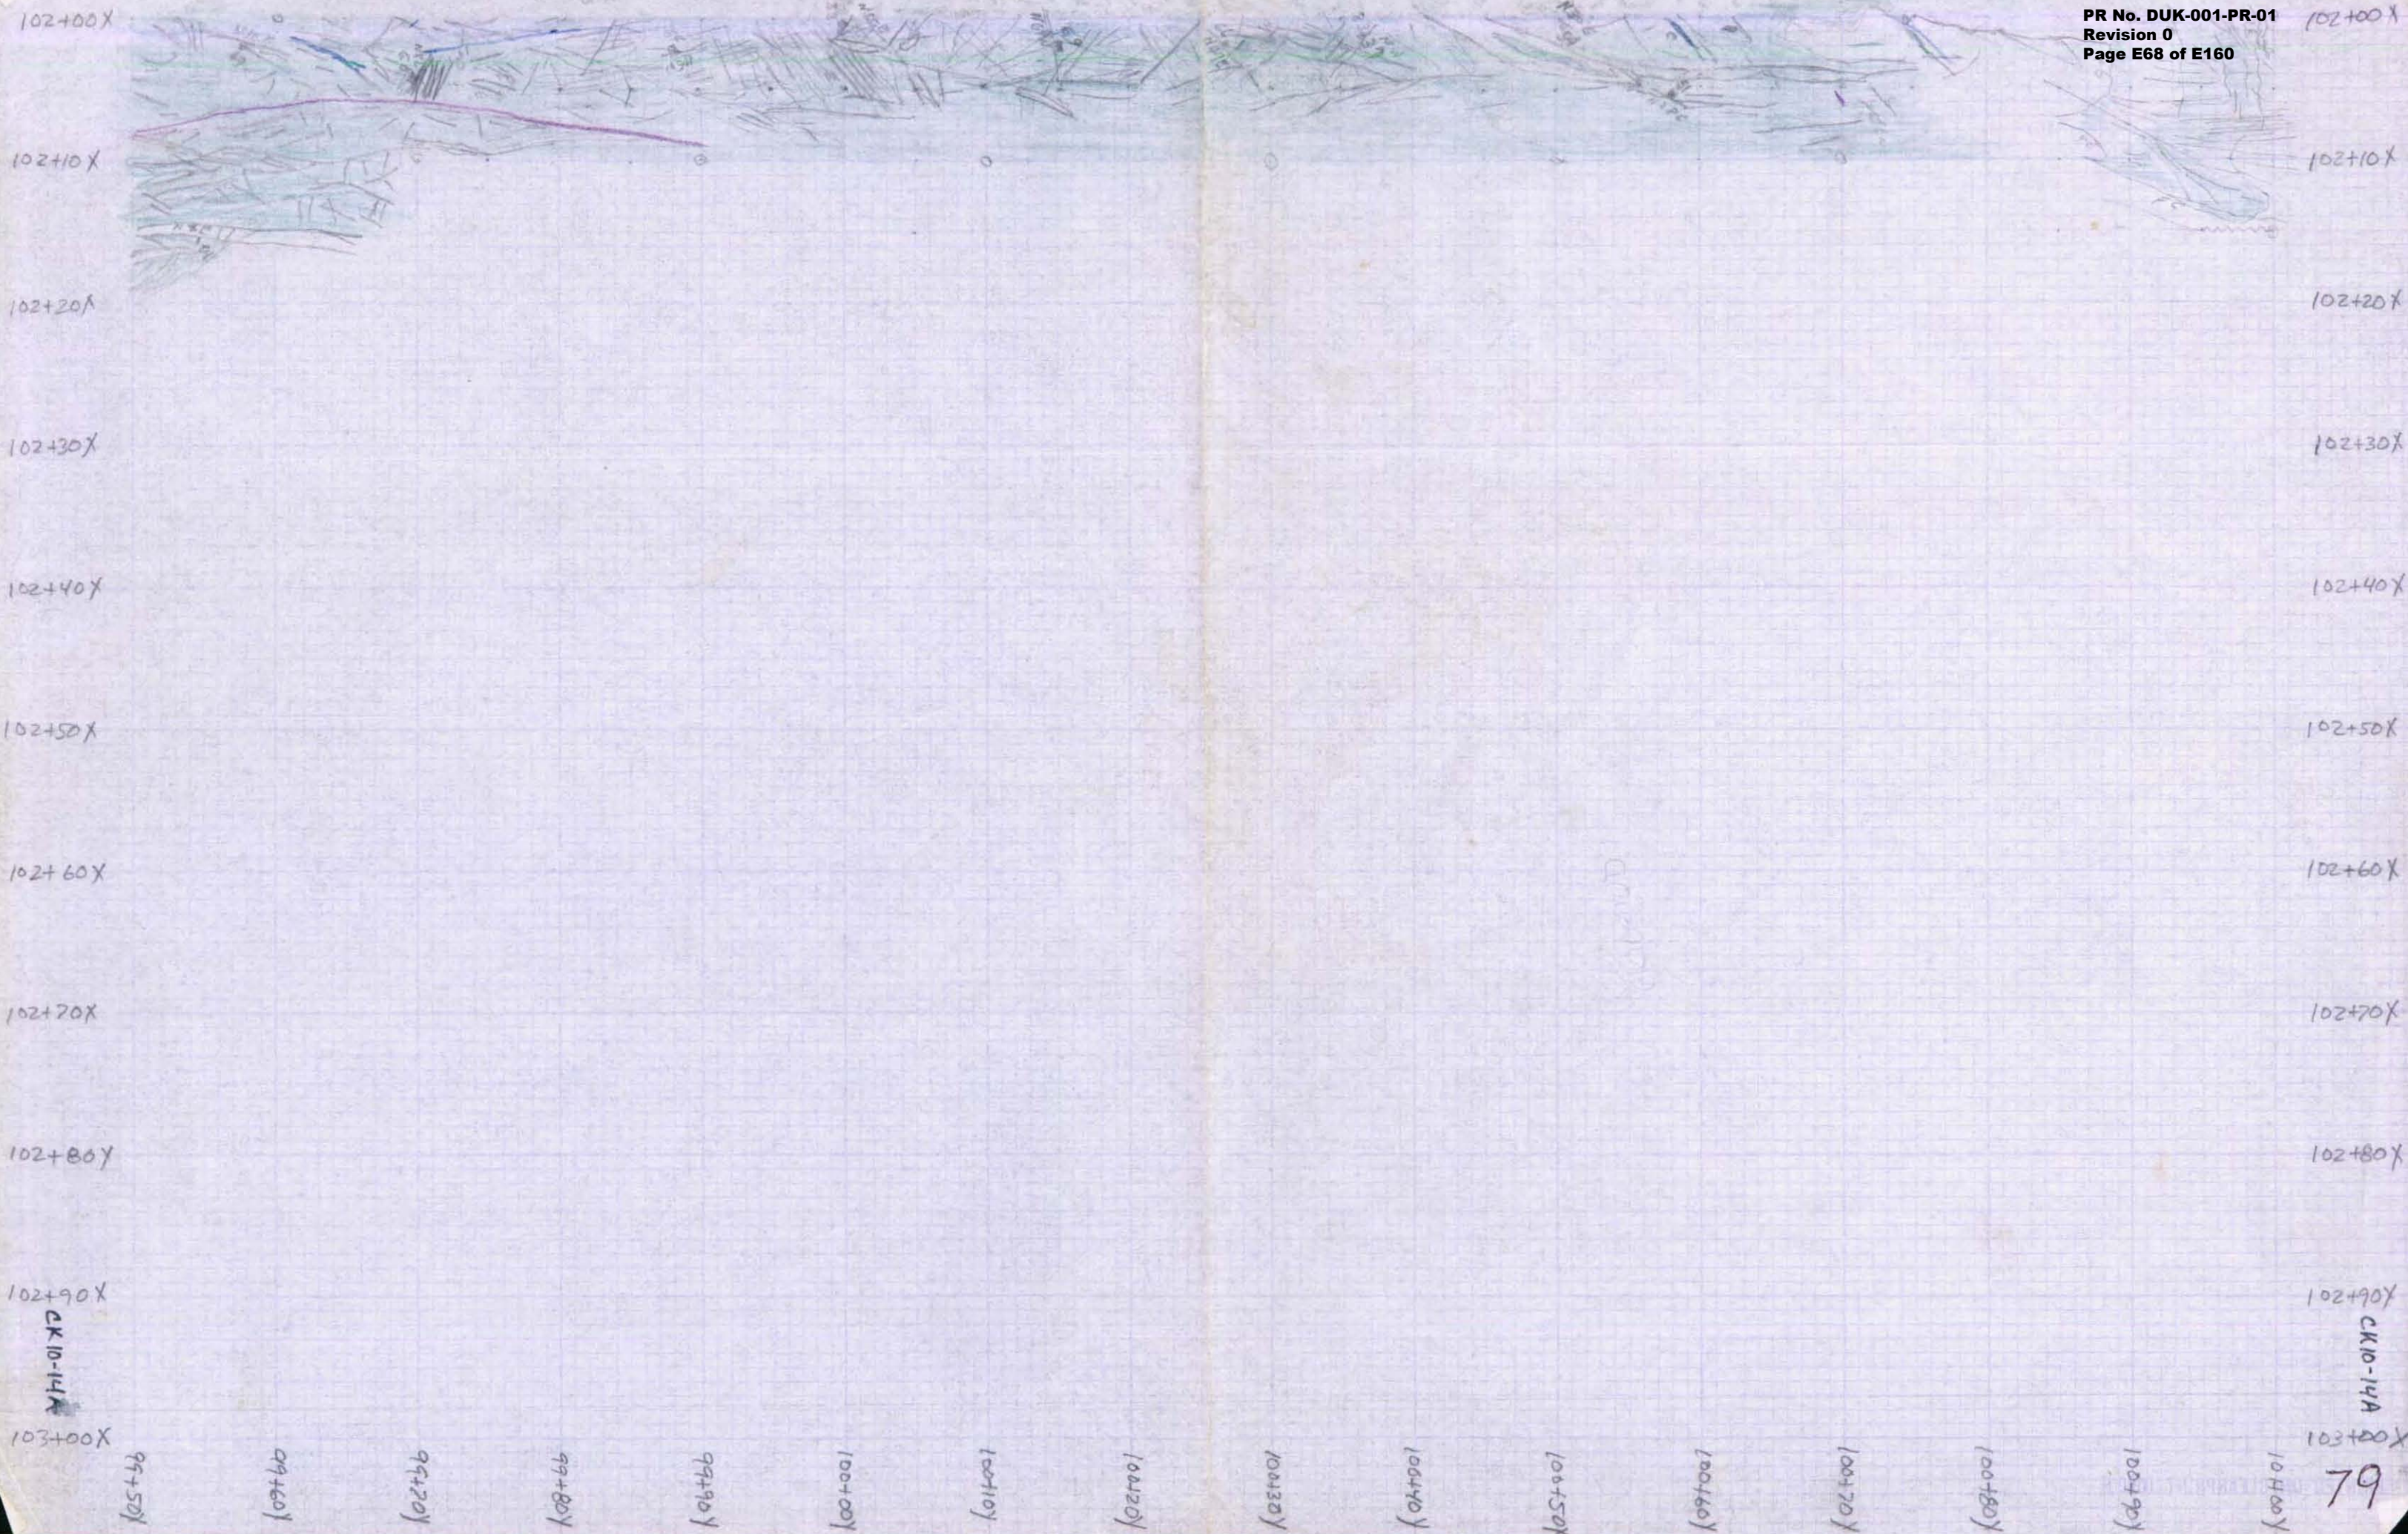

Replacement Scans
(Transmitted June 4, 2010)

- 49 CK10-07A.JPEG
- 52 CK10-07D.JPEG
- 62 CK10-10B.JPEG
- 69 CK10-11F.JPEG
- 73 CK10-11D.JPEG

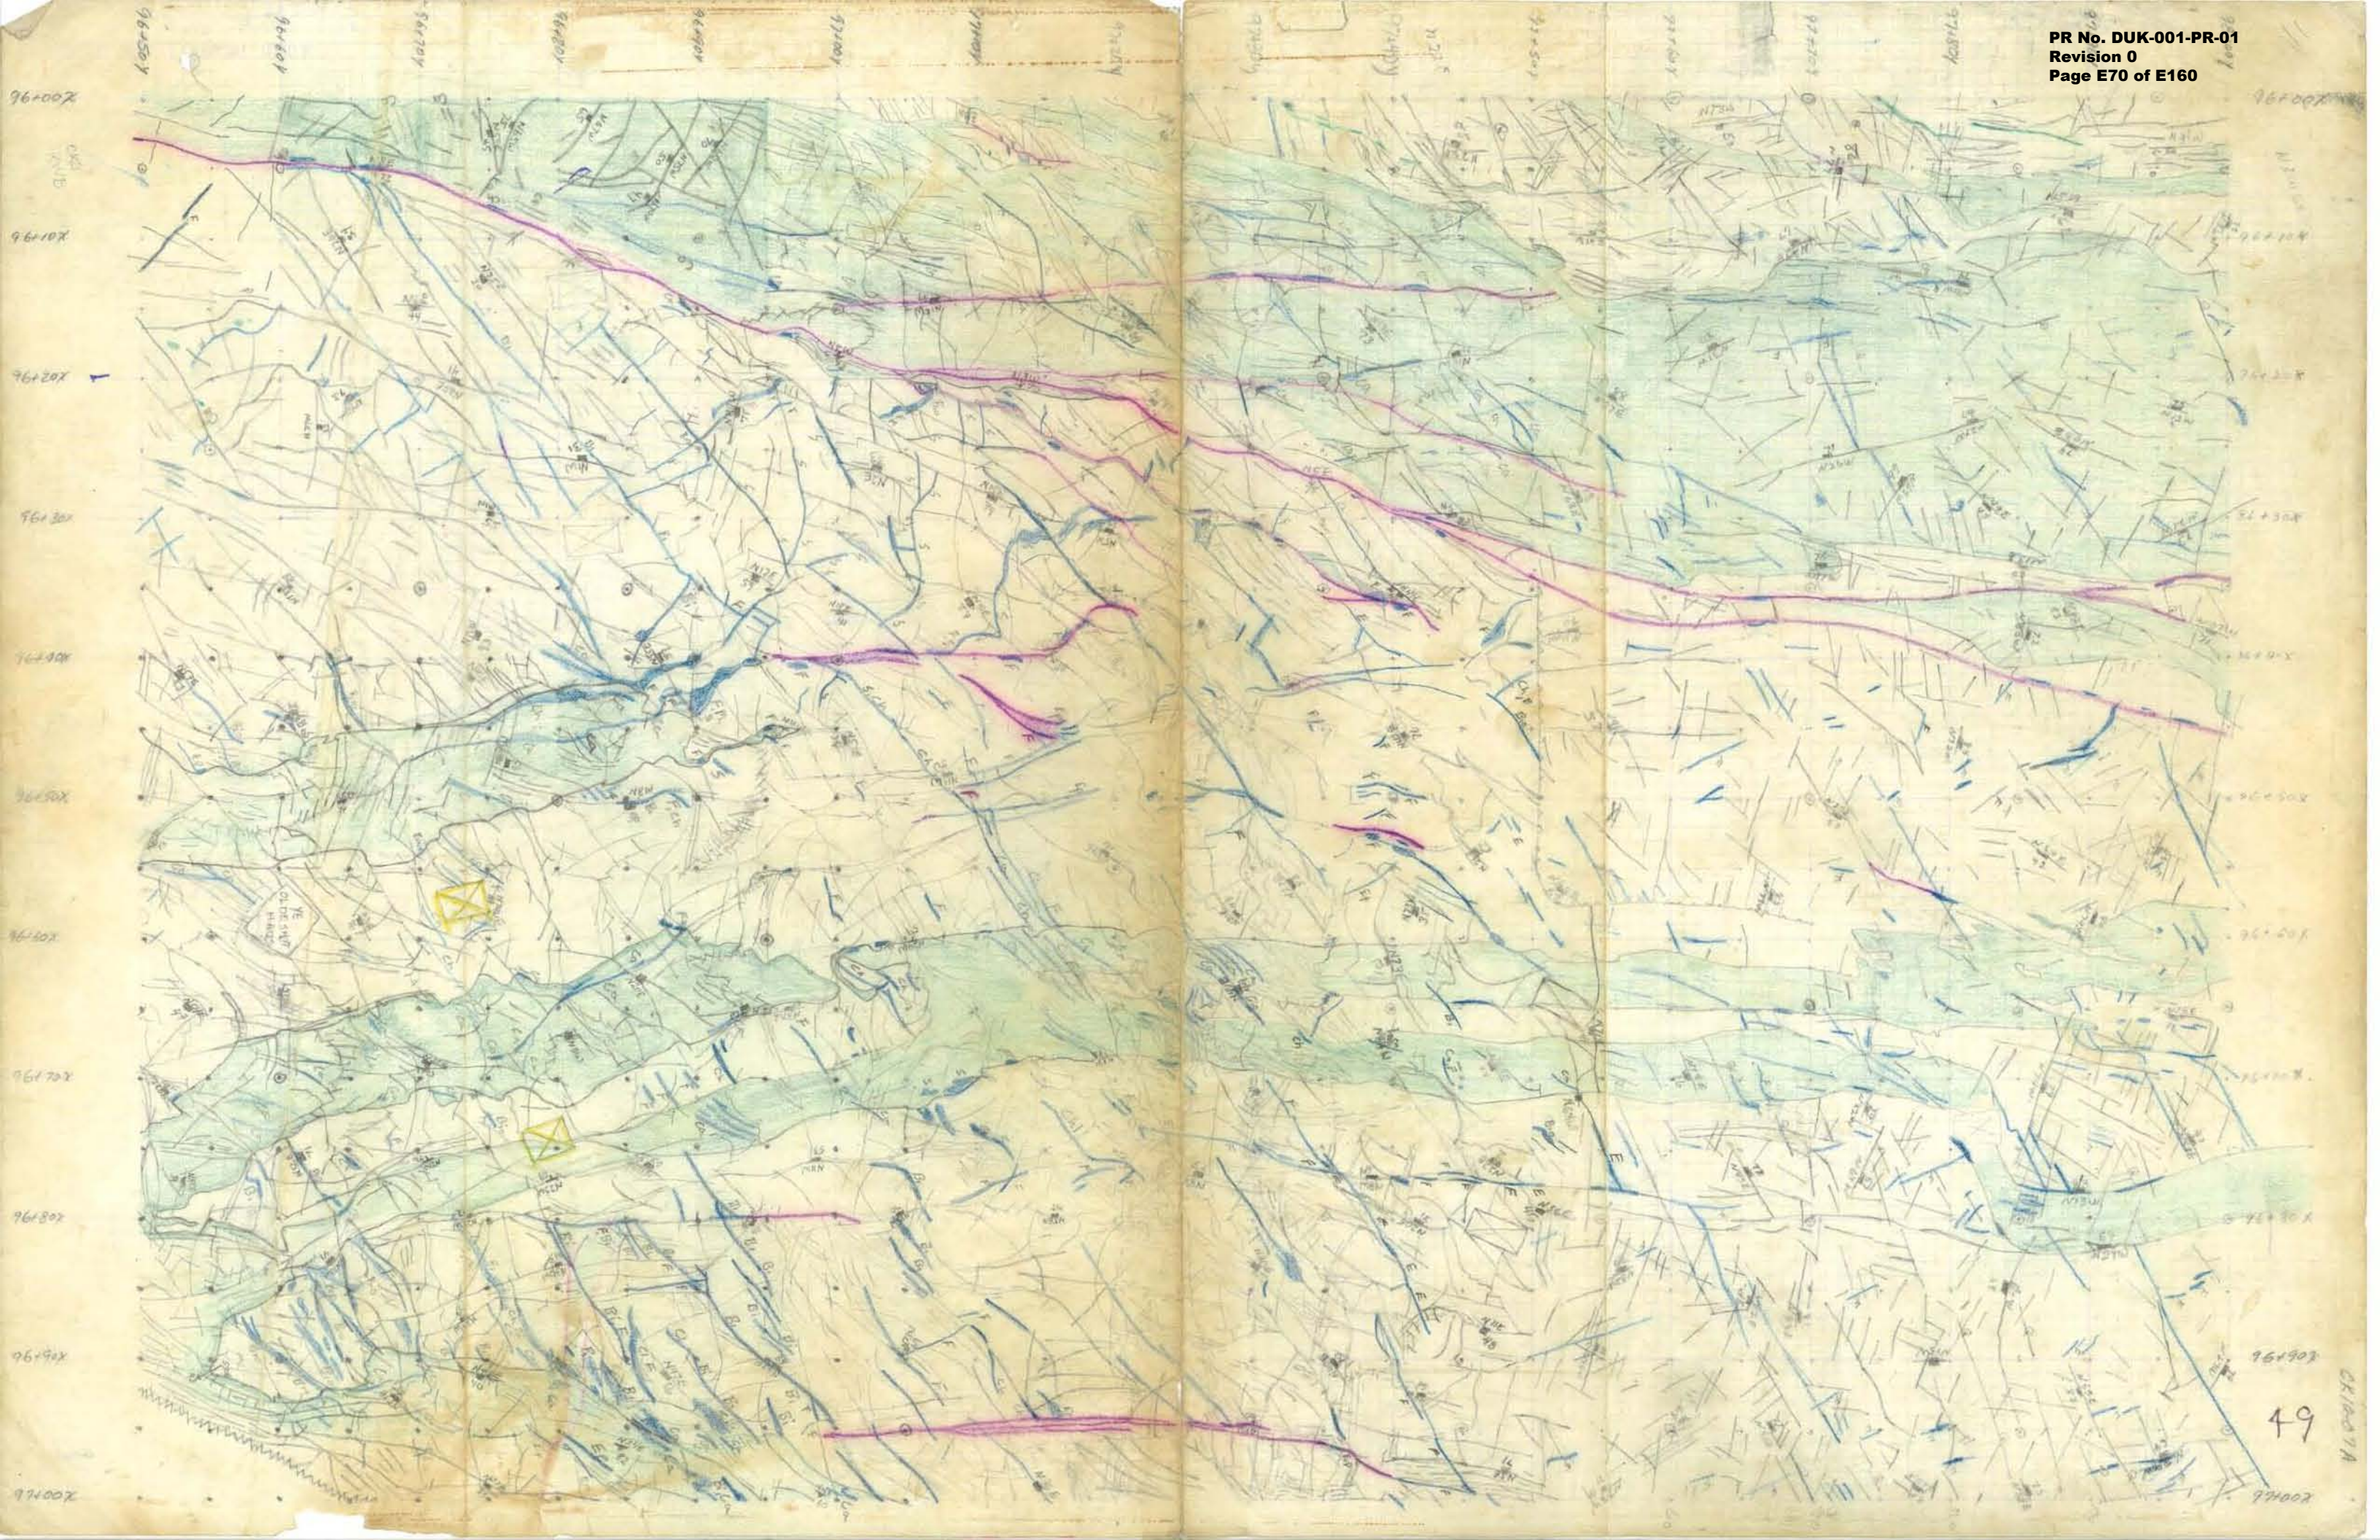

97+00X

97+10X

97+20X

97+30X

97+40X

97+50X

97+60X

97+70X

97+80X

97+90X

98+00X

96+50X

97+00X

97+10X

97+20X

97+30X

97+40X

97+50X


97+60X

97+70X

97+80X

97+90X


98+00X

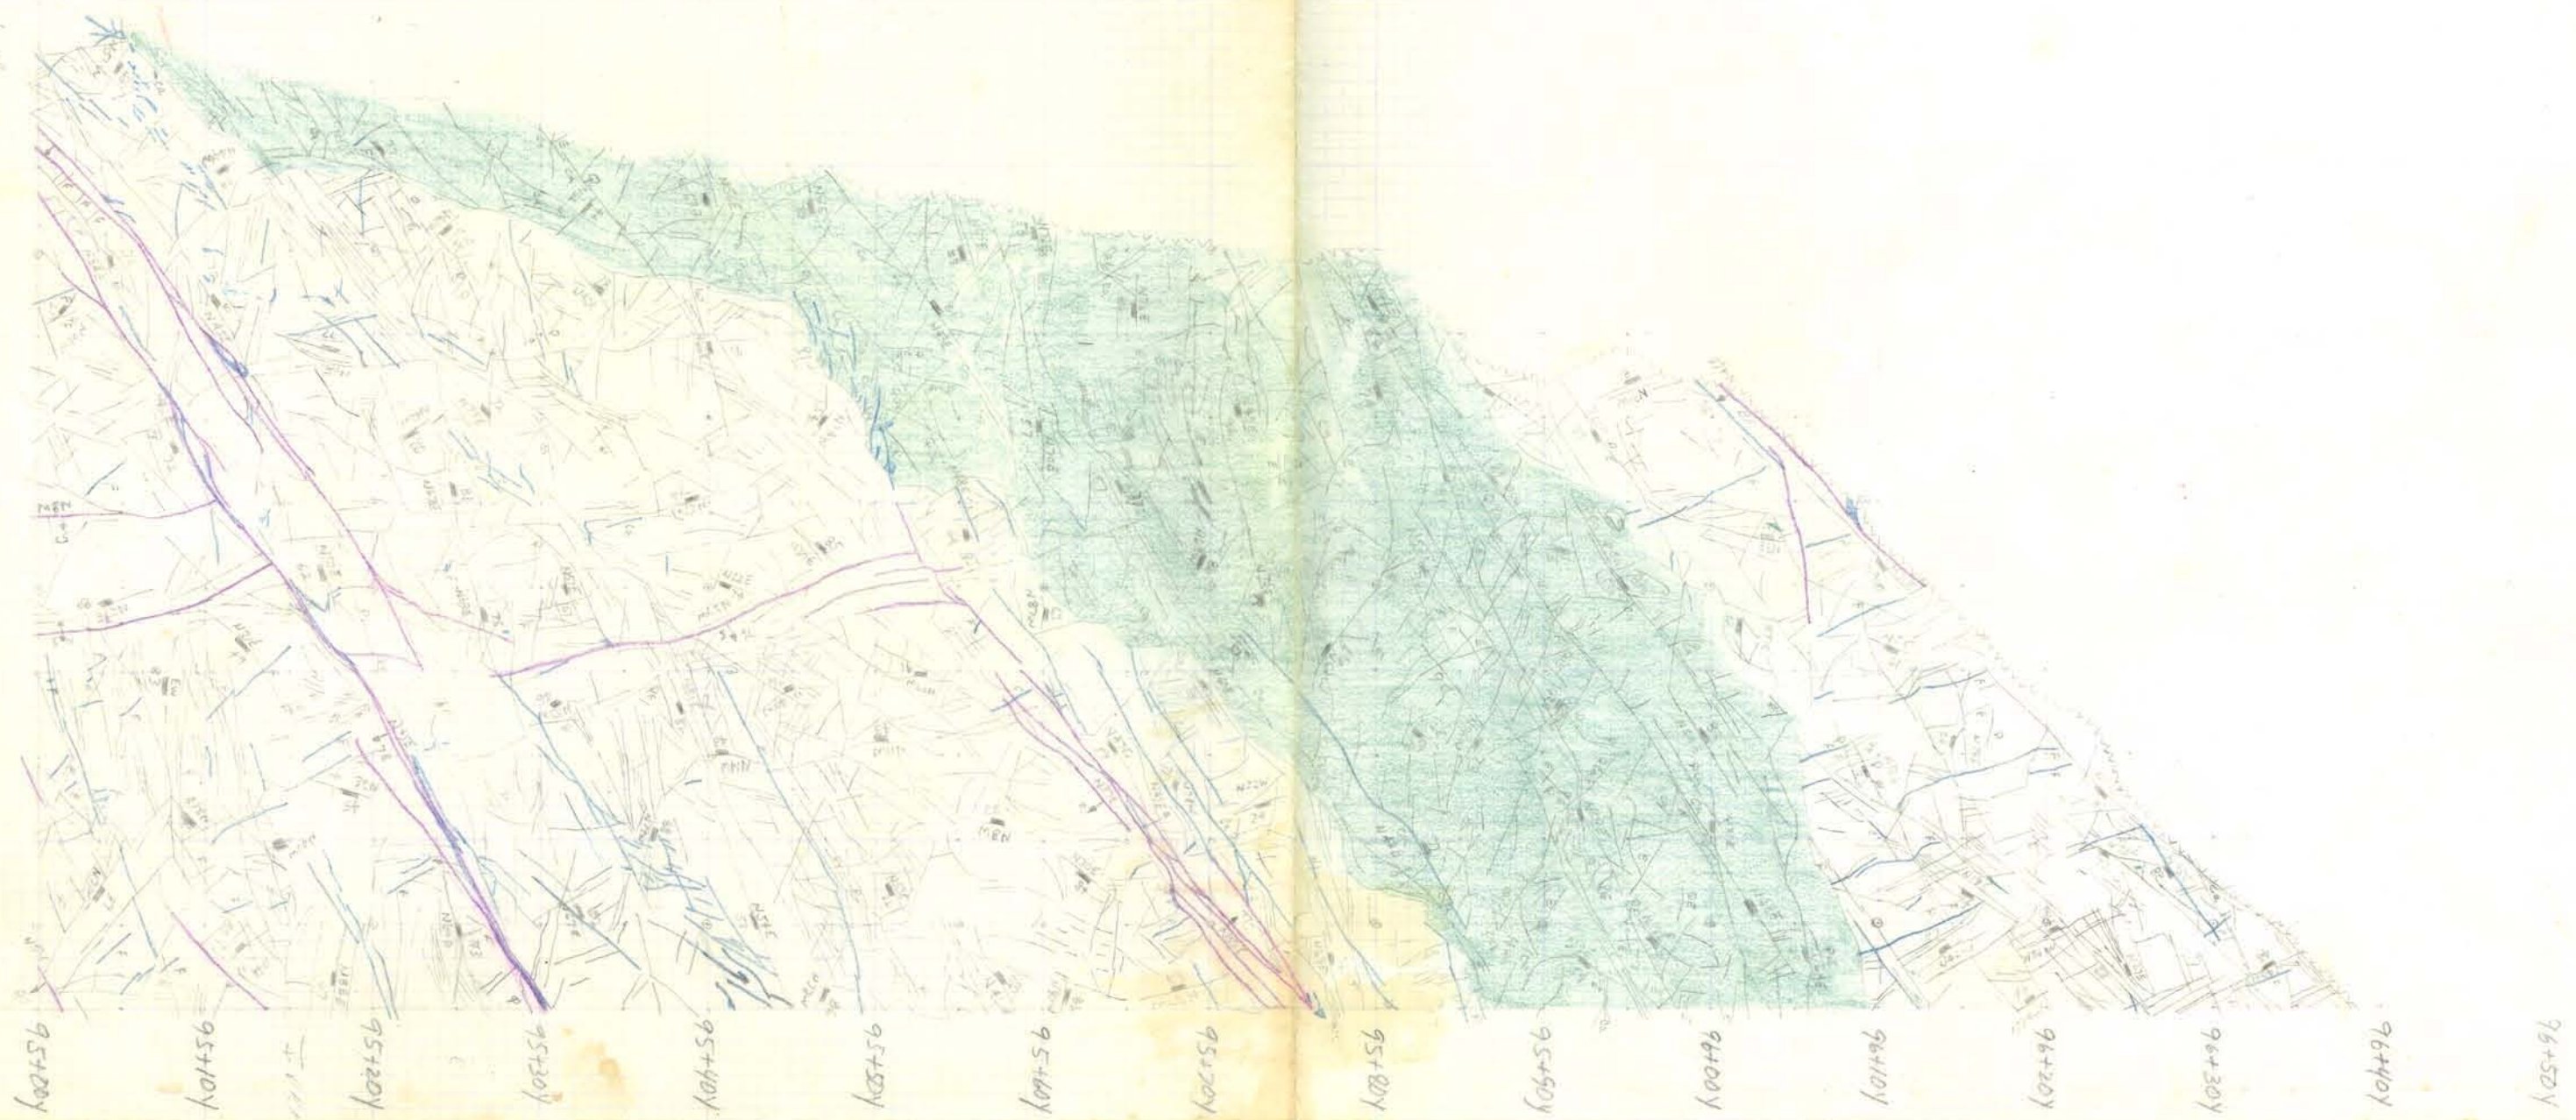


95+00X 95+10X 95+20X 95+30X 95+40X 95+50X 95+60X 95+70X 95+80X 95+90X 96+00X 96+10X 96+20X 96+30X 96+40X 96+50X

CK10-07D

52

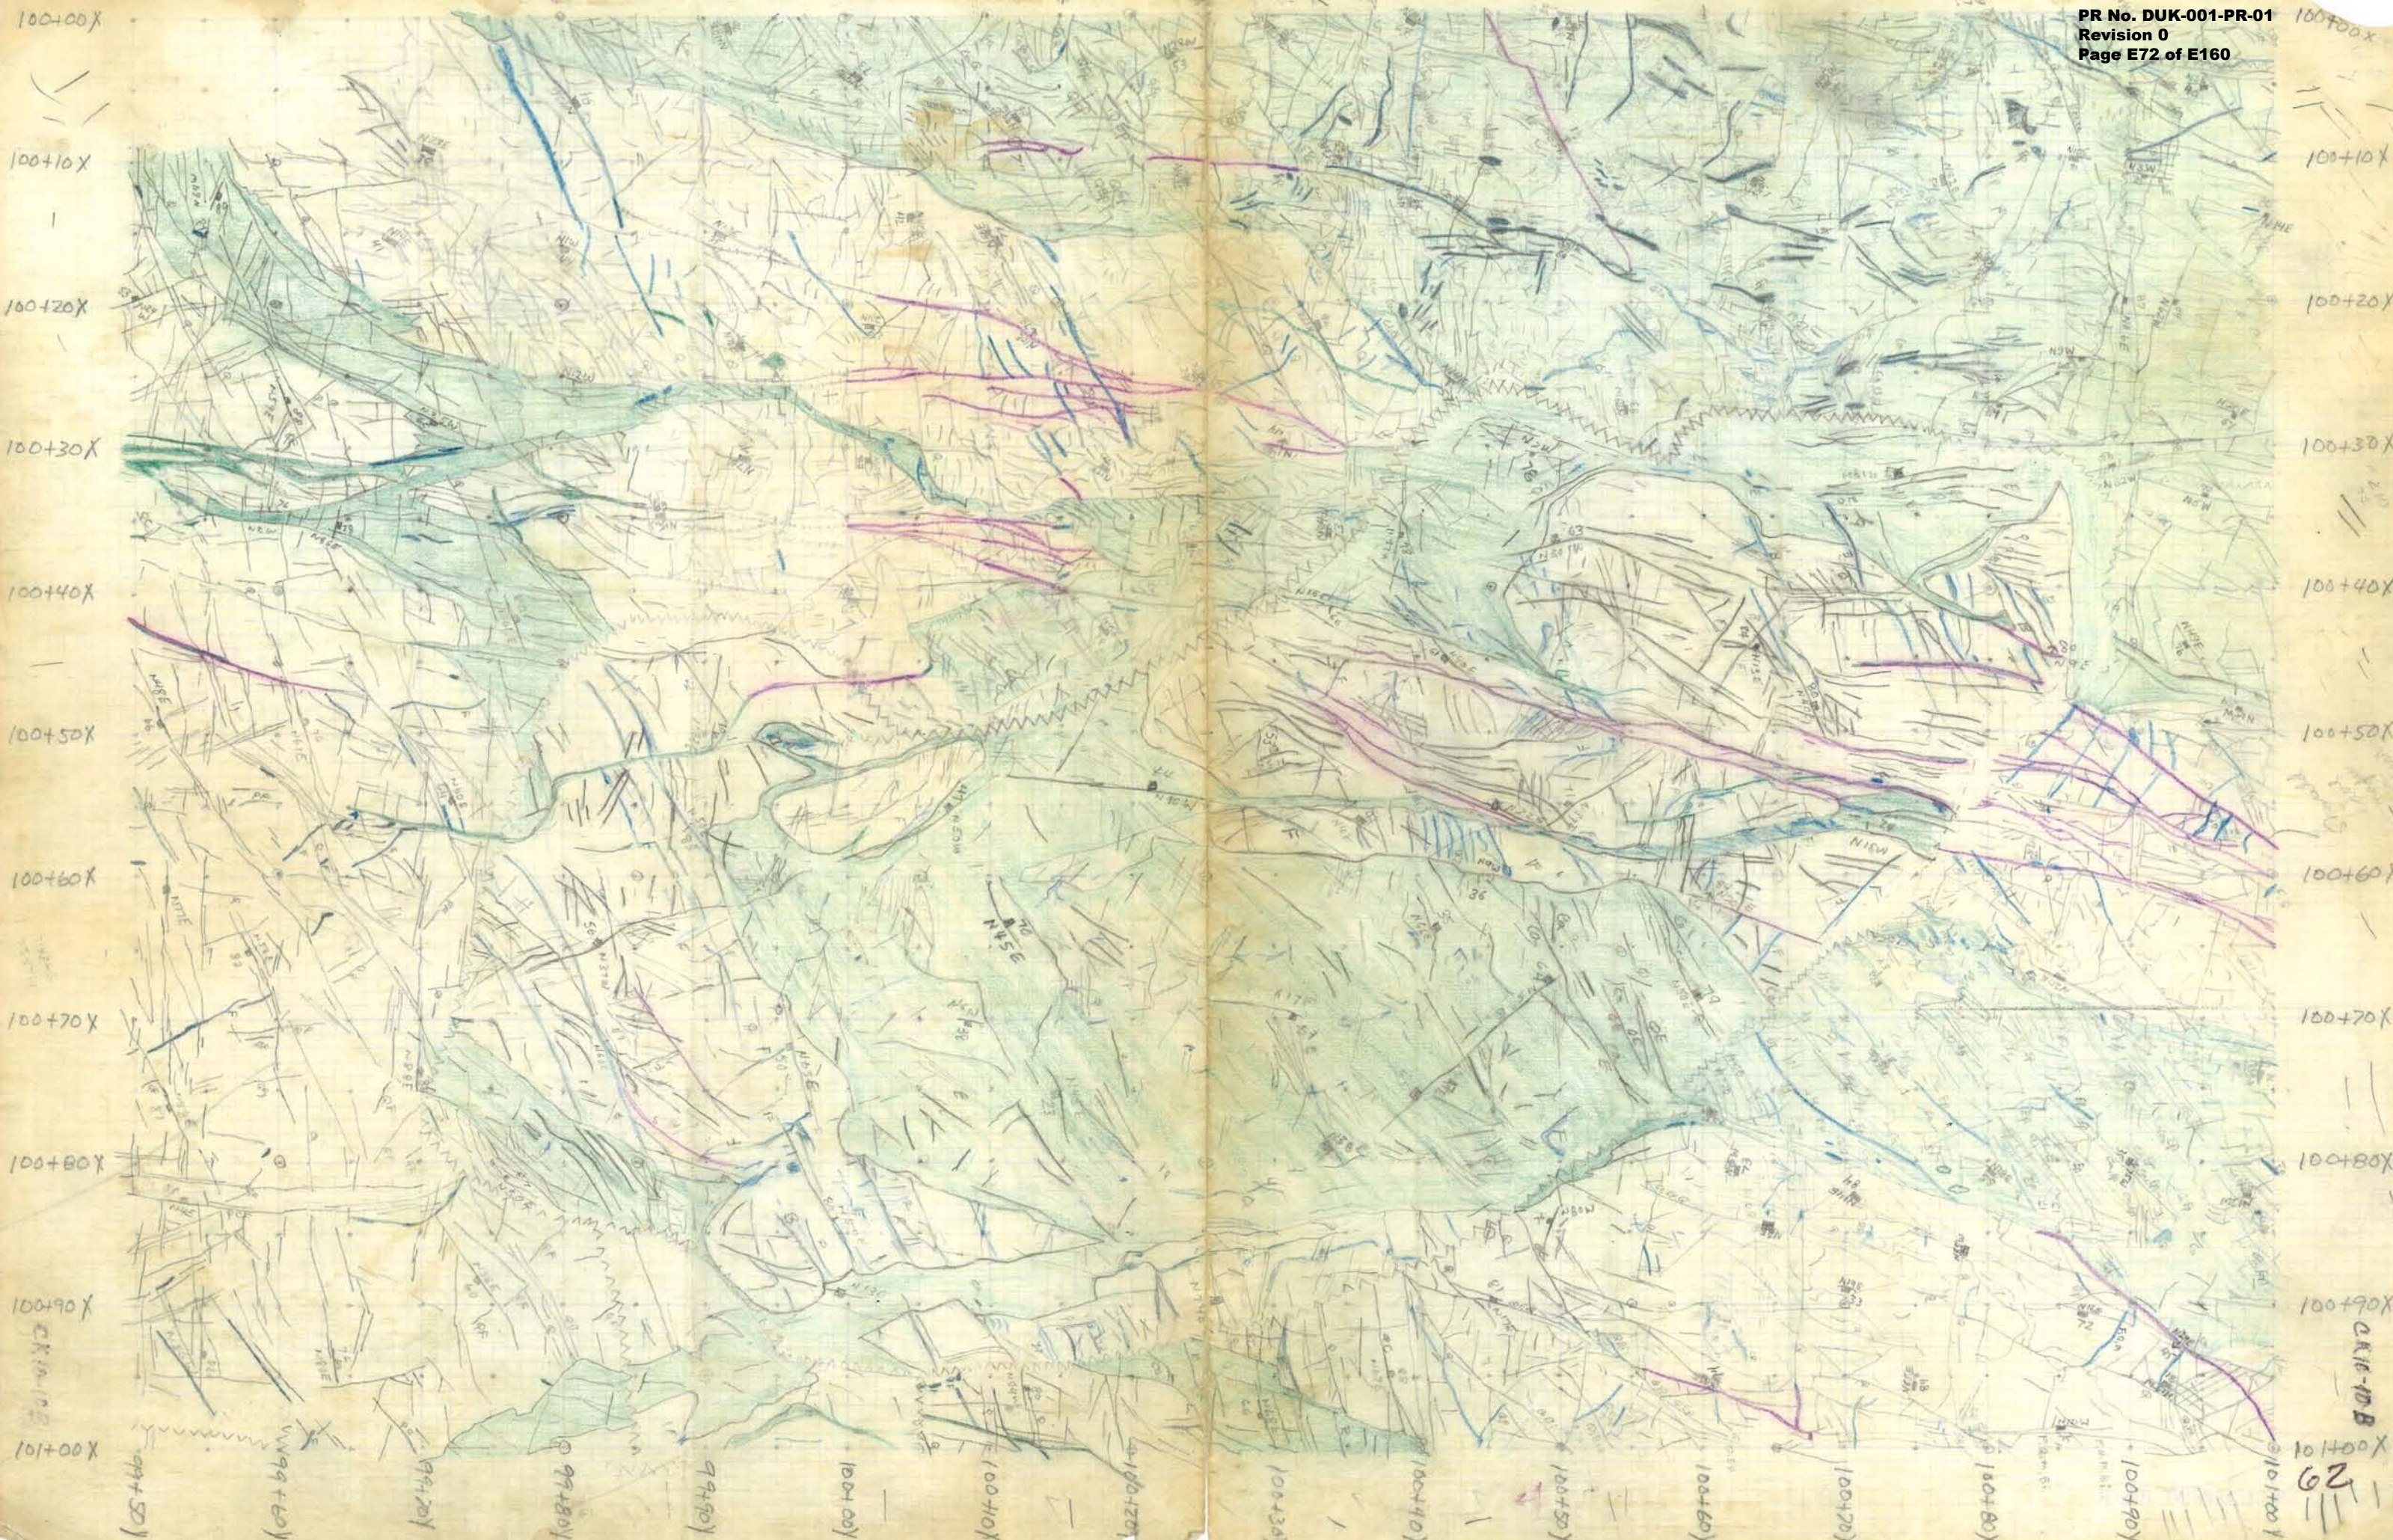

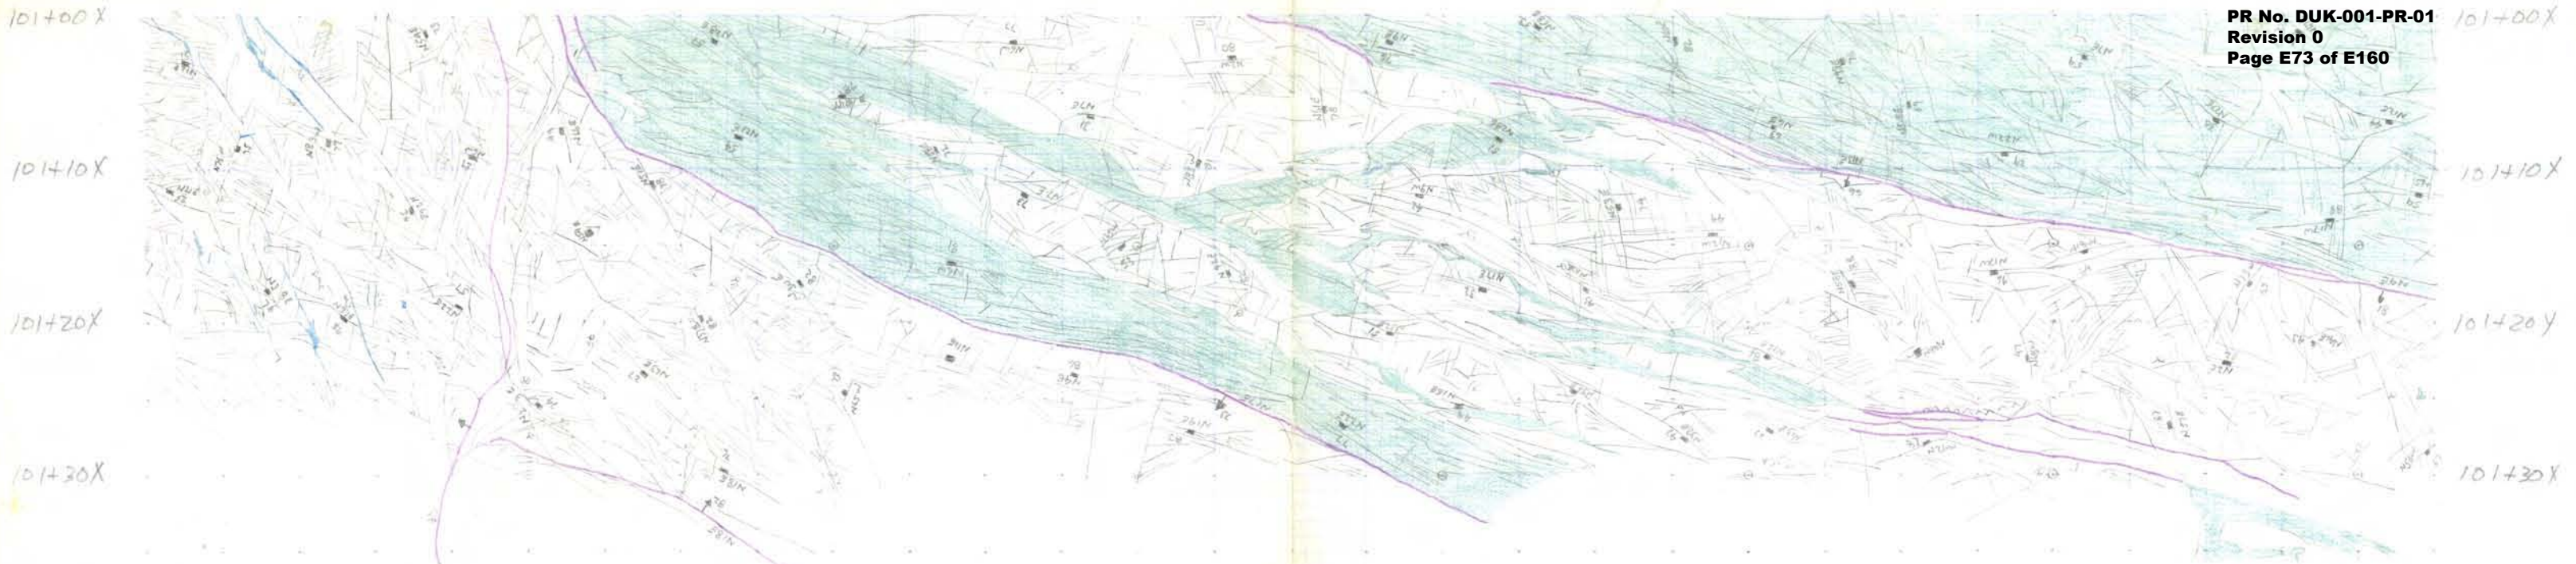


101+00X
101+10X
101+20X
101+30X
101+40X
101+50X
101+60X
101+70X
101+80X
101+90X
102+00X

101+00X
101+10X
101+20Y
101+30X
101+40X
101+50X
101+60X
101+70X
101+80X
101+90X
102+00X

95+00Y
95+10Y
95+20Y
95+30Y
95+40Y
95+50Y
95+60Y
95+70Y
95+80Y
95+90Y
96+00Y
96+10Y
96+20Y
96+30Y
96+40Y

CK10-11F
69

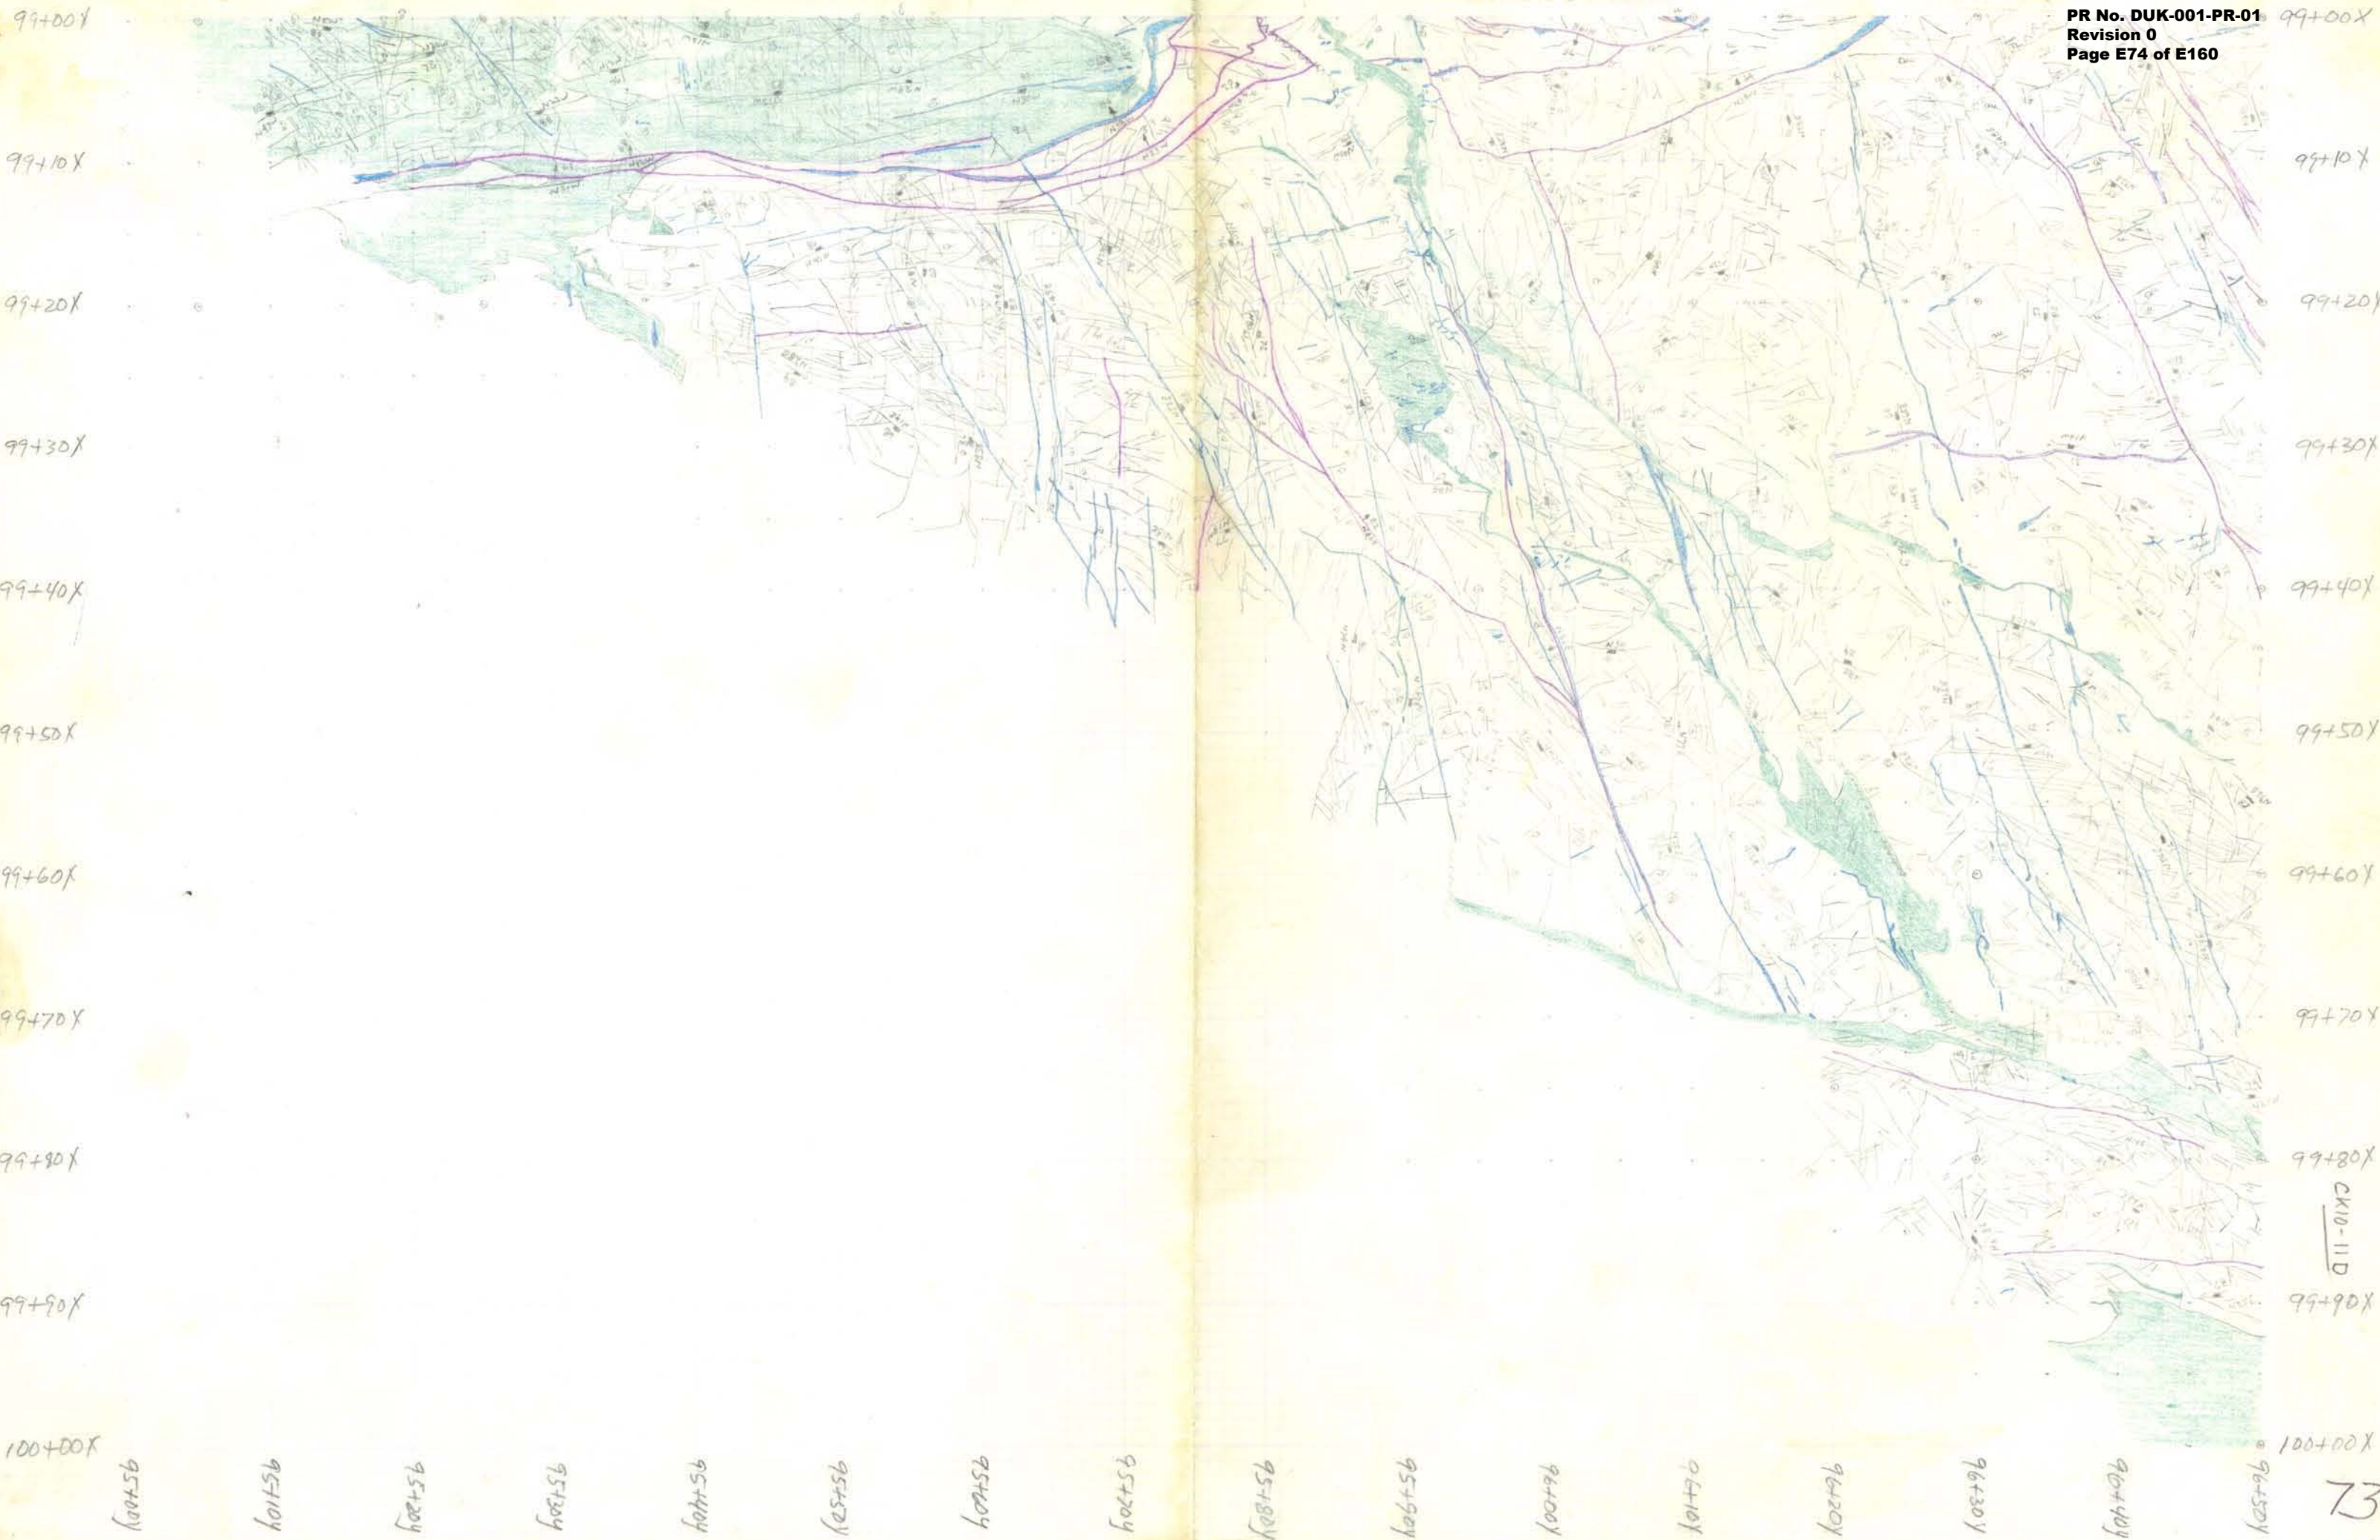

CR10-11D

ATTACHMENT 3

Record Transmittals:

*Historical Mapping of the Excavation for Lee Nuclear Site
Historical Construction Photos of Unit 1 Area*
Transmitted to FWLA from Duke Energy (March 23, 2007)

Updated Historical Foundation Mapping Documents
Transmitted to FWLA from Duke Energy (June 4, 2010)

*Final Foundation Index Map, Geologic Mapping Procedure, and Supplemental Mapping
Guidance*
Transmittal to FWLA from Duke Energy (November 23, 2010)



1780, 14.3

DUK-010
DUKE LNS COL 1780

PR No. DUK-001-PR-01
Revision 0
Page E76 of E160
Mailing Address:
Mail Code EC05Z
526 South Church Street
Charlotte, NC 28201
704-382-4319
704-382-4545 fax

March 23, 2007

Mr. Robert Falk
ENERCON Services
12850 Middlebrook Rd
Suite 304
Germantown, MD 20874

Subject: Historical Mapping of the Excavation for Lee Nuclear Site
Historical Construction Photos of Unit 1 Area

Dear Bob,

Drawings showing the historical mapping of the excavation for Lee Nuclear Station listed below are being transmitted via three DVDs with this letter. Construction photos of the Unit 1 area listed below are also being transmitted via a CD-ROM.

MG 7/11/07
GM
G 5/21/07


Three DVDs Contain:	
	Folder CK 10-01 (Drwgs 20, 21)
	Folder CK 10-02 (Drwgs 22,23,24,25,26,27,28)
CD 26	Folder CK 10-03 (Drwgs 29,30,31,32,33,34)
	Folder CK 10-04 (Drwgs 35,36,37,38)
	Folder CK 10-05 (Drwgs 39,40,41)
	Folder CK 10-06 (Drwgs 42,43,44,45,46,47)
CD 27	Folder CK 10-07 (Drwgs 48,49,50,51,52,53,54)
	Folder CK 10-08 (Drwgs 55,56,57,58)
	Folder CK 10-09 (Drwgs 59,60,61)
	Folder CK 10-10 (Drwgs 62,63,64,65,66,67)
CD 28	Folder CK 10-11 (Drwgs 68,69,70,71,72,73)
	Folder CK 10-12 (Drwgs 74,75,76)
	Folder CK 10-13 (Drwg 77)
	Folder CK 10-14 (Drwgs 78,79)

CD-ROM Contains:	
Construction Photos	
CD 25	No. 436,467,476,485,501,503,504,518,530,544,557,641,653,670, 792,832,833,922,1012,1359,1360



If you have any questions, please call me at 704-382-4319.

Sincerely,

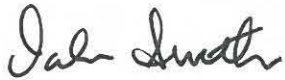

Dale M Smith
Civil Engineering Lead

Enclosures: Three DVDs
CD-ROM

Cc: Mike Gray, Lettis (with enclosure)
R. L. Morgan, Jr. (without enclosure)
J. S. Thrasher (without enclosure)
4000.01-09 (without enclosure)



Jun. 4, 2010

Mr. Tom Slavonic
Enercon Services
4490 Old William Penn Highway
Murrysville, PA 15668

Subject: Updated Historical Foundation Mapping Documents

Dear Tom:


The attached CD contains updated scans of five historical field documents that were problematic for the foundation mapping work being performed by FWLA. This information supplements and replaces that transmitted by Duke Energy's letter of March 23, 2007 (Dale Smith to Bob Falk) for these five map panels. The five files are identified as shown below.

CD#29

Map Panel Designation	Former File Name	New File Name	File Properties
CK10-07A	49.tif	49 CK10-07A.jpg	Created 6/3/2010 5:32 pm; Size 10,108,309 bytes
CK10-07D	52.tif	52 CK10-07D.jpg	Created 6/3/2010 5:33 pm; Size 7,049,104 bytes
CK10-10B	62.tif	62 CK10-10B.jpg	Created 6/3/2010 5:34 pm; Size 10,205,854 bytes
CK10-11F	69.tif	69 CK10-11F.jpg	Created 6/3/2010 5:35 pm; Size 4,143,323 bytes
CK10-11D	73.tif	73 CK10-11D.jpg	Created 6/3/2010 5:36 pm; Size 6,244,638 bytes

If you have questions, please call me at 704-382-7830.

Sincerely,

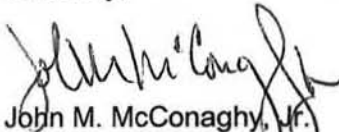

John M. McConaghy, Jr.
Engineering Consultant

Enclosure: 1 CD as described

cc: Mike Gray, FWLA (w/ enclosure)
R.L. Morgan (w/o enclosure)
J.S. Thrasher (w/o enclosure)
J.R. Cassidy (w/o enclosure)
4000.01-09 (w/ enclosure)



November 23, 2010

Mr. Tom Slavonic
Enercon Services
4490 Old William Penn Highway
Murrysville, PA 15668

Subject: Final Foundation Index Map, Geologic Mapping Procedure, and
Supplemental Mapping Guidance

Dear Tom:

After our recent teleconference on qualification of Cherokee legacy geologic mapping documentation, Adam Wade pointed out that FWLA still needed to receive controlled distribution of several documents, including the Final Foundation Index Map, and the geologic mapping procedures, as well as input on those procedures from Dr. Hatcher. The attached CD contains these documents, as retrieved from several sources.

The files whose file name includes a Duke microfilm reel number were obtained from scans of microfilm records from Duke archives, and can be identified by the reel and frame number stenciled at the left of each page. The document whose name contains "MFS CK1108.00" was retrieved from Malcolm Schaeffer's Cherokee correspondence files that are now maintained as part of the Lee project documentation. The documents containing "LETCo" in the filename were retrieved from the Law Engineering Cherokee files at MACTEC.

Comparison of the Duke and Law versions of the Geologic Mapping procedure give high confidence that the content of the two is the same, and reflects the procedures used in the field.

The Duke archive microfilm record contains only the first page of Dr. Hatcher's letter, but it is the same as the first page of Mr. Schaeffer's complete (two-page) document. Comparing Mr. Schaeffer's CK1108.00 complete Hatcher document to the comparable document from Law, one can confirm that the content is the same.

The CK1108.00 version and the Law version of the Hatcher letter differ in some cosmetic ways such as pagination. I believe this can be explained by recalling that in 1977, such letters were produced on a typewriter, and a letter to two different companies would normally have two originals typed. It is not unreasonable to expect that a 1977 typist may have created different page breaks for the two letters, while maintaining the same content.


Mr. Tom Slavonic
November 23, 2010
Page 2 of 2

The Final Foundation Index map is easily identified by its file name. The files are identified as shown in the listing below.

File Name	File Properties		
	Created		Size (Bytes)
1976-1130 Geologic Mapping Procedure, Pearce to Sams (From Duke Microfilm Reel 3184).pdf	11/22/2010	05:31 PM	808,352
1976-1130 Geologic Mapping Procedure, Pearce to Sams (From LETCo Cherokee Files).pdf	11/22/2010	05:32 PM	1,975,820
1977-0422 Geo Mapping Letter, Hatcher to Sams and Pearce (From Duke MFS CK1108.00).pdf	11/22/2010	05:34 PM	517,068
1977-0422 Geo Mapping Letter, Hatcher to Sams and Pearce (From Duke Microfilm Reel 3184).pdf	11/22/2010	05:34 PM	85,621
1977-0422 Geo Mapping Letter, Hatcher to Sams and Pearce (From LETCo Cherokee Files).pdf	11/22/2010	05:35 PM	341,589
Final Foundation Index Map (AKA Binder2 2).pdf	10/09/2006	09:27 AM	30,201,242

If you have questions, please call me at 704-382-7830.

Sincerely,

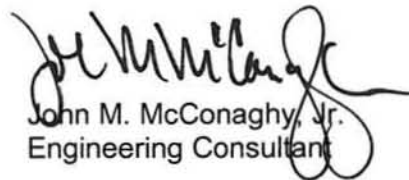

John M. McConaghy, Jr.
Engineering Consultant

Enclosure: 1 CD as described

cc: Mike Gray, FWLA (w/ enclosure)
Malcolm Schaeffer, HDR|DTA (w/ enclosure)
R.L. Morgan (w/o enclosure)
J.S. Thrasher (w/o enclosure)
J.R. Cassidy (w/o enclosure)
4000.01-09 (w/ enclosure)

ATTACHMENT 4

Duke Power Company Mapping Procedures and Addendum

Duke Power Company
Project 81
Cherokee Nuclear Station
Geologic Mapping Procedure
(November 30, 1976)

Transmitted to Law Engineering Testing Co. from Duke Power Company
[Duke File Name:1976-1130 Geologic Mapping Procedure, Pearce to Sams
(From Duke Microfilm Reel 3184).pdf]

Geologic Mapping Procedure
Outline

SECTION I - GENERAL DESCRIPTION

- A. Purpose
- B. Scope of Mapping and Sequence
- C. Definition of Responsible Parties
 - 1) Responsible Engineer
 - 2) Geologist
 - 3) Field Engineer
 - 4) Consultant
 - 5) Independent Geologic Consultant
- D. Assignment of Responsibilities
 - 1) Geologist
 - 2) Field Engineer
 - 3) Consultant
 - 4) Independent Geologic Consultant
- E. Requirements for Mapping
 - 1) Phase I - Initial Mapping
 - 2) Phase II - Final Excavation Mapping

SECTION II - TECHNICAL ASPECTS OF MAPPING

SECTION III - INVESTIGATING AND DOCUMENTING GEOLOGIC FAULT FEATURES

D J 3 1 8 4 0 4 6 1

DUKE POWER COMPANY
PROJECT 81
CHEROKEE NUCLEAR STATION
GEOLOGIC MAPPING PROCEDURE

ATTACHMENT

Section I - General Description

A. PURPOSE

The purpose of the geologic mapping program for Cherokee Station is to provide a permanent record of the foundation conditions encountered in areas of safety-related structures as outlined in PSAR Section 2.5.1.2(9). This Section of the procedure outlines the relationship of responsibilities and activities between Design Engineering and Construction Departments, and the Consultants in the following areas:

- Scope of Mapping and Sequence
- Definition of Parties
- Assignment of Responsibilities
- Requirements for Mapping

B. SCOPE OF MAPPING AND SEQUENCE

The geologic mapping required by this procedure shall be performed for certain designated areas including the following major plant structures:

- (1) Power Block Area - (Reactor Building, Auxiliary Building and Turbine Building Complex)
- (2) Nuclear Service Water Pond Dam foundation
- (3) NSW Pond Spillway Control Section foundation
- (4) NSW Pump Structure foundations

The complete program of geologic mapping shall be sequenced in two basic phases depending on the extent of excavation progress.

Phase I - Scale 1"=20' - Mapping of the top of rock before blasting is started in power block area only. Detailed mapping at 1"=5' where necessary.

Phase II - Scale 1"=10' - Mapping of final excavated surfaces. Detailed mapping at 1"=5' where necessary.

When the final foundation grade is above top of rock, no Phase I mapping will be necessary. Scale for final mapping in saprolite shall not be less than 1"=20'.

0 0 3 1 8 4 0 4 6 2

CK 1108 00

C. DEFINITION OF RESPONSIBLE PARTIES

- (1) Responsible Engineer - The Principal Engineer in charge of the responsible Civil Projects Section in the Civil/Environmental Division of Design Engineering Department or his designated representative.
- (2) Geologist - The individual designated by Chief Engineer of Civil/Environmental Division to act as his field representative in any matters pertaining to geologic mapping.
- (3) Field Engineer - The specific individual designated by the Construction Department Project Manager to be responsible for the coordination of all construction support or activities required for carrying out the geologic mapping program.
- (4) Consultant - The person or persons assigned by Law Engineering and Testing Co. (LETCo) with sufficient training and experience to assist with field mapping work and review of drawings and reports when requested by the Geologist or Responsible Engineer.
- (5) Independent Geologic Consultant - A third-party consultant (or consultants) with recognized expertise in the geology of the area engaged specifically for this work. This consultant will provide independent review of fault features and supporting data and conclusions where NRC notification is required for non-similar features as defined in Section III.

D. ASSIGNMENT OF RESPONSIBILITIES

All parties involved in the geologic mapping program will have general overall responsibilities to jointly support the requirement of the mapping program, to pursue their respective assignments in a timely and professional manner, and to assure that the resulting maps, data, reports, and documents are sufficient in content and accuracy to accomplish the purpose intended. The specific scope of responsibility for each of the parties for field mapping work is outlined below:

- (1) Geologist -
 - a. Supervises and coordinates all field geologic activity involved in mapping.
 - b. Schedules mapping of prepared areas designated by the Field Engineer and coordinates required construction support with Field Engineer. Provides Field Engineer with estimate of time required for mapping in specific areas.

0 3 1 8 4 0 4 6 3

- c. Determines the need for and extent of support necessary from Consultant (LETCO) and schedules personnel required for mapping.
- d. Schedules and supervises as necessary all office drafting associated with preparation of geologic maps.
- e. Coordinates review of field and office work, including preparation and review of reports, with Consultant (LETCO).
- f. Schedules and coordinates site visits of Independent Geologic Consultant when visits are required.
- g. Releases investigated areas to Field Engineer after completion of geologic mapping.
- h. When designated, represents Design Engineering during NRC site visits and inspections regarding geologic matters.

(2) Field Engineer -

- a. Schedules availability of areas to be mapped and assures that specific areas are cleaned and maintained until mapping is complete.
- b. Coordinates earthwork operations in areas requiring mapping with Geologist and advises when areas are ready for mapping.
- c. Schedules and coordinates labor, equipment, survey support, and other construction resources as necessary to assure that mapping can be completed as soon as possible.

(3) Consultant (LETCO) -

- a. Provides geologist personnel support for assistance in mapping when requested by the Geologist and/or the Responsible Engineer.
- b. Reviews all maps, drawings, data and reports relating to geology and foundation conditions and offers comments and suggestions as requested by the Geologist and/or the Responsible Engineer.
- c. Provides other specialized assistance in personnel or services if requested by the Geologist and/or the Responsible Engineer.

(4) Independent Geologic Consultant -

- a. Shall provide inspection, review and opinions pertaining to data developed for special features in consultation with Duke and Consultant (LETCO) when requested by the Geologist and/or the Responsible Engineer.

CK 110000

- b. May provide other services as may be necessary if requested by the Responsible Engineer.

E. REQUIREMENTS FOR MAPPING

Phase I - Initial Mapping (Top of Rock)

During early construction on the site, the Geologist will monitor the overall earthmoving activities and will record in a Geologic Field Log and by use of photographs any significant observable geologic features in the areas to be mapped. At an appropriate time before rock excavation begins, the Field Engineer will notify the Geologist when an area will be ready for inspection and mapping. The Field Engineer will coordinate the necessary construction resources to prepare the area for mapping.

Excavated areas will be mapped at elevations where earth and rock materials can no longer be removed with earthmoving equipment and blasting is required for further excavation. Preparation of an area for mapping will normally consist of a general clean-up of loose surface materials and gentle sloping of surfaces, where practicable. Limited portions of the area may have to be cleaned more thoroughly by air or water hoses, etc., to permit more detailed mapping, if features requiring detail study are found.

For areas scheduled to be mapped, the Geologist will schedule appropriate Duke Personnel and LETCO personnel, if required, to carry out the mapping in that area. In areas of exposed rock the Field Engineer will coordinate with survey crews to establish a 20 ft. grid reference system. The grid shall be plainly visible and shall be capable of being easily photographed. Iridescent type paint may be used for marking the grid and elevations shall be determined on certain grid points as requested by the Geologist to assist in map work. A 5 ft. grid may be required in some areas if determined necessary by the Geologist.

If the area to be mapped contains sloped surfaces, at greater than 30° angle from horizontal, or nearly vertical walls, the Geologist may request the Field Engineer to have the slope marked off in grids on the slope area. The Field Engineer shall also schedule and provide appropriate construction equipment or safety-ropes, etc., to allow taking of structural readings on steep slopes as requested by the Geologist. When all mapping of an

0 3 1 8 4 0 4 6 5

area has been completed, the Geologist will release the area to the Field Engineer for subsequent excavation.

Phase II - Final Excavation Mapping

As the excavation of an area to be mapped nears final grade, the Field Engineer will advise the Geologist of the expected date when excavation and cleanup of the area will be complete and available for mapping. The Geologist will then determine the expected mapping completion date based on his estimate of required work for the area.

The area shall be mapped as soon as practicable after it is cleaned. Various special equipment and methods may have to be employed by the Field Engineer to maintain a mappable surface. Normally, visible 10 ft. grid reference points will be provided by the Field Engineer for Phase II mapping. The Geologist shall coordinate the mapping with the Field Engineer so that priority can be placed on any critical portions of an area.

When final mapping has been completed in the area, the Geologist will release that area to the Field Engineer for construction.

0 2 3 1 8 4 0 4 6 6

CK 1108.00

Section II - Technical Mapping Aspects

Geologic features shall be mapped at the top of rock, or Phase I mapping stage, at a scale of 1"=20' on base maps. Any detail mapping of features shall be at a scale of 1"=5'. Photographs reproduced to an appropriate scale may be used as permanent record and for checking field mapping as determined necessary by the Geologist.

In the final Phase II foundation mapping stage, structural data will be taken concurrently with the mapping effort whenever deemed necessary by the field Geologist. Density of structural readings in the powerhouse excavation should be about 2 readings per 10 ft. grid square or as many as deemed necessary by the Geologist to get a representative sample of the geologic features. The data should include measurements of the following types of geologic occurrences, where applicable:

- foliation - type, strike, dip, weathering
- joints - spacing, continuity, separation, roughness fill material, strike, dip
- shear planes
and faults - brecciation, offsets, strike, dip
- contacts - rock types, weathering

As determined by the field Geologist, sufficient samples should be selected for study in thin section. The thin section data obtained should be keyed into the mapping and compared with thin section data obtained during previous studies in the area. For fault features, additional thin sections and other data may be required.

An appropriate index system shall be established to reference samples, features, and data to physical locations in the mapped areas. The system shall be suitable for cross-referencing and grouping of similar and non-similar features.

In addition, any potential problem features that may have engineering significance and will affect structure design or construction due to joints, shear zones or weathered condition of rock should be reported to the Responsible Engineer.

0 3 1 8 4 0 4 6 7

Section III - Investigating and Documenting Geologic Fault FeaturesA. INTRODUCTION

Extensive studies of fault features characteristic of the region and of the project site area have been made at the Catawba Nuclear Station (Docket Nos. 50-413 and -414) during geologic mapping and at the Cherokee project site in support of the Preliminary Safety Analysis Report for project licensing. These studies ⁽¹⁾ establish that numerous fault features occur and can be anticipated in any large excavation in the region.

B. PURPOSE

The purpose of this section is to establish a procedure for investigating and documenting geological fault features. The fault investigation will utilize data from previous studies where applicable.

C. SCOPE

This Investigation relates directly to those geologic fault features occurring in excavations required for safety related structure foundations.

D. PROCEDURE

1. Geologic mapping will be conducted as stated in Cherokee PSAR Section 2.5.1.2(9) and Section IE and Section II of this Procedure.
2. In the event a feature as described below is discovered the (field) Geologist will promptly notify the Responsible Engineer. Features which are reportable to Responsible Engineer may include brecciated zones containing offsets and any other offsets or displaced feature of tectonic origin.
3. The Responsible Engineer will hold any structure construction in an area containing a feature as described in 2 above until a determination

(1) Reference: Catawba Nuclear Station - PSAR, Chapter 2, Section 2.5, Appendices 2C and 2E
 - "Final Geological Report on Brecciated Zones"
 Cherokee Nuclear Station - PSAR, Chapter 2, Section 2.5, Appendices 2C and 2E

0 3 1 8 4 0 4 6 8

can be made 1) that the feature is similar to features previously studied by observation and that its relevant characteristics can be determined by correlation to previously studied features or (2) that the feature is not similar to any previously studied feature and requires new investigation.

4. For similar features (described in item 3(1)), the Geologist will so notify the Responsible Engineer who will release work in the area as soon as the Geologist has indexed the feature, documented it by detailed mapping and photographs, and established the feature's similarity to a previously established feature. This similarity will be documented by comparing relevant characteristics to features observed and studied at Catawba Nuclear Station during mapping or in any of the numerous test pits opened at the Cherokee site during subsurface investigative studies. Where this similarity can be established and documented, mapping and project work will continue routinely. A tabular summary will be prepared which indexes each occurrence of a feature and makes specific comparison to a previously studied feature. Documentation will be subject to audit during field inspections by NRC.
5. For features where similarity cannot be established by comparison to features previously studied at the Cherokee or Catawba sites, the Responsible Engineer will continue to hold work in the area and notify the NRC Project Manager of the discovery. The geologic feature will then be left exposed for ten (10) days for NRC inspection.
 - 5a. Duke with the assistance of Law Engineering Testing Company and/or other consultant will map the feature, develop data, and determine if the feature falls in the sequence of geologic events established and reported in the Cherokee PSAR.
 - 5b. A third party, independent geologic consultant, will be engaged and will visit the site to examine the feature and examine the data developed by Duke and LETCo and/or other consultant. The Geologist will notify the Responsible Engineer (when geologic mapping, photography and field data gathering have been completed) that investigations have been completed and documented. The independent consultant will report his findings to the Responsible Engineer.

0 3 1 8 4 0 4 6 9

CK 1108-00

5c. If the independent geologic consultant concurs with Duke's conclusions, the Responsible Engineer will then release the area for project construction activity upon completion of item 5b.

5d. For non-similar features a report will be prepared which shall consist of the following:

- (1) Description of the feature including the investigation and description of data obtained
- (2) Geologic history
- (3) Summary and conclusions
- (4) Geologic maps and photographs
- (5) Report of findings by Geologic Consultant
- (6) This report and other data will be available for NRC review whenever requested.

0 0 3 1 8 4 0 4 7 0

Addendum to Mapping Procedures
(April 22, 1977)

Transmitted to Law Engineering Company and
Duke Power Company from Clemson University

[Duke File Name:1977-0422 Geo Mapping Letter, Hatcher to Sams and
Pearce (From Duke Microfilm Reel 3184).pdf]

CK 1108.00

APRIL 22, 1977

Mr. I. W. Pearce
Principal Engineer
Civil-Environmental Division
Duke Power Company
P. O. Box 2178
Charlotte, NC 28242

and

Mr. C. E. Sams
Assistant Vice-President
Law Engineering Testing Company
P. O. Box 11297
Charlotte, NC 28209

Dear Sirs:

A meeting was held April 13, 1977, at Cherokee Nuclear Station for the purpose of examining bedrock features in the cleaned area in the Number 1 Turbine Building. Present at the meeting were Malcomb N. Schaeffer, Duke Power Company, Neil J. Gilbert, Law Engineering Testing Company and myself.

The meeting began with a preliminary briefing by Malcomb Schaeffer over lunch. We arrived at the site at about 1:00 PM and joined N. J. Gilbert on the cleaned area in Number 1 Turbine Building. We examined bedrock lithologies and structures and studied the 1" = 20' geologic maps prepared of the cleaned area.

After the examination of bedrock features on the site we returned to the construction site office to discuss the nature of the geologic mapping and more specifically the problems related to 1" = 5' scale mapping and what should be mapped.

The following recommendations were formulated as a result of these discussions:

1. Mapping of features at 1" = 5' scale.

(a) There should be a minimum of 2 feet offset on a fault. This is the threshold of visibility of offset at the 1" = 20' scale.

and/or

(b) There should be 50 feet traceable length on a fault. This is again related to a significant threshold of prominence of a structural feature on a 1" = 20' scale map.

and/or

(c) Cataclastic zones of significant thickness. A minimum thickness of 1 foot is arbitrarily chosen.

Corollary to the above:

Combinations of greater offset with less traceable length and/or thicker

0 3 1 8 4 0 6 2 7

Addendum to Mapping Procedures
(April 22, 1977)

Transmitted to Law Engineering Company and
Duke Power Company from Clemson University

[Duke File Name: 1977-0422 Geo Mapping Letter, Hatcher to Sams and
Pearce (From Duke MFS CK1108.00).pdf]

Mr. I. W. Pearce
Principal Engineer
Civil-Environmental Division
Duke Power Company
P. O. Box 2178
Charlotte, NC 28242

and

Mr. C. E. Sams
Assistant Vice-President
Law Engineering Testing Company
P. O. Box 11297
Charlotte, NC 28209

Dear Sirs:

A meeting was held April 13, 1977, at Cherokee Nuclear Station for the purpose of examining bedrock features in the cleaned area in the Number 1 Turbine Building. Present at the meeting were Malcomb N. Schaeffer, Duke Power Company, Neil J. Gilbert, Law Engineering Testing Company and myself.

The meeting began with a preliminary briefing by Malcomb Schaeffer over lunch. We arrived at the site at about 1:00 PM and joined N. J. Gilbert on the cleaned area in Number 1 Turbine Building. We examined bedrock lithologies and structures and studied the 1" = 20' geologic maps prepared of the cleaned area.

After the examination of bedrock features on the site we returned to the construction site office to discuss the nature of the geologic mapping and more specifically the problems related to 1" = 5' scale mapping and what should be mapped.

The following recommendations were formulated as a result of these discussions:

1. Mapping of features at 1" = 5' scale.

(a) There should be a minimum of 2 feet offset on a fault. This is the threshold of visibility of offset at the 1" = 20' scale.

and/or

(b) There should be 50 feet traceable length on a fault. This is again related to a significant threshold of prominence of a structural feature on a 1" = 20' scale map.

and/or

(c) Cataclastic zones of significant thickness. A minimum thickness of 1 foot is arbitrarily chosen.

Corollary to the above:

Combinations of greater offset with less traceable length and/or thicker

Mr. I. W. Pearce,
Mr. C. E. Sams
April 22, 1977
Page -2-


cataclastic zones may in the Geologist's judgment warrant 1" = 5' scale mapping. Also, greater traceable length and lesser offset may likewise require 1" = 5' scale mapping.

2. Repetitious sampling of features otherwise established as similar during the initial phases of the top of rock mapping program should not be undertaken. However, samples should be taken at the discretion of the Geologist.

We returned to the site at 5:25 P.M. after the above recommendations were formulated and examined a fault previously not seen by the Independent Geologic Consultant. The above recommendations were applied to this fault and appeared to work well.

The meeting was adjourned at 6:00 P.M.

Sincerely,

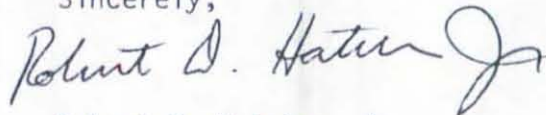

Robert D. Hatcher, Jr.
Professor of Geology
Clemson University
Clemson, SC 29631

RDH:sr

cc: Dr. Donald T. Secor, Jr.

Duke Power Company
Project 81
Cherokee Nuclear Station
Geologic Mapping Procedure
(November 30, 1976)

Transmitted to Law Engineering Testing Co. from Duke Power Company
[Duke File Name:1976-1130 Geologic Mapping Procedure, Pearce to Sams
(From LETCo Cherokee Files).pdf]

DUKE POWER COMPANY

P. O. BOX 2178

GENERAL OFFICES
422 SOUTH CHURCH STREET
CHARLOTTE, N. C. 28201

TELEPHONE: AREA 704
374-4011

November 30, 1976

COPY TO NEIL GILBERT

Mr. C. E. Sams
Law Engineering Testing Co.
P. O. Box 11297
Charlotte, N. C. 28209


RE: Cherokee 1-3
Geologic Mapping
File No: CK-1108.00

Dear Mr. Sams:

Attached is a copy of the procedure we propose to use for geologic mapping at Cherokee for your review. Please plan to meet with us at the Electric Center on ~~Monday~~, December 13, 1976, at 2:00 p.m. to discuss our overall mapping program at Cherokee and Law Engineering's role in that program. We can discuss any comments you might have on the procedure at that time.

Yours very truly,

L. C. Dail, Chief Engineer
Civil/Environmental Division


By: I. W. Pearce, Principal Engineer

IWP/gc

Attachment

cc: C. Q. Reeves
D. R. Privett
M. F. Schaeffer

Geologic Mapping Procedure
Outline

SECTION I - GENERAL DESCRIPTION

- A. Purpose
- B. Scope of Mapping and Sequence
- C. Definition of Responsible Parties
 - 1) Responsible Engineer
 - 2) Geologist - MALCOLM SCHAEFFER
 - 3) Field Engineer
 - 4) Consultant
 - 5) Independent Geologic Consultant
- D. Assignment of Responsibilities
 - 1) Geologist
 - 2) Field Engineer
 - 3) Consultant
 - 4) Independent Geologic Consultant
- E. Requirements for Mapping
 - 1) Phase I - Initial Mapping
 - 2) Phase II - Final Excavation Mapping

SECTION II - TECHNICAL ASPECTS OF MAPPING

SECTION III - INVESTIGATING AND DOCUMENTING GEOLOGIC FAULT FEATURES

DUKE POWER COMPANY
PROJECT 81
CHEROKEE NUCLEAR STATION
GEOLOGIC MAPPING PROCEDURE

Section I - General Description

A. PURPOSE

The purpose of the geologic mapping program for Cherokee Station is to provide a permanent record of the foundation conditions encountered in areas of safety-related structures as outlined in PSAR Section 2.5.1.2(9). This Section of the procedure outlines the relationship of responsibilities and activities between Design Engineering and Construction Departments, and the Consultants in the following areas:

- Scope of Mapping and Sequence
- Definition of Parties
- Assignment of Responsibilities
- Requirements for Mapping

B. SCOPE OF MAPPING AND SEQUENCE

The geologic mapping required by this procedure shall be performed for certain designated areas including the following major plant structures:

- (1) Power Block Area - (Reactor Building, Auxiliary Building and Turbine Building Complex)
- (2) Nuclear Service Water Pond Dam foundation
- (3) NSW Pond Spillway Control Section foundation
- (4) NSW Pump Structure foundations

The complete program of geologic mapping shall be sequenced in two basic phases depending on the extent of excavation progress.

Phase I - Scale 1"=20' - Mapping of the top of rock before blasting is started in power block area only. Detailed mapping at 1"=5' where necessary.

Phase II - Scale 1"=10' - Mapping of final excavated surfaces. Detailed mapping at 1"=5' where necessary.

When the final foundation grade is above top of rock, no Phase I mapping will be necessary. Scale for final mapping in saprolite shall not be less than 1"=20'.

C. DEFINITION OF RESPONSIBLE PARTIES

- (1) Responsible Engineer - The Principal Engineer in charge of the responsible Civil Projects Section in the Civil/Environmental Division of Design Engineering Department or his designated representative. I.W. PEARCE
Alternate: COP. pers.
- (2) Geologist - The individual designated by Chief Engineer of Civil/Environmental Division to act as his field representative in any matters pertaining to geologic mapping. } MALCOLM
- (3) Field Engineer - The specific individual designated by the Construction Department Project Manager to be responsible for the coordination of all construction support or activities required for carrying out the geologic mapping program.
- (4) Consultant - The person or persons assigned by Law Engineering and Testing Co. (LETCo) with sufficient training and experience to assist with field mapping work and review of drawings and reports when requested by the Geologist or Responsible Engineer.
- (5) Independent Geologic Consultant - A third-party consultant (or consultants) with recognized expertise in the geology of the area engaged specifically for this work. This consultant will provide independent review of fault features and supporting data and conclusions where NRC notification is required for non-similar features as defined in Section III. Bob Fletcher

D. ASSIGNMENT OF RESPONSIBILITIES

All parties involved in the geologic mapping program will have general overall responsibilities to jointly support the requirement of the mapping program, to pursue their respective assignments in a timely and professional manner, and to assure that the resulting maps, data, reports, and documents are sufficient in content and accuracy to accomplish the purpose intended. The specific scope of responsibility for each of the parties for field mapping work is outlined below:

- (1) Geologist -
 - a. Supervises and coordinates all field geologic activity involved in mapping.
 - b. Schedules mapping of prepared areas designated by the Field Engineer and coordinates required construction support with Field Engineer. Provides Field Engineer with estimate of time required for mapping in specific areas.

- c. Determines the need for and extent of support necessary from Consultant (LETCO) and schedules personnel required for mapping.
 - d. Schedules and supervises as necessary all office drafting associated with preparation of geologic maps.
 - e. Coordinates review of field and office work, including preparation and review of reports, with Consultant (LETCO).
 - f. Schedules and coordinates site visits of Independent Geologic Consultant when visits are required.
 - g. Releases investigated areas to Field Engineer after completion of geologic mapping.
 - h. When designated, represents Design Engineering during NRC site visits and inspections regarding geologic matters.
- (2) Field Engineer -
- a. Schedules availability of areas to be mapped and assures that specific areas are cleaned and maintained until mapping is complete.
 - b. Coordinates earthwork operations in areas requiring mapping with Geologist and advises when areas are ready for mapping.
 - c. Schedules and coordinates labor, equipment, survey support, and other construction resources as necessary to assure that mapping can be completed as soon as possible.
- (3) Consultant (LETCO) -
- a. Provides geologist personnel support for assistance in mapping when requested by the Geologist and/or the Responsible Engineer.
 - b. Reviews all maps, drawings, data and reports relating to geology and foundation conditions and offers comments and suggestions as requested by the Geologist and/or the Responsible Engineer.
 - c. Provides other specialized assistance in personnel or services if requested by the Geologist and/or the Responsible Engineer.
- (4) Independent Geologic Consultant -
- a. Shall provide inspection, review and opinions pertaining to data developed for special features in consultation with Duke and Consultant (LETCO) when requested by the Geologist and/or the Responsible Engineer.

- b. May provide other services as may be necessary if requested by the Responsible Engineer.

E. REQUIREMENTS FOR MAPPING

Phase I - Initial Mapping (Top of Rock)

During early construction on the site, the Geologist will monitor the overall earthmoving activities and will record in a Geologic Field Log and by use of photographs any significant observable geologic features in the areas to be mapped. At an appropriate time before rock excavation begins, the Field Engineer will notify the Geologist when an area will be ready for inspection and mapping. The Field Engineer will coordinate the necessary construction resources to prepare the area for mapping.

Excavated areas will be mapped at elevations where earth and rock materials can no longer be removed with earthmoving equipment and blasting is required for further excavation. Preparation of an area for mapping will normally consist of a general clean-up of loose surface materials and gentle sloping of surfaces, where practicable. Limited portions of the area may have to be cleaned more thoroughly by air or water hoses, etc., to permit more detailed mapping, if features requiring detail study are found.

For areas scheduled to be mapped, the Geologist will schedule appropriate Duke Personnel and LETCO personnel, if required, to carry out the mapping in that area. In areas of exposed rock the Field Engineer will coordinate with survey crews to establish a 20 ft. grid reference system. The grid shall be plainly visible and shall be capable of being easily photographed. Iridescent type paint may be used for marking the grid and elevations shall be determined on certain grid points as requested by the Geologist to assist in map work. A 5 ft. grid may be required in some areas if determined necessary by the Geologist.

If the area to be mapped contains sloped surfaces, at greater than 30° angle from horizontal, or nearly vertical walls, the Geologist may request the Field Engineer to have the slope marked off in grids on the slope area. The Field Engineer shall also schedule and provide appropriate construction equipment or safety-ropes, etc., to allow taking of structural readings on steep slopes as requested by the Geologist. When all mapping of an

area has been completed, the Geologist will release the area to the Field Engineer for subsequent excavation.

Phase II - Final Excavation Mapping

As the excavation of an area to be mapped nears final grade, the Field Engineer will advise the Geologist of the expected date when excavation and cleanup of the area will be complete and available for mapping. The Geologist will then determine the expected mapping completion date based on his estimate of required work for the area.

The area shall be mapped as soon as practicable after it is cleaned. Various special equipment and methods may have to be employed by the Field Engineer to maintain a mappable surface. Normally, visible 10 ft. grid reference points will be provided by the Field Engineer for Phase II mapping. The Geologist shall coordinate the mapping with the Field Engineer so that priority can be placed on any critical portions of an area.

When final mapping has been completed in the area, the Geologist will release that area to the Field Engineer for construction.

Section II - Technical Mapping Aspects

Geologic features shall be mapped at the top of rock, or Phase I mapping stage, at a scale of 1"=20' on base maps. Any detail mapping of features shall be at a scale of 1"=5'. Photographs reproduced to an appropriate scale may be used as permanent record and for checking field mapping as determined necessary by the Geologist.

In the final Phase II foundation mapping stage, structural data will be taken concurrently with the mapping effort whenever deemed necessary by the field Geologist. Density of structural readings in the powerhouse excavation should be about 2 readings per 10 ft. grid square or as many as deemed necessary by the Geologist to get a representative sample of the geologic features. The data should include measurements of the following types of geologic occurrences, where applicable:

- foliation - type, strike, dip, weathering
- joints - spacing, continuity, separation, roughness fill material, strike, dip
- shear planes and faults - brecciation, offsets, strike, dip
- contacts - rock types, weathering

As determined by the field Geologist, sufficient samples should be selected for study in thin section. The thin section data obtained should be keyed into the mapping and compared with thin section data obtained during previous studies in the area. For fault features, additional thin sections and other data may be required.

An appropriate index system shall be established to reference samples, features, and data to physical locations in the mapped areas. The system shall be suitable for cross-referencing and grouping of similar and non-similar features.

In addition, any potential problem features that may have engineering significance and will affect structure design or construction due to joints, shear zones or weathered condition of rock should be reported to the Responsible Engineer.

can be made 1) that the feature is similar to features previously studied by observation and that its relevant characteristics can be determined by correlation to previously studied features or (2) that the feature is not similar to any previously studied feature and requires new investigation.

4. For similar features (described in item 3(1)), the Geologist will so notify the Responsible Engineer who will release work in the area as soon as the Geologist has indexed the feature, documented it by detailed mapping and photographs, and established the feature's similarity to a previously established feature. This similarity will be documented by comparing relevant characteristics to features observed and studied at Catawba Nuclear Station during mapping or in any of the numerous test pits opened at the Cherokee site during subsurface investigative studies. Where this similarity can be established and documented, mapping and project work will continue routinely. A tabular summary will be prepared which indexes each occurrence of a feature and makes specific comparison to a previously studied feature. Documentation will be subject to audit during field inspections by NRC.
5. For features where similarity cannot be established by comparison to features previously studied at the Cherokee or Catawba sites, the Responsible Engineer will continue to hold work in the area and notify the NRC Project Manager of the discovery. The geologic feature will then be left exposed for ten (10) days for NRC inspection.
 - 5a. Duke with the assistance of Law Engineering Testing Company and/or other consultant will map the feature, develop data, and determine if the feature falls in the sequence of geologic events established and reported in the Cherokee PSAR.
 - 5b. A third party, independent geologic consultant, will be engaged and will visit the site to examine the feature and examine the data developed by Duke and LETCo and/or other consultant. The Geologist will notify the Responsible Engineer (when geologic mapping, photography and field data gathering have been completed) that investigations have been completed and documented. The independent consultant will report his findings to the Responsible Engineer.

5c. If the independent geologic consultant concurs with Duke's conclusions, the Responsible Engineer will then release the area for project construction activity upon completion of item 5b.

5d. For non-similar features a report will be prepared which shall consist of the following:

- (1) Description of the feature including the investigation and description of data obtained
- (2) Geologic history
- (3) Summary and conclusions
- (4) Geologic maps and photographs
- (5) Report of findings by Geologic Consultant
- (6) This report and other data will be available for NRC review whenever requested.

Addendum to Mapping Procedures
(April 22, 1977)

Transmitted to Law Engineering Company and
Duke Power Company from Clemson University

[Duke File Name:1977-0422 Geo Mapping Letter, Hatcher to Sams and
Pearce (From LETCo Cherokee Files).pdf]

✓
14
4-27

Mr. C. E. Sams
Assistant Vice-President
Law Engineering Testing Company
P. O. Box 11297
Charlotte, NC 28209

and

Mr. I. W. Pearce
Principal Engineer
Civil-Environmental Division
Duke Power Company
P. O. Box 2178
Charlotte, NC 28242

Dear Sirs:

A meeting was held April 13, 1977, at Cherokee Nuclear Station for the purpose of examining bedrock features in the cleaned area in the Number 1 Turbine Building. Present at the meeting were Malcomb N. Schaeffer, Duke Power Company, Neil J. Gilbert, Law Engineering Company and myself.

The meeting began with a preliminary briefing by Malcomb Schaeffer over lunch. We arrived at the site at about 1:00 PM and joined N. J. Gilbert on the cleaned area in Number 1 Turbine Building. We examined bedrock lithologies and structures and studied the 1" = 20' geologic maps prepared of the cleaned area.

After the examination of bedrock features on the site we returned to the construction site office to discuss the nature of the geologic mapping and more specifically the problems related to 1" = 5' scale mapping and what should be mapped.

The following recommendations were formulated as a result of these discussions:

1. Mapping of features at 1" = 5' scale.

- (a) There should be a minimum of 2 feet offset on a fault. This is the threshold of visibility of offset at the 1" = 20' scale.

and/or

- (b) There should be 50 feet traceable length on a fault. This is again related to a significant threshold of prominence of a structural feature on a 1" = 20' scale map.

and/or

- (c) Cataclastic zones of significant thickness. A minimum thickness of 1 foot is arbitrarily chosen.

Mr. C. E. Sams
Mr. I. W. Pearce
April 22, 1977
Page -2-

Corollary to the above:


Combinations of greater offset with less traceable length and/or thicker cataclastic zones may in the Geologist's judgment warrant 1" = 5' scale mapping. Also, greater traceable length and lesser offset may likewise require 1" = 5' scale mapping.

2. Repetitious sampling of features otherwise established as similar during the initial phases of the top of rock mapping program should not be undertaken. However, samples should be taken at the discretion of the Geologist.

We returned to the site at 5:25 P.M. after the above recommendations were formulated and examined a fault previously not seen by the Independent Geologic Consultant. The above recommendations were applied to this fault and appeared to work well.

The meeting was adjourned at 6:00 P.M.

Sincerely,

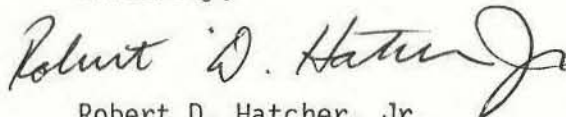

Robert D. Hatcher, Jr.
Professor of Geology
Clemson University
Clemson, SC 29631

RDH:sr

cc: Dr. Donald T. Secor, Jr.

Data Verification Summary

Data Verification Title: Cherokee Nuclear Station Service Building Final Foundation Field Maps (SB1 and SB2)

ID Number: HRO-FWLA-002

Date of Qualification Review Team Meeting: November 12, 2010

Quality Review Team:

Name	Sign (Initials)	Organization	Qualifications
Jim Cassidy	JRC 1 Dec 2010	Duke Energy	QA/QC Verification
John McConaghy	JMM 30 Nov 10	Duke Energy	Engineering
Juan Vizcaya	JV	Enercon Services Inc.	Engineering
Malcolm Schaeffer	MFS	HDR/DTA	Former Duke Power Project Geologist
Michael Gray	MGG	FWLA	Project Principal Geologist
Adam Wade	AWW	FWLA	Project Geologist

Data / Evidence Considered During the Reviews:

The contents of the files outlined in attachment 2 were reviewed for applicability and completeness.

Critical Attributes Considered During the Reviews:

Files comprise the hand drawn field maps, documenting observed foundation level mapping conducted at the former Cherokee Nuclear Station (CNS) Service Building.

Basis for Qualification / Non-Qualification:

The data is qualified to use in WLS evaluations to document final foundation geology beneath former CNS Service Building. The information documented in these files were acquired, prepared, and verified using the applicable specifications and Duke QA procedures governing at the time of gathering and preparation. The CNS Service Building final foundation field geologic maps may be used in corroboration of information.

These field maps will be used, in addition to the CNS Units 1 and 2 maps, as inputs to develop a final foundation map record to support geologic evaluations as part of WLS COLA.

Is the data considered Nuclear Safety Related QA Qualified? Yes (Yes / No)

Recommendations for Additional Qualification Activities:

None

Dissenting conclusions or comments: If the team reaches consensus, enter "None" here. Otherwise, document the dissenting view as follows:

Reviewer Name and Organization: _____

Dissenting Statement: _____ None _____

Signature and Date: _____

I hereby certify this Data Verification Package is complete:

Quality Review Team Lead: Michael A. Guy (Sign) Date: 12/02/2010

I approve this Data Verification Package for the usage identified above:

Approved By: RJ Morgan Jr. R.L. Morgan, Jr. (Sign) Date: 12/02/2010

(Duke Project Manager or designee)

Data Verification Planning Form

Data Verification Title: Cherokee Nuclear Station
Service Building Final Foundation Maps (SB1 and
SB2)

ID Number: HRO-FWLA-002

Scope of Historical Data Requiring Review:

Two hand drawn field geologic maps at 1"=10' scale of final excavated surface of the
Service Building for the Cherokee Nuclear Station (CNS). Mapping was performed during
CNS construction from 1977 to 1982. Attachment 1 summarizes the individual field maps
to be qualified. Attachment 2 contains .pdf copies of the hand drawn map panels.

Attachment 3 contains a copy of the record transmittal. Attachment 4 contains a copy of
the written mapping procedures and addendum for the final excavation mapping program.

Purpose / Applicability of Data: _____

These field maps will be used, in addition to the CNS Units 1 and 2 maps, as inputs to
develop a final foundation map record to support geologic evaluations as part of WLS
COLA.

Methods of Verification (X):

Peer Review _____ Data Corroboration Confirmatory Testing _____

Rationale: _____

The field maps generated for this project were produced using approved standards
and procedures by Duke Power Company, now Duke-Energy. They represent an in-process
product with status as of the time work on the Cherokee project was stopped. A copy of the
Duke Power mapping procedure and addendum is provided in Attachment 4. Current-era
work will compile information from these field maps to support licensing and
construction of Lee Nuclear Station.

Need for Data Qualification Affirmed By: Michael Gray **Date:** 10/15/2010
FWLA Project Manager (or designee)

Required Organizations for Verification:

FWLA with support from Duke-Energy and Enercon.

Duke Approval of Scope and Methods Used: RJ Morgan Jr RL Morgan Jr **Date:** 12/02/2010
Duke Project Manager (or designee)

Attachments:

- Attachment 1 Listing of Field Maps to be Qualified
- Attachment 2 CNS Service Building Final Foundation Field Maps SB1 and SB2
- Attachment 3 Record Transmittals
- Attachment 4 Duke Power Company Mapping Procedures and Addendum


ATTACHMENT 1

Listing of Field Maps to be Qualified

Duke Energy Records Designation			CNS Records Designation	CNS Map Phase
Folder Name	File Name	Date of Transmittal	Map Panel Designation	Phase II map 1"=10'
Service Building	122_20101012.JPG	10/13/2010	SB1	X
	123_20101012.JPG	10/13/2010	SB2	X

ATTACHMENT 2

CNS Service Building Final Foundation Field Maps (SB1 and SB2)

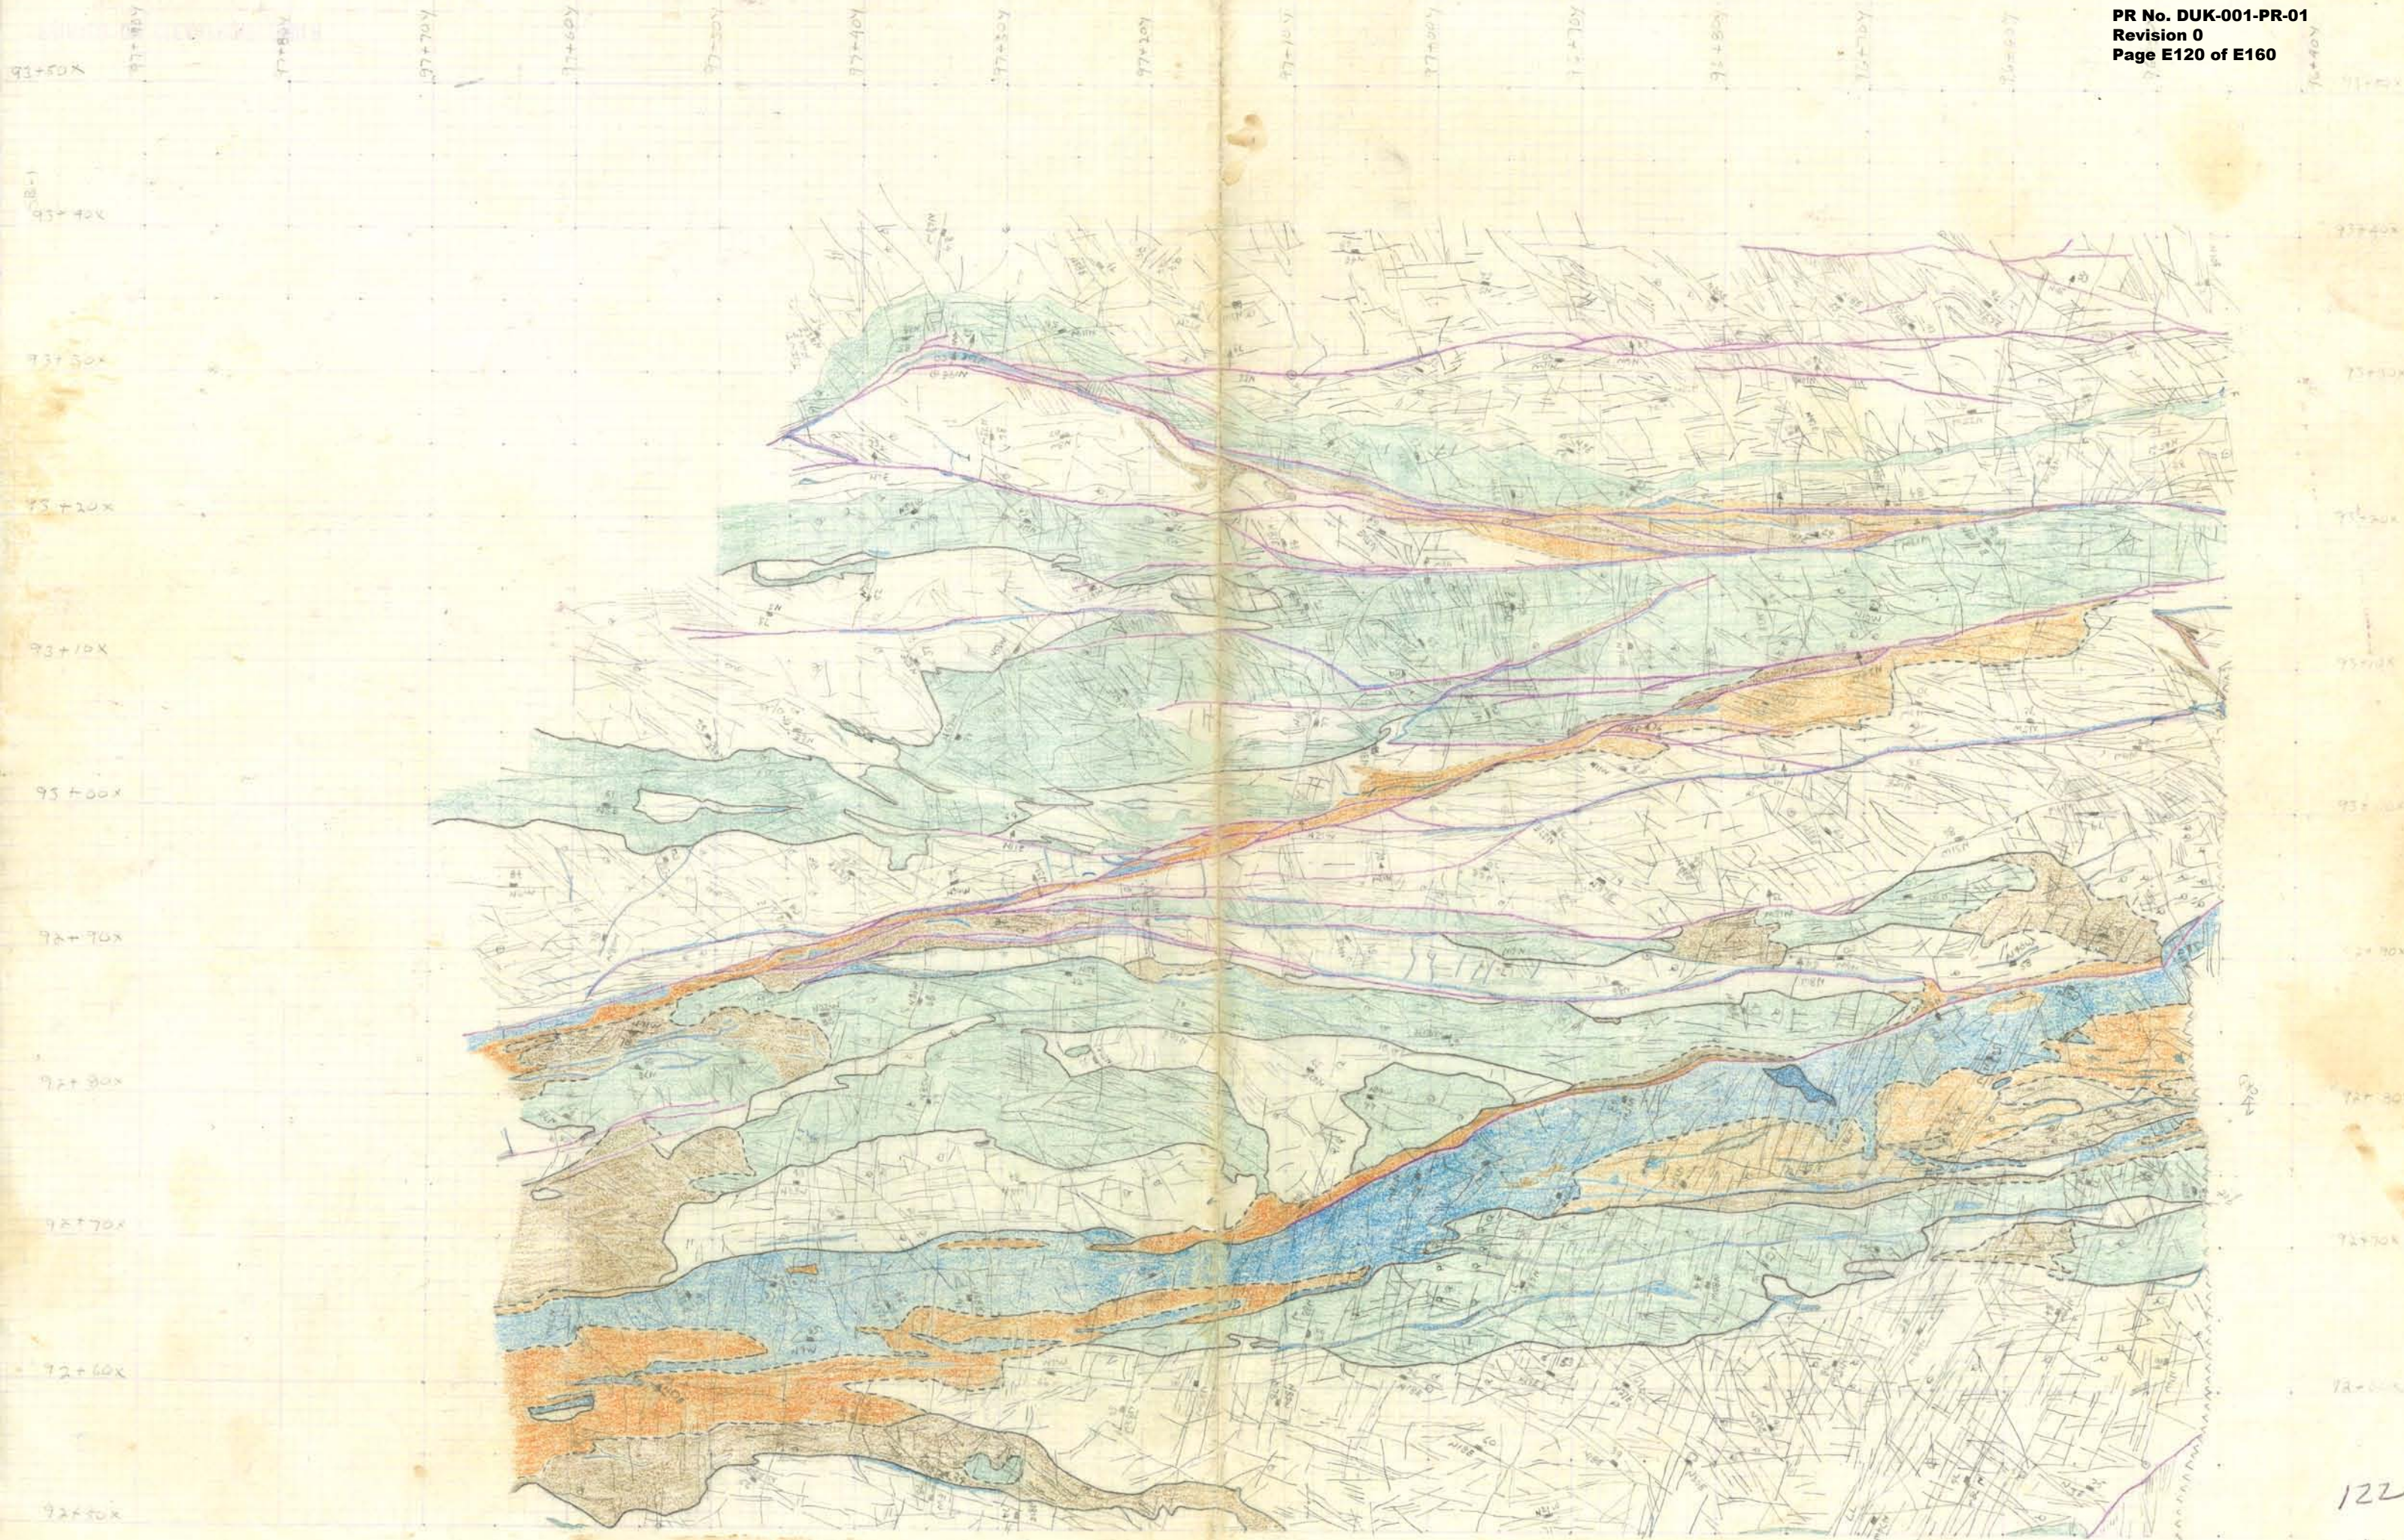

91450 X
91460 X
91470 X
91480 X
91490 X
91500 X
91510 X
91520 X
91530 X
91540 X
91550 X

91460 X
91470 X
91480 X
91490 X
91500 X
92100 X
92110 X
92120 X
92130 X
92140 X
92150 X



ATTACHMENT 3

Record Transmittals:

Top of Rock Map Panels, Wall Map Panels, and Service Building Foundation Maps
Transmitted to FWLA from Duke Energy (October 13, 2010)

*Final Foundation Index Map, Geologic Mapping Procedure, and Supplemental Mapping
Guidance*
Transmittal to FWLA from Duke Energy (November 23, 2010)



REC'D 10/15/10
MGG

PR No. DUK-001-PR-01
Revision 0
Page E123 of E160
EC09D/ 526 South Church Street
Charlotte, NC 28201-1006

Mailing Address:
P.O. Box 1006 - EC09D
Charlotte, NC 28201-1006
704-382-7830
704-382-2038 fax

October 13, 2010

Mr. Tom Slavonic
Enercon Services
4490 Old William Penn Highway
Murrysville, PA 15668

Subject: Top of Rock Map Panels, Wall Map Panels, and Service Building Foundation Maps

Dear Tom:

During our recent review of surviving Cherokee-era working documents at the Duke offices, Malcolm Schaeffer pointed out the Service Building foundation maps that had been missing during our current mapping project. Malcolm also identified complete sets of Top-of-Rock Map panels, and Wall Map panels. These items have been scanned again consistent with FWLA's needs for the mapping tasks, and the scans are contained on the attached CD. The files are identified as shown in the attached listing.

If you have questions, please call me at 704-382-7830.

Sincerely,



John M. McConaghy, Jr.
Engineering Consultant

Enclosure: 1 CD as described

cc: ~~Mike Gray~~, FWLA (w/ enclosure)
Malcolm Schaeffer, HDR|DTA (w/ enclosure)
R.L. Morgan (w/o enclosure)
J.S. Thrasher (w/o enclosure)
J.R. Cassidy (w/o enclosure)
4000.01-09 (w/ enclosure)

Mr. Tom Slavonic
October 13, 2010
Page 2 of 3

Listing of CD Folders and Files (sheet 1 of 2)

Volume in drive D is TopRock_WallMaps
Volume Serial Number is 5973-956A

Directory of D:\

10/13/2010 11:31 AM <DIR> Additional Cherokee-Era Geologic Mapping Scans
0 File(s) 0 bytes

Directory of D:\Additional Cherokee-Era Geologic Mapping Scans

10/13/2010 11:31 AM <DIR> .
10/13/2010 12:35 PM <DIR> ..
10/13/2010 11:32 AM <DIR> Final Fdn Maps - CK-10 Series MLS Folder 13
10/12/2010 04:34 PM <DIR> Service Building
10/12/2010 04:49 PM <DIR> Top of Rock Maps - CK-20 Series MLS Folder 14
10/13/2010 11:28 AM <DIR> Wall Maps - U1 MLS Folder13, U2 MLS Folder 8
0 File(s) 0 bytes

Directory of D:\Additional Cherokee-Era Geologic Mapping Scans\Final Fdn Maps - CK-10 Series MLS Folder 13

10/13/2010 11:32 AM <DIR> .
10/13/2010 11:31 AM <DIR> ..
10/13/2010 11:32 AM 0 CK-10 Series Previously Transmitted
1 File(s) 0 bytes

Directory of D:\Additional Cherokee-Era Geologic Mapping Scans\Service Building

10/12/2010 04:34 PM <DIR> .
10/13/2010 11:31 AM <DIR> ..
10/12/2010 01:37 PM 9,940,479 122_20101012.jpg
10/12/2010 01:39 PM 8,052,850 123_20101012.jpg
2 File(s) 17,993,329 bytes

Directory of D:\Additional Cherokee-Era Geologic Mapping Scans\Top of Rock Maps - CK-20 Series MLS Folder 14

10/12/2010 04:49 PM <DIR> .
10/13/2010 11:31 AM <DIR> ..
10/12/2010 04:01 PM 9,759,896 ck20-01_20101012_01.jpg
10/12/2010 04:01 PM 10,078,809 ck20-01_20101012_02.jpg
10/12/2010 04:01 PM 7,392,250 ck20-01_20101012_03.jpg
10/12/2010 04:02 PM 5,777,591 ck20-01_20101012_04.jpg
10/12/2010 04:02 PM 6,444,427 ck20-01_20101012_05.jpg
10/12/2010 04:02 PM 3,044,212 ck20-01_20101012_06.jpg
10/12/2010 04:07 PM 10,434,397 ck20-02_20101012_01.jpg
10/12/2010 04:07 PM 8,846,726 ck20-02_20101012_02.jpg
10/12/2010 04:07 PM 5,825,793 ck20-02_20101012_03.jpg
10/12/2010 04:08 PM 7,966,907 ck20-02_20101012_04.jpg
10/12/2010 04:08 PM 8,680,759 ck20-02_20101012_05.jpg
10/12/2010 04:08 PM 8,930,141 ck20-02_20101012_06.jpg
10/12/2010 04:11 PM 10,252,712 ck20-03_20101012_01.jpg
10/12/2010 04:12 PM 6,575,732 ck20-03_20101012_02.jpg

Mr. Tom Slavonic
October 13, 2010
Page 3 of 3

Listing of CD Folders and Files (sheet 2 of 2)

10/12/2010	04:12	PM	10,406,620	ck20-03_20101012_03.jpg
10/12/2010	04:12	PM	5,645,841	ck20-03_20101012_04.jpg
10/12/2010	04:13	PM	5,598,919	ck20-03_20101012_05.jpg
10/12/2010	04:13	PM	8,563,547	ck20-03_20101012_06.jpg
10/12/2010	04:15	PM	7,499,550	ck20-04_20101012_01.jpg
10/12/2010	04:16	PM	7,083,395	ck20-04_20101012_02.jpg
10/12/2010	04:16	PM	6,270,975	ck20-04_20101012_03.jpg
10/12/2010	04:16	PM	6,477,375	ck20-04_20101012_04.jpg
10/12/2010	04:18	PM	10,175,323	ck20-05_20101012_01.jpg
10/12/2010	04:19	PM	5,249,532	ck20-05_20101012_02.jpg
10/12/2010	04:19	PM	6,875,786	ck20-05_20101012_03.jpg
10/12/2010	04:19	PM	4,993,186	ck20-06_20101012_01.jpg
03/08/2007	12:03	PM	51,123,852	CK21-05A-002 Top of Rock Map Index.tif
			27 File(s)	245,974,253 bytes

Directory of D:\Additional Cherokee-Era Geologic Mapping Scans\Wall Maps - U1 MLS
Folder13, U2 MLS Folder 8

10/13/2010	11:28	AM	<DIR>	.
10/13/2010	11:31	AM	<DIR>	..
10/12/2010	03:36	PM	7,080,008	U1_wall_maps_20101012_01.jpg
10/12/2010	03:36	PM	4,285,881	U1_wall_maps_20101012_02.jpg
10/12/2010	03:36	PM	6,711,437	U1_wall_maps_20101012_03.jpg
10/12/2010	03:36	PM	5,910,759	U1_wall_maps_20101012_04.jpg
10/12/2010	03:36	PM	5,351,665	U1_wall_maps_20101012_05.jpg
10/12/2010	03:37	PM	5,696,710	U1_wall_maps_20101012_06.jpg
10/12/2010	03:37	PM	6,749,387	U1_wall_maps_20101012_07.jpg
10/12/2010	03:37	PM	2,149,403	U1_wall_maps_20101012_08.jpg
10/12/2010	03:37	PM	2,005,658	U1_wall_maps_20101012_09.jpg
10/12/2010	03:37	PM	5,404,262	U1_wall_maps_20101012_10.jpg
10/12/2010	03:38	PM	5,481,555	U1_wall_maps_20101012_11.jpg
10/12/2010	03:38	PM	6,481,455	U1_wall_maps_20101012_12.jpg
10/12/2010	03:38	PM	6,406,683	U1_wall_maps_20101012_13.jpg
10/12/2010	03:38	PM	5,417,767	U1_wall_maps_20101012_14.jpg
10/12/2010	03:39	PM	5,595,000	U1_wall_maps_20101012_15.jpg
10/12/2010	03:39	PM	5,830,501	U1_wall_maps_20101012_16.jpg
10/12/2010	03:39	PM	5,900,371	U1_wall_maps_20101012_17.jpg
10/12/2010	03:39	PM	6,162,857	U1_wall_maps_20101012_18.jpg
10/12/2010	02:37	PM	3,945,702	U1_wall_maps_20101012-1.jpg
10/12/2010	02:38	PM	2,790,311	U1_wall_maps_20101012-2.jpg
10/12/2010	02:39	PM	5,221,707	U1_wall_maps_20101012-3.jpg
10/12/2010	02:43	PM	6,149,398	U1_wall_maps_20101012-4.jpg
10/13/2010	11:10	AM	5,421,496	U2_wall_maps_20101013_125_PartA.jpg
10/13/2010	11:09	AM	5,670,236	U2_wall_maps_20101013_125_PartB.jpg
10/13/2010	11:10	AM	5,480,150	U2_wall_maps_20101013_126.jpg
10/13/2010	11:10	AM	5,564,012	U2_wall_maps_20101013_127.jpg
10/13/2010	11:10	AM	7,773,212	U2_wall_maps_20101013_128.jpg
10/13/2010	11:10	AM	4,793,258	U2_wall_maps_20101013_129.jpg
10/13/2010	11:10	AM	2,908,704	U2_wall_maps_20101013_130.jpg
10/13/2010	11:11	AM	4,569,143	U2_wall_maps_20101013_131.jpg
			30 File(s)	158,908,688 bytes

Total Files Listed:
60 File(s) 422,876,270 bytes
15 Dir(s) 0 bytes free



Mailing Address:
P.O. Box 1006 – EC09D
Charlotte, NC 28201-1006
704-382-7830
704-382-2038 fax

November 23, 2010

Mr. Tom Slavonic
Enercon Services
4490 Old William Penn Highway
Murrysville, PA 15668

Subject: Final Foundation Index Map, Geologic Mapping Procedure, and
Supplemental Mapping Guidance

Dear Tom:

After our recent teleconference on qualification of Cherokee legacy geologic mapping documentation, Adam Wade pointed out that FWLA still needed to receive controlled distribution of several documents, including the Final Foundation Index Map, and the geologic mapping procedures, as well as input on those procedures from Dr. Hatcher. The attached CD contains these documents, as retrieved from several sources.

The files whose file name includes a Duke microfilm reel number were obtained from scans of microfilm records from Duke archives, and can be identified by the reel and frame number stenciled at the left of each page. The document whose name contains “MFS CK1108.00” was retrieved from Malcolm Schaeffer’s Cherokee correspondence files that are now maintained as part of the Lee project documentation. The documents containing “LETCo” in the filename were retrieved from the Law Engineering Cherokee files at MACTEC.

Comparison of the Duke and Law versions of the Geologic Mapping procedure give high confidence that the content of the two is the same, and reflects the procedures used in the field.

The Duke archive microfilm record contains only the first page of Dr. Hatcher’s letter, but it is the same as the first page of Mr. Schaeffer’s complete (two-page) document. Comparing Mr. Schaeffer’s CK1108.00 complete Hatcher document to the comparable document from Law, one can confirm that the content is the same.

The CK1108.00 version and the Law version of the Hatcher letter differ in some cosmetic ways such as pagination. I believe this can be explained by recalling that in 1977, such letters were produced on a typewriter, and a letter to two different companies would normally have two originals typed. It is not unreasonable to expect that a 1977 typist may have created different page breaks for the two letters, while maintaining the same content.


Mr. Tom Slavonic
November 23, 2010
Page 2 of 2

The Final Foundation Index map is easily identified by its file name. The files are identified as shown in the listing below.

File Name	File Properties		
	Created		Size (Bytes)
1976-1130 Geologic Mapping Procedure, Pearce to Sams (From Duke Microfilm Reel 3184).pdf	11/22/2010	05:31 PM	808,352
1976-1130 Geologic Mapping Procedure, Pearce to Sams (From LETCo Cherokee Files).pdf	11/22/2010	05:32 PM	1,975,820
1977-0422 Geo Mapping Letter, Hatcher to Sams and Pearce (From Duke MFS CK1108.00).pdf	11/22/2010	05:34 PM	517,068
1977-0422 Geo Mapping Letter, Hatcher to Sams and Pearce (From Duke Microfilm Reel 3184).pdf	11/22/2010	05:34 PM	85,621
1977-0422 Geo Mapping Letter, Hatcher to Sams and Pearce (From LETCo Cherokee Files).pdf	11/22/2010	05:35 PM	341,589
Final Foundation Index Map (AKA Binder2 2).pdf	10/09/2006	09:27 AM	30,201,242

If you have questions, please call me at 704-382-7830.

Sincerely,

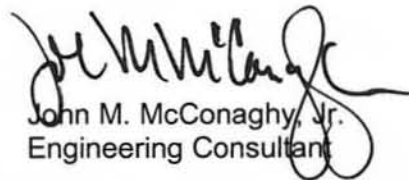

John M. McConaghy, Jr.
Engineering Consultant

Enclosure: 1 CD as described

cc: Mike Gray, FWLA (w/ enclosure)
Malcolm Schaeffer, HDR|DTA (w/ enclosure)
R.L. Morgan (w/o enclosure)
J.S. Thrasher (w/o enclosure)
J.R. Cassidy (w/o enclosure)
4000.01-09 (w/ enclosure)

ATTACHMENT 4

Duke Power Company Mapping Procedures and Addendum

Duke Power Company
Project 81
Cherokee Nuclear Station
Geologic Mapping Procedure
(November 30, 1976)

Transmitted to Law Engineering Testing Co. from Duke Power Company
[Duke File Name:1976-1130 Geologic Mapping Procedure, Pearce to Sams
(From Duke Microfilm Reel 3184).pdf]

Geologic Mapping Procedure
Outline

SECTION I - GENERAL DESCRIPTION

- A. Purpose
- B. Scope of Mapping and Sequence
- C. Definition of Responsible Parties
 - 1) Responsible Engineer
 - 2) Geologist
 - 3) Field Engineer
 - 4) Consultant
 - 5) Independent Geologic Consultant
- D. Assignment of Responsibilities
 - 1) Geologist
 - 2) Field Engineer
 - 3) Consultant
 - 4) Independent Geologic Consultant
- E. Requirements for Mapping
 - 1) Phase I - Initial Mapping
 - 2) Phase II - Final Excavation Mapping

SECTION II - TECHNICAL ASPECTS OF MAPPING

SECTION III - INVESTIGATING AND DOCUMENTING GEOLOGIC FAULT FEATURES

D J 3 1 8 4 0 4 6 1

DUKE POWER COMPANY
PROJECT 81
CHEROKEE NUCLEAR STATION
GEOLOGIC MAPPING PROCEDURE

ATTACHMENT

Section I - General Description

A. PURPOSE

The purpose of the geologic mapping program for Cherokee Station is to provide a permanent record of the foundation conditions encountered in areas of safety-related structures as outlined in PSAR Section 2.5.1.2(9). This Section of the procedure outlines the relationship of responsibilities and activities between Design Engineering and Construction Departments, and the Consultants in the following areas:

- Scope of Mapping and Sequence
- Definition of Parties
- Assignment of Responsibilities
- Requirements for Mapping

B. SCOPE OF MAPPING AND SEQUENCE

The geologic mapping required by this procedure shall be performed for certain designated areas including the following major plant structures:

- (1) Power Block Area - (Reactor Building, Auxiliary Building and Turbine Building Complex)
- (2) Nuclear Service Water Pond Dam foundation
- (3) NSW Pond Spillway Control Section foundation
- (4) NSW Pump Structure foundations

The complete program of geologic mapping shall be sequenced in two basic phases depending on the extent of excavation progress.

Phase I - Scale 1"=20' - Mapping of the top of rock before blasting is started in power block area only. Detailed mapping at 1"=5' where necessary.

Phase II - Scale 1"=10' - Mapping of final excavated surfaces. Detailed mapping at 1"=5' where necessary.

When the final foundation grade is above top of rock, no Phase I mapping will be necessary. Scale for final mapping in saprolite shall not be less than 1"=20'.

0 0 3 1 8 4 0 4 6 2

CK 1108-00

C. DEFINITION OF RESPONSIBLE PARTIES

- (1) Responsible Engineer - The Principal Engineer in charge of the responsible Civil Projects Section in the Civil/Environmental Division of Design Engineering Department or his designated representative.
- (2) Geologist - The individual designated by Chief Engineer of Civil/Environmental Division to act as his field representative in any matters pertaining to geologic mapping.
- (3) Field Engineer - The specific individual designated by the Construction Department Project Manager to be responsible for the coordination of all construction support or activities required for carrying out the geologic mapping program.
- (4) Consultant - The person or persons assigned by Law Engineering and Testing Co. (LETCo) with sufficient training and experience to assist with field mapping work and review of drawings and reports when requested by the Geologist or Responsible Engineer.
- (5) Independent Geologic Consultant - A third-party consultant (or consultants) with recognized expertise in the geology of the area engaged specifically for this work. This consultant will provide independent review of fault features and supporting data and conclusions where NRC notification is required for non-similar features as defined in Section III.

D. ASSIGNMENT OF RESPONSIBILITIES

All parties involved in the geologic mapping program will have general overall responsibilities to jointly support the requirement of the mapping program, to pursue their respective assignments in a timely and professional manner, and to assure that the resulting maps, data, reports, and documents are sufficient in content and accuracy to accomplish the purpose intended. The specific scope of responsibility for each of the parties for field mapping work is outlined below:

- (1) Geologist -
 - a. Supervises and coordinates all field geologic activity involved in mapping.
 - b. Schedules mapping of prepared areas designated by the Field Engineer and coordinates required construction support with Field Engineer. Provides Field Engineer with estimate of time required for mapping in specific areas.

0 3 1 8 4 0 4 6 3

- c. Determines the need for and extent of support necessary from Consultant (LETCO) and schedules personnel required for mapping.
- d. Schedules and supervises as necessary all office drafting associated with preparation of geologic maps.
- e. Coordinates review of field and office work, including preparation and review of reports, with Consultant (LETCO).
- f. Schedules and coordinates site visits of Independent Geologic Consultant when visits are required.
- g. Releases investigated areas to Field Engineer after completion of geologic mapping.
- h. When designated, represents Design Engineering during NRC site visits and inspections regarding geologic matters.

(2) Field Engineer -

- a. Schedules availability of areas to be mapped and assures that specific areas are cleaned and maintained until mapping is complete.
- b. Coordinates earthwork operations in areas requiring mapping with Geologist and advises when areas are ready for mapping.
- c. Schedules and coordinates labor, equipment, survey support, and other construction resources as necessary to assure that mapping can be completed as soon as possible.

(3) Consultant (LETCO) -

- a. Provides geologist personnel support for assistance in mapping when requested by the Geologist and/or the Responsible Engineer.
- b. Reviews all maps, drawings, data and reports relating to geology and foundation conditions and offers comments and suggestions as requested by the Geologist and/or the Responsible Engineer.
- c. Provides other specialized assistance in personnel or services if requested by the Geologist and/or the Responsible Engineer.

(4) Independent Geologic Consultant -

- a. Shall provide inspection, review and opinions pertaining to data developed for special features in consultation with Duke and Consultant (LETCO) when requested by the Geologist and/or the Responsible Engineer.

CK 1100 00

- b. May provide other services as may be necessary if requested by the Responsible Engineer.

E. REQUIREMENTS FOR MAPPING

Phase I - Initial Mapping (Top of Rock)

During early construction on the site, the Geologist will monitor the overall earthmoving activities and will record in a Geologic Field Log and by use of photographs any significant observable geologic features in the areas to be mapped. At an appropriate time before rock excavation begins, the Field Engineer will notify the Geologist when an area will be ready for inspection and mapping. The Field Engineer will coordinate the necessary construction resources to prepare the area for mapping.

Excavated areas will be mapped at elevations where earth and rock materials can no longer be removed with earthmoving equipment and blasting is required for further excavation. Preparation of an area for mapping will normally consist of a general clean-up of loose surface materials and gentle sloping of surfaces, where practicable. Limited portions of the area may have to be cleaned more thoroughly by air or water hoses, etc., to permit more detailed mapping, if features requiring detail study are found.

For areas scheduled to be mapped, the Geologist will schedule appropriate Duke Personnel and LETCO personnel, if required, to carry out the mapping in that area. In areas of exposed rock the Field Engineer will coordinate with survey crews to establish a 20 ft. grid reference system. The grid shall be plainly visible and shall be capable of being easily photographed. Iridescent type paint may be used for marking the grid and elevations shall be determined on certain grid points as requested by the Geologist to assist in map work. A 5 ft. grid may be required in some areas if determined necessary by the Geologist.

If the area to be mapped contains sloped surfaces, at greater than 30° angle from horizontal, or nearly vertical walls, the Geologist may request the Field Engineer to have the slope marked off in grids on the slope area. The Field Engineer shall also schedule and provide appropriate construction equipment or safety-ropes, etc., to allow taking of structural readings on steep slopes as requested by the Geologist. When all mapping of an

0 0 3 1 8 4 0 4 6 5

area has been completed, the Geologist will release the area to the Field Engineer for subsequent excavation.

Phase II - Final Excavation Mapping

As the excavation of an area to be mapped nears final grade, the Field Engineer will advise the Geologist of the expected date when excavation and cleanup of the area will be complete and available for mapping. The Geologist will then determine the expected mapping completion date based on his estimate of required work for the area.

The area shall be mapped as soon as practicable after it is cleaned. Various special equipment and methods may have to be employed by the Field Engineer to maintain a mappable surface. Normally, visible 10 ft. grid reference points will be provided by the Field Engineer for Phase II mapping. The Geologist shall coordinate the mapping with the Field Engineer so that priority can be placed on any critical portions of an area.

When final mapping has been completed in the area, the Geologist will release that area to the Field Engineer for construction.

0 2 3 1 8 4 0 4 6 6

CK 1108.00

Section II - Technical Mapping Aspects

Geologic features shall be mapped at the top of rock, or Phase I mapping stage, at a scale of 1"=20' on base maps. Any detail mapping of features shall be at a scale of 1"=5'. Photographs reproduced to an appropriate scale may be used as permanent record and for checking field mapping as determined necessary by the Geologist.

In the final Phase II foundation mapping stage, structural data will be taken concurrently with the mapping effort whenever deemed necessary by the field Geologist. Density of structural readings in the powerhouse excavation should be about 2 readings per 10 ft. grid square or as many as deemed necessary by the Geologist to get a representative sample of the geologic features. The data should include measurements of the following types of geologic occurrences, where applicable:

- foliation - type, strike, dip, weathering
- joints - spacing, continuity, separation, roughness fill material, strike, dip
- shear planes
and faults - brecciation, offsets, strike, dip
- contacts - rock types, weathering

As determined by the field Geologist, sufficient samples should be selected for study in thin section. The thin section data obtained should be keyed into the mapping and compared with thin section data obtained during previous studies in the area. For fault features, additional thin sections and other data may be required.

An appropriate index system shall be established to reference samples, features, and data to physical locations in the mapped areas. The system shall be suitable for cross-referencing and grouping of similar and non-similar features.

In addition, any potential problem features that may have engineering significance and will affect structure design or construction due to joints, shear zones or weathered condition of rock should be reported to the Responsible Engineer.

0 3 1 8 4 0 4 6 7

Section III - Investigating and Documenting Geologic Fault FeaturesA. INTRODUCTION

Extensive studies of fault features characteristic of the region and of the project site area have been made at the Catawba Nuclear Station (Docket Nos. 50-413 and -414) during geologic mapping and at the Cherokee project site in support of the Preliminary Safety Analysis Report for project licensing. These studies ⁽¹⁾ establish that numerous fault features occur and can be anticipated in any large excavation in the region.

B. PURPOSE

The purpose of this section is to establish a procedure for investigating and documenting geological fault features. The fault investigation will utilize data from previous studies where applicable.

C. SCOPE

This Investigation relates directly to those geologic fault features occurring in excavations required for safety related structure foundations.

D. PROCEDURE

1. Geologic mapping will be conducted as stated in Cherokee PSAR Section 2.5.1.2(9) and Section IE and Section II of this Procedure.
2. In the event a feature as described below is discovered the (field) Geologist will promptly notify the Responsible Engineer. Features which are reportable to Responsible Engineer may include brecciated zones containing offsets and any other offsets or displaced feature of tectonic origin.
3. The Responsible Engineer will hold any structure construction in an area containing a feature as described in 2 above until a determination

(1) Reference: Catawba Nuclear Station - PSAR, Chapter 2, Section 2.5, Appendices 2C and 2E
 - "Final Geological Report on Brecciated Zones"
 Cherokee Nuclear Station - PSAR, Chapter 2, Section 2.5, Appendices 2C and 2E

0 3 1 8 4 0 4 6 8

can be made 1) that the feature is similar to features previously studied by observation and that its relevant characteristics can be determined by correlation to previously studied features or (2) that the feature is not similar to any previously studied feature and requires new investigation.

4. For similar features (described in item 3(1)), the Geologist will so notify the Responsible Engineer who will release work in the area as soon as the Geologist has indexed the feature, documented it by detailed mapping and photographs, and established the feature's similarity to a previously established feature. This similarity will be documented by comparing relevant characteristics to features observed and studied at Catawba Nuclear Station during mapping or in any of the numerous test pits opened at the Cherokee site during subsurface investigative studies. Where this similarity can be established and documented, mapping and project work will continue routinely. A tabular summary will be prepared which indexes each occurrence of a feature and makes specific comparison to a previously studied feature. Documentation will be subject to audit during field inspections by NRC.
5. For features where similarity cannot be established by comparison to features previously studied at the Cherokee or Catawba sites, the Responsible Engineer will continue to hold work in the area and notify the NRC Project Manager of the discovery. The geologic feature will then be left exposed for ten (10) days for NRC inspection.
 - 5a. Duke with the assistance of Law Engineering Testing Company and/or other consultant will map the feature, develop data, and determine if the feature falls in the sequence of geologic events established and reported in the Cherokee PSAR.
 - 5b. A third party, independent geologic consultant, will be engaged and will visit the site to examine the feature and examine the data developed by Duke and LETCo and/or other consultant. The Geologist will notify the Responsible Engineer (when geologic mapping, photography and field data gathering have been completed) that investigations have been completed and documented. The independent consultant will report his findings to the Responsible Engineer.

0 0 3 1 8 4 0 4 6 9

CK 1108-00

5c. If the independent geologic consultant concurs with Duke's conclusions, the Responsible Engineer will then release the area for project construction activity upon completion of item 5b.

5d. For non-similar features a report will be prepared which shall consist of the following:

- (1) Description of the feature including the investigation and description of data obtained
- (2) Geologic history
- (3) Summary and conclusions
- (4) Geologic maps and photographs
- (5) Report of findings by Geologic Consultant
- (6) This report and other data will be available for NRC review whenever requested.

0 0 3 1 8 4 0 4 7 0

Addendum to Mapping Procedures
(April 22, 1977)

Transmitted to Law Engineering Company and
Duke Power Company from Clemson University

[Duke File Name:1977-0422 Geo Mapping Letter, Hatcher to Sams and
Pearce (From Duke Microfilm Reel 3184).pdf]

CK 1108.00

APRIL 22, 1977

Mr. I. W. Pearce
Principal Engineer
Civil-Environmental Division
Duke Power Company
P. O. Box 2178
Charlotte, NC 28242

and

Mr. C. E. Sams
Assistant Vice-President
Law Engineering Testing Company
P. O. Box 11297
Charlotte, NC 28209

Dear Sirs:

A meeting was held April 13, 1977, at Cherokee Nuclear Station for the purpose of examining bedrock features in the cleaned area in the Number 1 Turbine Building. Present at the meeting were Malcomb N. Schaeffer, Duke Power Company, Neil J. Gilbert, Law Engineering Testing Company and myself.

The meeting began with a preliminary briefing by Malcomb Schaeffer over lunch. We arrived at the site at about 1:00 PM and joined N. J. Gilbert on the cleaned area in Number 1 Turbine Building. We examined bedrock lithologies and structures and studied the 1" = 20' geologic maps prepared of the cleaned area.

After the examination of bedrock features on the site we returned to the construction site office to discuss the nature of the geologic mapping and more specifically the problems related to 1" = 5' scale mapping and what should be mapped.

The following recommendations were formulated as a result of these discussions:

1. Mapping of features at 1" = 5' scale.

(a) There should be a minimum of 2 feet offset on a fault. This is the threshold of visibility of offset at the 1" = 20' scale.

and/or

(b) There should be 50 feet traceable length on a fault. This is again related to a significant threshold of prominence of a structural feature on a 1" = 20' scale map.

and/or

(c) Cataclastic zones of significant thickness. A minimum thickness of 1 foot is arbitrarily chosen.

Corollary to the above:

Combinations of greater offset with less traceable length and/or thicker

0 3 1 8 4 0 6 2 7

Addendum to Mapping Procedures
(April 22, 1977)

Transmitted to Law Engineering Company and
Duke Power Company from Clemson University

[Duke File Name: 1977-0422 Geo Mapping Letter, Hatcher to Sams and
Pearce (From Duke MFS CK1108.00).pdf]

Mr. I. W. Pearce
Principal Engineer
Civil-Environmental Division
Duke Power Company
P. O. Box 2178
Charlotte, NC 28242

and

Mr. C. E. Sams
Assistant Vice-President
Law Engineering Testing Company
P. O. Box 11297
Charlotte, NC 28209

Dear Sirs:

A meeting was held April 13, 1977, at Cherokee Nuclear Station for the purpose of examining bedrock features in the cleaned area in the Number 1 Turbine Building. Present at the meeting were Malcomb N. Schaeffer, Duke Power Company, Neil J. Gilbert, Law Engineering Testing Company and myself.

The meeting began with a preliminary briefing by Malcomb Schaeffer over lunch. We arrived at the site at about 1:00 PM and joined N. J. Gilbert on the cleaned area in Number 1 Turbine Building. We examined bedrock lithologies and structures and studied the 1" = 20' geologic maps prepared of the cleaned area.

After the examination of bedrock features on the site we returned to the construction site office to discuss the nature of the geologic mapping and more specifically the problems related to 1" = 5' scale mapping and what should be mapped.

The following recommendations were formulated as a result of these discussions:

1. Mapping of features at 1" = 5' scale.

(a) There should be a minimum of 2 feet offset on a fault. This is the threshold of visibility of offset at the 1" = 20' scale.

and/or

(b) There should be 50 feet traceable length on a fault. This is again related to a significant threshold of prominence of a structural feature on a 1" = 20' scale map.

and/or

(c) Cataclastic zones of significant thickness. A minimum thickness of 1 foot is arbitrarily chosen.

Corollary to the above:

Combinations of greater offset with less traceable length and/or thicker

Mr. I. W. Pearce,
Mr. C. E. Sams
April 22, 1977
Page -2-


cataclastic zones may in the Geologist's judgment warrant 1" = 5' scale mapping. Also, greater traceable length and lesser offset may likewise require 1" = 5' scale mapping.

2. Repetitious sampling of features otherwise established as similar during the initial phases of the top of rock mapping program should not be undertaken. However, samples should be taken at the discretion of the Geologist.

We returned to the site at 5:25 P.M. after the above recommendations were formulated and examined a fault previously not seen by the Independent Geologic Consultant. The above recommendations were applied to this fault and appeared to work well.

The meeting was adjourned at 6:00 P.M.

Sincerely,

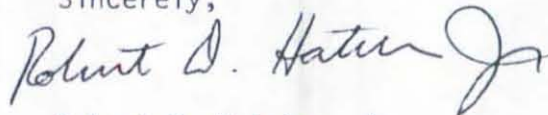

Robert D. Hatcher, Jr.
Professor of Geology
Clemson University
Clemson, SC 29631

RDH:sr

cc: Dr. Donald T. Secor, Jr.

Duke Power Company
Project 81
Cherokee Nuclear Station
Geologic Mapping Procedure
(November 30, 1976)

Transmitted to Law Engineering Testing Co. from Duke Power Company
[Duke File Name:1976-1130 Geologic Mapping Procedure, Pearce to Sams
(From LETCo Cherokee Files).pdf]

DUKE POWER COMPANY

P. O. BOX 2178

GENERAL OFFICES
422 SOUTH CHURCH STREET
CHARLOTTE, N. C. 28201

TELEPHONE: AREA 704
374-4011

November 30, 1976

COPY TO NEIL GILBERT

Mr. C. E. Sams
Law Engineering Testing Co.
P. O. Box 11297
Charlotte, N. C. 28209


RE: Cherokee 1-3
Geologic Mapping
File No: CK-1108.00

Dear Mr. Sams:

Attached is a copy of the procedure we propose to use for geologic mapping at Cherokee for your review. Please plan to meet with us at the Electric Center on ¹⁵Monday, December 13, 1976, at 2:00 p.m. to discuss our overall mapping program at Cherokee and Law Engineering's role in that program. We can discuss any comments you might have on the procedure at that time.

Yours very truly,

L. C. Dail, Chief Engineer
Civil/Environmental Division


By: I. W. Pearce, Principal Engineer

IWP/gc

Attachment

cc: C. Q. Reeves
D. R. Privett
M. F. Schaeffer

Geologic Mapping Procedure
Outline

SECTION I - GENERAL DESCRIPTION

- A. Purpose
- B. Scope of Mapping and Sequence
- C. Definition of Responsible Parties
 - 1) Responsible Engineer
 - 2) Geologist - MALCOLM SCHAEFFER
 - 3) Field Engineer
 - 4) Consultant
 - 5) Independent Geologic Consultant
- D. Assignment of Responsibilities
 - 1) Geologist
 - 2) Field Engineer
 - 3) Consultant
 - 4) Independent Geologic Consultant
- E. Requirements for Mapping
 - 1) Phase I - Initial Mapping
 - 2) Phase II - Final Excavation Mapping

SECTION II - TECHNICAL ASPECTS OF MAPPING

SECTION III - INVESTIGATING AND DOCUMENTING GEOLOGIC FAULT FEATURES

DUKE POWER COMPANY
PROJECT 81
CHEROKEE NUCLEAR STATION
GEOLOGIC MAPPING PROCEDURE

Section I - General Description

A. PURPOSE

The purpose of the geologic mapping program for Cherokee Station is to provide a permanent record of the foundation conditions encountered in areas of safety-related structures as outlined in PSAR Section 2.5.1.2(9). This Section of the procedure outlines the relationship of responsibilities and activities between Design Engineering and Construction Departments, and the Consultants in the following areas:

- Scope of Mapping and Sequence
- Definition of Parties
- Assignment of Responsibilities
- Requirements for Mapping

B. SCOPE OF MAPPING AND SEQUENCE

The geologic mapping required by this procedure shall be performed for certain designated areas including the following major plant structures:

- (1) Power Block Area - (Reactor Building, Auxiliary Building and Turbine Building Complex)
- (2) Nuclear Service Water Pond Dam foundation
- (3) NSW Pond Spillway Control Section foundation
- (4) NSW Pump Structure foundations

The complete program of geologic mapping shall be sequenced in two basic phases depending on the extent of excavation progress.

Phase I - Scale 1"=20' - Mapping of the top of rock before blasting is started in power block area only. Detailed mapping at 1"=5' where necessary.

Phase II - Scale 1"=10' - Mapping of final excavated surfaces. Detailed mapping at 1"=5' where necessary.

When the final foundation grade is above top of rock, no Phase I mapping will be necessary. Scale for final mapping in saprolite shall not be less than 1"=20'.

C. DEFINITION OF RESPONSIBLE PARTIES

- (1) Responsible Engineer - The Principal Engineer in charge of the responsible Civil Projects Section in the Civil/Environmental Division of Design Engineering Department or his designated representative. I.W. PEARCE
Alternate: COP. pers.
- (2) Geologist - The individual designated by Chief Engineer of Civil/Environmental Division to act as his field representative in any matters pertaining to geologic mapping. } MALCOLM
- (3) Field Engineer - The specific individual designated by the Construction Department Project Manager to be responsible for the coordination of all construction support or activities required for carrying out the geologic mapping program.
- (4) Consultant - The person or persons assigned by Law Engineering and Testing Co. (LETCo) with sufficient training and experience to assist with field mapping work and review of drawings and reports when requested by the Geologist or Responsible Engineer.
- (5) Independent Geologic Consultant - A third-party consultant (or consultants) with recognized expertise in the geology of the area engaged specifically for this work. This consultant will provide independent review of fault features and supporting data and conclusions where NRC notification is required for non-similar features as defined in Section III. Bob Fletcher

D. ASSIGNMENT OF RESPONSIBILITIES

All parties involved in the geologic mapping program will have general overall responsibilities to jointly support the requirement of the mapping program, to pursue their respective assignments in a timely and professional manner, and to assure that the resulting maps, data, reports, and documents are sufficient in content and accuracy to accomplish the purpose intended. The specific scope of responsibility for each of the parties for field mapping work is outlined below:

- (1) Geologist -
 - a. Supervises and coordinates all field geologic activity involved in mapping.
 - b. Schedules mapping of prepared areas designated by the Field Engineer and coordinates required construction support with Field Engineer. Provides Field Engineer with estimate of time required for mapping in specific areas.

- c. Determines the need for and extent of support necessary from Consultant (LETCO) and schedules personnel required for mapping.
 - d. Schedules and supervises as necessary all office drafting associated with preparation of geologic maps.
 - e. Coordinates review of field and office work, including preparation and review of reports, with Consultant (LETCO).
 - f. Schedules and coordinates site visits of Independent Geologic Consultant when visits are required.
 - g. Releases investigated areas to Field Engineer after completion of geologic mapping.
 - h. When designated, represents Design Engineering during NRC site visits and inspections regarding geologic matters.
- (2) Field Engineer -
- a. Schedules availability of areas to be mapped and assures that specific areas are cleaned and maintained until mapping is complete.
 - b. Coordinates earthwork operations in areas requiring mapping with Geologist and advises when areas are ready for mapping.
 - c. Schedules and coordinates labor, equipment, survey support, and other construction resources as necessary to assure that mapping can be completed as soon as possible.
- (3) Consultant (LETCO) -
- a. Provides geologist personnel support for assistance in mapping when requested by the Geologist and/or the Responsible Engineer.
 - b. Reviews all maps, drawings, data and reports relating to geology and foundation conditions and offers comments and suggestions as requested by the Geologist and/or the Responsible Engineer.
 - c. Provides other specialized assistance in personnel or services if requested by the Geologist and/or the Responsible Engineer.
- (4) Independent Geologic Consultant -
- a. Shall provide inspection, review and opinions pertaining to data developed for special features in consultation with Duke and Consultant (LETCO) when requested by the Geologist and/or the Responsible Engineer.

- b. May provide other services as may be necessary if requested by the Responsible Engineer.

E. REQUIREMENTS FOR MAPPING

Phase I - Initial Mapping (Top of Rock)

During early construction on the site, the Geologist will monitor the overall earthmoving activities and will record in a Geologic Field Log and by use of photographs any significant observable geologic features in the areas to be mapped. At an appropriate time before rock excavation begins, the Field Engineer will notify the Geologist when an area will be ready for inspection and mapping. The Field Engineer will coordinate the necessary construction resources to prepare the area for mapping.

Excavated areas will be mapped at elevations where earth and rock materials can no longer be removed with earthmoving equipment and blasting is required for further excavation. Preparation of an area for mapping will normally consist of a general clean-up of loose surface materials and gentle sloping of surfaces, where practicable. Limited portions of the area may have to be cleaned more thoroughly by air or water hoses, etc., to permit more detailed mapping, if features requiring detail study are found.

For areas scheduled to be mapped, the Geologist will schedule appropriate Duke Personnel and LETCO personnel, if required, to carry out the mapping in that area. In areas of exposed rock the Field Engineer will coordinate with survey crews to establish a 20 ft. grid reference system. The grid shall be plainly visible and shall be capable of being easily photographed. Iridescent type paint may be used for marking the grid and elevations shall be determined on certain grid points as requested by the Geologist to assist in map work. A 5 ft. grid may be required in some areas if determined necessary by the Geologist.

If the area to be mapped contains sloped surfaces, at greater than 30° angle from horizontal, or nearly vertical walls, the Geologist may request the Field Engineer to have the slope marked off in grids on the slope area. The Field Engineer shall also schedule and provide appropriate construction equipment or safety-ropes, etc., to allow taking of structural readings on steep slopes as requested by the Geologist. When all mapping of an

area has been completed, the Geologist will release the area to the Field Engineer for subsequent excavation.

Phase II - Final Excavation Mapping

As the excavation of an area to be mapped nears final grade, the Field Engineer will advise the Geologist of the expected date when excavation and cleanup of the area will be complete and available for mapping. The Geologist will then determine the expected mapping completion date based on his estimate of required work for the area.

The area shall be mapped as soon as practicable after it is cleaned. Various special equipment and methods may have to be employed by the Field Engineer to maintain a mappable surface. Normally, visible 10 ft. grid reference points will be provided by the Field Engineer for Phase II mapping. The Geologist shall coordinate the mapping with the Field Engineer so that priority can be placed on any critical portions of an area.

When final mapping has been completed in the area, the Geologist will release that area to the Field Engineer for construction.

Section II - Technical Mapping Aspects

Geologic features shall be mapped at the top of rock, or Phase I mapping stage, at a scale of 1"=20' on base maps. Any detail mapping of features shall be at a scale of 1"=5'. Photographs reproduced to an appropriate scale may be used as permanent record and for checking field mapping as determined necessary by the Geologist.

In the final Phase II foundation mapping stage, structural data will be taken concurrently with the mapping effort whenever deemed necessary by the field Geologist. Density of structural readings in the powerhouse excavation should be about 2 readings per 10 ft. grid square or as many as deemed necessary by the Geologist to get a representative sample of the geologic features. The data should include measurements of the following types of geologic occurrences, where applicable:

- foliation - type, strike, dip, weathering
- joints - spacing, continuity, separation, roughness fill material, strike, dip
- shear planes and faults - brecciation, offsets, strike, dip
- contacts - rock types, weathering

As determined by the field Geologist, sufficient samples should be selected for study in thin section. The thin section data obtained should be keyed into the mapping and compared with thin section data obtained during previous studies in the area. For fault features, additional thin sections and other data may be required.

An appropriate index system shall be established to reference samples, features, and data to physical locations in the mapped areas. The system shall be suitable for cross-referencing and grouping of similar and non-similar features.

In addition, any potential problem features that may have engineering significance and will affect structure design or construction due to joints, shear zones or weathered condition of rock should be reported to the Responsible Engineer.

can be made 1) that the feature is similar to features previously studied by observation and that its relevant characteristics can be determined by correlation to previously studied features or (2) that the feature is not similar to any previously studied feature and requires new investigation.

4. For similar features (described in item 3(1)), the Geologist will so notify the Responsible Engineer who will release work in the area as soon as the Geologist has indexed the feature, documented it by detailed mapping and photographs, and established the feature's similarity to a previously established feature. This similarity will be documented by comparing relevant characteristics to features observed and studied at Catawba Nuclear Station during mapping or in any of the numerous test pits opened at the Cherokee site during subsurface investigative studies. Where this similarity can be established and documented, mapping and project work will continue routinely. A tabular summary will be prepared which indexes each occurrence of a feature and makes specific comparison to a previously studied feature. Documentation will be subject to audit during field inspections by NRC.
5. For features where similarity cannot be established by comparison to features previously studied at the Cherokee or Catawba sites, the Responsible Engineer will continue to hold work in the area and notify the NRC Project Manager of the discovery. The geologic feature will then be left exposed for ten (10) days for NRC inspection.
 - 5a. Duke with the assistance of Law Engineering Testing Company and/or other consultant will map the feature, develop data, and determine if the feature falls in the sequence of geologic events established and reported in the Cherokee PSAR.
 - 5b. A third party, independent geologic consultant, will be engaged and will visit the site to examine the feature and examine the data developed by Duke and LETCo and/or other consultant. The Geologist will notify the Responsible Engineer (when geologic mapping, photography and field data gathering have been completed) that investigations have been completed and documented. The independent consultant will report his findings to the Responsible Engineer.

5c. If the independent geologic consultant concurs with Duke's conclusions, the Responsible Engineer will then release the area for project construction activity upon completion of item 5b.

5d. For non-similar features a report will be prepared which shall consist of the following:

- (1) Description of the feature including the investigation and description of data obtained
- (2) Geologic history
- (3) Summary and conclusions
- (4) Geologic maps and photographs
- (5) Report of findings by Geologic Consultant
- (6) This report and other data will be available for NRC review whenever requested.

Addendum to Mapping Procedures
(April 22, 1977)

Transmitted to Law Engineering Company and
Duke Power Company from Clemson University

[Duke File Name:1977-0422 Geo Mapping Letter, Hatcher to Sams and
Pearce (From LETCo Cherokee Files).pdf]

✓
14
4-27

Mr. C. E. Sams
Assistant Vice-President
Law Engineering Testing Company
P. O. Box 11297
Charlotte, NC 28209

and

Mr. I. W. Pearce
Principal Engineer
Civil-Environmental Division
Duke Power Company
P. O. Box 2178
Charlotte, NC 28242

Dear Sirs:

A meeting was held April 13, 1977, at Cherokee Nuclear Station for the purpose of examining bedrock features in the cleaned area in the Number 1 Turbine Building. Present at the meeting were Malcomb N. Schaeffer, Duke Power Company, Neil J. Gilbert, Law Engineering Company and myself.

The meeting began with a preliminary briefing by Malcomb Schaeffer over lunch. We arrived at the site at about 1:00 PM and joined N. J. Gilbert on the cleaned area in Number 1 Turbine Building. We examined bedrock lithologies and structures and studied the 1" = 20' geologic maps prepared of the cleaned area.

After the examination of bedrock features on the site we returned to the construction site office to discuss the nature of the geologic mapping and more specifically the problems related to 1" = 5' scale mapping and what should be mapped.

The following recommendations were formulated as a result of these discussions:

1. Mapping of features at 1" = 5' scale.

(a) There should be a minimum of 2 feet offset on a fault. This is the threshold of visibility of offset at the 1" = 20' scale.

and/or

(b) There should be 50 feet traceable length on a fault. This is again related to a significant threshold of prominence of a structural feature on a 1" = 20' scale map.

and/or

(c) Cataclastic zones of significant thickness. A minimum thickness of 1 foot is arbitrarily chosen.

Mr. C. E. Sams
Mr. I. W. Pearce
April 22, 1977
Page -2-

Corollary to the above:


Combinations of greater offset with less traceable length and/or thicker cataclastic zones may in the Geologist's judgment warrant 1" = 5' scale mapping. Also, greater traceable length and lesser offset may likewise require 1" = 5' scale mapping.

2. Repetitious sampling of features otherwise established as similar during the initial phases of the top of rock mapping program should not be undertaken. However, samples should be taken at the discretion of the Geologist.

We returned to the site at 5:25 P.M. after the above recommendations were formulated and examined a fault previously not seen by the Independent Geologic Consultant. The above recommendations were applied to this fault and appeared to work well.

The meeting was adjourned at 6:00 P.M.

Sincerely,

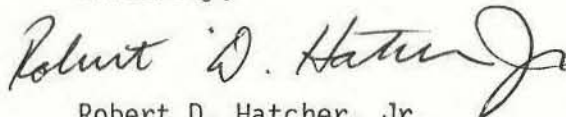

Robert D. Hatcher, Jr.
Professor of Geology
Clemson University
Clemson, SC 29631

RDH:sr

cc: Dr. Donald T. Secor, Jr.