B-402

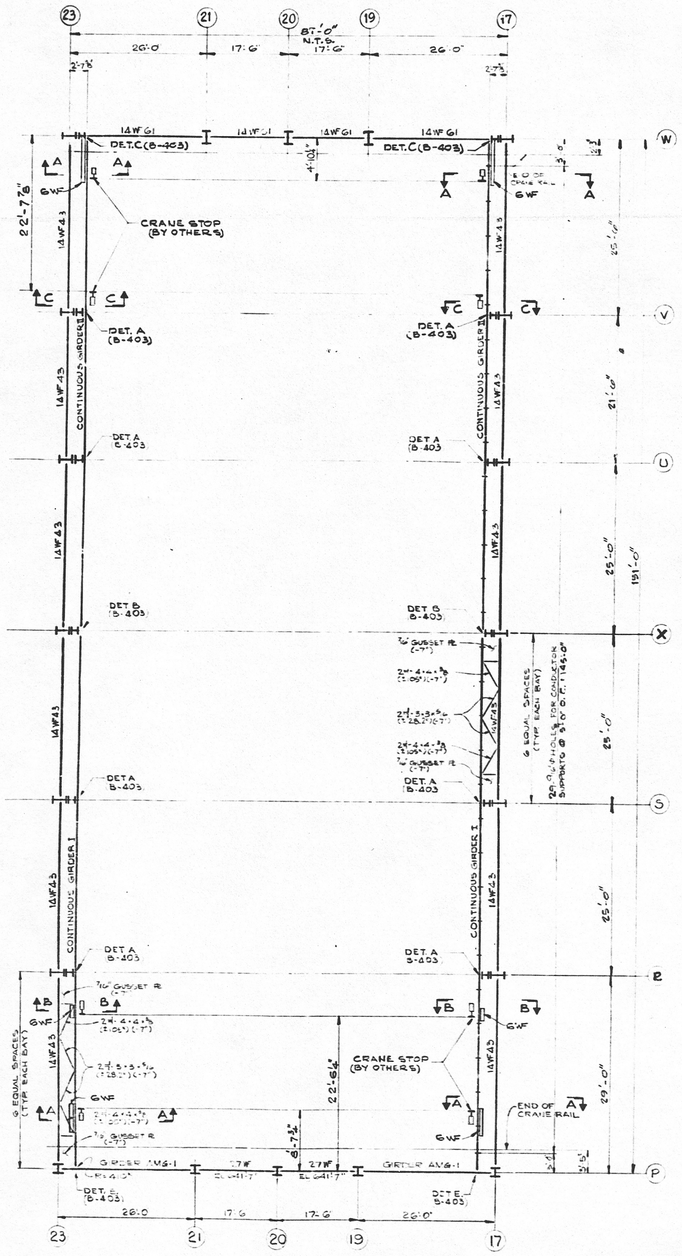

CONTINUOUS GIRDER & RAIL PLAN

TOP OF RAIL EL 643'-0"
TOP OF STEEL EL. 642'-6" UNLESS NOTED

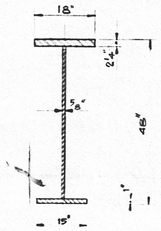

SECTION (TYP)
SCALE 3/4" = 1'-0"

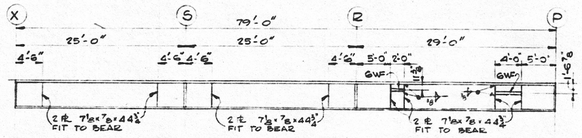

CONTINUOUS GIRDER I

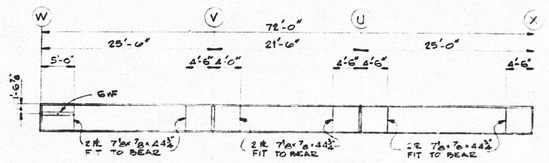

CONTINUOUS GIRDER II

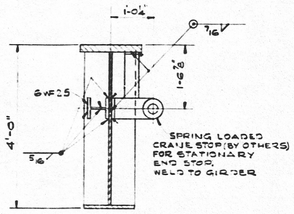

SECTION A-A
SCALE: 3/4" = 1'-0"

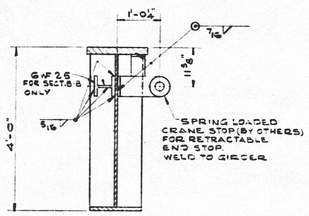

SECTION B-B
SECTION C-C
SCALE: 3/4" = 1'-0"

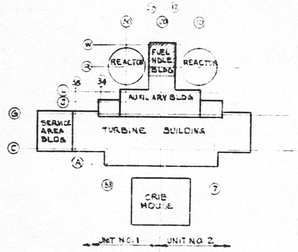

KEY PLAN

NOTES

1. FOR GENERAL NOTES SEE DWG B-285

REFERENCE DRAWINGS

B-403	FUEL HDLG BLDG CRANE GIRDER - SECTS & DETS.

Drawing Release Record			
Rev.	Date	Init	Description
	12-21-65		1st ISSUED
	3-11-66		ISSUED FOR BIDS
	3-25-69		ISSUED FOR CONST.
A	3-27-68		ISSUED FOR CONST.
B	9-11-68		ADDED SECT.
C	12-5-68		ADDED SECT.
D	1-20-69		ADDED SECT.
E	5-5-69		ADDED SECT.
F	11-25-70		ADD SECTS
G	12-15-70		ADD WELD SYM
H	1-27-71		AS BUILT

FUEL HANDLING BUILDING
CRANE GIRDER AND RAIL PLAN
ZION STATION UNIT 1 & 2
COMMONWEALTH EDISON CO.
CHICAGO, ILLINOIS

SCALE: 1/8"-1'-0" UNLESS N.T.S.
DRAWN A. GABLESON 7-5-66
CHECKED [illegible] 12-21-68
ENGINEER [illegible] 12-21-68
APPROVED [illegible] 12-21-68
JOB NO. 5782 3833

SARGENT & LUNDY ENGINEERS CHICAGO

DRAWING NO. B-402

NORTH

CONDITION OF ORIGINAL DRAWING - FAIR - REPRODUCTION CONSULTANTS LTD. . . 4-88 -30x D34