

Southern California Edison Company



P. O. BOX 800

2244 WALNUT GROVE AVENUE

ROSEMEAD, CALIFORNIA 91770

KENNETH P. BASKIN
VICE PRESIDENT

TELEPHONE
818-302-1401

APR 1 1985

Office of Nuclear Reactor Regulation
Attention: Dennis M. Crutchfield, Assistant Director
for Safety Assessment
Division of Licensing
U. S. Nuclear Regulatory Commission
Washington, D.C. 20555

Gentlemen:

Subject: Docket No. 50-206
Seismic Analyses
San Onofre Nuclear Generating Station
Unit 1

Your letter of February 15, 1985 requested that we provide original design analyses for San Onofre Unit 1 which pertain to your review of SCE's April 30, 1982 seismic reevaluation report regarding Balance of Plant Mechanical Equipment and Piping (BOPMEP). As indicated in our letter of September 9, 1979 from J. T. Head to R.H. Engelken, only six original seismic analysis documents pertaining to the San Onofre Unit 1 balance of plant were identified as being available. In a subsequent letter from H. L. Ottoson to R. H. Engelken dated January 14, 1980 it was noted that one of these analyses (Bechtel stress problem number 3246-10) was not applicable to the as-built piping configuration.

In accordance with your request we have asked our contractor, Bechtel Power Corporation, to again search their files for information regarding these original seismic analyses. Based on this effort, seismic design information was located for the following systems:

| <u>Item</u> | <u>Description</u> | <u>Calculation No.</u> |
|-------------|---|------------------------|
| 1. | Main Steam Piping between the Turbine Stop Valves and Steam Generators | 3246-1 |
| 2. | Main Feedwater Piping between the Sphere Penetration and Steam Generator E-1B | 3246-3 |
| 3. | Main Feedwater Piping between the Sphere Penetration and Steam Generator E-1C | 3246-14, 15, 16 |

8504040294

Acc'd
1/2
Encls Rec'd
4/5/85

Aperture Dist
Card
Encls To: Reg Files - 1
W. Paulson - 1

APR 1 1985

SCE

4. Main Feedwater Piping between
Feedwater Pumps G-3A and G-3B
and Sphere Penetrations C-3A,
C-3B and C-3C

3246-10

In addition, Bechtel has prepared a comparison of the available original seismic design data for the first three systems listed above with the design data used in the April 1982 BOPMEP report. This comparison is provided for your information in Attachments 1, 2 and 3.

With respect to the original seismic design data and seismic analyses located for the four systems identified above, in no case was a complete "seismic calculation package" located. In each case, various independent pieces of information related to original seismic analyses were located. This information has been assembled in Attachments 4 through 7 for the four systems identified above. It should be noted that for Item 4 above, no original seismic analyses could be located; however, Attachment 7 includes tabulations prepared in 1973 for use in pipe break analyses of this system. These are considered to be taken from original seismic calculations based on discussions with the engineer who prepared the 1973 tabulation and the fact that a similar tabulation prepared in 1973 for the main steam piping was also located and it correlates with the stresses developed for the original plant.

Finally, Attachment 8 provides a discussion of a number of differences between the methods and criteria used for the 1982 BOPMEP seismic analyses and methods and criteria which were probably used in the original seismic analyses. The purpose of this discussion is to recognize the fact that there are a number of differences between calculations done during the two time periods. As such, conclusions regarding the original design should not be made based on the results of the 1982 analyses.

If you have any questions regarding the enclosed information, please call me.

Very truly yours,

Kenneth P. Bush

ATTACHMENT (1)

Comparison of design data used for original plant seismic calculations, circa 1964/1965, with design data used for the BOPMEP Report of April 1980 for Main Steam Piping between the Turbine Stop Valves and Steam Generators, Calculation No. 3246-1.

| Item | Original Analysis | BOPMEP Analysis | Comments |
|-----------------------|---|---|--|
| 1. Calc. No. | 3246-1 | MS-01 | |
| | (a) Turbine Stop Valves to Steam Generators (12/21/64) | Turbine Stop Valves to Steam Generators | 1. Subsequent calculations were made in 1965 since the original, 12/21/64 analysis showed high stresses. See comments for Item 5. |
| | (b) Turbine Stop Valves to Sphere Penetration including Relief Valve Header Piping (4/24/65) | | 2. Original seismic analysis Item 1(c) cannot be found. Evidence of this analysis is provided by letter as shown on Page 22 of Attachment (4). |
| | (c) Sphere Penetration to Steam Generators (3/5/65). This computer input/output could not be located. | | |
| 2. Method of Analysis | (a) Static Analysis | Dynamic Analysis, Closely Space Modes per Reg. Guide 1.92 | |
| | (b) Static Analysis | | |
| | (c) Static Analysis | | |

ATTACHMENT (1) (Cont'd)

| Item | Original Analysis | BOPMEP Analysis | Comments |
|---------------------|--|--|---------------------------|
| 3. Response Spectra | (a) 12/21/64 | Fundamental Freq. = 8.7 cps | |
| | X Direc. = 0.5 g Y Direc. = Not Located Z Direc. = 0.5 g | X Direc. = 2.45 g (DBE) Y Direc. = 2.1 g (DBE) Z Direc. = 3.03 g (DBE) | |
| | (b) 4/24/65 | | |
| | X Direc. = 1.0 g Y Direc. = 0.67 g Z Direc. = 1.0 g | | |
| | (c) 3/5/65 | | 1. See Item 1, comment 2. |
| | X Direc. = 1.0 g Y Direc. = 1.0 g Z Direc. = 1.0 g | | |

ATTACHMENT (1) (Cont'd)

| Item | Original Analysis | BOPMEP Analysis | Comments |
|--------------------|--|---|---|
| 4. Piping Geometry | <p>(a) 12/21/64 - Computer Model of Piping from Turbine Stop Valve to S.G.</p> <p>Due to Symmetry, one half of piping system was considered. Relief header line was not included.</p> <p>(b) 4/24/65 Computer Model Outside Containment</p> <p>Due to Symmetry, one half of piping system was considered. Included relief header line.</p> <p>(c) 3/5/65 Computer Model Inside Containment</p> <p>Due to Symmetry, one half of piping system was considered.</p> | <p>Considered Full Model for Inside Containment and Outside Containment</p> | <p>1. Considering (a), (b), and (c) of original analyses, the Piping Geometry was similar for both analyses</p> |

ATTACHMENT (1) (Cont'd)

| Item | Original Analysis | BOPMEP Analysis | Comments |
|--------------------|---|---|---|
| 5. No. of Supports | (a) 12/21/64 2 x-direction supports using half model 1 z-direction support using half model | 9 supports with x-direction components in half model, 16 supports with z-direction components in half model | <p>High Seismic stresses were calculated in original analysis (12/21/64). The stress problem was then divided into two parts and reruns were made with more supports</p> <p>(i) Turbine Stop Valves to Sphere Penetration with relief header line Outside Containment.</p> <p>(ii) Sphere Penetration to Steam Generators Inside Containment</p> |
| | (b) 4/24/65 Outside Containment | | <p>Primary Stresses were within allowable limits for the analysis of 4/24/65, outside containment, and the number, type and location of supports matched those used in the BOPMEP Analysis.</p> |
| | (c) 3/5/65 Inside Containment This analysis has not been located. | | <p>A letter had been sent to Service Bureau Corporation for seismic computer analysis, on 3/5/65, for inside containment portion. Results of the analysis have not been located. However, the number of supports installed in 1965/1966 agree with the number, type and location of supports used in BOPMEP which reflected piping stresses within code allowables.</p> |

ATTACHMENT (1) (Cont'd)

| Item | Original Analysis | BOPMEP Analysis | Comments |
|---------------------|---|---|--|
| 6. Primary Stresses | (a) High Stresses from 12/21/64 Analysis (b) Acceptable stresses from 4/24/65 analysis outside containment (c) Stresses not available | Acceptable Primary Stress 17,623 psi | 1. Since seismic spectra was more severe for the BOPMEP analysis, which resulted in acceptable stresses, it can be concluded that for the same piping geometry, support locations and types piping stresses for the original plant design were acceptable per the original plant criteria. |

ATTACHMENT (2)

Comparison of design data used for original plant seismic calculations, circa 1964/1965, with design data used for the BOPMEP Report of April 1980 for Main Feedwater Piping between the Sphere Penetration and Steam Generator E-1B, Calculation No. 3246-3.

| Item | Original Analysis | BOPMEP Analysis | Comments |
|-------------------------------|---|--|--|
| 1. Calc. No. | 3246-3 | FW-02 | |
| 2. Method of Seismic Analysis | Static Analysis | Dynamic Analysis, Closely Space Modes, Reg. Guide 1.92 | |
| 3. Response Spectra | 12/29/64 X Direc. = 0.5 g Z Direc. = 0.5 g Analysis for Y Direc. is not available. | Fundamental Freq. = 9.8 cps X Direc. = 2.5 g (DBE) Y Direc. = 1.35 g (DBE) Z Direc. = 1.6 g (DBE) | 1. For the original analysis on 12/29/64 a peak acceleration of 0.5 g applied statically, was used. Subsequent static seismic analyses was performed using a peak of 1 g. See Item 5 comments. |
| 4. Piping Geometry | Piping Footage - 200' Elbows - 6 | Piping Footage - 200' Elbows - 6 | Pipe routing is identical. |

ATTACHMENT (2) (Cont'd)

| Item | Original Analysis | BOPMEP Analysis | Comments |
|---------------------|---|--|--|
| 5. No. of Supports | 12/29/64 Computer Model N-S (X Direc.) = 1 Rigid Vert. (Y Direc.) = 4 Rigid E-W (Z Direc.) = 2 Rigid | N-S (X Direc.) = 2 Rigid Vert. (Y Direc.) = 8 Rigid E-W (Z Direc.) = 4 Rigid 5 Skew Snubbers 2 Springs | The 1964 Analysis did not represent the final seismic model and therefore the number of supports differed with the BOPMEP Model. Subsequent seismic analysis performed in 1965 cannot be located. However, the number of supports in 1965/1966 agrees with the number, type, and location used in the BOPMEP Analysis. |
| 6. Primary Stresses | 1. High Seismic Stress from 12/29/64 Analysis 2. Stresses from 1965 Analysis are not available. | Acceptable Primary Stresses - 15,451 psi | Since seismic spectra was more severe for the BOPMEP Analysis, which resulted in acceptable stresses, it can be concluded that for the same piping geometry, support locations and types, piping stresses were acceptable based on original criteria. |

ATTACHMENT (3)

COMPARISON OF DESIGN DATA USED FOR ORIGINAL PLANT SEISMIC CALCULATIONS,
 CIRCA 1964/65, WITH DESIGN DATA USED FOR THE BOPMEP REPORT OF
 APRIL 1980 FOR MAIN FEEDWATER PIPING BETWEEN THE SPHERE PENETRATION AND STEAM GENERATOR E-1C
 CALCULATION NO. 3246-14,15,16

| <u>ITEM</u> | <u>ORIGINAL ANALYSIS</u> | <u>BOPMEP ANALYSIS</u> | <u>COMMENTS</u> |
|-------------------------------|---|--|--|
| 1. Calc. No. | 3246-14 3246-15 3246-16 | FW-01 | - |
| 2. Method of Seismic Analysis | Static Analysis | Dynamic Analysis Closely Space Modes Reg. Guide 1.92 | |
| 3. Response Spectra | 2/65 X Direc. = 1.0 g Y Direc. = .067 g Z Direc. = 1.0 g | Fundamental Freq. = 7.2 cps X Direc. = 2.5 g Y Direc. = 2.3 g Z Direc. = 3.55 g | |
| 4. Piping Geometry | Piping Footage = 92' Elbows = 4 | Piping Footage = 97.5' Elbows = 4 | 1. Almost Identical Geometry |
| 5. No. of Supports | N-S (X Direc.) = 1 Rigid Vert (Y Direc.) = 3 Rigid E-W (Z Direc.) = 1 Snub. 2 Skew Snubbers, 2 Springs | N-S (X Direc.) = 1 Rigid Vert (Y Direc.) = 3 Rigid E-W (Z Direc.) = 1 Snub 2 Skew Snubbers, 2 Springs | 1. Support Numbers, types, and locations are identical. |
| 6. Stress | Stress Levels are Acceptable | Acceptable Primary Stress - 17,807 psi | |

ATTACHMENT (4)

Copies of original plant design data and seismic analyses for Main Steam Piping between the Turbine Stop Valves and Steam Generators, Calculation No. 3246-1.

| <u>Item</u> | <u>Description</u> | <u>Page</u> |
|-------------|--|-------------|
| 1. | Isometric - Main Steam Line between Turbine Stop Valves and Steam Generator E-1A and E-1B (Half Loop), dated 12/18/64 | 3 |
| 2. | Computer Input/Output Data | |
| | (a) Input Data X & Z Acceleration 0.5 g, dated 12/21/64 | 4-7 |
| | (b) Output Data X Acceleration 0.5 g, dated 12/21/64 | 8-14 |
| | (c) Output Data Z Acceleration 0.5 g, dated 12/21/64 | 15-21 |
| 3. | Memo from BPC to Service Bureau Corporation, dated 3/5/65 Subject: Piping Flexibility Analysis (Inside Containment Seismic Analysis for 1.0 g Acceleration) | 22 |
| 4. | Location of Pipe Supports (Sphere Penetration to Steam Generators E-1A, E-1B, and E-1C) as installed on Original Plant (1965/1966) | 24 |
| 5. | Isometric Turbine Stop Valves to Sphere Penetrations (Half Loop) | 27 |
| 6. | Computer Input/Output Data | |
| | (a) Output Data X Acceleration 1.0 g, dated 4/24/65 | 28-38 |
| | (b) Output Data Y Acceleration 1.67 g, dated 4/26/65 | 39-49 |
| | (c) Output Data Z Acceleration 1.0 g, dated 4/27/65 | 50-60 |
| | (d) Stress Summary Tables for Pipe Break Analysis, dated 6/19/73 | 61 |

ATTACHMENT (4) (Cont'd)

| <u>Item</u> | <u>Description</u> | <u>Page</u> |
|-------------|---|-------------|
| 7. | Location of Pipe Supports (Sphere Penetration to Turbine Stop Valves including Relief Valve Headers) as installed on Original Plant (1965/1966) | 64 |
| 8. | A Memo from D. Phillips to Bill Hsu, dated 2/11/65, Subject: Seismic Criteria | 66 |

ATTACHMENT 8

The Balance of Plant Mechanical Equipment and Piping (BOPMEP) Report of April 1980 presents the results of a seismic reevaluation performed to evaluate safety related components, structures and equipment of San Onofre 1. The program was based upon the use of then current analysis methods and criteria which differed significantly from, and were more severe than, those used during the original plant design, circa 1964/1965. As a result, it would be expected that significantly higher piping stresses, support and equipment loads would be generated for the BOPMEP evaluation than would be for the original plant. A discussion of the significant differences in analytical methods and criteria between BOPMEP and the original plant follows:

Original plant piping stress analysis was performed using static versus dynamic seismic analysis, per Reg. Guide 1.92 for closely spaced modes, for the BOPMEP evaluation. Also, the original analyses were based on ground motion spectra versus amplified in-structure response spectra used in the BOPMEP evaluation. A comparison of the peak accelerations from the BOPMEP seismic spectra curves with the peak of the original plant spectra curve indicates that resulting stresses and loads could be five times higher for the BOPMEP evaluation if only static seismic analysis was used in each case.

NOTE: OBE and DBE earthquakes were not addressed as such in 1964/65. A comparison of peak accelerations from BOPMEP seismic spectra curves was made against twice the peak of the original spectra curve, as shown in Figure 9.2 of the FSA, since the BOPMEP curves were DBE curves and the Figure 9.2 curve was based on a .25g earthquake. The .25g earthquake is considered comparable to the OBE and the DBE considered comparable to twice the .25g earthquake since the FSA required component functionality for an earthquake with a ground acceleration of twice that of the .25g earthquake. (See Section 9.2.6.3 of the SONGS 1 FSA).

Increases of 1.5 in piping seismic stresses and support and equipment loads could result due to dynamic vs. static analysis, and increases of 1.4 could result using closely spaced modes. Additional increases in stresses and loads could result due to differences in state of the art computer modeling techniques for concentrated and lumped masses.

Methods of combining earthquake loads also differed between BOPMEP and original plant analyses and could account for higher BOPMEP stresses. For BOPMEP, moments resulting from the three earthquake directions, two horizontal and one vertical, were combined using the square root of the sum of the equals method (SRSS); whereas, for the original plant, only one horizontal direction, the one providing highest moments, was combined with the vertical using absolute sum.

Application of stress intensification factors can also be cited as a major reason why piping stresses could be much higher for BOPMEP than for the original plant. For the original plant analyses, stress intensification factors were required to be used only for calculations of high cyclic stresses resulting from thermal expansion. Primary stresses due to weight and seismic loads would not have been considered to be of a

high cyclic nature and therefore, it is concluded that no stress intensification factors were considered in the calculation of these stresses. Stress intensification factors of up to ten were used in the BOPMEP analysis.

Certain piping systems were not considered to be safety related during the original plant design, e.g., the Auxiliary Feedwater Piping. Seismic analysis of this piping using BOPMEP analytical methods and criteria resulted in high piping stresses which would be expected when analyzing a previously non-seismic system as seismic.

Evaluation of small bore piping, piping less than, or equal to, two inches in diameter, for BOPMEP was based on very conservative assumptions and analytical techniques, e.g., rod hangers were considered to be nonexistent, very conservative valve weights were used, an empirical method of evaluation which would conservatively envelope dynamic effects was developed, etc.


Conclusion

It can be concluded that comparisons of resulting piping stresses and support and equipment loads using BOPMEP analytical methods and criteria versus those used for the original plant design could be significantly higher for piping systems considered safety related for both evaluation periods. Increases in stresses by as much as a couple orders of magnitude could be expected to occur considering only the effects of amplified spectra due to in-structure response, effects of dynamic analysis, effects of closely spaced modes and effects of stress intensification factors. Additional increases in stresses could also be expected due to differences in state of the art modeling techniques, and methods of combining earthquake loads.



PIPING FLEXIBILITY CALCULATION

BECHTEL CORPORATION
4550 SEVILLE AVENUE
VERNON, CALIFORNIA

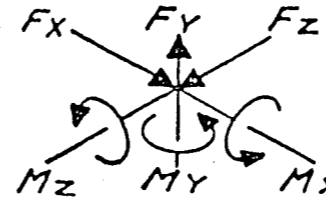

Sc = _____
Sh = _____
SA = 1.25Sc + .25Sh
SA = _____

MAXIMUM STRESS
AT POINT

PAGE 1 OF 21
3246-1

SIGNATURE W. J. [Signature] DATE 12-18-64
PROJECT SAH ONOPRE JOB NO. 3246
SUBJECT MAIN STM. X & Z ACCELERATION (EARTHQUAKE) (0.5G)

CONVENTION FOR
POSITIVE
FORCES & MOMENTS

DESIGN DATA

PRESS. _____

TEMP. 71°F

MAT'L CARB. STL.

EXP. COEF. .00000635

Ec x 10⁶ 27.9

MEMBER DATA

24" x .968 1 → 3, 8 → 12, 27, 25, 26

20" x .812 13, 16, 19 → 21, 27, 30 → 32

30" x 9.000 4 → 7, 17, 18, 23, 24, 28, 29


2" x .020 14, 15

ANCHOR DATA

ANCHOR COORDINATES | END DEFLECTION

| No. | Pt. | X | Y | Z | ΔX | ΔY | ΔZ |
|-----|-----|--------|--------|---------|----|----|----|
| A1 | 0 | 0 | 0 | 0 | 0 | 0 | 0 |
| A7 | 15 | 28.78' | -4.24' | 117.26' | 0 | 0 | 0 |
| A9 | 21 | 17.23' | 9.86' | 121.5' | 0 | 0 | 0 |
| A4 | 32 | -9.77' | 9.86' | 167.5' | 0 | 0 | 0 |

LINE: 1-24" EG TO 6-24" EG

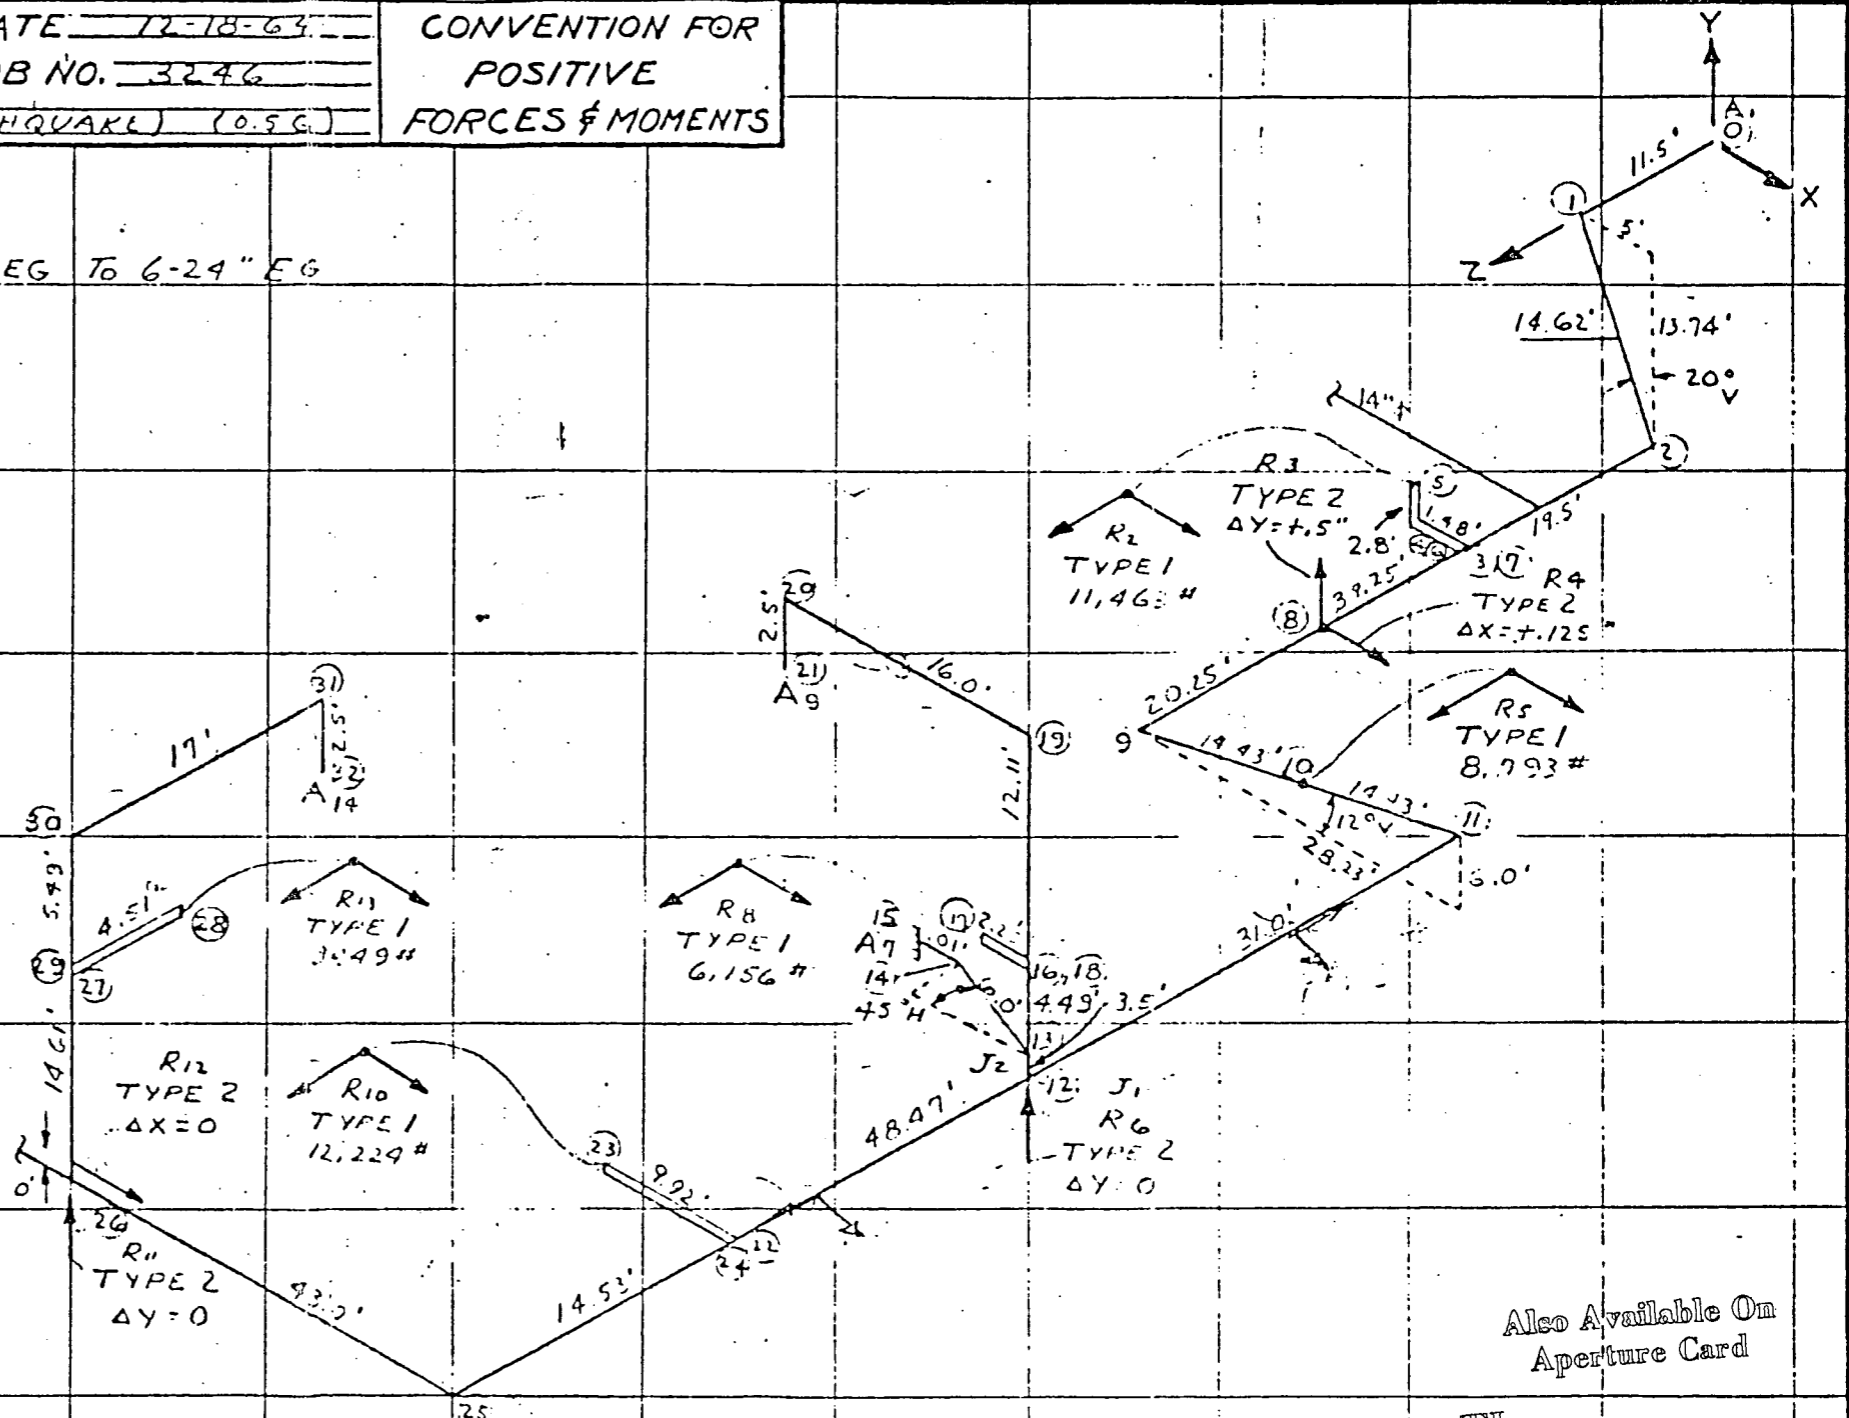

Also Available On
Aperture Card

TI
APERTURE
CARD

57-206
902-25
4/1/85
8504040294

8504040294-01

INPUT DATA FOR IBM


- THREE-PLANE PIPING STRESS ANALYSIS

ECC NO. SAN ONOFRE NAME W.D. GROSS
 MAIN STM X ACC.
 DATE 12-21-69 PAGE 3 OF 21

INSTRUCTIONS

- REFER TO DESIGN PRACTICE FOR DESCRIPTION OF PROGRAM.
- USE ONLY CAPITAL LETTERS AND ARABIC FIGURES, WRITE ALPHABETICAL LETTERS O THUS "0", AND I THUS "I"; FIGURES ZERO THUS "0", ONE THUS "1".
- ENTER DATA FOR EACH ANCHOR, STRAIGHT OR CURVED MEMBER, JUNCTION, OR RESTRAINT ON A SEPARATE LINE.
- NO ENTRY NEED BE MADE FOR ANCHOR DISPLACEMENTS. RESTRAINT DEFLECTION OR FORCE IF VALUES ARE ZERO.
- THE O.D., THICK., & TEMP. NEED TO BE ENTERED ONLY FOR THE FIRST STRAIGHT OR CURVED MEMBER. THESE VALUES WILL BE USED FOR ALL SUCCEEDING MEMBERS UNTIL DIFFERENT VALUES ARE ENTERED. THE NEW VALUES WILL THEN BE USED UNTIL ANOTHER ENTRY IS MADE.
- NUMBER STRAIGHT & CURVED MEMBERS CONSECUTIVELY STARTING WITH 1; DITTO FOR ANCHORS & RESTRAINTS; DITTO FOR JUNCTIONS.

| |
|---|
| 1 | 2 | 3 | 4 | 5 | 6 | 7 | 8 | 9 | 10 | 11 | 12 | 13 | 14 | 15 | 16 | 17 | 18 | 19 | 20 | 21 | 22 | 23 | 24 | 25 | 26 | 27 | 28 | 29 | 30 | 31 | 32 | 33 | 34 | 35 | 36 | 37 | 38 | 39 | 40 | 41 | 42 | 43 | 44 | 45 | 46 | 47 | 48 | 49 | 50 | 51 | 52 | 53 | 54 | 55 | 56 | 57 | 58 | 59 | 60 | 61 | 62 | 63 | 64 |
| NUMBER OF PROBLEMS IN RUN (FILL IN ON FIRST SHEET ONLY) | | | | | | | | | | | | | | | | | REFINERY OR PLANT | |
| PROJECT | | | | | | | | | | | | | | | | | DATE | |
| NAME | | | | | | | | | | | | | | | | | CASE | |
| LINE DESIG. | | | | | | | | | | | | | | | | | PRINT SHAPE COEFFICIENT | |
| SHAPE COEFFICIENT CHECK | | | | | | | | | | | | | | | | | PRINT EQUATIONS | |
| MODULUS OF ELASTICITY (PSI) | | | | | | | | | | | | | | | | | ALLOWABLE STRESS (PSI) | |
| EXPANSION COEFFICIENT (IN/IN/DEG. F) | | | | | | | | | | | | | | | | | NO. OF TYPE 1 & 3 RESTR. | |
| NUMBER OF RESTRAINTS | | | | | | | | | | | | | | | | | NO. OF PASSES | |

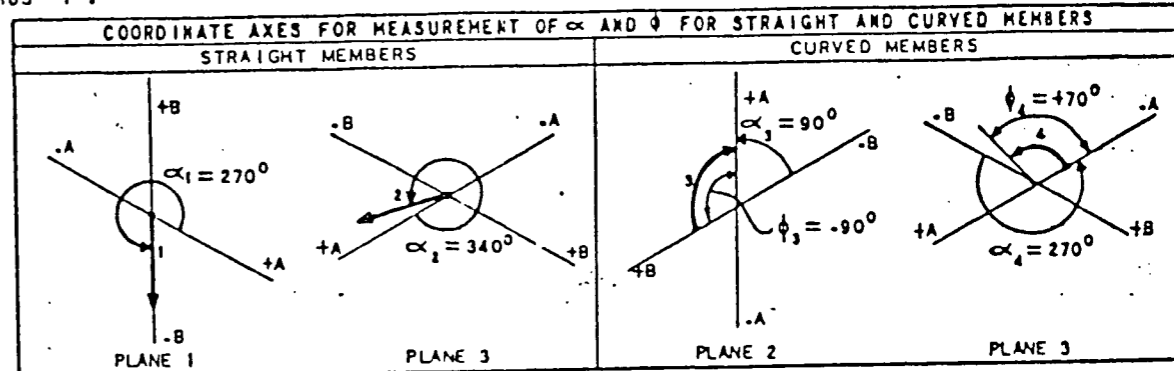


| TYPE OF MEMBER | MEMBER NO. | | STRAIGHT AND CURVED MEMBERS | | | | | | | | | | | CURVED ONLY | ANCHOR DISPLACEMENT | | | | | | RESTRAINTS | | | | | |
|--------------------------|--------------------|----------|-----------------------------|-----------------------|-----------------------|----------------|---------------------|-----------------------------------|-----------------|-----------------|-----------------|----------------|----------------|----------------|---------------------------------------|---|-----------------------------|--|--|--|------------|--|--|--|--|--|
| | STRAIGHT OR CURVED | JUNCTION | ANGLE α (DEG) | LENGTH OR RADIUS (FT) | OUTSIDE DIAMETER (IN) | THICKNESS (IN) | TEMP ΔT (F) | ROTATION AND ϕ (+ OR -, DEG) | ΔX (IN) | ΔY (IN) | ΔZ (IN) | ϕX (DEG) | ϕY (DEG) | ϕZ (DEG) | DEFLECTION FOR TYPE 2 RESTRAINTS (IN) | FORCE FOR TYPES 1 & 3 RESTRAINTS ONLY (LBS) | TYPE OF RESTRAINT 1, 2 OR 3 | | | | | | | | | |
| 24 | 2 | 2 | 90 | 9.92 | . | . | . | . | . | . | . | . | . | . | . | . | . | | | | | | | | | |
| 25 | 2 | 2 | 0 | 14.53 | 24. | .968 | . | . | . | . | . | . | . | . | . | . | | | | | | | | | | |
| 26 | 2 | 2 | 270 | 43. | . | . | . | . | . | . | . | . | . | . | . | . | | | | | | | | | | |
| 100 | 11 | 1 | . | . | . | . | . | . | . | . | . | . | . | . | . | . | | | | | | | | | | |
| 100 | 12 | 1 | . | . | . | . | . | . | . | . | . | . | . | . | . | . | | | | | | | | | | |
| 27 | 1 | 1 | 0 | 14.61 | 20. | .812 | . | . | . | . | . | . | . | . | . | . | | | | | | | | | | |
| 28 | 1 | 1 | 270 | 4.51 | 30. | 9. | . | . | . | . | . | . | . | . | 34.49 | 1 | | | | | | | | | | |
| 100 | 13 | 1 | . | . | . | . | . | . | . | . | . | . | . | . | . | . | | | | | | | | | | |
| 29 | 1 | 1 | 90 | 4.51 | . | . | . | . | . | . | . | . | . | . | . | . | | | | | | | | | | |
| 30 | 1 | 1 | 0 | 5.49 | 20. | .812 | . | . | . | . | . | . | . | . | . | . | | | | | | | | | | |
| 31 | 1 | 1 | 270 | 17. | . | . | . | . | . | . | . | . | . | . | . | . | | | | | | | | | | |
| 32 | 1 | 1 | 180 | 2.5 | . | . | . | . | . | . | . | . | . | . | . | . | | | | | | | | | | |
| 75 | 14 | 1 | . | . | . | . | . | . | 0.00 | 0.00 | 0.00 | . | . | . | . | . | | | | | | | | | | |
| ONE BLANK CARD GOES HERE | | | | | | | | | | | | | | | | | | | | | | | | | | |

8504040294-03

INSTRUCTIONS

- 1. REFER TO DESIGN PRACTICE FOR DESCRIPTION OF PROGRAM.
2. USE ONLY CAPITAL LETTERS AND ARABIC FIGURES, WRITE ALPHABETICAL LETTERS O THUS "0", AND I THUS "1"; FIGURES ZERO THUS "0", ONE THUS "1".
3. ENTER DATA FOR EACH ANCHOR, STRAIGHT OR CURVED MEMBER, JUNCTION, OR RESTRAINT ON A SEPARATE LINE.
4. NO ENTRY NEED BE MADE FOR ANCHOR DISPLACEMENTS, RESTRAINT DEFLECTION OR FORCE IF VALUES ARE ZERO.
5. THE O.D., THICK., & TEMP. NEED TO BE ENTERED ONLY FOR THE FIRST STRAIGHT OR CURVED MEMBER. THESE VALUES WILL BE USED FOR ALL SUCCEEDING MEMBERS UNTIL DIFFERENT VALUES ARE ENTERED. THE NEW VALUES WILL THEN BE USED UNTIL ANOTHER ENTRY IS MADE.
6. NUMBER STRAIGHT & CURVED MEMBERS CONSECUTIVELY STARTING WITH 1; DITTO FOR ANCHORS & RESTRAINTS; DITTO FOR JUNCTIONS.

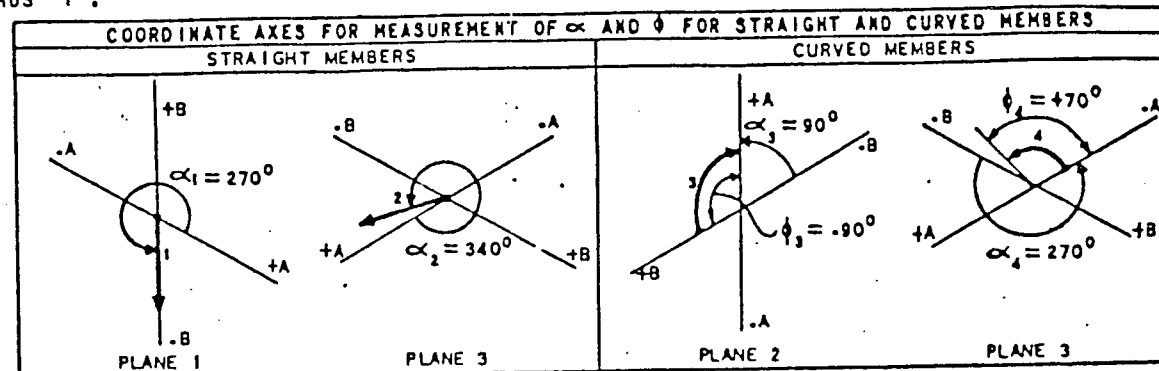

CARD NO. 1 2 3 4

Table with 64 columns for card numbers and fields for PROJECT, NAME, LINE DESIG. MAIN STEAM Z ACCELERATION, SHAPE COEFFICIENT CHECK, MODULUS OF ELASTICITY, EXPANSION COEFFICIENT, NUMBER OF RESTRAINTS, NO. OF TYPE 1 & 3 RESTR., NO. OF PASSES, PRINT SHAPE COEFFICIENT, PRINT EQUATIONS, ALLOWABLE STRESS.

Main data table with columns: TYPE OF MEMBER, MEMBER NO., STRAIGHT AND CURVED MEMBERS (ANGLE, LENGTH OR RADIUS, OUTSIDE DIAMETER, THICKNESS, TEMP, ROTATION), ANCHOR DISPLACEMENT (DELTA X, DELTA Y, DELTA Z, DELTA X, DELTA Y, DELTA Z), RESTRAINTS (DEFLECTION, FORCE), TYPE OF RESTRAINT.

CONTINUE ON SHEET #2
EXCEPT AS NOTED

API
APERTURE
CARD

Also Available On
Aperture Card

8504040294-04

PIPING FLEXIBILITY ANALYSIS

SAN ONOFRE MAIN STEAM X ACCELERATION .5G CASE 1 W D GROSS ENGINEERING DEPT. PROGRAM ENGR 33 DEC 21, 1964 SHEET 1

MODULUS OF ELASTICITY= 27900000. PSI EXPANSION COEFFICIENT= 0.00000638 IN/IN/DEG F ALLOWABLE STRESS= -0. PSI

STRAIGHT OR CURVED MEMBERS ANCHORS AND RESTRAINTS

MEMB NO. PLANE ALPHA DEG. LENGTH OR RADIUS, FT. O.D. IN. THICK. IN. TEMP. DEG.F. PHI DEG. (PHI X, Y, Z IN DEGREES---DELTA X, Y, Z IN INCHES)

Table with columns for member number, plane, alpha, length, o.d., thick., temp., phi, anchor no., phi x, phi y, phi z, delta x, delta y, delta z, restraint no., type, direction, deflection, force. Includes rows 1-23 and junctions 1 and 2.

TI APERTURE CARD

Also Available On Aperture Card

PIPING FLEXIBILITY ANALYSIS

STRAIGHT OR CURVED MEMBERS ANCHORS AND RESTRAINTS

| MEMB. NO. | PLANE | ALPHA DEG. | LENGTH OR RADIUS, FT. | O.D. IN. | THICK. IN. | TEMP. DEG. F. | PHI DEG. | (PHI X, Y, Z IN DEGREES---DELTA X, Y, Z IN INCHES) | | | | | | |
|-----------|-------|------------|-----------------------|----------|------------|---------------|----------|--|-------------|-------------|-----------------------|---------------------|---------------|---------------|
| 24 | 2 | 90. | 9.92 | 30.000 | 9.000 | 1. | | | | | | | | |
| 25 | 2 | 0. | 14.53 | 24.000 | 0.968 | 1. | | | | | | | | |
| 26 | 2 | 270. | 43.00 | 24.000 | 0.968 | 1. | | | | | | | | |
| | | | | | | | | RESTRAINT NO.11 | TYPE 2 | DIRECTION 2 | DEFLECTION, IN. 0.000 | FORCE, LBS. 0.00 | | |
| | | | | | | | | RESTRAINT NO.12 | TYPE 2 | DIRECTION 1 | DEFLECTION, IN. 0.000 | FORCE, LBS. 0.00 | | |
| 27 | 1 | 0. | 14.61 | 20.000 | 0.812 | 1. | | | | | | | | |
| 28 | 1 | 270. | 4.51 | 30.000 | 9.000 | 1. | | | | | | | | |
| | | | | | | | | RESTRAINT NO.13 | TYPE 1 | DIRECTION 1 | DEFLECTION, IN. 0.000 | FORCE, LBS. 3449.00 | | |
| 29 | 1 | 90. | 4.51 | 30.000 | 9.000 | 1. | | | | | | | | |
| 30 | 1 | 0. | 5.49 | 20.000 | 0.812 | 1. | | | | | | | | |
| 31 | 1 | 270. | 17.00 | 20.000 | 0.812 | 1. | | | | | | | | |
| 32 | 1 | 180. | 2.50 | 20.000 | 0.812 | 1. | | | | | | | | |
| | | | | | | | | ANCHOR NO.14 | PHI X 0.000 | PHI Y 0.000 | PHI Z 0.000 | DELTA X 0.000 | DELTA Y 0.000 | DELTA Z 0.000 |

TI
APERTURE
CARD

8504040294-07

Also Available On
Aperture Card

MAIN STEAM X ACCELERATION .5G

PIPING FLEXIBILITY ANALYSIS-ENGR 33
CASE 1 W D GROSS

DEC 21, 1964

| ANCHOR | X (FT) | Y (FT) | Z (FT) | EIDX (LB-FT*3) | EIDY (LB-FT*3) | EIDZ (LB-FT*3) |
|--------|-----------|-----------|-----------|-------------------|-------------------|-------------------|
| 7 | 28.98 ✓ | -4.24 ✓ | 117.26 ✓ | -166652.94 | 24373.47 | -674371.42 |
| 9 | 17.23 ✓ | 9.86 ✓ | 121.50 ✓ | -99091.43 | -56718.56 | -698771.75 |
| 14 | -9.77 ✓ | 9.86 ✓ | 167.50 ✓ | 56191.19 | -56718.55 | -963327.27 |

OK

TEST NO. 6 OKAY

TI
APERTURE
CARD

Also Available On
Aperture Card

8504040204-08

MAIN STEAM X ACCELERATION .5G

PIPING FLEXIBILITY ANALYSIS-ENGR 33
CASE 1 W D GROSS

DEC 21, 1964

DEFLECTION OR FORCE AT RESTRAINTS

| RESTRAINT NUMBER | DEFLECTION (IN) | FORCE ON ORIGIN (LBS) | FORCE ON RESTRAINT (LBS) |
|-----------------------|-----------------|-----------------------|--------------------------|
| TYPE 1 OR 3 -- TYPE 2 | | | |
| 2 | .45794 | | |
| 5 | .35661 | | |
| 8 | .17055 | | |
| 10 | .24326 | | |
| 13 | .07494 | | |
| | | 1845.99 | -1845.99 |
| | | -10892.22 | 10892.22 |
| | | -5981.27 | 5981.27 |
| | | 2670.05 | -2670.05 |
| | | -11045.89 | 11045.89 |

TOTAL MOMENTS AND FORCES ON ANCHORS

| ANCHOR | MX (FT-LBS) | MY (FT-LBS) | MZ (FT-LBS) | FX (LBS) | FY (LBS) | FZ (LBS) |
|--------|-------------|-------------|-------------|----------|----------|----------|
| 1 | -13360.46 | 94870.33 | 49271.56 | 6178.27 | 880.88 | -1549.29 |
| 7 | 13.98 | 334.56 | 5.16 | 5101.82 | -3.24 | 4920.49 |
| 9 | 8926.49 | 17257.27 | -31944.18 | 6445.07 | -4686.52 | -1502.87 |
| 14 | -14291.14 | 29964.91 | -9353.43 | 2421.73 | 2343.66 | -1868.34 |

ROTATION AND DEFLECTION OF MEMBERS

| MEMBER | PHI X (DEG) | PHI Y (DEG) | PHI Z (DEG) | DELTA X (IN) | DELTA Y (IN) | DELTA Z (IN) |
|--------|-------------|-------------|-------------|--------------|--------------|--------------|
| ORIGIN | .000 | .000 | .000 | .000 | .000 | .000 |
| 1 | -.006 | .043 | .047 | .065 | .009 | .001 |
| 2 | -.021 | .068 | .051 | .229 | .067 | -.024 |
| 3 | -.041 | .013 | -.013 | .450 | .202 | -.023 |
| 4 | -.041 | .012 | -.014 | .450 | .206 | -.019 |
| 5 | -.041 | .009 | -.014 | .458 | .207 | -.043 |
| 6 | -.041 | .006 | -.015 | .449 | .206 | -.019 |
| 7 | -.041 | .005 | -.015 | .449 | .202 | -.021 |
| 8 | -.017 | .004 | -.040 | .125 | .500 | -.018 |
| 9 | .006 | .063 | -.054 | .322 | .513 | -.017 |
| 10 | .017 | .044 | -.047 | .357 | .357 | -.174 |
| 11 | .031 | .004 | -.025 | .380 | .250 | -.236 |
| 12 | .035 | -.005 | .044 | .268 | .000 | -.234 |
| 13 | .038 | -.001 | .057 | .230 | .000 | -.207 |
| 14 | .000 | .002 | .000 | -.002 | -.000 | .000 |
| 15 | -.000 | .000 | .000 | -.002 | -.000 | .000 |
| 16 | .044 | .004 | .069 | .171 | .001 | -.169 |
| 17 | .044 | .004 | .069 | .171 | -.031 | -.166 |
| 18 | .044 | .004 | .070 | .171 | .001 | -.168 |
| 19 | .038 | .018 | .038 | .005 | .003 | -.057 |
| 20 | .004 | .007 | -.008 | .003 | .000 | .001 |
| 21 | .000 | -.000 | .000 | -.000 | .000 | .000 |
| 22 | .019 | -.055 | -.006 | .244 | -.235 | -.229 |
| 23 | .019 | -.061 | -.007 | .243 | -.221 | -.350 |
| 24 | .020 | -.067 | -.008 | .244 | -.236 | -.216 |
| 25 | .024 | -.064 | -.023 | .006 | -.302 | -.215 |
| 26 | .050 | .034 | -.038 | -.000 | .000 | -.183 |

APERTURE CARD

Also Available On Aperture Card

8504040294-09

PIPING FLEXIBILITY ANALYSIS-ENGR 33
CASE 1 W D GROSS

DEC 21, 1964

MAIN STEAM X ACCELERATION .5G

ROTATION AND DEFLECTION OF MEMBERS

| MEMBER | PHI X (DEG) | PHI Y (DEG) | PHI Z (DEG) | DELTA X (IN) | DELTA Y (IN) | DELTA Z (IN) |
|--------|----------------|----------------|----------------|-----------------|-----------------|-----------------|
| 27 | .038 | .023 | -.020 | .097 | .001 | -.034 |
| 28 | .038 | .023 | -.020 | .075 | .037 | -.034 |
| 29 | .037 | .023 | -.019 | .097 | .001 | -.034 |
| 30 | .019 | .034 | -.012 | .113 | .001 | -.000 |
| 31 | -.004 | .013 | -.002 | .001 | .000 | -.001 |
| 32 | -.000 | -.000 | .000 | -.000 | .000 | -.000 |

TI
APERTURE
CARD

8504040294-10

Also Available On
Aperture Card

PIPING FLEXIBILITY ANALYSIS-ENGR 33
CASE 1 W D GROSS

MAIN STEAM X ACCELERATION .5G

DEC 21, 1964

STRESS, MOMENTS AND FORCES ON MEMBERS

| MEMBER START/END | STRESS (PSI) | MX (FT-LBS) | MY (FT-LBS) | MZ (FT-LBS) | FX (LBS) | FY (LBS) | FZ (LBS) |
|---------------------|-----------------|----------------|----------------|----------------|-------------|-------------|-------------|
| 1 | 3334.40 | -13360.46 | 94870.33 | 49271.56 | 6178.27 | 880.88 | -1549.29 |
| 2 | 1696.78 | -3230.40 | 23820.22 | 49271.56 | 6178.27 | 880.88 | -1549.29 |
| 3 | 1535.18 | -24514.99 | 16073.26 | -40012.08 | 6178.27 | 880.88 | -1549.29 |
| 4 | 520.58 | -7337.92 | -104403.02 | -40012.08 | 6178.27 | 880.88 | -1549.29 |
| 5 | 508.49 | -7337.92 | -102110.07 | -38708.39 | 6178.27 | 880.88 | -1549.29 |
| 6 | 484.92 | -2999.92 | -102110.07 | -21409.23 | 6178.27 | 880.88 | -1549.29 |
| 7 | 476.62 | -7337.92 | -102110.07 | -6611.99 | -5284.73 | 880.88 | -1549.29 |
| 8 | 487.64 | -7337.92 | -104403.02 | -7915.68 | -5284.73 | 880.88 | -1549.29 |
| 9 | 3248.53 | -7337.92 | -104403.02 | -7915.68 | -5284.73 | 880.88 | -1549.29 |
| 10 | 3307.22 | 27236.43 | 103022.60 | -7915.68 | 5607.49 | -965.11 | -1549.29 |
| 11 | 3307.22 | 27236.43 | 103022.60 | -7915.68 | 5607.49 | -965.11 | -1549.29 |
| 12 | 472.13 | 7692.95 | -10529.06 | -7915.68 | 5607.49 | -965.11 | -1549.29 |
| 13 | 472.13 | 7692.95 | -10529.06 | -7915.68 | 5607.49 | -965.11 | -1549.29 |
| 14 | 1279.66 | 12341.07 | -32396.75 | 22529.92 | 5607.49 | -965.11 | -1549.29 |
| 15 | 1279.66 | 12341.07 | -32396.75 | 22529.92 | -3185.51 | -965.11 | -1549.29 |
| 16 | 1942.87 | 16989.19 | -54264.44 | 26595.08 | -3185.51 | -965.11 | -1549.29 |
| 17 | 1942.87 | 16989.19 | -54264.44 | 26595.08 | -3185.51 | -965.11 | -1549.29 |
| 18 | 1653.31 | -12929.22 | 44486.38 | 26595.08 | -3185.51 | -965.11 | -1549.29 |
| 19 | 2110.95 | 301.99 | 7174.14 | 39044.08 | -5390.89 | 4689.76 | -3417.62 |
| 20 | 1312.15 | 12263.67 | 7174.14 | 20175.96 | -5390.89 | 4689.76 | -3417.62 |
| 21 | 9989.94 | -24 | 385.56 | -18.94 | -5101.82 | 3.24 | 4920.49 |
| 22 | 9938.81 | -13.98 | -383.76 | -5.20 | -5101.82 | 3.24 | 4920.49 |
| 23 | 9938.81 | -13.98 | -383.76 | -5.20 | -5101.82 | 3.24 | 4920.49 |
| 24 | 8666.47 | -13.98 | -334.55 | -5.16 | -5101.82 | 3.24 | 4920.49 |
| 25 | 1307.17 | 12263.91 | 6788.59 | 20194.89 | -289.07 | 4686.52 | 1502.87 |
| 26 | 1107.25 | 5516.05 | 6788.59 | 18896.95 | -289.07 | 4686.52 | 1502.87 |
| 27 | 96.74 | 5516.05 | 6788.59 | 18896.95 | -289.07 | 4686.52 | 1502.87 |
| 28 | 140.06 | 5516.05 | 3407.14 | 29441.63 | -6445.07 | 4686.52 | 1502.87 |
| 29 | 140.06 | 5516.05 | 3407.13 | 29441.63 | -6445.07 | 4686.52 | 1502.87 |
| 30 | 96.74 | 5516.05 | 6788.58 | 18896.95 | -6445.07 | 4686.52 | 1502.87 |
| 31 | 1107.25 | 5516.05 | 6788.58 | 18896.95 | -6445.07 | 4686.52 | 1502.87 |
| 32 | 3237.08 | -12683.65 | 6788.58 | -59152.88 | -6445.07 | 4686.52 | 1502.87 |
| 33 | 3237.08 | -12683.65 | 6788.58 | -59152.88 | -6445.07 | 4686.52 | 1502.87 |
| 34 | 1416.19 | -12683.65 | -17257.27 | 15831.49 | -6445.07 | 4686.52 | 1502.87 |
| 35 | 1416.19 | -12683.65 | -17257.27 | 15831.49 | -6445.07 | 4686.52 | 1502.87 |
| 36 | 1988.11 | -8926.48 | -17257.27 | 31944.17 | -6445.07 | 4686.52 | 1502.87 |
| 37 | 1284.44 | -13231.21 | 37312.23 | -12449.00 | 2205.38 | 326.39 | 1868.34 |
| 38 | 2189.27 | 2589.11 | -69582.61 | -12449.00 | 2205.38 | 326.39 | 1868.34 |
| 39 | 328.64 | 2589.11 | -88116.49 | -9211.18 | 2205.38 | 326.39 | 1868.34 |
| 40 | 411.80 | 2589.11 | -88116.50 | -9211.18 | -10018.62 | 326.39 | 1868.34 |
| 41 | 411.80 | 2589.11 | -88116.50 | -9211.18 | -10018.62 | 326.39 | 1868.34 |
| 42 | 328.64 | 2589.11 | -69582.61 | -12449.00 | -10018.62 | 326.39 | 1868.34 |
| 43 | 2189.27 | 2589.11 | -69582.61 | -12449.00 | -10018.62 | 326.39 | 1868.34 |
| 44 | 2393.98 | 7331.61 | 75987.89 | -12449.00 | -10018.62 | 326.39 | 1868.34 |

Also Available On
Aperture Card

TI
APERTURE
CARD

8504040294-11

PIPING FLEXIBILITY ANALYSIS-ENGR 33
CASE 1 W D GROSS

DEC 21, 1964

MAIN STEAM X ACCELERATION .5G

| MEMBER START/END | STRESS (PSI) | STRESS, MOMENTS AND FORCES ON MEMBERS | | | | | |
|---------------------|-----------------|---------------------------------------|----------------|----------------|-------------|-------------|-------------|
| | | MX (FT-LBS) | MY (FT-LBS) | MZ (FT-LBS) | FX (LBS) | FY (LBS) | FZ (LBS) |
| 26 | 2393.98 | 7331.61 | 75987.89 | -12449.00 | -10018.62 | 326.39 | 1868.34 |
| | 268.39 | 7331.61 | -4350.55 | 1585.93 | -10018.62 | 326.39 | 1868.34 |
| 27 | 461.10 | 7331.61 | -4350.54 | 1585.93 | 1027.27 | -2343.66 | 1868.34 |
| | 1399.69 | -19964.77 | -4350.54 | 16594.39 | 1027.27 | -2343.66 | 1868.34 |
| 28 | 122.30 | -19964.77 | -4350.54 | 16594.39 | 1027.27 | -2343.66 | 1868.34 |
| | 88.61 | -9394.85 | 282.46 | 16594.39 | 1027.27 | -2343.66 | 1868.34 |
| 29 | 88.61 | -9394.85 | 282.45 | 16594.39 | -2421.73 | -2343.66 | 1868.34 |
| | 131.37 | -19964.76 | 11204.44 | 16594.39 | -2421.73 | -2343.66 | 1868.34 |
| 30 | 1503.52 | -19964.76 | 11204.44 | 16594.39 | -2421.73 | -2343.66 | 1868.34 |
| | 1722.86 | -30221.92 | 11204.44 | 3299.10 | -2421.73 | -2343.66 | 1868.34 |
| 31 | 1722.86 | -30221.92 | 11204.44 | 3299.10 | -2421.73 | -2343.66 | 1868.34 |
| | 1682.63 | 9620.31 | -29964.93 | 3299.11 | -2421.73 | -2343.66 | 1868.34 |
| 32 | 1682.63 | 9620.31 | -29964.93 | 3299.11 | -2421.73 | -2343.66 | 1868.34 |
| | 1834.02 | 14291.15 | -29964.93 | 9353.42 | -2421.73 | -2343.66 | 1868.34 |

Also Available On
Aperture Card

TI
APERTURE
CARD

8504040294-12

PIPING FLEXIBILITY ANALYSIS

SAN ONOFRE MAIN STEAM Z ACCELERATION .5G CASE 1 W D GROSS ENGINEERING DEPT. PROGRAM ENGR 33 DEC 21, 1964 SHEET 1

INPUT DATA

MODULUS OF ELASTICITY= 27900000. PSI EXPANSION COEFFICIENT= 0.0000638 IN/IN/DEG F ALLOWABLE STRESS= -7. PSI

STRAIGHT OR CURVED MEMBERS ANCHORS AND RESTRAINTS

MEMB. ALPHA LENGTH OR O.D. THICK. TEMP. PHI (PHI X,Y,Z IN DEGREES---DELTA X,Y,Z IN INCHES) NO. PLANE DEG. RADIUS, FT. IN. IN. DEG.F. DEG.

Table with columns for member number, plane, alpha, length, O.D., thickness, temperature, phi, anchor number, phi x, phi y, phi z, delta x, delta y, delta z, restraint number, type, direction, deflection, and force.

Also Available On Aperture Card

TI APERTURE CARD

8504040294-13

(14)

PIPING FLEXIBILITY ANALYSIS

STRAIGHT OR CURVED MEMBERS

ANCHORS AND RESTRAINTS

| MEMB. NO. | PLANE | ALPHA DEG. | LENGTH OR RADIUS, FT. | O.D. IN. | THICK. IN. | TEMP. DEG. F. | PHI DEG. | (PHI X, Y, Z IN DEGREES---DELTA X, Y, Z IN INCHES) | | | | | | |
|-----------|-------|------------|-----------------------|----------|------------|---------------|----------|--|-------------|-------------|-----------------------|---------------------|---------------|---------------|
| 24 | 2 | 90. | 9.92 | 30.000 | 9.000 | 1. | | | | | | | | |
| 25 | 2 | 0. | 14.53 | 24.000 | 0.968 | 1. | | | | | | | | |
| 26 | 2 | 270. | 43.00 | 24.000 | 0.968 | 1. | | | | | | | | |
| | | | | | | | | RESTRAINT NO.11 | TYPE 2 | DIRECTION 2 | DEFLECTION, IN. 0.000 | FORCE, LBS. 0.00 | | |
| | | | | | | | | RESTRAINT NO.12 | TYPE 2 | DIRECTION 1 | DEFLECTION, IN. 0.000 | FORCE, LBS. 0.00 | | |
| 27 | 1 | 0. | 14.61 | 20.000 | 0.812 | 1. | | | | | | | | |
| 28 | 1 | 270. | 4.51 | 30.000 | 9.000 | 1. | | RESTRAINT NO.13 | TYPE 1 | DIRECTION 3 | DEFLECTION, IN. 0.000 | FORCE, LBS. 3449.00 | | |
| 29 | 1 | 90. | 4.51 | 30.000 | 9.000 | 1. | | | | | | | | |
| 30 | 1 | 0. | 5.49 | 20.000 | 0.812 | 1. | | | | | | | | |
| 31 | 1 | 270. | 17.00 | 20.000 | 0.812 | 1. | | | | | | | | |
| 32 | 1 | 180. | 2.50 | 20.000 | 0.812 | 1. | | ANCHOR NO.14 | PHI X 0.000 | PHI Y 0.000 | PHI Z 0.000 | DELTA X 0.000 | DELTA Y 0.000 | DELTA Z 0.000 |

Also Available On Aperture Card

TI APERTURE CARD

8504040294-14

PIPING FLEXIBILITY ANALYSIS-ENGR 33

2 MAIN STEAM Z ACCELERATION .5G

CASE 1 W O GROSS

DEC 21, 1964

FREE ENDS - COORDINATES AND EXPANSION VALUES

| ANCHOR | X (FT) | Y (FT) | Z (FT) | EIDX (LB-FT*3) | EIDY (LB-FT*3) | EIDZ (LB-FT*3) |
|--------|-----------|-----------|-----------|-------------------|-------------------|-------------------|
| 7 | 28.98 ✓ | -4.24 ✓ | 117.26 ✓ | -166652.94 | 24373.47 | -674371.42 |
| 9 | 17.23 ✓ | 9.86 ✓ | 121.50 ✓ | -99091.43 | -56718.56 | -698771.75 |
| 14 | -9.77 ✓ | 9.86 ✓ | 167.50 ✓ | 56191.19 | -56718.55 | -963327.27 |

OK

TEST NO. 6 OKAY

Also Available On Aperture Card

TI APERTURE CARD

8504040294-15

| DEFLECTION OR FORCE AT RESTRAINTS | | | |
|-----------------------------------|-----------------|-----------------------|--------------------------|
| RESTRAINT NUMBER | DEFLECTION (IN) | FORCE ON ORIGIN (LBS) | FORCE ON RESTRAINT (LBS) |
| TYPE 1 OR 3 — TYPE 2 | | | |
| 2 | .31967 | | |
| 5 | .56559 | | |
| 8 | .53680 | | |
| 10 | .99951 | | |
| 13 | .06636 | | |
| | | 1145.53 | -1145.53 |
| | | 6519.75 | -6519.75 |
| | | 10596.65 | -10596.65 |
| | | -5099.40 | 5099.40 |
| | | 627.11 | -627.11 |

| TOTAL MOMENTS AND FORCES ON ANCHORS | | | | | | |
|-------------------------------------|-------------|-------------|-------------|-----------|----------|----------|
| ANCHOR | MX (FT-LBS) | MY (FT-LBS) | MZ (FT-LBS) | FX (LBS) | FY (LBS) | FZ (LBS) |
| 1 | -110296.02 | -1623.50 | 4507.69 | 1673.70 | -276.98 | 12602.36 |
| 7 | -46.60 | -1231.97 | -7.10 | 17518.48 | 13.98 | 18007.65 |
| 9 | -22694.42 | -72531.00 | 68573.94 | -11673.80 | 11039.20 | 5436.73 |
| 14 | 30472.30 | -18369.98 | 4996.72 | -371.53 | -4133.40 | 6038.26 |

| ROTATION AND DEFLECTION OF MEMBERS | | | | | | |
|------------------------------------|-------------|-------------|-------------|--------------|--------------|--------------|
| MEMBER | PHI X (DEG) | PHI Y (DEG) | PHI Z (DEG) | DELTA X (IN) | DELTA Y (IN) | DELTA Z (IN) |
| ORIGIN | .000 | .000 | .000 | .000 | .000 | .000 |
| 1 | -.082 | -.008 | .004 | -.006 | .098 | .002 |
| 2 | -.109 | .007 | -.002 | .003 | .100 | .326 |
| 3 | -.038 | .039 | -.029 | .111 | .397 | .329 |
| 4 | -.037 | .039 | -.029 | .111 | .406 | .341 |
| 5 | -.036 | .038 | -.030 | .128 | .407 | .320 |
| 6 | -.036 | .038 | -.030 | .111 | .406 | .341 |
| 7 | -.036 | .038 | -.030 | .111 | .397 | .329 |
| 8 | .006 | -.062 | -.086 | .125 | .500 | .332 |
| 9 | .002 | -.093 | -.114 | -.253 | .469 | .334 |
| 10 | -.019 | -.064 | -.127 | -.176 | .111 | .566 |
| 11 | -.031 | -.076 | -.135 | -.093 | -.279 | .729 |
| 12 | -.070 | -.060 | -.151 | -.702 | -.000 | .729 |
| 13 | -.096 | -.061 | -.172 | -.585 | -.000 | .664 |
| 14 | -.000 | -.007 | -.000 | -.005 | -.001 | .002 |
| 15 | -.000 | .001 | .000 | -.003 | -.000 | .002 |
| 16 | -.113 | -.062 | -.190 | -.410 | -.000 | .566 |
| 17 | -.113 | -.062 | -.190 | -.410 | .089 | .537 |
| 18 | -.114 | -.062 | -.191 | -.410 | -.001 | .566 |
| 19 | -.109 | -.092 | -.085 | -.007 | -.001 | .259 |
| 20 | -.010 | -.031 | .018 | -.006 | .000 | -.002 |
| 21 | .000 | .000 | -.000 | .000 | -.000 | .000 |
| 22 | -.004 | .127 | -.031 | -.238 | .255 | .736 |
| 23 | -.005 | .126 | -.029 | -.238 | .317 | 1.350 |
| 24 | -.005 | .120 | -.027 | -.238 | .259 | .743 |
| 25 | -.013 | .035 | .009 | .003 | .282 | .744 |
| 26 | -.070 | -.084 | .034 | .000 | -.000 | .294 |

Also Available On Aperture Card

8504040294-16

TI APERTURE CARD

ROTATION AND DEFLECTION OF MEMBERS

| MEMBER | PHI X (DEG) | PHI Y (DEG) | PHI Z (DEG) | DELTA X (IN) | DELTA Y (IN) | DELTA Z (IN) |
|--------|-------------|-------------|-------------|--------------|--------------|--------------|
| 27 | -.065 | -.054 | .017 | -.076 | .002 | .067 |
| 28 | -.064 | -.053 | .017 | -.026 | -.059 | .066 |
| 29 | -.064 | -.053 | .017 | -.076 | .001 | .067 |
| 30 | -.037 | -.042 | .013 | -.093 | .002 | .005 |
| 31 | .008 | -.008 | .001 | -.000 | .000 | .003 |
| 32 | .000 | -.000 | -.000 | .000 | -.000 | .000 |

Also Available On Aperture Card

TI APERTURE CARD

PIPING FLEXIBILITY ANALYSIS-ENGR 33

MAIN STEAM 7 ACCELERATION .5G

CASE 1

W D GROSS

DEC 21, 1964

STRESS, MOMENTS AND FORCES ON MEMBERS

| MEMBER START/END | STRESS (PSI) | MX (FT-LBS) | MY (FT-LBS) | MZ (FT-LBS) | FX (LBS) | FY (LBS) | FZ (LBS) |
|---------------------|-----------------|----------------|----------------|----------------|-------------|-------------|-------------|
| 1 | 3416.92 | -110296.02 | -1623.50 | 4507.69 | 1673.70 | -276.98 | 12602.36 |
| | 3573.92 | -113481.32 | -20871.08 | 4507.69 | 1673.70 | -276.98 | 12602.36 |
| 2 | 3573.92 | -113481.32 | -20871.08 | 4507.69 | 1673.70 | -276.98 | 12602.36 |
| | 2321.74 | 59653.80 | 42144.94 | -17101.13 | 1673.70 | -276.98 | 12602.36 |
| 3 | 2321.74 | 59653.80 | 42144.94 | -17101.13 | 1673.70 | -276.98 | 12602.36 |
| | 1785.01 | 54252.63 | 9507.75 | -17101.13 | 1673.70 | -276.98 | 12602.36 |
| 4 | 267.95 | 54252.63 | 9507.75 | -17101.13 | 1673.70 | -276.98 | 12602.36 |
| | 268.25 | 54252.63 | -9143.75 | -17511.07 | 1673.70 | -276.98 | 12602.36 |
| 5 | 268.25 | 54252.63 | -9143.75 | -17511.07 | 1673.70 | -276.98 | 12602.36 |
| | 114.54 | 18966.01 | -9143.75 | -12824.70 | 1673.70 | -276.98 | 12602.36 |
| 6 | 114.54 | 18966.01 | -9143.75 | -12824.70 | 1673.70 | -276.98 | 1139.36 |
| | 137.91 | 22156.23 | -9143.75 | -17511.07 | 1673.70 | -276.98 | 1139.36 |
| 7 | 137.91 | 22156.23 | -9143.75 | -17511.07 | 1673.70 | -276.98 | 1139.36 |
| | 134.57 | 22156.23 | -7457.49 | -17101.13 | 1673.70 | -276.98 | 1139.36 |
| 8 | 896.47 | 22156.23 | -7457.49 | -17101.13 | 1673.70 | -276.98 | 1139.36 |
| | 2351.16 | 11284.64 | -73150.30 | -17101.13 | 1673.70 | -276.98 | 1139.36 |
| 9 | 2351.16 | 11284.64 | -73150.30 | -17101.13 | -4846.04 | -1422.52 | 1139.36 |
| | 1082.62 | -17521.32 | 24982.07 | -17101.13 | -4846.04 | -1422.52 | 1139.36 |
| 10 | 1082.62 | -17521.32 | 24982.07 | -17101.13 | -4846.04 | -1422.52 | 1139.36 |
| | 1470.83 | -20939.59 | 41063.81 | -11561.72 | -4846.04 | -1422.52 | 1139.36 |
| 11 | 1470.84 | -20939.60 | 41063.81 | -11561.72 | -4846.04 | -1422.52 | -7653.64 |
| | 2081.89 | 2022.58 | -66964.74 | -6022.30 | -4846.04 | -1422.52 | -7653.64 |
| 12 | 2081.89 | 2022.58 | -66964.74 | -6022.30 | -4846.04 | -1422.52 | -7653.64 |
| | 2893.37 | -42075.42 | 83262.59 | -6022.30 | -4846.04 | -1422.52 | -7653.64 |
| 13 | 5000.18 | -86844.97 | -1629.06 | -36024.43 | -5844.68 | -11053.18 | -17288.37 |
| | 3314.88 | -26335.67 | -1629.06 | -56480.80 | -5844.68 | -11053.18 | -17288.37 |
| 14 | 26542.93 | -12.69 | -1023.42 | 66.54 | 17518.48 | -13.98 | -18007.65 |
| | 27249.48 | 46.61 | 1051.91 | 7.24 | 17518.48 | -13.98 | -18007.65 |
| 15 | 27249.48 | 46.61 | 1051.91 | 7.24 | 17518.48 | -13.98 | -18007.65 |
| | 31905.27 | 46.61 | 1231.97 | 7.10 | 17518.48 | -13.98 | -18007.65 |
| 16 | 3316.82 | -26322.98 | -605.64 | -56547.35 | 11673.80 | -11039.20 | 719.27 |
| | 1587.04 | -29552.52 | -605.64 | -4131.97 | 11673.80 | -11039.20 | 719.27 |
| 17 | 138.67 | -29552.52 | -605.64 | -4131.97 | 11673.80 | -11039.20 | 719.27 |
| | 192.55 | -29552.52 | -2224.02 | -28970.17 | 11673.80 | -11039.20 | 719.27 |
| 18 | 192.55 | -29552.52 | -2224.02 | -28970.17 | 11673.80 | -11039.20 | -5436.73 |
| | 154.05 | -29552.52 | -14456.64 | -4131.97 | 11673.80 | -11039.20 | -5436.73 |
| 19 | 1763.12 | -29552.52 | -14456.64 | -4131.97 | 11673.80 | -11039.20 | -5436.73 |
| | 7587.29 | 36286.23 | -14456.64 | 137237.80 | 11673.80 | -11039.20 | -5436.73 |
| 20 | 7587.29 | 36286.23 | -14456.64 | 137237.80 | 11673.80 | -11039.20 | -5436.73 |
| | 4794.21 | 36286.23 | 72530.98 | -39389.42 | 11673.80 | -11039.20 | -5436.73 |
| 21 | 4794.21 | 36286.23 | 72530.98 | -39389.42 | 11673.80 | -11039.20 | -5436.73 |
| | 5443.04 | 22694.42 | 72530.98 | -68573.93 | 11673.80 | -11039.20 | -5436.73 |
| 22 | 3112.17 | 44769.54 | 84891.65 | 30002.13 | 998.64 | -965.99 | 9634.74 |
| | 1463.43 | -2052.13 | 36487.79 | 30002.13 | 998.64 | -965.99 | 9634.74 |
| 23 | 219.68 | -2052.13 | 36487.79 | 30002.13 | 998.64 | -965.99 | 9634.74 |
| | 290.61 | -2052.13 | -59088.79 | 20419.48 | 998.64 | -965.99 | 9634.74 |
| 24 | 290.61 | -2052.13 | -59088.79 | 20419.48 | 998.64 | -965.99 | -2589.26 |
| | 417.91 | -2052.13 | -84774.29 | 30002.13 | 998.64 | -965.99 | -2589.26 |
| 25 | 2783.99 | -2052.13 | -84774.29 | 30002.13 | 998.64 | -965.99 | -2589.26 |
| | 3248.51 | -16088.01 | -99284.46 | 30002.13 | 998.64 | -965.99 | -2589.26 |

Also Available On Aperture Card

TI APERTURE CARD

8504040294-18

PIPING FLEXIBILITY ANALYSIS-ENGR 33

CASE 1 W D GROSS

DEC 21, 1964

MAIN STEAM Z ACCELERATION .5G


STRESS, MOMENTS AND FORCES ON MEMBERS

| MEMBER START/END | STRESS (PSI) | MX (FT-LBS) | MY (FT-LBS) | MZ (FT-LBS) | FX (LBS) | FY (LBS) | FZ (LBS) |
|---------------------|-----------------|----------------|----------------|----------------|-------------|-------------|-------------|
| 26 | 3248.51 | -16088.01 | -99284.46 | 30002.13 | 998.64 | -965.99 | -2589.26 |
| | 717.35 | -16088.00 | 12053.91 | -11535.56 | 998.64 | -965.99 | -2589.26 |
| 27 | 1232.43 | -16088.00 | 12053.91 | -11535.56 | 371.53 | 4133.40 | -2589.26 |
| | 1361.17 | 21741.15 | 12053.91 | -6107.57 | 371.53 | 4133.40 | -2589.26 |
| 28 | 118.93 | 21741.15 | 12053.91 | -6107.57 | 371.53 | 4133.40 | -2589.26 |
| | 71.28 | 3099.51 | 13729.49 | -6107.57 | 371.53 | 4133.40 | -2589.26 |
| 29 | 71.28 | 3099.51 | 13729.50 | -6107.57 | 371.53 | 4133.40 | -6038.26 |
| | 118.93 | 21741.15 | 12053.92 | -6107.57 | 371.53 | 4133.40 | -6038.26 |
| 30 | 1361.17 | 21741.15 | 12053.92 | -6107.57 | 371.53 | 4133.40 | -6038.26 |
| | 2996.15 | 54891.22 | 12053.92 | -4067.90 | 371.53 | 4133.40 | -6038.26 |
| 31 | 2996.15 | 54891.22 | 12053.92 | -4067.90 | 371.53 | 4133.40 | -6038.26 |
| | 1292.07 | -15376.65 | 18369.85 | -4067.90 | 371.53 | 4133.40 | -6038.26 |
| 32 | 1292.07 | -15376.65 | 18369.85 | -4067.90 | 371.53 | 4133.40 | -6038.26 |
| | 1910.55 | -30472.31 | 18369.85 | -4996.71 | 371.53 | 4133.40 | -6038.26 |

Also Available On Aperture Card

TI APERTURE CARD

8504040204-19

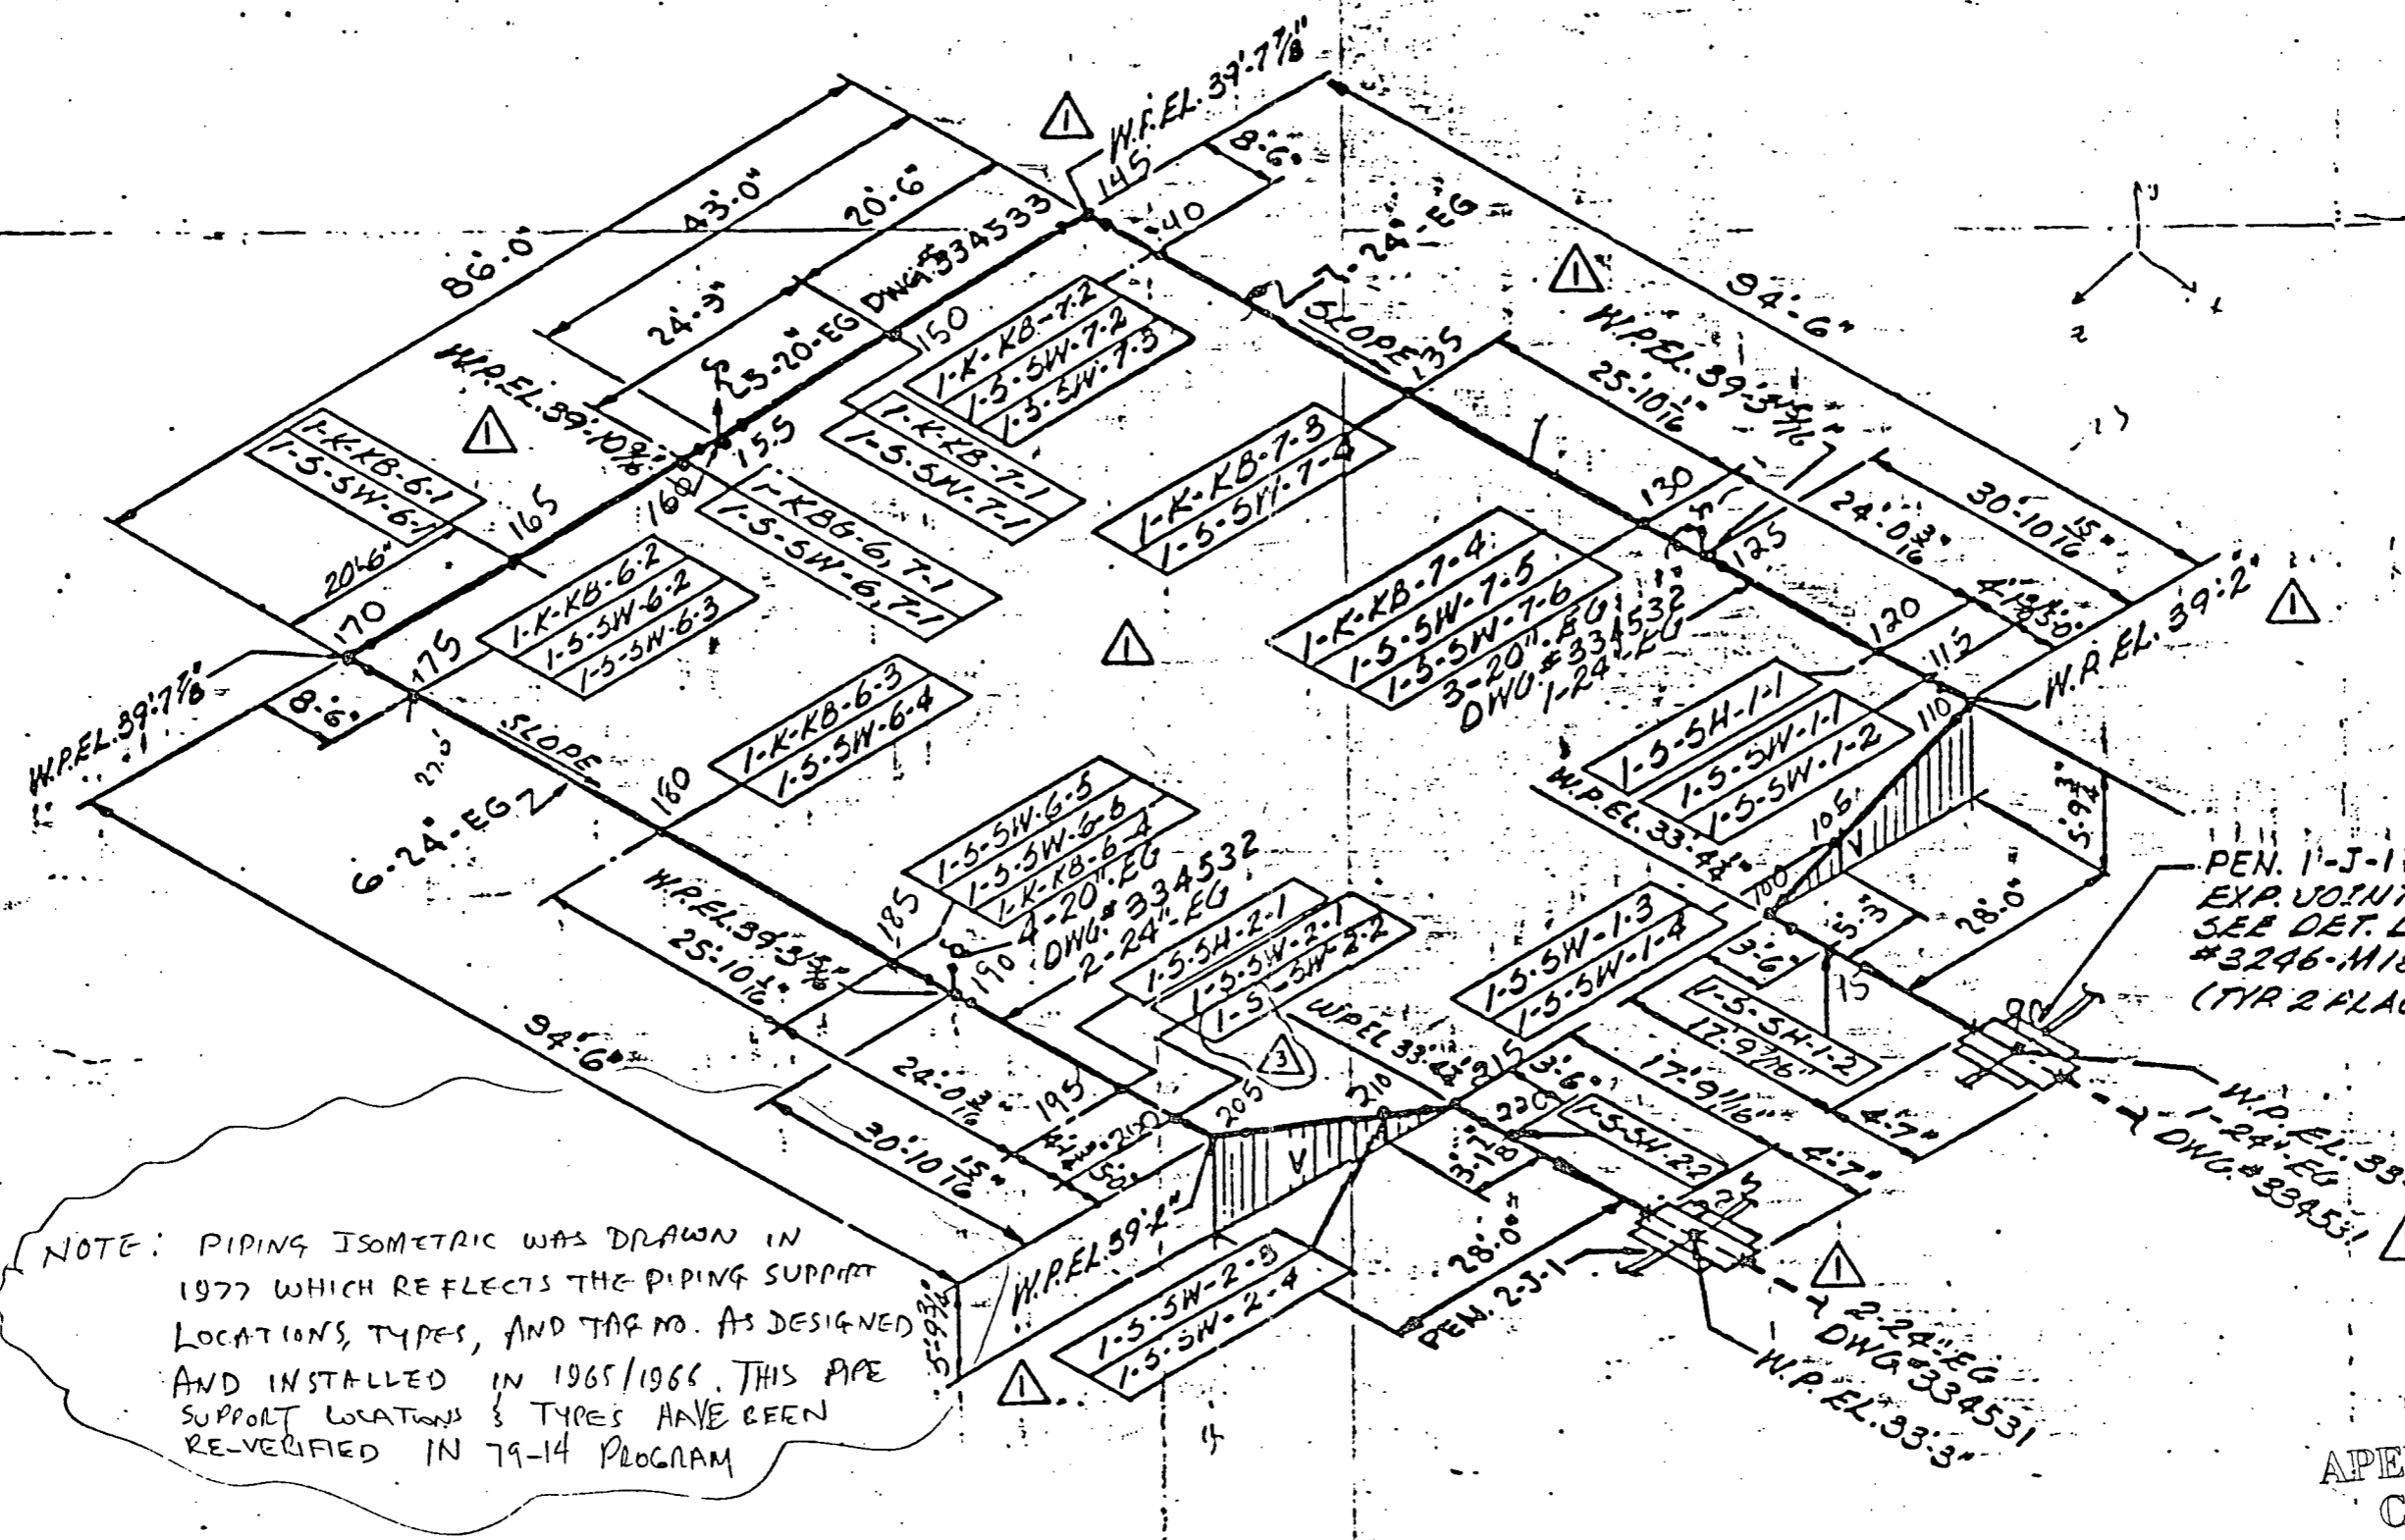

ORIGINATOR - A.E.
CHECKER - C.S.

NOTE: PIPING ISOMETRIC WAS DRAWN IN 1977 WHICH REFLECTS THE PIPING SUPPORT LOCATIONS, TYPES, AND TAG NO. AS DESIGNED AND INSTALLED IN 1965/1966. THIS PIPE SUPPORT LOCATIONS & TYPES HAVE BEEN RE-VERIFIED IN 79-14 PROGRAM

PEN. 1-J-1
EXP. JOINT
SEE DET. DWG #3246-M187678 - NOTES;
(TYR 2 PLACED) 1. FOR PIPE SUPP. DETAILS, SEE...
2. COMPLETE LI... UNABLE TO Y...
3. WESTINGHOUSE

| | | |
|---|-----|---------|
| 3 | yes | 11/5/71 |
| 2 | no | 11/5/71 |
| 1 | no | 11/5/71 |
| 0 | no | 11/5/71 |



TI APERTURE CARD

Also Available On Aperture Card

CLASS 2 P SAFETY R

CERTIFIED AS BUILT

BOP-SEISMIC RE ANALYSIS BOUND

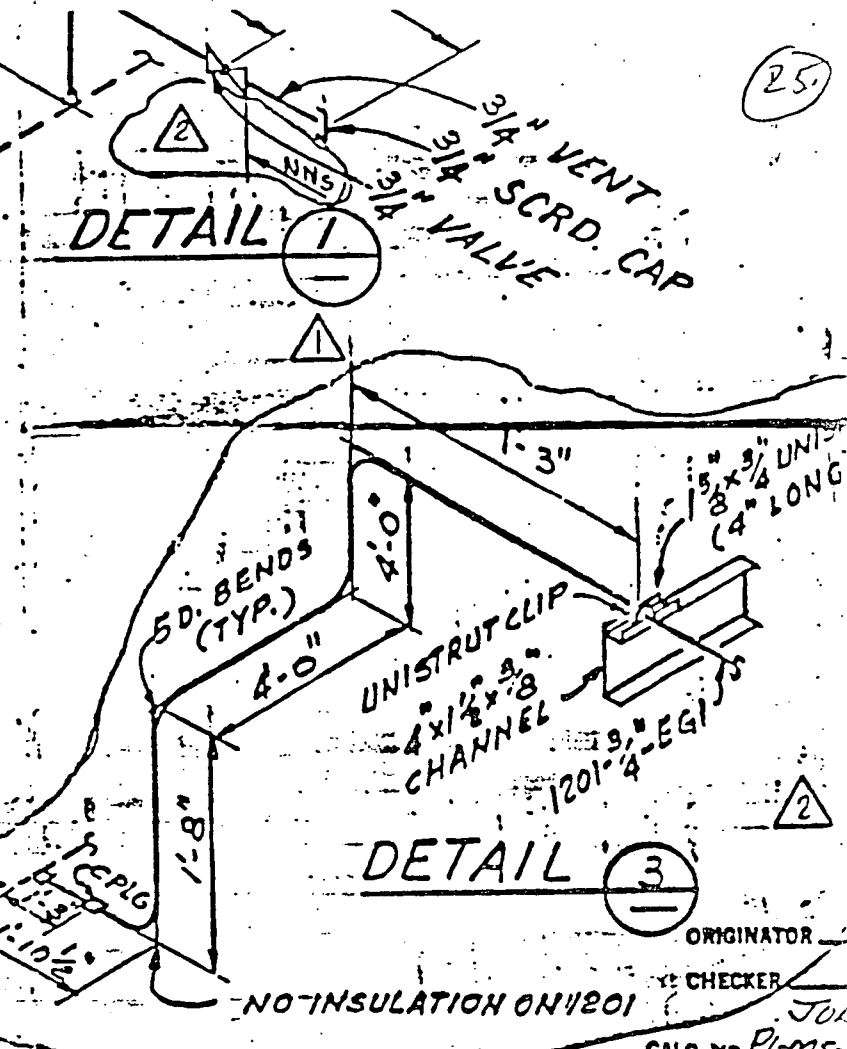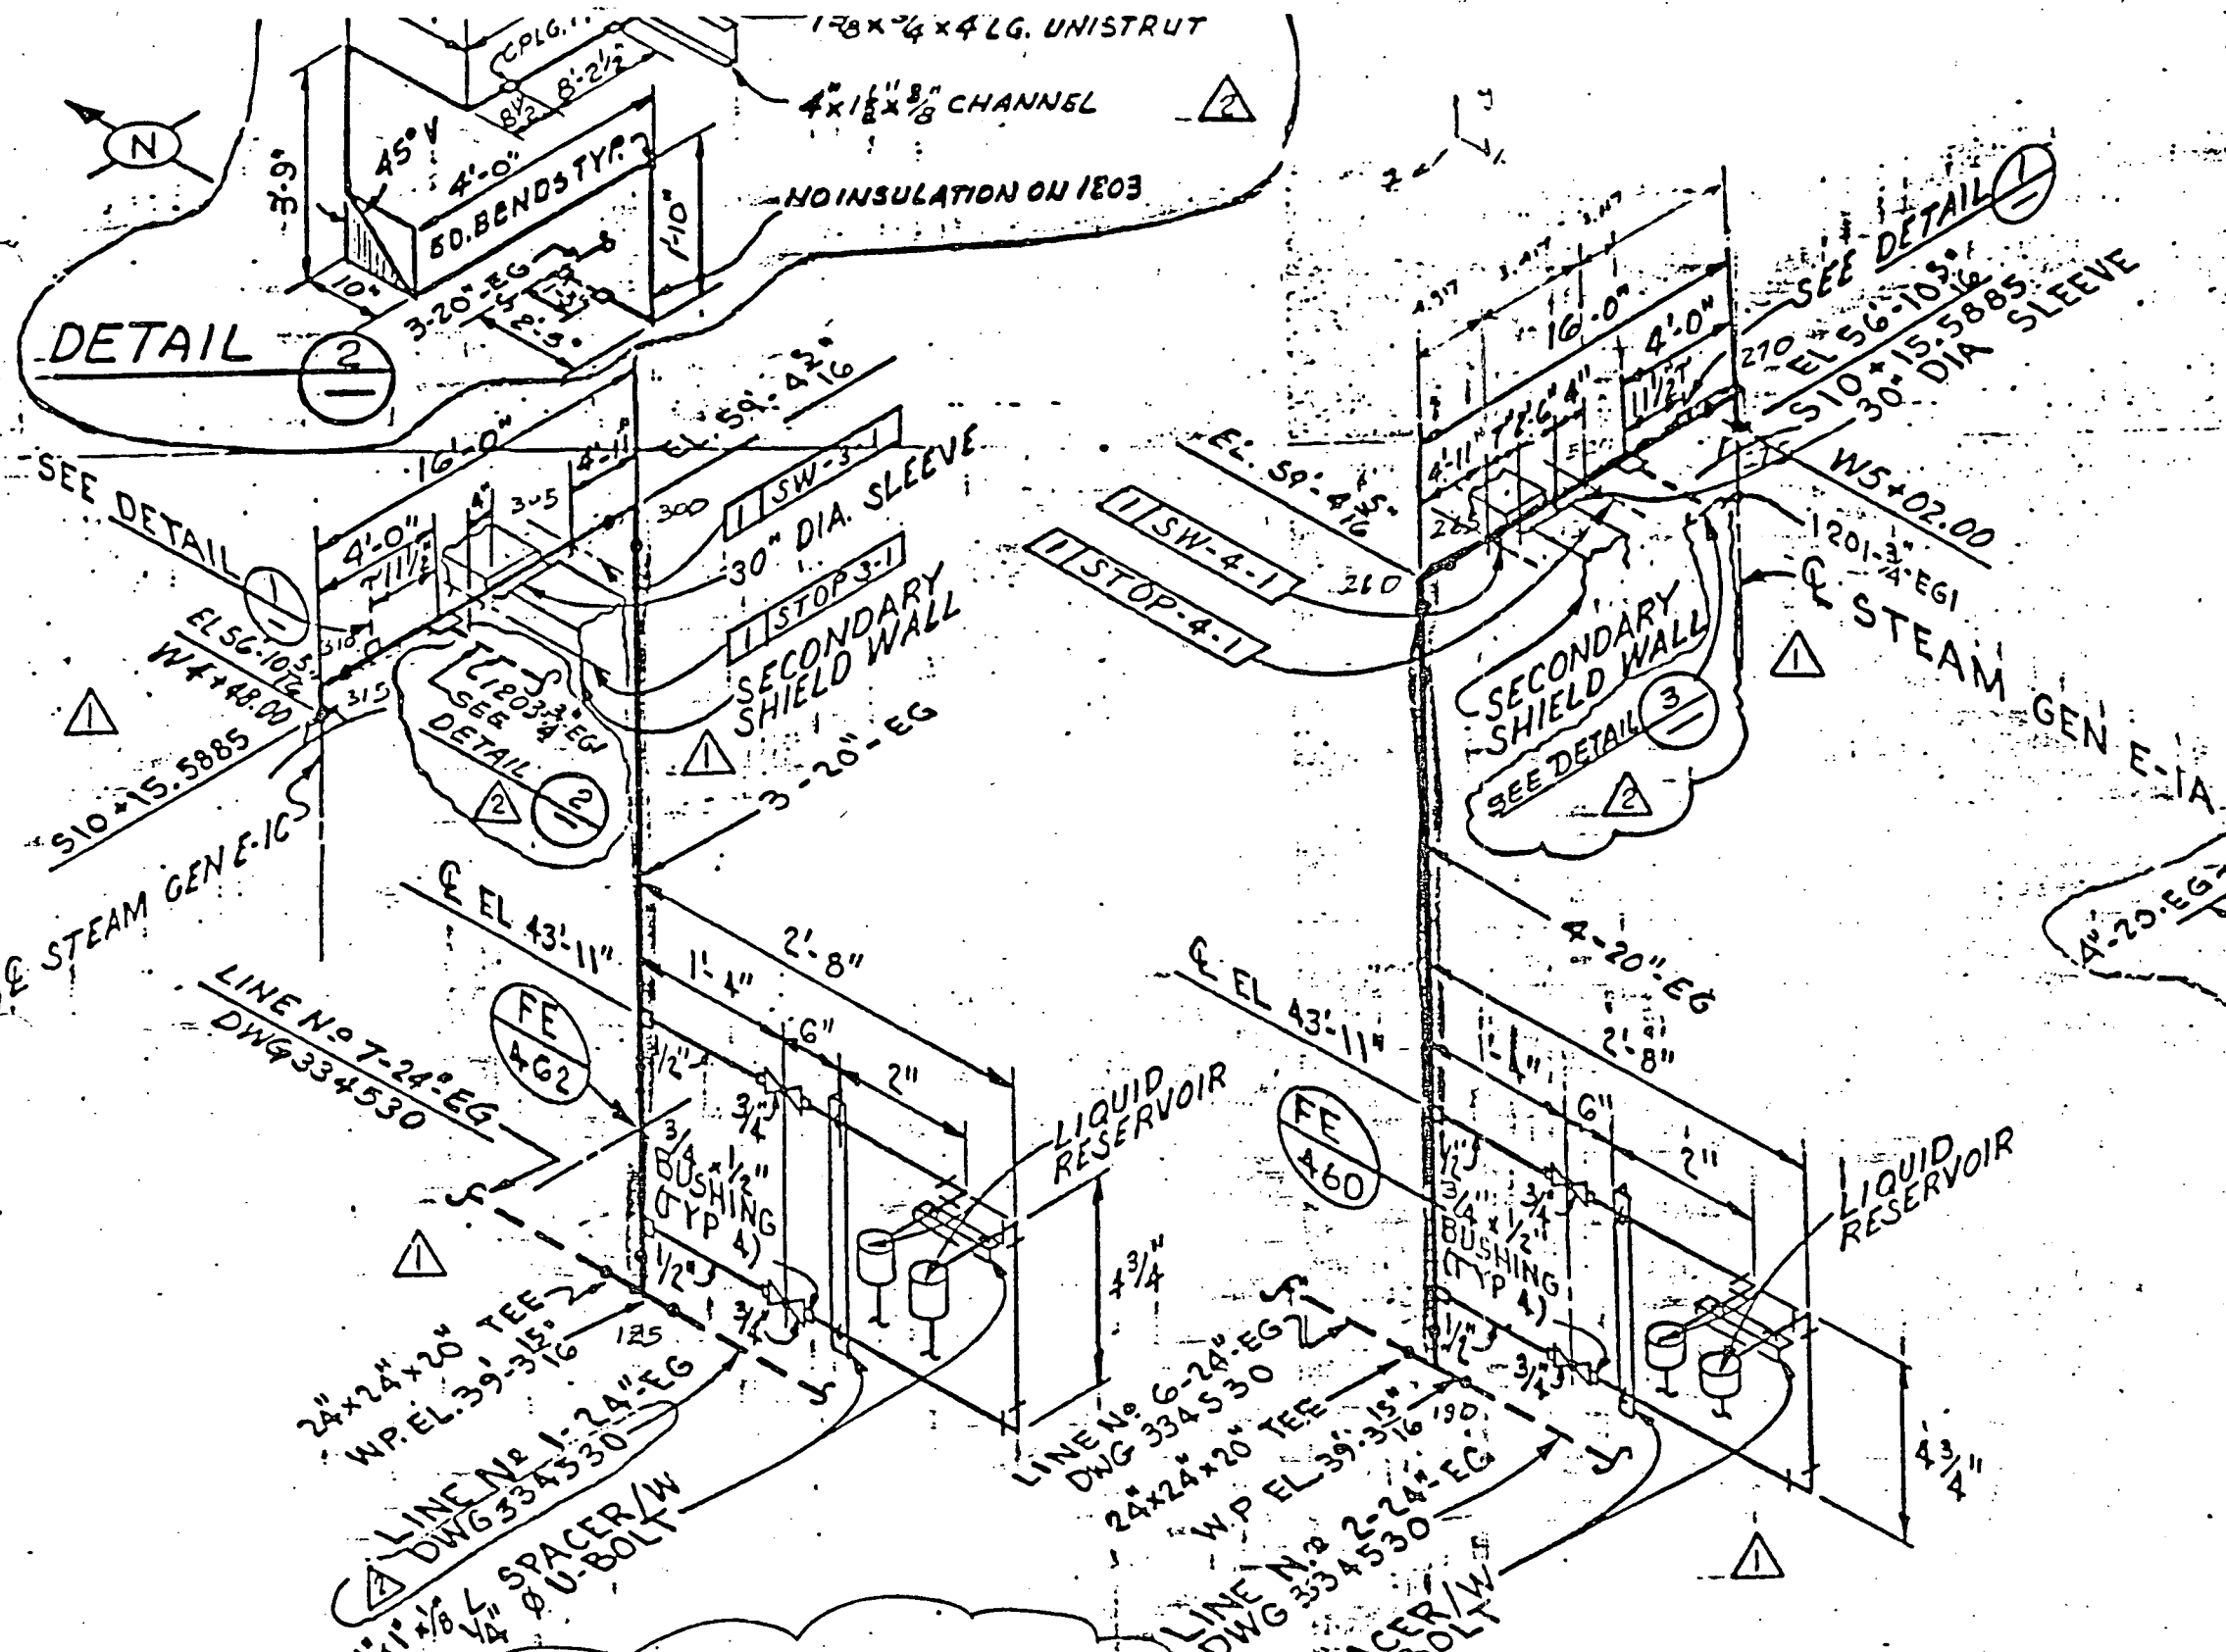

25

ORIGINATOR
 CHECKER
 CALC. NO. P-1-MS
 SHEET 31

- NOTES
1. LINE INSULATED, UNABLE TO VERIFY FITTINGS
 2. FOR PIPE SUPPORT AND HANG DETAILS SEE M-31736
 3. WESTINGHOUSE SCOPE OF ANALYSIS

Also Available On Aperture Card

TI APERTURE CARD
 CLASS 2-PIPING
 SAFETY RELATED

MICRO-PRINT
 BEST AVAILABLE
 ORIGINAL




NOTE: THIS PIPING ISOMETRIC WAS DRAWN IN 1977 WHICH REFLECTS THE PIPING SUPPORT LOCATIONS, TYPES, AND TAG NO AS DESIGNED AND INSTALLED IN 1965/1966. THIS PIPE SUPPORT LOCATIONS & TYPES HAVE BEEN REVERIFIED IN 79-14 PROGRAM.

| | | |
|---|-----|---------|
| 1 | REV | 2/14/78 |
| 0 | REV | 7/1/77 |

CERTIFIED AS BUILT

8504040294-21

UNIT 1

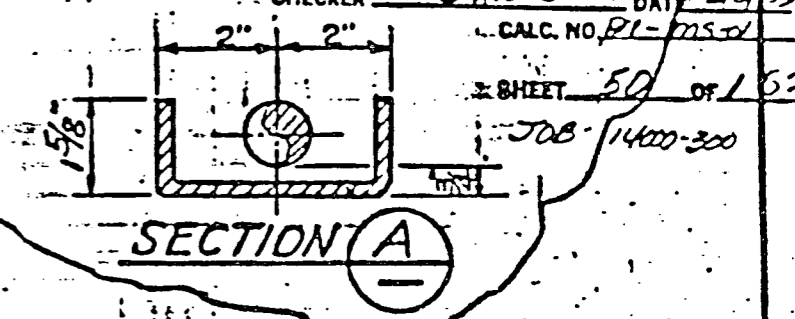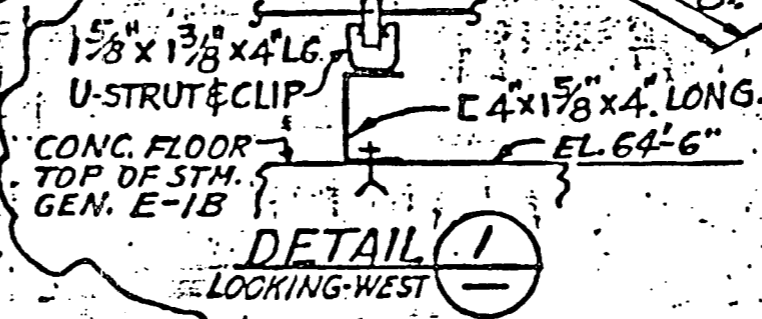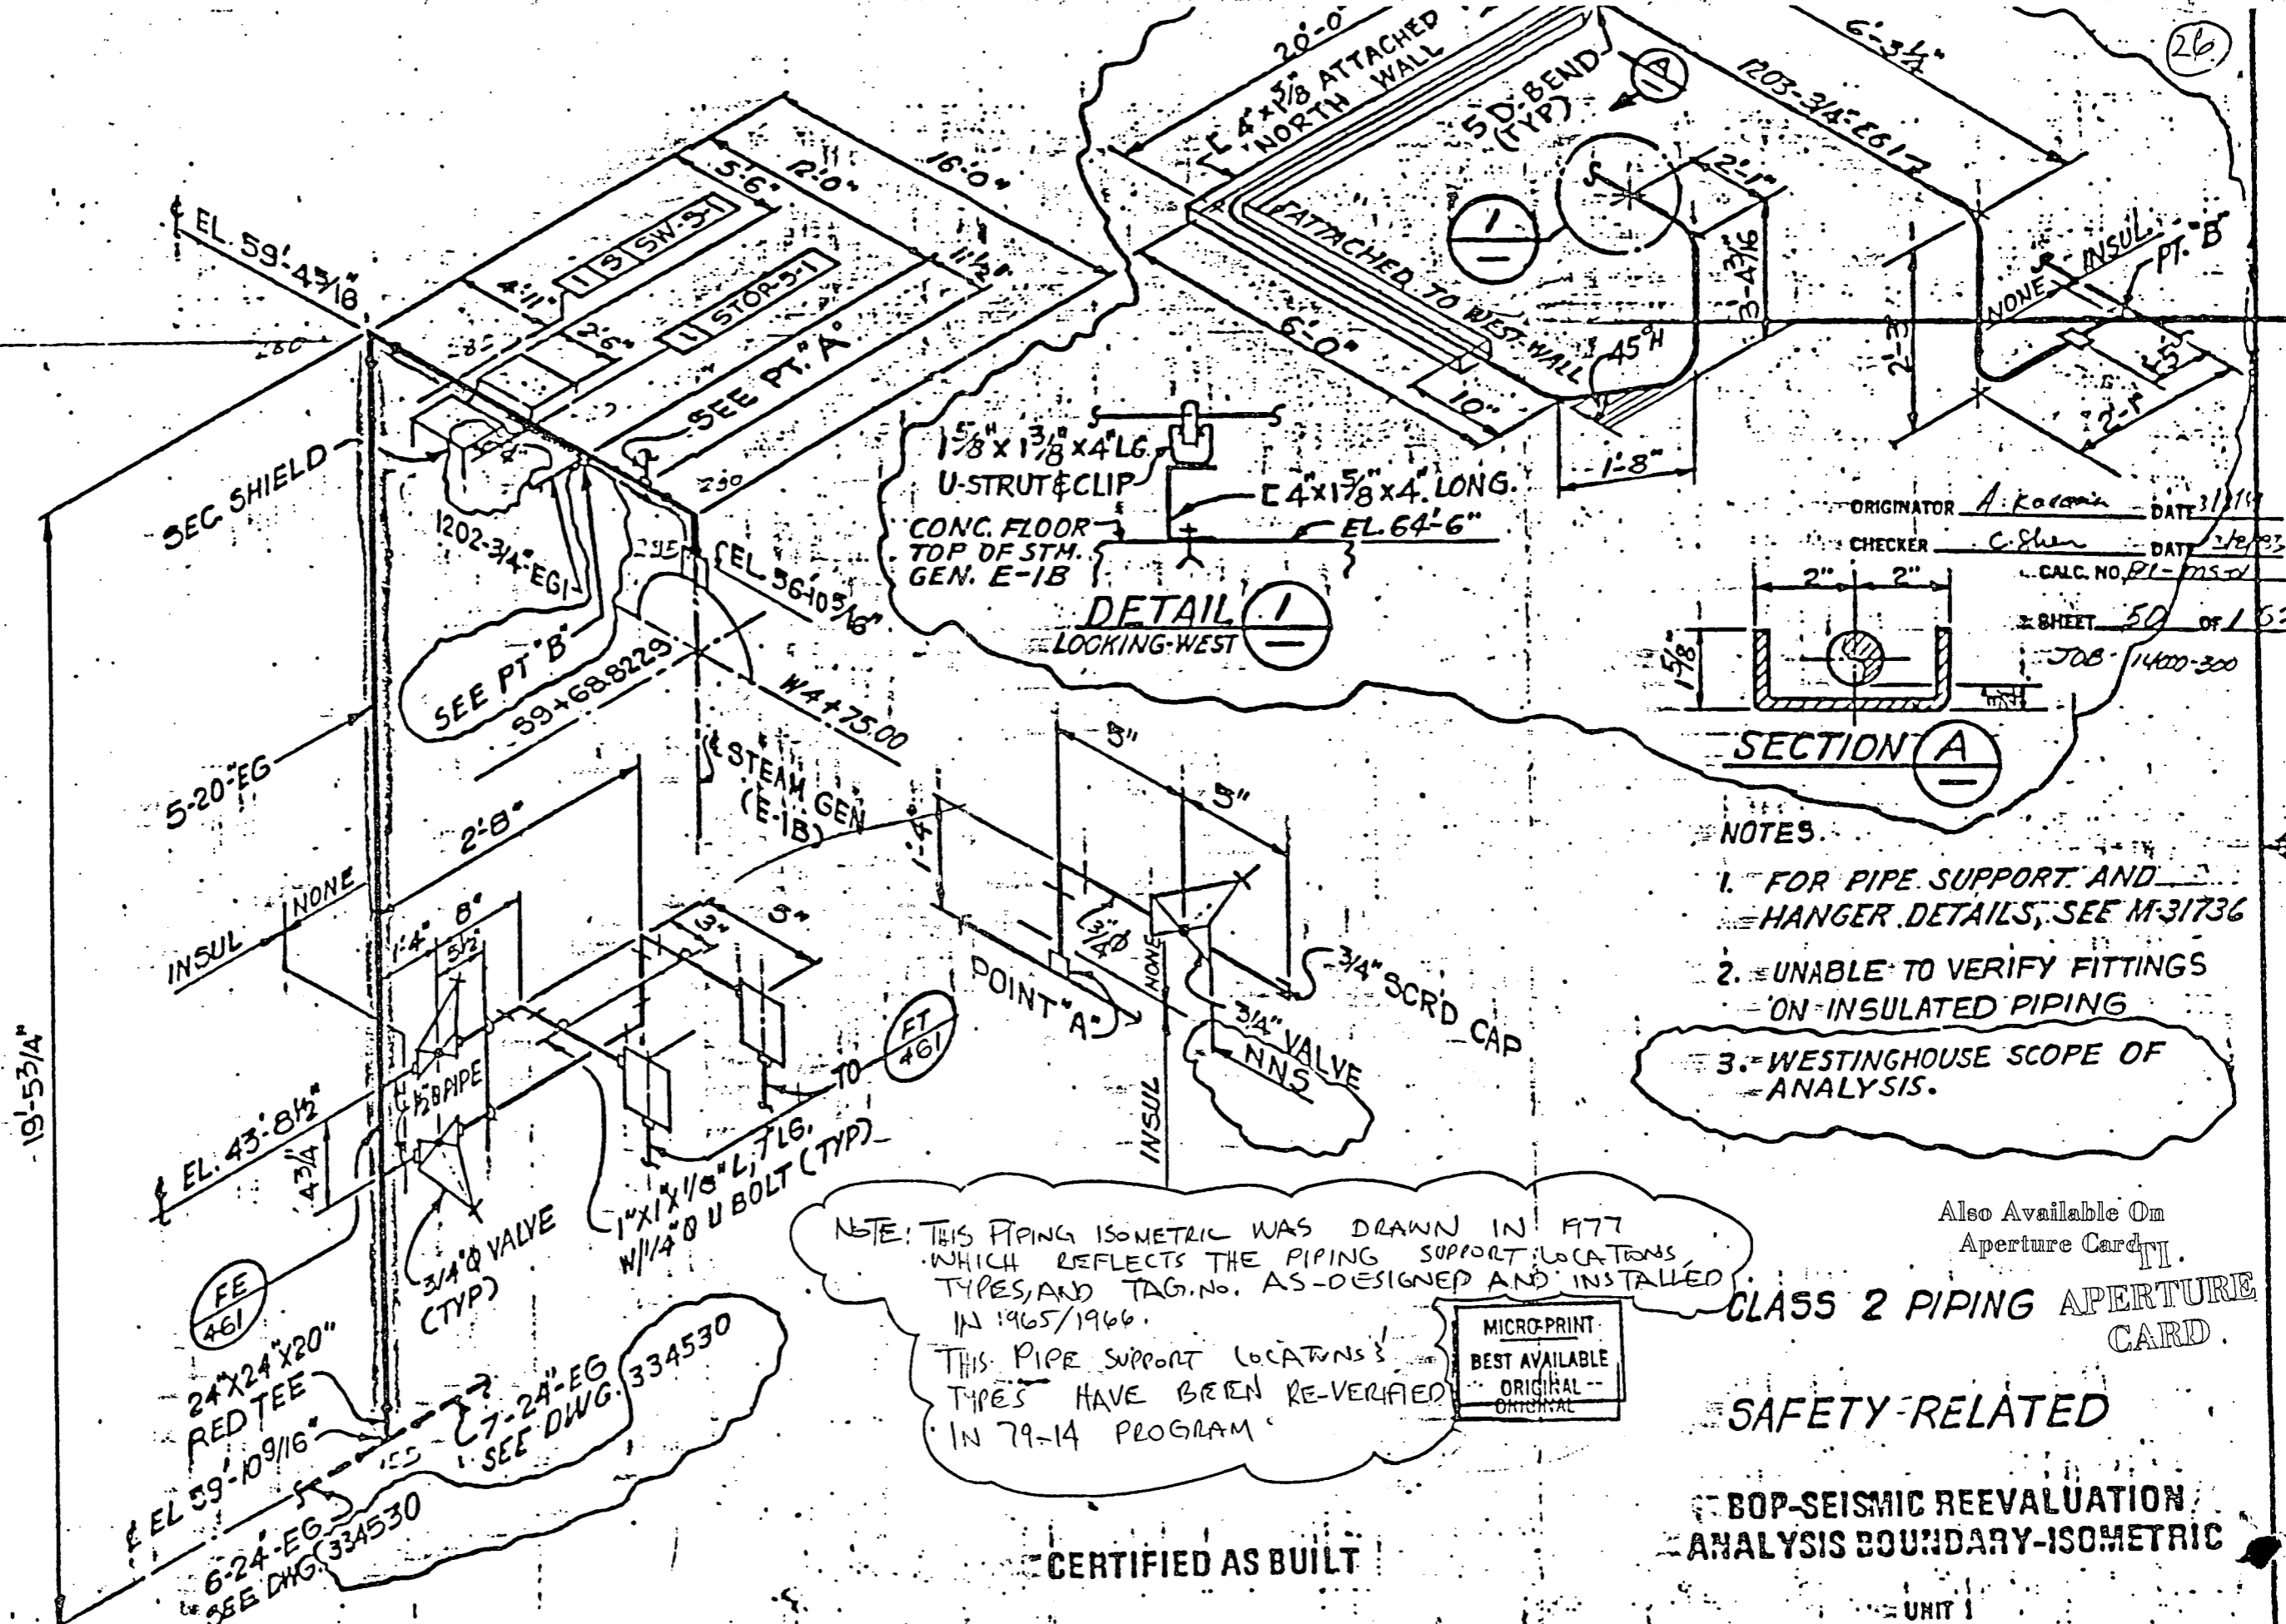

- NOTES:
1. FOR PIPE SUPPORT AND HANGER DETAILS, SEE M-31736
 2. UNABLE TO VERIFY FITTINGS ON INSULATED PIPING
 3. WESTINGHOUSE SCOPE OF ANALYSIS.

NOTE: THIS PIPING ISOMETRIC WAS DRAWN IN 1977 WHICH REFLECTS THE PIPING SUPPORT LOCATIONS, TYPES, AND TAG NO. AS DESIGNED AND INSTALLED IN 1965/1966.
 THIS PIPE SUPPORT LOCATIONS TYPES HAVE BEEN RE-VERIFIED IN 79-14 PROGRAM

MICRO-PRINT
 BEST AVAILABLE ORIGINAL

CLASS 2 PIPING APERTURE CARD

SAFETY-RELATED

BOP-SEISMIC REEVALUATION ANALYSIS BOUNDARY-ISOMETRIC


CERTIFIED AS BUILT

UNIT I

ORIGINATOR A. Kocana DATE 3/1/69
 CHECKER C. Shen DATE 2/2/83
 SHEET 50 OF 162
 JOB 1400-300

| | |
|------|---------|
| | 0/0/0 |
| | 3/23/78 |
| | 9/1/77 |
| DATE | |

PIPING FLEXIBILITY CALCULATION
 BECHTEL CORPORATION
 4550 SEVILLE AVENUE
 VERNON, CALIFORNIA

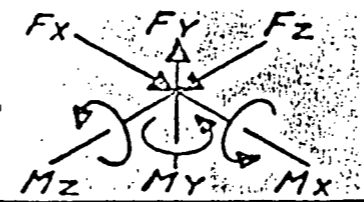

$S_c =$ _____
 $S_h =$ _____
 $S_A = 1.25 S_c + 2.5 S_h$
 $S_A =$ _____

MAXIMUM STRESS

 AT POINT

PAGE ___ OF ___

SIGNATURE _____ DATE _____
 PROJECT _____ JOB NO. _____
 SUBJECT MAIN STEAM - SEISMIC ANALYSIS

CONVENTION FOR POSITIVE FORCES & MOMENTS

DESIGN DATA

PRESS. _____
 TEMP. _____


MAT'L. _____
 EXP. COEF. _____
 $E_c \times 10^6$ _____

MEMBER DATA $\alpha = 387.8$

| | | | | | | |
|-----|-------|-----|------|------|-------|----|
| 2-1 | 10-1 | 960 | 10-1 | 5-45 | 70-75 | 65 |
| 122 | 25-21 | 36 | 275 | 7 | 11 | |
| 60 | | | | | | |
| 25 | 75 | 25 | 25 | 25 | 25 | 25 |

ANCHOR DATA

| ANCHOR | | COORDINATES | | | END DEFLECTION | | |
|--------|-----|-------------|--------|---------|----------------|------------|------------|
| No. | Pt. | X | Y | Z | ΔX | ΔY | ΔZ |
| 1 | 5 | 0 | 0 | 0 | 0 | 0 | 0 |
| 2 | 65 | -25 | -17 | -29.17 | | | |
| 3 | 200 | -25 | -77.25 | -113.55 | 0 | 0 | 0 |
| | | | | | | | |
| | | | | | | | |
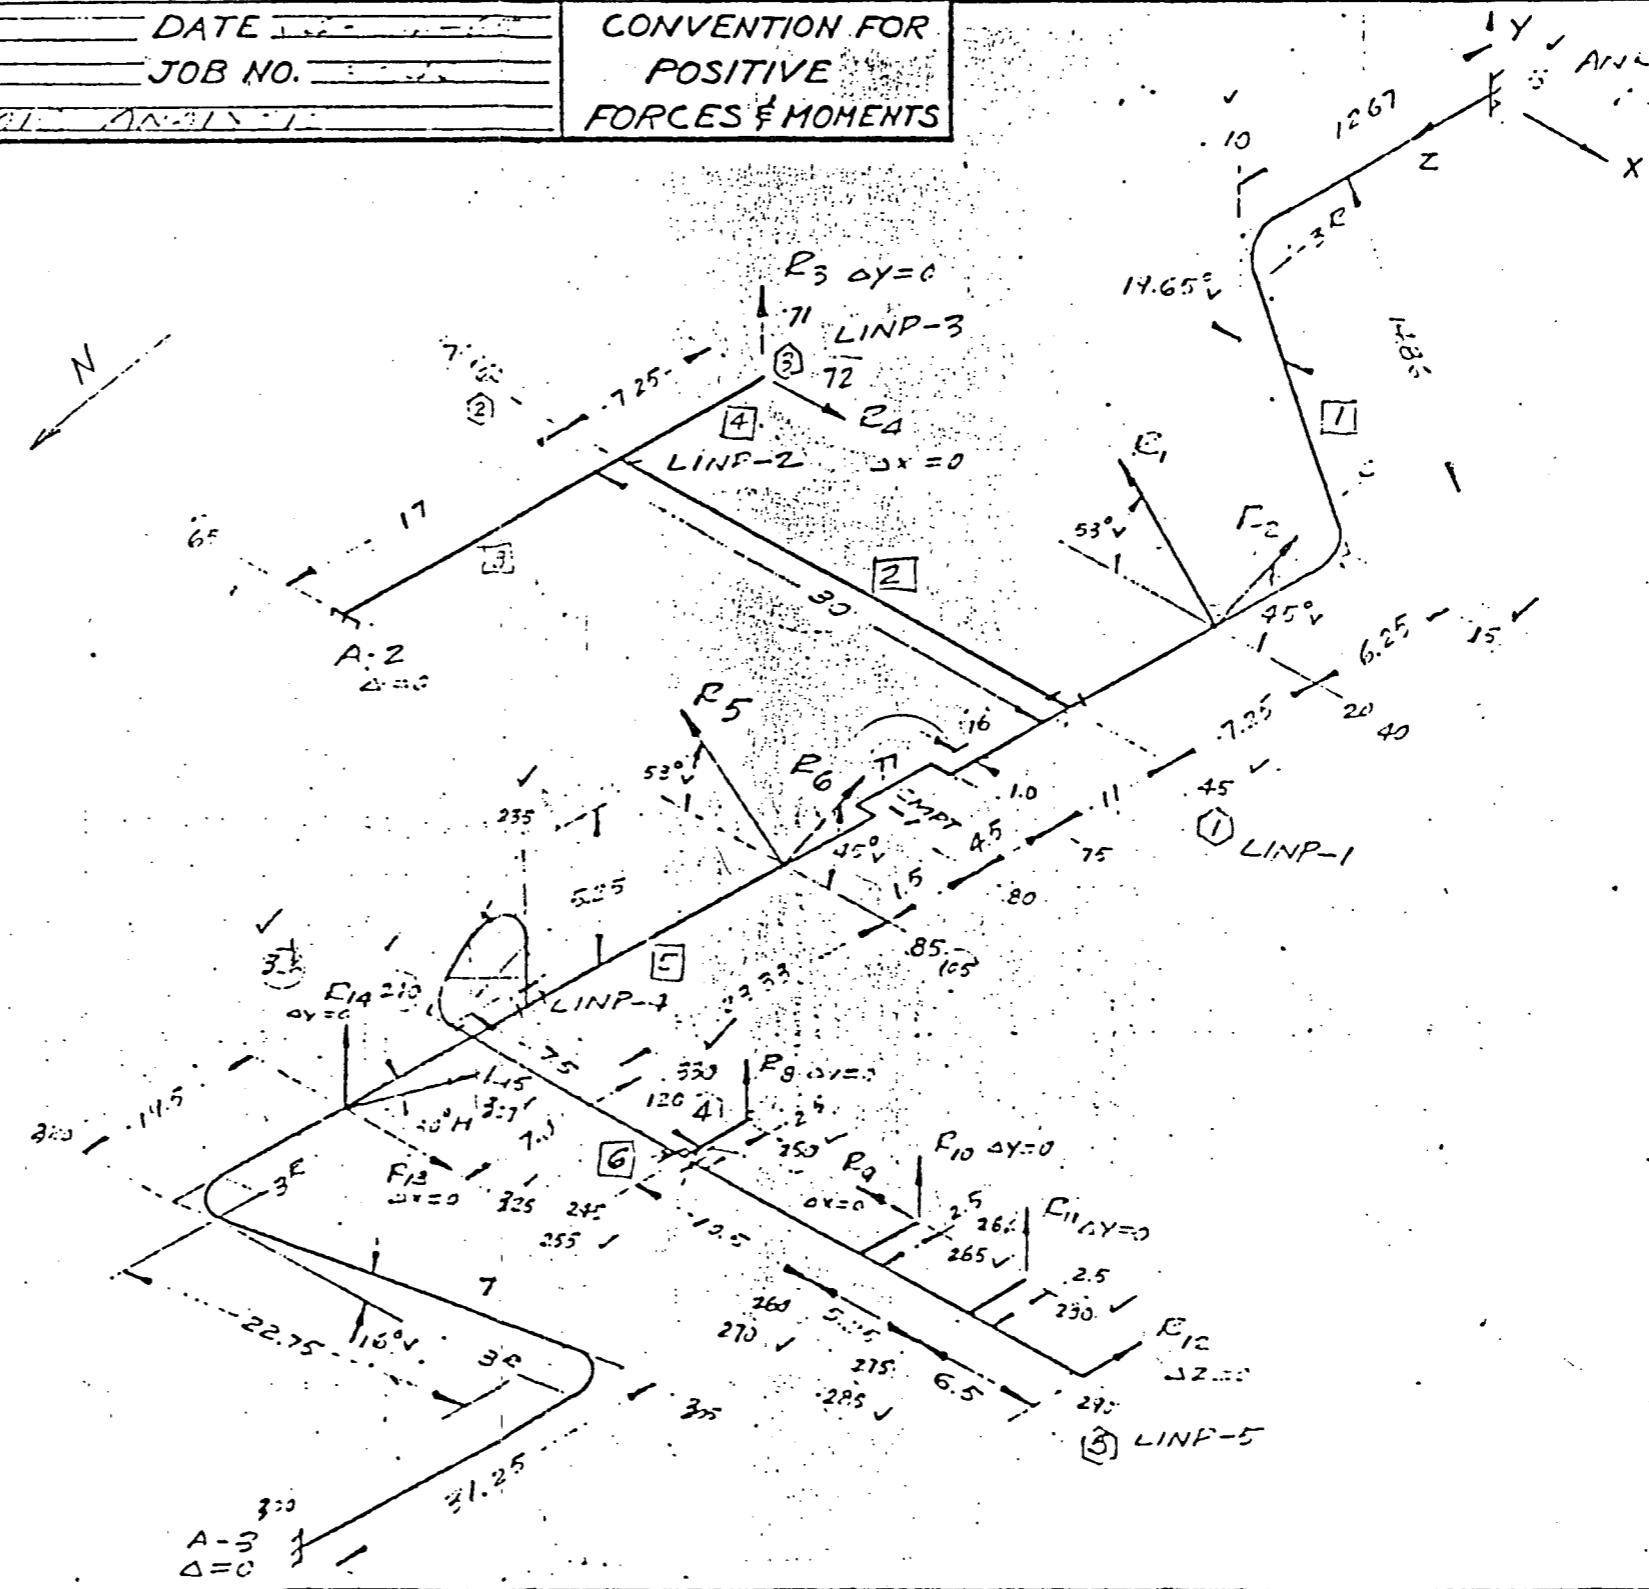

Also Available On Aperture Card

TI APERTURE CARD

SEISMIC

2513 BEGIN PROBLEM C10

*****THE INITIAL LOAD SPECIFIED FOR THE RIGID RESTRAINT AT DATA POINT 20 HAS BEEN RESET TO ZERO.
TO INCLUDE AN INITIAL LOAD, SPECIFY A FLEXIBLE RESTRAINT.

*****THE INITIAL LOAD SPECIFIED FOR THE RIGID RESTRAINT AT DATA POINT 40 HAS BEEN RESET TO ZERO.
TO INCLUDE AN INITIAL LOAD, SPECIFY A FLEXIBLE RESTRAINT.

*****THE INITIAL LOAD SPECIFIED FOR THE RIGID RESTRAINT AT DATA POINT 71 HAS BEEN RESET TO ZERO.
TO INCLUDE AN INITIAL LOAD, SPECIFY A FLEXIBLE RESTRAINT.

*****THE INITIAL LOAD SPECIFIED FOR THE RIGID RESTRAINT AT DATA POINT 72 HAS BEEN RESET TO ZERO.
TO INCLUDE AN INITIAL LOAD, SPECIFY A FLEXIBLE RESTRAINT.

*****THE INITIAL LOAD SPECIFIED FOR THE RIGID RESTRAINT AT DATA POINT 85 HAS BEEN RESET TO ZERO.
TO INCLUDE AN INITIAL LOAD, SPECIFY A FLEXIBLE RESTRAINT.

*****THE INITIAL LOAD SPECIFIED FOR THE RIGID RESTRAINT AT DATA POINT 105 HAS BEEN RESET TO ZERO.
TO INCLUDE AN INITIAL LOAD, SPECIFY A FLEXIBLE RESTRAINT.

*****THE INITIAL LOAD SPECIFIED FOR THE RIGID RESTRAINT AT DATA POINT 250 HAS BEEN RESET TO ZERO.
TO INCLUDE AN INITIAL LOAD, SPECIFY A FLEXIBLE RESTRAINT.

*****THE INITIAL LOAD SPECIFIED FOR THE RIGID RESTRAINT AT DATA POINT 265 HAS BEEN RESET TO ZERO.
TO INCLUDE AN INITIAL LOAD, SPECIFY A FLEXIBLE RESTRAINT.

*****THE INITIAL LOAD SPECIFIED FOR THE RIGID RESTRAINT AT DATA POINT 266 HAS BEEN RESET TO ZERO.
TO INCLUDE AN INITIAL LOAD, SPECIFY A FLEXIBLE RESTRAINT.

*****THE INITIAL LOAD SPECIFIED FOR THE RIGID RESTRAINT AT DATA POINT 280 HAS BEEN RESET TO ZERO.
TO INCLUDE AN INITIAL LOAD, SPECIFY A FLEXIBLE RESTRAINT.

*****THE INITIAL LOAD SPECIFIED FOR THE RIGID RESTRAINT AT DATA POINT 290 HAS BEEN RESET TO ZERO.
TO INCLUDE AN INITIAL LOAD, SPECIFY A FLEXIBLE RESTRAINT.

*****THE INITIAL LOAD SPECIFIED FOR THE RIGID RESTRAINT AT DATA POINT 325 HAS BEEN RESET TO ZERO.
TO INCLUDE AN INITIAL LOAD, SPECIFY A FLEXIBLE RESTRAINT.

*****THE INITIAL LOAD SPECIFIED FOR THE RIGID RESTRAINT AT DATA POINT 326 HAS BEEN RESET TO ZERO.
TO INCLUDE AN INITIAL LOAD, SPECIFY A FLEXIBLE RESTRAINT.

*****THE INITIAL LOAD SPECIFIED FOR THE RIGID RESTRAINT AT DATA POINT 327 HAS BEEN RESET TO ZERO.
TO INCLUDE AN INITIAL LOAD, SPECIFY A FLEXIBLE RESTRAINT.

CONTROL ENTERED BLKF08.
CONTROL ENTERED BLKF08.
CONTROL ENTERED BLKF08.
CONTROL ENTERED BLKF08.
CONTROL ENTERED BLKF08.
CONTROL ENTERED BLKF12.

Also Available On
Aperture Card

T1
APERTURE
CARD

RLN NO. C

PIPING FLEXIBILITY ANALYSIS PROGRAM MEC-21/7094
** WEIGHT LOADING EFFECTS **

MAIN STEAM SPHERE TO TURBINE X-ACC 1.0G 4/24/65 PROBLEM NO. 010
PROJECT NO. 3246 DATE 00010'U00
GROUP 0000 TIME 2513 HRS.

SUMMATION OF THE REACTIONS ON THE STRUCTURE

| FX, LBS. | FY, LBS. | FZ, LBS. | MX, FT.-LBS. | MY, FT.-LBS. | MZ, FT.-LBS. |
|----------|----------|----------|--------------|--------------|--------------|
| -58723. | 38. | -32. | -2342. | -2591254. | -666151. |

SUMMATION OF THE WEIGHT AND UNIFORM LOADING EFFECTS

| FX, LBS. | FY, LBS. | FZ, LBS. | MX, FT.-LBS. | MY, FT.-LBS. | MZ, FT.-LBS. |
|----------|----------|----------|--------------|--------------|--------------|
| -58990. | 0. | 0. | 0. | -2608930. | -668977. |

CENTER-OF-FORCES COORDINATES

CENTER-OF-GRAVITY COORDINATES

| X, FT. | Y, FT. | Z, FT. |
|--------|--------|--------|
| 0. | -11.3 | 44.2 |

| X, FT. | Y, FT. | Z, FT. |
|--------|--------|--------|
| 0. | -0. | 44.2 |

SUMMATION OF THE REACTIONS AT THE BRANCH-INTERSECTION-POINTS

| BINP NC. | FX, LBS. | FY, LBS. | FZ, LBS. | MX, FT.-LBS. | MY, FT.-LBS. | MZ, FT.-LBS. |
|----------|----------|----------|----------|--------------|--------------|--------------|
| LINP 1 | 2. | 0. | 18. | -1. | 1. | -0. |
| LINP 2 | 0. | 0. | 0. | 0. | -0. | -0. |
| LINP 3 | -0. | -0. | -0. | 0. | -0. | -0. |
| LINP 4 | 265. | 38. | -51. | -290. | -135. | -1093. |
| LINP 5 | 0. | -0. | 0. | 0. | 0. | 0. |

Also Available On Aperture Card

TI APERTURE CARD

CATE 000)C'UCO TIME 2513 HRS.

MAIN STEAM SPHERE TO TURBINE X-ACC 1.0G 4/24/65

PROBLEM NO. 010

TYPE ONE CARDS

CNOARTTCTGBRFR DATA PT COORDINATES DIAM THCK RAD SPECIAL COORDINATES P DIAGNOSTIC NOTES

| | XFT / | YFT / | ZFT / | V / | VV / | VFT / | VXFT / | YFT / | ZFT / | VV | DIAGNOSTIC NOTES |
|----|-------|-------|-------|-----|------|-------|--------|-------|-------|----|-------------------|
| 51 | | | | | | | | | | | ZERO COORDINATES. |
| 10 | 1 | | | | | | | | | | |
| 15 | 1 | | | | | | | | | | |
| 20 | 2 | 1 | | | | | | | | | |
| 40 | 2 | 1 | | | | | | | | | |
| 45 | 1 | | | | | | | | | | |
| 60 | 1 | | | | | | | | | | |
| 65 | | 0203 | | | | | | | | | |
| 70 | 1 | | | | | | | | | | |
| 71 | 2 | 1 | | | | | | | | | |
| 72 | 2 | 1 | | | | | | | | | |
| 75 | 1 | | | | | | | | | | |
| 76 | 1 | | | | | | | | | | |
| 77 | 3 | | | | | | | | | | |

TYPE TWO CARDS

CNO CMPT DATA OR ANCHOR, RESTRAINT FLEX C CG-R STR LOC-A COS CR

| | E / | E / | E / | E / | E / | E / | EX / / | Y / / | Z / / | VV |
|----|-----|-----|-----|-----|-----|-----|--------|-------|-------|----|
| 5 | | | | | | | | | | |
| 10 | | | | | | | | | | |
| 15 | | | | | | | | | | |
| 20 | | | | | | | | | | |
| 40 | | | | | | | | | | |
| 45 | | | | | | | | | | |
| 60 | | | | | | | | | | |
| 65 | | | | | | | | | | |
| 70 | | | | | | | | | | |
| 71 | | | | | | | | | | |
| 72 | | | | | | | | | | |
| 75 | | | | | | | | | | |
| 76 | | | | | | | | | | |
| 77 | | | | | | | | | | |

TYPE THREE CARDS

CNOEXPAN E MU LOAD RHO PSI ULOAD F COS, ANK DELTA ANK ROT, RSNT MOVE

| | V / | VV / | VV / | VV / | V / | VX / | Y / | Z / | X / / | Y / / | Z / / |
|----|------|------|------|------|-----|------|-----|-----|-------|-------|-------|
| 5 | | | | | | | | | | | |
| 10 | 2793 | | | | | | | | | | |
| 15 | 2793 | | | | | | | | | | |
| 20 | 2793 | | | | | | | | | | |
| 40 | | | | | | | | | | | |
| 45 | 2793 | | | | | | | | | | |
| 60 | 2793 | | | | | | | | | | |
| 65 | | | | | | | | | | | |
| 70 | 2793 | | | | | | | | | | |
| 71 | 2793 | | | | | | | | | | |
| 72 | | | | | | | | | | | |
| 75 | 2793 | | | | | | | | | | |
| 76 | 2793 | | | | | | | | | | |
| 77 | 2793 | | | | | | | | | | |

Also Available On Aperture Card

TI APERTURE CARD

RLN NO. 0

PIPING FLEXIBILITY ANALYSIS PROGRAM MEC-21/7094
** DATA CARD DISPLAY WITH DIAGNOSTIC NOTES **

PAGE 3 OF 10

DATE 00010'U00 TIME 2513 HRS.

MAIN STEAM SPHERE TO TURBINE X-ACC 1.0G 4/24/65

PROBLEM NO. 010

TYPE ONE CARDS

| CNO | ART | TCT | GRFR | DATA | PT | COORDINATES | DIAM | THCK | RAD | SPECIAL | COORDINATES | P | DIAGNOSTIC | NOTES |
|-----|-----|-----|--------|---------|---------|-------------|------|---------|-----|---------|-------------|---|------------|-------|
| | | | | | | | | | | | | | | |
| | | | | | | | | | | | | | | |
| 80 | 1 | | | +005000 | -C14000 | +041670 | 3000 | 009 | | | | | | |
| 85 | 2 | 1 | | +005000 | -C14000 | +043170 | 2400 | 00968 | | | | | | |
| 105 | 2 | 1 | | | | | | | | | | | | |
| 120 | 1 | | | +005000 | -C14000 | +066500 | 2400 | 00968 | | | | | | |
| 235 | 1 | | 050604 | +005000 | -C08750 | +066500 | 2400 | 0096803 | | | | | | |
| 240 | 1 | | | +008516 | -C08750 | +070016 | 2400 | 0096803 | | | | | | |
| 245 | 1 | | | +016016 | -C08750 | +070016 | 2400 | 00968 | | | | | | |
| 250 | 1 | 1 | | +016016 | -C08750 | +067516 | 3000 | 009000 | | | | | | |
| 255 | 1 | | | +016016 | -C08750 | +070016 | 3000 | 009000 | | | | | | |
| 260 | 1 | | | +026516 | -C08750 | +070016 | 2400 | 00968 | | | | | | |
| 265 | 2 | 1 | | +026516 | -C08750 | +067516 | 3000 | 009 | | | | | | |
| 266 | 2 | 1 | | | | | | | | | | | | |
| 270 | 1 | | | +026516 | -C08750 | +070016 | 3000 | 009 | | | | | | |
| 275 | 1 | | | +031766 | -C08750 | +070016 | 2400 | 00968 | | | | | | |

TYPE TWO CARDS

| CNO | CMPT | DATA | OR | ANCHOR | RESTRAINT | FLEX | C | CG-R | STR | LOC-A | COS | CR |
|-----|------|------|----|--------|-----------|------|---|------|-----|-------|-----|----|
| | | | | | | | | | | | | |
| | | | | | | | | | | | | |
| 80 | | | | | | | | | | | | |
| 85 | | | | | | | | | | | | |
TYPE THREE CARDS

| CNO | EXPAN | E | MU | LOAD | RHO | PSI | ULOAD | F | COS | ANK | DELTA | ANK | ROT | RSNT | MOVE |
|-----|-------|---|----|------|-----|-----|-------|---|-----|-----|-------|-----|-----|------|------|
| | | | | | | | | | | | | | | | |
| | | | | | | | | | | | | | | | |
| 80 | | | | 2793 | | | | | | | | | | | |
| 85 | | | | 2793 | | | | | | | | | | | |
| 105 | | | | | | | | | | | | | | | |
| 120 | | | | 2793 | | | | | | | | | | | |
| 235 | | | | 2793 | | | | | | | | | | | |
| 240 | | | | 2793 | | | | | | | | | | | |
| 245 | | | | 2793 | | | | | | | | | | | |
| 250 | | | | 2793 | | | | | | | | | | | |
| 255 | | | | 2793 | | | | | | | | | | | |
| 260 | | | | 2793 | | | | | | | | | | | |
| 265 | | | | 2793 | | | | | | | | | | | |
| 266 | | | | | | | | | | | | | | | |
| 270 | | | | 2793 | | | | | | | | | | | |
| 275 | | | | 2793 | | | | | | | | | | | |

21202-1 21.2# / IN

21202-1 -X DIRECTION

21202-1

21202-1

21202-1

21202-1

53002-1

53002-1

53002-1

TI
APERTURE
CARD

Also Available On
Aperture Card

8504040294-27

DATE 00010UCO TIME 2513 HRS.

MAIN STEAM SPHERE TO TURBINE X-ACC 1.0G 4/24/65

PROBLEM NO. 010

TYPE ONE CARDS

| CNCARTTCTOBRFR | DATA | PT | COORDINATES | DIAM | THCK | RAO | SPECIAL | COORDINATES | P | DIAGNOSTIC | NOTES |
|----------------|------|------|--|------|------|-----|---------|-------------|---|------------|-------|
| | | | XFT / YFT / ZFT / V / VV / VFT / VXFT / YFT / ZFT / VV | | | | | | | | |
| 280 | 1 | 1 | +C31766-C08750+C6751630009 | | | | | | | | |
| 285 | 1 | | +C31766-C08750+C7001630009 | | | | | | | | |
| 290 | 1 | 1 | +038266-C08750+C7901624000968 | | | | | | | | |
| 3001 | | 0407 | +C32878-C07726+12425024000968 | | | | | | | | |
| 305 | 1 | | +032878-C07726+C930002400096803 | | | | | | | | |
| 320 | 1 | | +005000-014000+0930002400096803 | | | | | | | | |
| 325 | 3 | 1 | +005000-014000+07350024000968 | | | | | | | | |
| 326 | 3 | 1 | | | | | | | | | |
| 327 | 3 | 1 | | | | | | | | | |
| 330 | 1 | | +005000-014000+06650024000968 | | | | | | | | |

TYPE TWO CARDS

| CNO | CMPT | DATA | OR | ANCHOR, | RESTRAINT | FLEX | C | CG-R | STR | LOC-A | COS | CR |
|-----|------|------|----|---------|-----------|------|---|---------|---------|---------|-----|----|
| | | | | | | | | EX | Y | Z | VV | |
| | | | | | | | | / | / | / | / | |
| 280 | | | | | | | | +031766 | +010000 | +067516 | 1 | |
| 285 | | | | | | | | | | | | |
| 290 | | | | | | | | +038266 | -008750 | +06 | 1 | |
| 300 | | | | | | | | | | | | |
| 305 | | | | | | | | | | | | |
| 320 | | | | | | | | | | | | |
| 325 | | | | | | | | +010000 | -014000 | +0735 | 1 | |
| 326 | | | | | | | | +005000 | -010000 | +0735 | 1 | |
| 327 | | | | | | | | +009000 | -014000 | +066572 | 1 | |
| 330 | | | | | | | | | | | | |

TYPE THREE CARDS

| CNO | EXPAN | E | MU | LOAD | RHO | PSI | ULOAD | F | COS, | ANK | DELTA | ANK | ROT, | RSNT | MOVE |
|-----|-------|---|----|------|-----|-----|-------|----|------|-----|-------|-----|------|------|------|
| | | | | | | | | | | | | | | | |
| | | V | VV | VV | VV | VV | VV | VV | VX | Y | Z | X | Y | Z | |
| 280 | | | | | | | | | | | | | | | |
| 285 | | | | | | | | | | | | | | | |
| 290 | | | | | | | | | | | | | | | |
| 300 | | | | | | | | | | | | | | | |
| 305 | | | | | | | | | | | | | | | |
| 320 | | | | | | | | | | | | | | | |
| 325 | | | | | | | | | | | | | | | |
| 326 | | | | | | | | | | | | | | | |
| 327 | | | | | | | | | | | | | | | |
| 330 | | | | | | | | | | | | | | | |

TI
APERTURE
CARD

8504040294-28

Also Available On
Aperture Card

| ELEMENT ID | ELEM TYPE | ELEM PCNT | ELEMENT POINT COORDINATES | | | LENGTH FT. | DIAM IN. | THCK IN. | RADIUS FT. | THETA DEG | DISPLACEMENTS, INCHES | | |
|------------|-----------|-----------|---------------------------|---------|---------|------------|----------|----------|------------|-----------|-----------------------|---------|---------|
| | | | X, FT. | Y, FT. | Z, FT. | | | | | | DELTA X | DELTA Y | DELTA Z |
| 330-07-010 | TGNT | BINP | 5.000 | -14.000 | 66.500 | 7.000 | 24.000 | 0.968 | | | -0.010 | -0.001 | -0.000 |
| 327-07-009 | RSNT | END | 5.000 | -14.000 | 73.500 | | | | | | -0.000 | 0.000 | -0.000 |
| 326-07-008 | RSNT | END | 5.000 | -14.000 | 73.500 | | | | | | -0.000 | 0.000 | -0.000 |
| 325-07-007 | RSNT | END | 5.000 | -14.000 | 73.500 | | | | | | -0.000 | 0.000 | -0.000 |
| 325-07-006 | TGNT | END | 5.000 | -14.000 | 73.500 | 16.500 | 24.000 | 0.968 | | | -0.000 | 0.000 | -0.000 |
| 320-07-005 | BENC | END | 5.000 | -14.000 | 90.000 | 4.712 | 24.000 | 0.968 | 3.000 | 90.000 | 0.017 | 0.000 | -0.000 |
| 320-07-004 | TGNT | END | 7.927 | -13.341 | 93.000 | 22.575 | 24.000 | 0.968 | | | 0.019 | 0.001 | -0.001 |
| 305-07-003 | BENC | END | 29.951 | -8.385 | 93.000 | 4.712 | 24.000 | 0.968 | 3.000 | 90.000 | 0.018 | 0.005 | -0.001 |
| 305-07-002 | TGNT | END | 32.878 | -7.726 | 96.000 | 28.250 | 24.000 | 0.968 | | | 0.016 | 0.005 | 0.000 |
| 300-07-001 | ANKR | END | 32.878 | -7.726 | 124.250 | | 24.000 | 0.968 | | | 0.000 | -0. | -0. |
| 290-06-019 | RSNT | BINP | 38.266 | -8.750 | 70.016 | | | | | | -0.005 | 0.003 | 0.000 |
| 290-06-018 | TGNT | END | 38.266 | -8.750 | 70.016 | 6.500 | 24.000 | 0.968 | | | -0.005 | 0.003 | 0.000 |
| 285-06-017 | TGNT | END | 31.766 | -8.750 | 70.016 | 2.500 | 30.000 | 9.000 | | | -0.005 | 0.003 | -0.006 |
| 280-06-016 | RSNT | END | 31.766 | -8.750 | 67.516 | | | | | | -0.002 | 0.000 | -0.006 |
| 280-06-015 | TGNT | END | 31.766 | -8.750 | 67.516 | 2.500 | 30.000 | 9.000 | | | -0.002 | 0.000 | -0.006 |
| 275-06-014 | TGNT | END | 31.766 | -8.750 | 70.016 | 5.250 | 24.000 | 0.968 | | | -0.005 | 0.003 | -0.006 |
| 270-06-013 | TGNT | END | 26.516 | -8.750 | 70.016 | 2.500 | 30.000 | 9.000 | | | -0.005 | 0.003 | -0.014 |
| 266-06-012 | RSNT | END | 26.516 | -8.750 | 67.516 | | | | | | -0.000 | -0.000 | -0.014 |
| 265-06-011 | RSNT | END | 26.516 | -8.750 | 67.516 | | | | | | -0.000 | -0.000 | -0.014 |
| 265-06-010 | TGNT | END | 26.516 | -8.750 | 67.516 | 2.500 | 30.000 | 9.000 | | | -0.000 | -0.000 | -0.014 |
| 260-06-009 | TGNT | END | 26.516 | -8.750 | 70.016 | 10.500 | 24.000 | 0.968 | | | -0.005 | 0.003 | -0.014 |
| 255-06-008 | TGNT | ENC | 16.016 | -8.750 | 70.016 | 2.500 | 30.000 | 9.000 | | | -0.006 | 0.003 | -0.020 |
| 250-06-007 | RSNT | END | 16.016 | -8.750 | 67.516 | | | | | | -0.007 | 0.000 | -0.020 |
| 250-06-006 | TGNT | END | 16.016 | -8.750 | 67.516 | 2.500 | 30.000 | 9.000 | | | -0.007 | 0.000 | -0.020 |
| 245-06-005 | TGNT | END | 16.016 | -8.750 | 70.016 | 6.257 | 24.000 | 0.968 | | | -0.006 | 0.003 | -0.020 |

TI APERTURE CARD
Also Available On Aperture Card

DATE 00C10'UCO TIME 2513 HRS.

MAIN STEAM SPHERE TO TURBINE X-ACC 1.0G 4/24/65

PROBLEM NO. 010

| ELEMENT ID | ELEM TYPE | ELEM PCNT | ROTATIONS, RADIANS | | | RSNT LOAD | FORCES, LBS. | | | MOMENTS, FT.-LBS. | | | STRESS SE, PSI |
|------------|-----------|-----------|--------------------|----------|----------|-----------|--------------|-------|--------|-------------------|---------|------|----------------|
| | | | PHI X | PHI Y | PHI Z | | FX | FY | FZ | MX | MY | MZ | |
| 330-07-01C | TGNT | BINP | -0.00002 | 0.00009 | 0.00004 | | -1503. | 248. | -1201. | -2804. | -11488. | 373. | 366. |
| 327-07-009 | RSNT | END | -0.00001 | 0.00013 | 0.00004 | -1416. | -708. | 0. | 1226. | 0. | 0. | 0. | |
| 326-07-008 | RSNT | END | -0.00001 | 0.00013 | 0.00004 | -195. | -0. | -195. | -0. | 0. | 0. | 0. | |
| 325-07-007 | RSNT | END | -0.00001 | 0.00013 | 0.00004 | 4208. | 4208. | 0. | 0. | 0. | 0. | 0. | |
| 325-07-006 | TGNT | END | -0.00001 | 0.00013 | 0.00004 | | 217. | 53. | 25. | -1066. | 5264. | 373. | 167. |
| 320-07-005 | BEND | END | 0.00000 | 0.00006 | 0.00003 | | 217. | 53. | 25. | -192. | 1689. | 373. | 116. |
| 320-07-004 | TGNT | END | 0.00001 | 0.00002 | 0.00002 | | 217. | 53. | 25. | -50. | 1112. | 361. | 79. |
| 305-07-003 | BEND | END | 0.00001 | -0.00001 | 0.00001 | | 217. | 53. | 25. | -173. | 1657. | 269. | 114. |
| 305-07-002 | TGNT | END | 0.00002 | -0.00006 | 0.00001 | | 217. | 53. | 25. | -30. | 1079. | 257. | 74. |
| 300-07-001 | ANKR | END | -0. | -0. | -0. | | 217. | 53. | 25. | 1465. | -5041. | 257. | 163. |
| 290-06-019 | RSNT | BINP | -0.00009 | -0.00007 | 0.00000 | 1320. | 0. | 0. | -1320. | 0. | 0. | 0. | |
| 290-06-018 | TGNT | END | -0.00009 | -0.00007 | 0.00000 | | 0. | -0. | -1320. | -0. | 0. | 0. | 0. |
| 285-06-017 | TGNT | END | -0.00009 | -0.00010 | 0.00000 | | -3650. | -0. | -1320. | -0. | 8582. | -0. | 40. |
| 280-06-016 | RSNT | END | -0.00009 | -0.00010 | 0.00000 | -5. | -0. | -5. | -0. | 0. | 0. | 0. | |
| 280-06-015 | TGNT | END | -0.00009 | -0.00010 | 0.00000 | | -3650. | -5. | -1320. | 0. | -544. | -0. | 3. |
| 275-06-014 | TGNT | END | -0.00009 | -0.00010 | 0.00000 | | -3650. | -5. | -1320. | -11. | 8582. | -0. | 266. |
| 270-06-013 | TGNT | END | -0.00009 | -0.00017 | 0.00000 | | -6989. | -5. | -1320. | -11. | 15513. | -24. | 72. |
| 266-06-012 | RSNT | END | -0.00009 | -0.00017 | 0.00000 | 27. | 0. | 27. | 0. | 0. | 0. | 0. | |
| 265-06-011 | RSNT | END | -0.00009 | -0.00017 | 0.00000 | -16828. | 16828. | -0. | -0. | 0. | 0. | 0. | |
| 265-06-010 | TGNT | END | -0.00009 | -0.00017 | 0.00000 | | 9839. | 23. | -1320. | 0. | -1960. | -24. | 9. |
| 260-06-009 | TGNT | END | -0.00009 | -0.00017 | 0.00000 | | 9839. | 23. | -1320. | 56. | -26557. | -24. | 822. |
| 255-06-008 | TGNT | END | -0.00009 | 0.00006 | -0.00000 | | 3161. | 23. | -1320. | 56. | -12694. | 213. | 59. |
| 250-06-007 | RSNT | END | -0.00009 | 0.00006 | -0.00000 | -101. | -0. | -101. | -0. | 0. | 0. | 0. | |
| 250-06-006 | TGNT | END | -0.00009 | 0.00006 | -0.00000 | | 3161. | -79. | -1320. | 0. | -4792. | 213. | 22. |
| 245-06-005 | TGNT | END | -0.00009 | 0.00007 | -0.00000 | | 3161. | -79. | -1320. | -197. | -12694. | 213. | 393. |

TI APERTURE CARD

Also Available On Aperture Card

| ELEMENT ID | ELEM TYPE | ELEM PONT | ELEMENT POINT COORDINATES | | | LENGTH FT. | DIAM IN. | THCK IN. | RADIUS FT. | THETA DEG | DISPLACEMENTS, INCHES | | |
|------------|-----------|-----------|---------------------------|---------|--------|------------|----------|----------|------------|-----------|-----------------------|---------|---------|
| | | | X, FT. | Y, FT. | Z, FT. | | | | | | DELTA X | DELTA Y | DELTA Z |
| 240-06-004 | BENC | END | 9.759 | -8.750 | 70.016 | 2.356 | 24.000 | 0.968 | 3.000 | 45.000 | -0.006 | 0.003 | -0.012 |
| 240-06-003 | TGNT | END | 7.637 | -8.750 | 69.137 | 0.730 | 24.000 | 0.968 | | | -0.007 | 0.002 | -0.008 |
| 235-06-002 | BENC | END | 7.121 | -8.750 | 68.621 | 4.712 | 24.000 | 0.968 | 3.000 | 90.000 | -0.008 | 0.001 | -0.007 |
| 235-06-001 | TGNT | END | 5.000 | -11.750 | 66.500 | 2.250 | 24.000 | 0.968 | | | -0.011 | -0.001 | -0.001 |
| 235-06-001 | TGNT | BGIN | 5.000 | -14.000 | 66.500 | 2.250 | 24.000 | 0.968 | | | -0.010 | -0.001 | -0.000 |
| 120-05-008 | TGNT | BINP | 5.000 | -14.000 | 66.500 | 23.330 | 24.000 | 0.968 | | | -0.010 | -0.001 | -0.000 |
| 105-05-007 | RSNT | END | 5.000 | -14.000 | 43.170 | | | | | | -0.000 | -0.000 | -0.000 |
| 85-05-006 | RSNT | END | 5.000 | -14.000 | 43.170 | | | | | | -0.000 | -0.000 | -0.000 |
| 85-05-005 | TGNT | END | 5.000 | -14.000 | 43.170 | 1.500 | 24.000 | 0.968 | | | -0.000 | -0.000 | -0.000 |
| 80-05-004 | TGNT | END | 5.000 | -14.000 | 41.670 | 1.000 | 30.000 | 9.000 | | | -0.001 | 0.000 | -0.000 |
| 77-05-003 | CMPT | END | 4.000 | -14.000 | 41.670 | 4.500 | | | | | -0.001 | -0.001 | 0.001 |
| 76-05-002 | TGNT | END | 4.000 | -14.000 | 37.170 | 1.000 | 30.000 | 9.000 | | | -0.007 | -0.001 | 0.001 |
| 75-05-001 | TGNT | END | 5.000 | -14.000 | 37.170 | 11.000 | 24.000 | 0.968 | | | -0.007 | -0.000 | -0.000 |
| 75-05-001 | TGNT | BGIN | 5.000 | -14.000 | 26.170 | 11.000 | 24.000 | 0.968 | | | -0.010 | -0.001 | -0.000 |
| 72-04-003 | RSNT | BINP | -25.000 | -14.000 | 18.920 | | | | | | -0.000 | -0.000 | -0.000 |
| 71-04-002 | RSNT | END | -25.000 | -14.000 | 18.920 | | | | | | -0.000 | -0.000 | -0.000 |
| 71-04-001 | TGNT | END | -25.000 | -14.000 | 18.920 | 7.250 | 24.000 | 0.812 | | | -0.000 | -0.000 | -0.000 |
| 71-04-001 | TGNT | BGIN | -25.000 | -14.000 | 26.170 | 7.250 | 24.000 | 0.812 | | | -0.010 | -0.000 | -0.000 |
| 70-03-002 | TGNT | BINP | -25.000 | -14.000 | 26.170 | 17.000 | 24.000 | 0.968 | | | -0.010 | -0.000 | -0.000 |
| 65-03-001 | ANKR | END | -25.000 | -14.000 | 43.170 | | 24.000 | 0.968 | | | -0.000 | -0. | -0. |
| 60-02-001 | TGNT | BINP | -25.000 | -14.000 | 26.170 | 30.000 | 20.000 | 0.812 | | | -0.010 | -0.000 | -0.000 |
| 60-02-001 | TGNT | BGIN | 5.000 | -14.000 | 26.170 | 30.000 | 20.000 | 0.812 | | | -0.010 | -0.001 | -0.000 |
| 45-01-009 | TGNT | BINP | 5.000 | -14.000 | 26.170 | 7.250 | 24.000 | 0.968 | | | -0.010 | -0.001 | -0.000 |
| 40-01-008 | RSNT | END | 5.000 | -14.000 | 18.920 | | | | | | -0.000 | 0.000 | -0.000 |
| 20-01-007 | RSNT | END | 5.000 | -14.000 | 18.920 | | | | | | -0.000 | 0.000 | -0.000 |

II
APERTURE
CARD

Also Available On
Aperture Card

DATE 00010'UGO TIME 2513 HRS.

MAIN STEAM SPHERE TO TURBINE X-ACC 1.0G 4/24/65

PROBLEM NO. 010

| ELEMENT ID | ELEM TYPE | ELEM PCNT | ROTATIONS, RADIANS | | | RSNT LOAD | FORCES, LBS. | | | MOMENTS, FT.-LBS. | | | STRESS SE, PSI |
|------------|-----------|-----------|--------------------|----------|----------|-----------|--------------|--------|--------|-------------------|---------|--------|----------------|
| | | | PHI X | PHI Y | PHI Z | | FX | FY | FZ | MX | MY | MZ | |
| 240-06-004 | BEND | END | -0.00009 | 0.00013 | -0.00000 | | 1569. | -79. | -1320. | -197. | -4432. | -279. | 302. |
| 240-06-003 | TGNT | END | -0.00009 | 0.00017 | 0.00000 | | 970. | -79. | -1320. | -127. | -601. | -446. | 45. |
| 235-06-002 | BEND | END | -0.00009 | 0.00017 | 0.00000 | | 784. | -79. | -1320. | -87. | 533. | -487. | 43. |
| 235-06-001 | TGNT | END | -0.00004 | 0.00011 | 0.00004 | | -415. | -79. | -1320. | -3881. | 4073. | -716. | 296. |
| 235-06-001 | TGNT | BGIN | -0.00002 | 0.00009 | 0.00004 | | -987. | -79. | -1320. | -6852. | 4073. | 862. | 248. |
| 120-05-008 | TGNT | BINP | -0.00002 | 0.00009 | 0.00004 | | 780. | -289. | -170. | -4337. | 15426. | -604. | 496. |
| 105-05-007 | RSNT | END | 0.00000 | 0.00006 | 0.00006 | 13511. | 9554. | 9554. | 0. | 0. | 0. | 0. | |
| 85-05-006 | RSNT | END | 0.00000 | 0.00006 | 0.00006 | -11328. | 6817. | -9047. | -0. | 0. | 0. | 0. | |
| 85-05-005 | TGNT | END | 0.00000 | 0.00006 | 0.00006 | | 11216. | 217. | -170. | 2413. | -35607. | -604. | 1105. |
| 80-05-004 | TGNT | END | -0.00000 | 0.00010 | 0.00006 | | 10834. | 217. | -170. | 2087. | -19069. | -604. | 89. |
| 77-05-003 | CMPT | END | -0.00000 | 0.00010 | 0.00006 | | 10834. | 217. | -170. | 2087. | -18899. | -387. | 0. |
| 76-05-002 | TGNT | END | -0.00000 | 0.00010 | 0.00006 | | 1838. | 217. | -170. | 1110. | 9613. | -387. | 45. |
| 75-05-001 | TGNT | END | -0.00000 | 0.00010 | 0.00006 | | 1838. | 217. | -170. | 1110. | 9443. | -604. | 295. |
| 75-05-001 | TGNT | BGIN | -0.00000 | -0.00007 | 0.00007 | | -961. | 217. | -170. | -1278. | 14268. | -604. | 444. |
| 72-04-003 | RSNT | BINP | 0.00000 | -0.00015 | -0.00002 | 3900. | 3900. | 0. | 0. | 0. | 0. | 0. | |
| 71-04-002 | RSNT | END | 0.00000 | -0.00015 | -0.00002 | 86. | 0. | 86. | 0. | 0. | 0. | 0. | |
| 71-04-001 | TGNT | END | 0.00000 | -0.00015 | -0.00002 | | 3900. | 86. | -0. | 0. | -0. | -0. | 0. |
| 71-04-001 | TGNT | BGIN | 0.00000 | -0.00004 | -0.00002 | | 2055. | 86. | -0. | 625. | -21587. | -0. | 781. |
| 70-03-002 | TGNT | BINP | 0.00000 | -0.00004 | -0.00002 | | -340. | -65. | -327. | 601. | -17192. | -898. | 533. |
| 65-03-001 | ANKR | END | -0. | -0. | -0. | | -4665. | -65. | -327. | -499. | 25354. | -898. | 785. |
| 60-02-001 | TGNT | BINP | 0.00000 | -0.00004 | -0.00002 | | 2396. | 151. | 327. | 24. | -4395. | 898. | 239. |
| 60-02-001 | TGNT | BGIN | -0.00000 | -0.00007 | 0.00007 | | -2932. | 151. | 327. | 24. | 5416. | -3626. | 347. |
| 45-01-009 | TGNT | BINP | -0.00000 | -0.00007 | 0.00007 | | -3891. | 368. | 175. | -1256. | 19685. | -4231. | 624. |
| 40-01-008 | RSNT | END | 0.00002 | -0.00010 | 0.00012 | 7034. | 4974. | 4974. | 0. | 0. | 0. | 0. | |
| 20-01-007 | RSNT | END | 0.00002 | -0.00010 | 0.00012 | -7634. | 4594. | -6097. | -0. | 0. | 0. | 0. | |

TI APERTURE CARD

Also Available On Aperture Card

RUN NO. 0

PIPING FLEXIBILITY ANALYSIS PROGRAM MEC-21/7094
** WEIGHT LOADING EFFECTS **

PAGE 9 OF 10

DATE 00010*U00 TIME 2513 HRS.

MAIN STEAM SPHERE TO TURBINE X-ACC 1.0G 4/24/65

PROBLEM NO. 010

| ELEMENT ID CRD-BR-ELM | ELEM TYPE | ELEM PCNT | ELEMENT POINT COORDINATES | | | LENGTH FT. | DIAM IN. | THCK IN. | RADIUS FT. | THETA DEG | DISPLACEMENTS, INCHES | | |
|--------------------------|-----------|-----------|---------------------------|---------|--------|---------------|-------------|-------------|---------------|--------------|-----------------------|---------|---------|
| | | | X, FT. | Y, FT. | Z, FT. | | | | | | DELTA X | DELTA Y | DELTA Z |
| 20-01-CC6 | TGNT | END | 5.000 | -14.000 | 18.920 | 3.250 | 24.000 | 0.968 | | | -0.000 | 0.000 | -0.000 |
| 15-01-CC5 | BEND | END | 5.000 | -14.000 | 15.670 | 4.712 | 24.000 | 0.968 | 3.000 | 90.000 | 0.003 | 0.001 | -0.000 |
| 15-01-CC4 | TGNT | END | 3.991 | -11.175 | 12.670 | 8.866 | 24.000 | 0.968 | | | -0.000 | 0.000 | 0.000 |
| 10-01-CC3 | BEND | END | 1.009 | -2.825 | 12.670 | 4.712 | 24.000 | 0.968 | 3.000 | 90.000 | -0.013 | -0.004 | 0.000 |
| 10-01-CC2 | TGNT | END | -0. | -0. | 9.670 | 9.670 | 24.000 | 0.968 | | | -0.011 | -0.003 | 0.000 |
| 5-01-CC1 | ANKR | END | -0. | -0. | -0. | | 24.000 | 0.968 | | | -0.000 | -0. | -0. |

TI
APERTURE
CARD

TI
TURE
CARD

Also Available On
Aperture Card

RUN NO. 0

PIPING FLEXIBILITY ANALYSIS PROGRAM MEC-21/7094
** WEIGHT LOADING EFFECTS **

PAGE 10 OF 10

DATE 00010'U00 TIME 2513 HRS.

MAIN STEAM SPHERE TO TURBINE X-ACC 1.0G 4/24/65

PROBLEM NO. 010

| ELEMENT ID CRD-BR-ELM | ELEM TYPE | ELEM PONT | ROTATIONS, RADIANS | | | RSNT LOAD | FORCES, LBS. | | | MOMENTS, FT.-LBS. | | | STRESS SE, PSI |
|--------------------------|-----------|-----------|--------------------|----------|---------|-----------|--------------|-------|------|-------------------|---------|--------|----------------|
| | | | PHI X | PHI Y | PHI Z | | FX | FY | FZ | MX | MY | MZ | |
| 20-01-006 | TGNT | END | 0.00002 | -0.00010 | 0.00012 | | 3833. | -755. | 175. | -3925. | -15212. | -4231. | 504. |
| 15-01-005 | BEND | END | 0.00003 | -0.00007 | 0.00014 | | 3006. | -755. | 175. | -1471. | -4100. | -4231. | 323. |
| 15-01-004 | TGNT | END | 0.00002 | -0.00005 | 0.00015 | | 1807. | -755. | 175. | 297. | 3433. | 1344. | 165. |
| 10-01-003 | BEND | END | 0.00003 | -0.00009 | 0.00010 | | -449. | -755. | 175. | -1167. | 2910. | 4764. | 338. |
| 10-01-002 | TGNT | END | 0.00005 | -0.00014 | 0.00002 | | -1647. | -755. | 175. | 601. | -902. | 1504. | 87. |
| 5-01-001 | ANKR | END | -0. | -0. | -0. | | -4107. | -755. | 175. | 7900. | -28727. | 1504. | 923. |

END, EXECUTION TIME 1.69 MINUTES.

III
APERTURE
CARD

Also Available On
Aperture Card

8504040294-34

2514 BEGIN PROBLEM C11

*****THE INITIAL LOAD SPECIFIED FOR THE RIGID RESTRAINT AT DATA POINT 20 HAS BEEN RESET TO ZERO.
TO INCLUDE AN INITIAL LOAD, SPECIFY A FLEXIBLE RESTRAINT.

*****THE INITIAL LOAD SPECIFIED FOR THE RIGID RESTRAINT AT DATA POINT 40 HAS BEEN RESET TO ZERO.
TO INCLUDE AN INITIAL LOAD, SPECIFY A FLEXIBLE RESTRAINT.

*****THE INITIAL LOAD SPECIFIED FOR THE RIGID RESTRAINT AT DATA POINT 71 HAS BEEN RESET TO ZERO.
TO INCLUDE AN INITIAL LOAD, SPECIFY A FLEXIBLE RESTRAINT.

*****THE INITIAL LOAD SPECIFIED FOR THE RIGID RESTRAINT AT DATA POINT 72 HAS BEEN RESET TO ZERO.
TO INCLUDE AN INITIAL LOAD, SPECIFY A FLEXIBLE RESTRAINT.

*****THE INITIAL LOAD SPECIFIED FOR THE RIGID RESTRAINT AT DATA POINT 85 HAS BEEN RESET TO ZERO.
TO INCLUDE AN INITIAL LOAD, SPECIFY A FLEXIBLE RESTRAINT.

*****THE INITIAL LOAD SPECIFIED FOR THE RIGID RESTRAINT AT DATA POINT 105 HAS BEEN RESET TO ZERO.
TO INCLUDE AN INITIAL LOAD, SPECIFY A FLEXIBLE RESTRAINT.

*****THE INITIAL LOAD SPECIFIED FOR THE RIGID RESTRAINT AT DATA POINT 250 HAS BEEN RESET TO ZERO.
TO INCLUDE AN INITIAL LOAD, SPECIFY A FLEXIBLE RESTRAINT.

*****THE INITIAL LOAD SPECIFIED FOR THE RIGID RESTRAINT AT DATA POINT 265 HAS BEEN RESET TO ZERO.
TO INCLUDE AN INITIAL LOAD, SPECIFY A FLEXIBLE RESTRAINT.

*****THE INITIAL LOAD SPECIFIED FOR THE RIGID RESTRAINT AT DATA POINT 266 HAS BEEN RESET TO ZERO.
TO INCLUDE AN INITIAL LOAD, SPECIFY A FLEXIBLE RESTRAINT.

*****THE INITIAL LOAD SPECIFIED FOR THE RIGID RESTRAINT AT DATA POINT 280 HAS BEEN RESET TO ZERO.
TO INCLUDE AN INITIAL LOAD, SPECIFY A FLEXIBLE RESTRAINT.

*****THE INITIAL LOAD SPECIFIED FOR THE RIGID RESTRAINT AT DATA POINT 290 HAS BEEN RESET TO ZERO.
TO INCLUDE AN INITIAL LOAD, SPECIFY A FLEXIBLE RESTRAINT.

*****THE INITIAL LOAD SPECIFIED FOR THE RIGID RESTRAINT AT DATA POINT 325 HAS BEEN RESET TO ZERO.
TO INCLUDE AN INITIAL LOAD, SPECIFY A FLEXIBLE RESTRAINT.

*****THE INITIAL LOAD SPECIFIED FOR THE RIGID RESTRAINT AT DATA POINT 326 HAS BEEN RESET TO ZERO.
TO INCLUDE AN INITIAL LOAD, SPECIFY A FLEXIBLE RESTRAINT.

*****THE INITIAL LOAD SPECIFIED FOR THE RIGID RESTRAINT AT DATA POINT 327 HAS BEEN RESET TO ZERO.
TO INCLUDE AN INITIAL LOAD, SPECIFY A FLEXIBLE RESTRAINT.

CONTROL ENTERED BLKF08.
CONTRCL ENTERED BLKF08.
CONTRCL ENTERED BLKF08.
CONTROL ENTERED BLKF08.
CCNTRCL ENTERED BLKF08.
CONTROL ENTERED BLKF12.

THE
APERTURE
CARD

Also Available On
Aperture Card

MAIN STEAM SPHERE TO TURBINE Y-ACC 1.67G 4/26/65 PROBLEM NO. 011
PROJECT NO. 3246 DATE 0010'U00
GROUP 0000 TIME 2514 HRS.

SUMMATION OF THE REACTIONS ON THE STRUCTURE

| FX, LBS. | FY, LBS. | FZ, LBS. | MX, FT.-LBS. | MY, FT.-LBS. | MZ, FT.-LBS. |
|----------|----------|----------|--------------|--------------|--------------|
| -0. | -98506. | -0. | 4356676. | -9. | -520913. |

SUMMATION OF THE WEIGHT AND UNIFORM LOADING EFFECTS

| FX, LBS. | FY, LBS. | FZ, LBS. | MX, FT.-LBS. | MY, FT.-LBS. | MZ, FT.-LBS. |
|----------|----------|----------|--------------|--------------|--------------|
| 0. | -98507. | 0. | 4356707. | 0. | -520917. |

CENTER-OF-FORCES COORDINATES

CENTER-OF-GRAVITY COORDINATES

| X, FT. | Y, FT. | Z, FT. | X, FT. | Y, FT. | Z, FT. |
|--------|--------|--------|--------|--------|--------|
| 5.3 | 0. | 44.2 | 5.3 | -11.3 | 44.2 |

SUMMATION OF THE REACTIONS AT THE BRANCH-INTERSECTION-POINTS

| BINP NO. | FX, LBS. | FY, LBS. | FZ, LBS. | MX, FT.-LBS. | MY, FT.-LBS. | MZ, FT.-LBS. |
|----------|----------|----------|----------|--------------|--------------|--------------|
| LINP 1 | -0. | 2. | -0. | 8. | -3. | -0. |
| LINP 2 | -0. | 0. | 0. | 0. | -0. | -0. |
| LINP 3 | -0. | -0. | -0. | 0. | -0. | -0. |
| LINP 4 | -0. | 0. | -0. | -0. | 0. | 0. |
| LINP 5 | 0. | 0. | 0. | 0. | 0. | -0. |

TI
APERTURE
CARD

Also Available On
Aperture Card

RUN NO. C

PIPING FLEXIBILITY ANALYSIS PROGRAM MEC-21/7094
** DATA CARD DISPLAY WITH DIAGNOSTIC NOTES **

DATE 00010'000 TIME 2514 HRS.

MAIN STEAM SPHERE TO TURBINE Y-ACC 1.67G 4/26/65

PROBLEM NO. 011

TYPE ONE CARDS

CNOARTTCTCBFR DATA PT COORDINATES DIAM THCK RAD SPECIAL COORDINATES P DIAGNOSTIC NOTES
XFT / YFT / ZFT / V / VV/ VFT/ VXFT / YFT / ZFT / VV

| LINE NO | PT | COORDINATES | DIAM | THCK | RAD | SPECIAL COORDINATES P | DIAGNOSTIC NOTES |
|---------|------|-------------|------|------|-----|----------------------------------|-------------------|
| 51 | C1C1 | | | | | 2400C0968 | ZERO COORDINATES. |
| 10 | 1 | | | | | +012670240000968C3 | |
| 15 | 1 | | | | | +C05000-014000+01267024000096803 | |
| 20 | 2 1 | | | | | +005000-014000+018920240000968 | |
| 40 | 2 1 | | | | | | |
| 45 | 1 | | | | | +C05000-014000+026170240000968 | |
| 60 | 1 | 020201 | | | | -C25000-014000+026170240000812 | |
| 65 | 1 | 0203 | | | | -C25000-014000+043170240000968 | |
| 70 | 1 | | | | | -025000-014000+026170240000968 | |
| 71 | 2 1 | 030402 | | | | -C25000-014000+018920240000812 | |
| 72 | 2 1 | | | | | | |
| 75 | 1 | 040501 | | | | +C05000-014000+037170240000968 | |
| 76 | 1 | | | | | +004000-014000+037170300009 | |
| 77 | 3 | | | | | +004000-014000+041670 | |

TYPE TWO CARDS

CNO CMPT DATA OR ANCHOR, RESTRAINT FLEX C CG-R STR LOC-A COS CR
/ E/ E/ E/ E/ E/ EX // Y // Z // VV

| LINE NO | DATA OR ANCHOR, RESTRAINT | FLEX C | CG-R | STR | LOC-A | COS | CR |
|---------|---------------------------|--------|------|-----|-------|-----|-------------------------|
| 5 | | | | | | | |
| 10 | | | | | | | |
| 15 | | | | | | | |
| 20 | | | | | | | +000186-007611+018920 1 |
| 40 | | | | | | | +010657-008343+018920 1 |
| 45 | | | | | | | |
| 60 | | | | | | | |
| 65 | | | | | | | |
| 70 | | | | | | | |
| 71 | | | | | | | -025000-004000+018920 1 |
| 72 | | | | | | | -015000-014000+018920 1 |
| 75 | | | | | | | |
| 76 | | | | | | | |
| 77 | | | | | | | 1 |

TYPE THREE CARDS

CNOEXPAN E MU LOAD RHO PSI ULOAC F COS, ANK DELTA ANK ROT, RSNT MOVE
/ V VV VV VV / VV V/ VX / Y / Z / X// Y// Z//

| LINE NO | EXPAN | E | MU | LOAD | RHO | PSI | UOAC | F | COS | ANK DELTA | ANK ROT | RSNT MOVE |
|---------|-------|---|----|------|-----|-----|------|-------|-----|-----------|---------|-----------|
| 5 | | | | | | | | | | | | |
| 10 | | | | 2793 | | | | 35402 | | | | -1 |
| 15 | | | | 2793 | | | | 35402 | | | | -1 |
| 20 | | | | 2793 | | | | 35402 | | | | -1 |
| 40 | | | | | | | | | | | | |
| 45 | | | | 2793 | | | | 35402 | | | | -1 |
| 60 | | | | 2793 | | | | 24722 | | | | -1 |
| 65 | | | | | | | | | | | | |
| 70 | | | | 2793 | | | | 35402 | | | | -1 |
| 71 | | | | 2793 | | | | 35402 | | | | -1 |
| 72 | | | | | | | | | | | | |
| 75 | | | | 2793 | | | | 35402 | | | | -1 |
| 76 | | | | 2793 | | | | | | | | |
| 77 | | | | 2793 | | | | 27823 | | | | -1 |

TI
APERTURE
CARD

Also Available On
Aperture Card

42

RUN NO. C

PIPING FLEXIBILITY ANALYSIS PROGRAM MEC-21/7094
** DATA CARD DISPLAY WITH DIAGNOSTIC NOTES **

PAGE 3 OF 10

DATE 00010'000 TIME 2514 HRS.

MAIN STEAM SPHERE TO TURBINE Y-ACC 1.67G 4/26/65

PROBLEM NO. 011

TYPE ONE CARDS

| CNO | ARTTCTOBRFR | DATA | PT | COORDINATES | DIAM | THCK | RAD | SPECIAL | COORDINATES | P | DIAGNOSTIC | NOTES |
|-----|-------------|--------|----|--|------|------|-----|---------|-------------|---|------------|-------|
| | | | | XFT / YFT / ZFT / V / VV/ VFT/ VXFT / YFT / ZFT / VV | | | | | | | | |
| 80 | 1 | | | +C05CC0-014C00+04167C3CC009 | | | | | | | | |
| 85 | 2 | 1 | | +C05C00-C14C00+C431702400CC968 | | | | | | | | |
| 105 | 2 | 1 | | | | | | | | | | |
| 120 | 1 | | | +C05CC0-014C00+06650C240CCC968 | | | | | | | | |
| 235 | 1 | 050604 | | +CC5CC0-C08750+066500240CCC96803 | | | | | | | | |
| 240 | 1 | | | +008516-C08750+07001624C00C96803 | | | | | | | | |
| 245 | 1 | | | +016016-C08750+07001624C00C968 | | | | | | | | |
| 250 | 1 | 1 | | +016016-C08750+0675163000C9CC0 | | | | | | | | |
| 255 | 1 | | | +016C16-C08750+07001630C009CC0 | | | | | | | | |
| 260 | 1 | | | +026516-C08750+07001624CCC968 | | | | | | | | |
| 265 | 2 | 1 | | +026516-C08750+06751630CC09 | | | | | | | | |
| 266 | 2 | 1 | | | | | | | | | | |
| 270 | 1 | | | +026516-C08750+07001630CC0C9 | | | | | | | | |
| 275 | 1 | | | +031766-C08750+07001624C00C968 | | | | | | | | |

TYPE TWO CARDS

| CNO | CMPT | DATA | OR | ANCHOR | RESTRAINT | FLEX | C | CG-R | STR | LOC-A | COS | CR | | | |
|-----|------|------|----|--------|-----------|------|----|------|-----|-------|-----|----|----|----|--|
| | | | | | | | | | | | | | | | |
| | | | E/ | E/ | E/ | E/ | E/ | EX | // | Y | // | Z | // | VV | |
| 80 | | | | | | | | | | | | | | | |
| 85 | | | | | | | | | | | | | | | |
| 105 | | | | | | | | | | | | | | | |
| 120 | | | | | | | | | | | | | | | |
| 235 | | | | | | | | | | | | | | | |
| 240 | | | | | | | | | | | | | | | |
| 245 | | | | | | | | | | | | | | | |
| 250 | | | | | | | | | | | | | | | |
| 255 | | | | | | | | | | | | | | | |
| 260 | | | | | | | | | | | | | | | |
| 265 | | | | | | | | | | | | | | | |
| 266 | | | | | | | | | | | | | | | |
| 270 | | | | | | | | | | | | | | | |
| 275 | | | | | | | | | | | | | | | |

TYPE THREE CARDS

| CNO | EXPAN | E | MU | LOAD | RHO | PSI | ULOAD | F | COS | ANK | DELTA | ANK | ROT | RSNT | MOVE | | | |
|-----|-------|---|----|------|-----|-----|-------|----|-----|-----|-------|-----|-----|------|------|-----|-----|--|
| | | | | | | | | | | | | | | | | | | |
| | | V | VV | VV | VV | / | VV | V/ | VX | / | Y | / | Z | / | X// | Y// | Z// | |
| 80 | | | | | | | | | | | | | | | | | | |
| 85 | | | | | | | | | | | | | | | | | | |
| 105 | | | | | | | | | | | | | | | | | | |
| 120 | | | | | | | | | | | | | | | | | | |
| 235 | | | | | | | | | | | | | | | | | | |
| 240 | | | | | | | | | | | | | | | | | | |
| 245 | | | | | | | | | | | | | | | | | | |
| 250 | | | | | | | | | | | | | | | | | | |
| 255 | | | | | | | | | | | | | | | | | | |
| 260 | | | | | | | | | | | | | | | | | | |
| 265 | | | | | | | | | | | | | | | | | | |
| 266 | | | | | | | | | | | | | | | | | | |
| 270 | | | | | | | | | | | | | | | | | | |
| 275 | | | | | | | | | | | | | | | | | | |

TI
APERTURE
CARD

Also Available On
Aperture Card

8504040294-38

RUN NO. 0

PIPING FLEXIBILITY ANALYSIS PROGRAM MEC-21/7094
** DATA CARD DISPLAY WITH DIAGNOSTIC NOTES **

PAGE 4 OF 10

DATE 00C1C*U00 TIME 2514 HRS.

MAIN STEAM SPHERE TO TURBINE Y-ACC 1.67G 4/26/65

PROBLEM NO. 011

TYPE ONE CARDS

| CNO | ART | TCT | CB | RFR | DATA | PT | COORDINATES | DIAM | THCK | RAD | SPECIAL | COORDINATES | P | DIAGNOSTIC | NOTES |
|------|-----|-----|------|-----|------|----|-------------|------|------|-----|---------|-------------|---|------------|-------|
| | | | | | | | | | | | | | | | |
| 280 | 1 | 1 | | | | | | | | | | | | | |
| | | | | | | | | | | | | | | | |
| 285 | 1 | | | | | | | | | | | | | | |
| 290 | 1 | 1 | | | | | | | | | | | | | |
| 3001 | | | 0407 | | | | | | | | | | | | |
| 305 | 1 | | | | | | | | | | | | | | |
| 320 | 1 | | | | | | | | | | | | | | |
| 325 | 3 | 1 | | | | | | | | | | | | | |
| 326 | 3 | 1 | | | | | | | | | | | | | |
| 327 | 3 | 1 | | | | | | | | | | | | | |
| 330 | 1 | | | | | | | | | | | | | | |

TYPE TWO CARDS

| CNO | CMPT | DATA | OR | ANCHOR | RESTRAINT | FLEX | C | CG-R | STR | LOC-A | COS | CR |
|-----|------|------|----|--------|-----------|------|---|------|-----|-------|-----|----|
| | | | | | | | | | | | | |
| 280 | | | | | | | | | | | | |
| 285 | | | | | | | | | | | | |
| 290 | | | | | | | | | | | | |
| 300 | | | | | | | | | | | | |
| 305 | | | | | | | | | | | | |
| 320 | | | | | | | | | | | | |
| 325 | | | | | | | | | | | | |
| 326 | | | | | | | | | | | | |
| 327 | | | | | | | | | | | | |
| 330 | | | | | | | | | | | | |

TYPE THREE CARDS

| CNO | EXPAN | E | MU | LOAD | RHO | PSI | ULOAD | F | COS | ANK | DELTA | ANK | ROT | RSNT | MOVE |
|-----|-------|---|----|------|-----|-----|-------|---|-----|-----|-------|-----|-----|------|------|
| | | | | | | | | | | | | | | | |
| 280 | | | | | | | | | | | | | | | |
| 285 | | | | | | | | | | | | | | | |
| 290 | | | | | | | | | | | | | | | |
| 300 | | | | | | | | | | | | | | | |
| 305 | | | | | | | | | | | | | | | |
| 320 | | | | | | | | | | | | | | | |
| 325 | | | | | | | | | | | | | | | |
| 326 | | | | | | | | | | | | | | | |
| 327 | | | | | | | | | | | | | | | |
| 330 | | | | | | | | | | | | | | | |

Also Available On Aperture Card

TI
APERTURE
CARD

c(4)
 ↑ c.

DATE 00C10'U00 TIME 2514 HRS.

MAIN STEAM SPHERE TO TURBINE Y-ACC 1.67G 4/26/65

PROBLEM NO. 011

| ELEMENT ID | ELEM TYPE | ELEM PONT | ELEMENT POINT COORDINATES | | | LENGTH FT. | DIAM IN. | THCK IN. | RADIUS FT. | THETA DEG | DISPLACEMENTS, INCHES | | |
|------------|-----------|-----------|---------------------------|---------|---------|------------|----------|----------|------------|-----------|-----------------------|---------|---------|
| | | | X, FT. | Y, FT. | Z, FT. | | | | | | DELTA X | DELTA Y | DELTA Z |
| 330-07-010 | TGNT | BINP | 5.000 | -14.000 | 66.500 | 7.000 | 24.000 | 0.968 | | | 0.007 | -0.004 | 0.000 |
| 327-07-009 | RSNT | END | 5.000 | -14.000 | 73.500 | | | | | | 0.000 | -0.000 | 0.000 |
| 326-07-008 | RSNT | END | 5.000 | -14.000 | 73.500 | | | | | | 0.000 | -0.000 | 0.000 |
| 325-07-007 | RSNT | END | 5.000 | -14.000 | 73.500 | | | | | | 0.000 | -0.000 | 0.000 |
| 325-07-006 | TGNT | END | 5.000 | -14.000 | 73.500 | 16.500 | 24.000 | 0.968 | | | 0.000 | -0.000 | 0.000 |
| 320-07-005 | BENC | END | 5.000 | -14.000 | 90.000 | 4.712 | 24.000 | 0.968 | 3.000 | 90.000 | -0.017 | 0.017 | 0.000 |
| 320-07-004 | TGNT | END | 7.927 | -13.341 | 93.000 | 22.575 | 24.000 | 0.968 | | | -0.018 | 0.018 | 0.001 |
| 305-07-003 | BENC | END | 29.951 | -8.385 | 93.000 | 4.712 | 24.000 | 0.968 | 3.000 | 90.000 | -0.015 | 0.006 | 0.001 |
| 305-07-002 | TGNT | END | 32.878 | -7.726 | 96.000 | 28.250 | 24.000 | 0.968 | | | -0.014 | 0.004 | -0.000 |
| 300-07-001 | ANKR | END | 32.878 | -7.726 | 124.250 | | 24.000 | 0.968 | | | -0.000 | -0. | -0. |
| 290-06-019 | RSNT | BINP | 38.266 | -8.750 | 70.016 | | | | | | 0.002 | -0.126 | 0.000 |
| 290-06-018 | TGNT | END | 38.266 | -8.750 | 70.016 | 6.500 | 24.000 | 0.968 | | | 0.002 | -0.126 | 0.000 |
| 285-06-017 | TGNT | END | 31.766 | -8.750 | 70.016 | 2.500 | 30.000 | 9.000 | | | 0.002 | -0.111 | 0.009 |
| 280-06-016 | RSNT | END | 31.766 | -8.750 | 67.516 | | | | | | -0.001 | -0.000 | 0.009 |
| 280-06-015 | TGNT | END | 31.766 | -8.750 | 67.516 | 2.500 | 30.000 | 9.000 | | | -0.001 | -0.000 | 0.009 |
| 275-06-014 | TGNT | END | 31.766 | -8.750 | 70.016 | 5.250 | 24.000 | 0.968 | | | 0.002 | -0.110 | 0.009 |
| 270-06-013 | TGNT | END | 26.516 | -8.750 | 70.016 | 2.500 | 30.000 | 9.000 | | | 0.002 | -0.103 | 0.015 |
| 266-06-012 | RSNT | END | 26.516 | -8.750 | 67.516 | | | | | | -0.000 | -0.000 | 0.015 |
| 265-06-011 | RSNT | END | 26.516 | -8.750 | 67.516 | | | | | | -0.000 | -0.000 | 0.015 |
| 265-06-010 | TGNT | END | 26.516 | -8.750 | 67.516 | 2.500 | 30.000 | 9.000 | | | -0.000 | -0.000 | 0.015 |
| 260-06-009 | TGNT | END | 26.516 | -8.750 | 70.016 | 10.500 | 24.000 | 0.968 | | | 0.002 | -0.103 | 0.015 |
| 255-06-008 | TGNT | END | 16.016 | -8.750 | 70.016 | 2.500 | 30.000 | 9.000 | | | 0.002 | -0.084 | 0.027 |
| 250-06-007 | RSNT | END | 16.016 | -8.750 | 67.516 | | | | | | -0.002 | -0.000 | 0.027 |
| 250-06-006 | TGNT | END | 16.016 | -8.750 | 67.516 | 2.500 | 30.000 | 9.000 | | | -0.002 | -0.000 | 0.027 |
| 245-06-005 | TGNT | END | 16.016 | -8.750 | 70.016 | 6.257 | 24.000 | 0.968 | | | 0.002 | -0.083 | 0.027 |

Also Available On Aperture Card

II APERTURE CARD

DATE 00010'UCO TIME 2514 HRS.

MAIN STEAM SPHERE TO TURBINE Y-ACC 1.67G 4/26/65

PROBLEM NO. 011

| ELEMENT ID | ELEM TYPE | ELEM PGNT | ROTATIONS, RADIANS | | | RSNT LOAD | FORCES, LBS. | | | MOMENTS, FT.-LBS. | | | STRESS SE, PSI |
|------------|-----------|-----------|--------------------|----------|----------|-----------|--------------|--------|-------|-------------------|--------|---------|----------------|
| | | | PHI X | PHI Y | PHI Z | | FX | FY | FZ | MX | MY | MZ | |
| 330-07-010 | TGNT | BINP | 0.00008 | -0.00001 | 0.00011 | | 5249. | -5557. | 238. | 46595. | 32085. | 2445. | 1753. |
| 327-07-009 | RSNT | END | -0.00011 | -0.00012 | 0.00008 | 296. | 148. | -0. | -256. | 0. | 0. | 0. | |
| 326-07-008 | RSNT | END | -0.00011 | -0.00012 | 0.00008 | 8613. | 0. | 8613. | 0. | 0. | 0. | 0. | |
| 325-07-007 | RSNT | END | -0.00011 | -0.00012 | 0.00008 | -5584. | -5584. | -0. | -0. | 0. | 0. | 0. | |
| 325-07-006 | TGNT | END | -0.00011 | -0.00012 | 0.00008 | | -187. | 83. | -18. | -2710. | -4661. | 2445. | 183. |
| 320-07-005 | BEND | END | -0.00007 | -0.00006 | 0.00002 | | -187. | 83. | -18. | -1345. | -1578. | 2445. | 160. |
| 320-07-004 | TGNT | END | -0.00003 | -0.00002 | -0.00003 | | -187. | 83. | -18. | -1085. | -1071. | 2080. | 157. |
| 305-07-003 | BEND | END | 0.00001 | 0.00001 | -0.00005 | | -187. | 83. | -18. | -994. | -1472. | -668. | 102. |
| 305-07-002 | TGNT | END | 0.00001 | 0.00005 | -0.00004 | | -187. | 83. | -18. | -734. | -965. | -1034. | 88. |
| 300-07-001 | ANKR | END | -0. | -0. | -0. | | -187. | 83. | -18. | 1603. | 4314. | -1034. | 146. |
| 250-06-019 | RSNT | BINP | 0.00369 | 0.00012 | -0.00022 | 617. | 0. | 0. | -617. | 0. | 0. | 0. | |
| 250-06-018 | TGNT | END | 0.00369 | 0.00012 | -0.00022 | | 0. | 0. | -617. | 0. | 0. | -0. | 0. |
| 285-06-017 | TGNT | END | 0.00369 | 0.00011 | -0.00017 | | 0. | -6096. | -617. | 0. | 4011. | -19814. | 94. |
| 280-06-016 | RSNT | END | 0.00368 | 0.00011 | -0.00016 | 12819. | 0. | 12819. | 0. | 0. | 0. | 0. | |
| 280-06-015 | TGNT | END | 0.00368 | 0.00011 | -0.00016 | | -0. | 6722. | -617. | 15241. | 4011. | -19814. | 118. |
| 275-06-014 | TGNT | END | 0.00368 | 0.00011 | -0.00015 | | -0. | 6722. | -617. | 32047. | 4011. | -19814. | 1173. |
| 270-06-013 | TGNT | END | 0.00343 | 0.00007 | -0.00011 | | -0. | 1146. | -617. | 32047. | 7250. | 842. | 153. |
| 266-06-012 | RSNT | END | 0.00342 | 0.00007 | -0.00011 | 3217. | 0. | 3217. | 0. | 0. | 0. | 0. | |
| 265-06-011 | RSNT | END | 0.00342 | 0.00007 | -0.00011 | -5631. | 5631. | -0. | -0. | 0. | 0. | 0. | |
| 265-06-010 | TGNT | END | 0.00342 | 0.00007 | -0.00011 | | 5631. | 4363. | -617. | 29182. | 7250. | 842. | 140. |
| 260-06-009 | TGNT | END | 0.00341 | 0.00007 | -0.00011 | | 5631. | 4363. | -617. | 40090. | -6827. | 842. | 1259. |
| 255-06-008 | TGNT | END | 0.00280 | 0.00011 | -0.00016 | | 5631. | -6789. | -617. | 40090. | -348. | -11892. | 194. |
| 250-06-007 | RSNT | END | 0.00279 | 0.00011 | -0.00015 | 12137. | 0. | 12137. | 0. | 0. | 0. | 0. | |
| 250-06-006 | TGNT | END | 0.00279 | 0.00011 | -0.00015 | | 5631. | 5348. | -617. | 57062. | 13729. | -11892. | 278. |
| 245-06-005 | TGNT | END | 0.00277 | 0.00011 | -0.00015 | | 5631. | 5348. | -617. | 70432. | -348. | -11892. | 2211. |

Also Available On Aperture Card

TI APERTURE CARD

| ELEMENT CRD-BR-ELM | IC TYPE | ELEM PCNT | ELEM END | ELEMENT POINT COORDINATES | | | LENGTH FT. | DIAM IN. | THCK IN. | RADIUS FT. | THETA DEG | DISPLACEMENTS, INCHES | | |
|-----------------------|------------|--------------|-------------|---------------------------|---------|--------|---------------|-------------|-------------|---------------|--------------|-----------------------|---------|---------|
| | | | | X, FT. | Y, FT. | Z, FT. | | | | | | DELTA X | DELTA Y | DELTA Z |
| 240-06-004 | BENC | END | | 9.759 | -8.750 | 70.016 | 2.356 | 24.000 | 0.968 | 3.000 | 45.000 | 0.001 | -0.073 | 0.035 |
| 240-06-003 | TGNT | END | | 7.637 | -8.750 | 69.137 | 0.730 | 24.000 | 0.968 | | | 0.001 | -0.048 | 0.037 |
| 235-06-002 | BEND | END | | 7.121 | -8.750 | 68.621 | 4.712 | 24.000 | 0.968 | 3.000 | 90.000 | 0.001 | -0.036 | 0.037 |
| 235-06-001 | TGNT | END | | 5.000 | -11.750 | 66.500 | 2.250 | 24.000 | 0.968 | | | 0.005 | -0.004 | 0.004 |
| 235-06-001 | TGNT | BGIN | | 5.000 | -14.000 | 66.500 | 2.250 | 24.000 | 0.968 | | | 0.007 | -0.004 | 0.000 |
| 120-05-008 | TGNT | BINP | | 5.000 | -14.000 | 66.500 | 23.330 | 24.000 | 0.968 | | | 0.007 | -0.004 | 0.000 |
| 105-05-007 | RSNT | END | | 5.000 | -14.000 | 43.170 | | | | | | 0.000 | -0.000 | 0.000 |
| 85-05-006 | RSNT | END | | 5.000 | -14.000 | 43.170 | | | | | | 0.000 | -0.000 | 0.000 |
| 85-05-005 | TGNT | END | | 5.000 | -14.000 | 43.170 | 1.500 | 24.000 | 0.968 | | | 0.000 | -0.000 | 0.000 |
| 80-05-004 | TGNT | ENC | | 5.000 | -14.000 | 41.670 | 1.000 | 30.000 | 9.000 | | | -0.000 | -0.003 | 0.000 |
| 77-05-003 | CMPT | END | | 4.000 | -14.000 | 41.670 | 4.500 | | | | | -0.000 | -0.010 | 0.000 |
| 76-05-002 | TGNT | ENC | | 4.000 | -14.000 | 37.170 | 1.000 | 30.000 | 9.000 | | | -0.001 | -0.020 | 0.000 |
| 75-05-001 | TGNT | ENC | | 5.000 | -14.000 | 37.170 | 11.000 | 24.000 | 0.968 | | | -0.001 | -0.014 | 0.000 |
| 75-05-001 | TGNT | BGIN | | 5.000 | -14.000 | 26.170 | 11.000 | 24.000 | 0.968 | | | -0.002 | -0.015 | 0.000 |
| 72-04-003 | RSNT | BINP | | -25.000 | -14.000 | 18.920 | | | | | | -0.000 | -0.000 | -0.000 |
| 71-04-002 | RSNT | END | | -25.000 | -14.000 | 18.920 | | | | | | -0.000 | -0.000 | -0.000 |
| 71-04-001 | TGNT | ENC | | -25.000 | -14.000 | 18.920 | 7.250 | 24.000 | 0.812 | | | -0.000 | -0.000 | -0.000 |
| 71-04-001 | TGNT | BGIN | | -25.000 | -14.000 | 26.170 | 7.250 | 24.000 | 0.812 | | | -0.002 | -0.018 | -0.000 |
| 70-03-002 | TGNT | BINP | | -25.000 | -14.000 | 26.170 | 17.000 | 24.000 | 0.968 | | | -0.002 | -0.018 | -0.000 |
| 65-03-001 | ANKR | END | | -25.000 | -14.000 | 43.170 | | 24.000 | 0.968 | | | -0.000 | -0. | -0. |
| 60-02-001 | TGNT | BINP | | -25.000 | -14.000 | 26.170 | 30.000 | 20.000 | 0.812 | | | -0.002 | -0.018 | -0.000 |
| 60-02-001 | TGNT | BGIN | | 5.000 | -14.000 | 26.170 | 30.000 | 20.000 | 0.812 | | | -0.002 | -0.015 | 0.000 |
| 45-01-009 | TGNT | BINP | | 5.000 | -14.000 | 26.170 | 7.250 | 24.000 | 0.968 | | | -0.002 | -0.015 | 0.000 |
| 40-01-008 | RSNT | END | | 5.000 | -14.000 | 18.920 | | | | | | 0.000 | -0.000 | 0.000 |
| 20-01-007 | RSNT | END | | 5.000 | -14.000 | 18.920 | | | | | | 0.000 | -0.000 | 0.000 |

TI
APERTURE
CARD

Also Available On
Aperture Card

47

RUN NO. 0 PIPING FLEXIBILITY ANALYSIS PROGRAM MEC-21/7094 PAGE 8 OF 10
** WEIGHT LOADING EFFECTS **

DATE 00010'U00 TIME 2514 HRS. MAIN STEAM SPHERE TO TURBINE Y-ACC 1.67G 4/26/65 PROBLEM NO. 011

| ELEMENT | IC | ELEM | ELEM | ROTATIONS, RADIANS | | | RSNT | FORCES, LBS. | | | MOMENTS, FT.-LBS. | | | STRESS |
|------------|------|------|----------|--------------------|----------|--------|---------|--------------|---------|--------|-------------------|-------|----|--------|
| | | | | CRD-BR-ELM | TYPE | PCNT | | PHI X | PHI Y | PHI Z | LOAD | FX | FY | |
| 240-06-004 | BEND | END | 0.00213 | 0.00010 | -0.00016 | 5631. | 2690. | -617. | 70432. | 3513. | 13254. | 2370. | | |
| 240-06-003 | TGNT | END | 0.00180 | 0.00000 | -0.00010 | 5631. | 1689. | -617. | 68648. | 9770. | 17956. | 3155. | | |
| 235-06-002 | BEND | ENC | 0.00173 | -0.00001 | -0.00012 | 5631. | 1379. | -617. | 67857. | 12994. | 18748. | 3151. | | |
| 235-06-001 | TGNT | END | 0.00024 | 0.00007 | 0.00010 | 5631. | -623. | -617. | 64624. | 26248. | 3236. | 4468. | | |
| 235-06-001 | TGNT | BGIN | 0.00008 | -0.00001 | 0.00011 | 5631. | -1579. | -617. | 63236. | 26248. | -9434. | 2139. | | |
| 120-05-008 | TGNT | BINP | 0.00008 | -0.00001 | 0.00011 | 382. | 3978. | -855. | 16641. | -5837. | -11879. | 658. | | |
| 105-05-007 | RSNT | END | -0.00015 | 0.00003 | 0.00051 | 13799. | 9758. | 9758. | 0. | 0. | 0. | 0. | | |
| 85-05-006 | RSNT | END | -0.00015 | 0.00003 | 0.00051 | 16988. | -10223. | 13568. | 0. | 0. | 0. | 0. | | |
| 85-05-005 | TGNT | END | -0.00015 | 0.00003 | 0.00051 | -84. | 17393. | -855. | 39445. | 3066. | -11879. | 1279. | | |
| 80-05-004 | TGNT | END | -0.00019 | 0.00002 | 0.00053 | -84. | 16756. | -855. | 13833. | 2939. | -11879. | 86. | | |
| 77-05-003 | CMPT | END | -0.00020 | 0.00002 | 0.00053 | -84. | 16756. | -855. | 13833. | 3794. | 4876. | 0. | | |
| 76-05-002 | TGNT | END | -0.00020 | 0.00002 | 0.00053 | -84. | 1733. | -855. | -27765. | 3416. | 4876. | 132. | | |
| 75-05-001 | TGNT | END | -0.00019 | 0.00002 | 0.00053 | -84. | 1733. | -855. | -27765. | 2561. | 3144. | 868. | | |
| 75-05-001 | TGNT | BGIN | 0.00016 | -0.00001 | 0.00048 | -84. | -2940. | -855. | -21126. | 1635. | 3144. | 663. | | |
| 72-04-003 | RSNT | BINP | 0.00027 | -0.00003 | -0.00036 | 667. | 667. | 0. | 0. | 0. | 0. | 0. | | |
| 71-04-002 | RSNT | END | 0.00027 | -0.00003 | -0.00036 | 6482. | 0. | 6482. | 0. | 0. | 0. | 0. | | |
| 71-04-001 | TGNT | END | 0.00027 | -0.00003 | -0.00036 | 667. | 6482. | -0. | 0. | -0. | -0. | 0. | | |
| 71-04-001 | TGNT | BGIN | 0.00009 | -0.00001 | -0.00036 | 667. | 3403. | -0. | 35833. | -4837. | -0. | 1308. | | |
| 70-03-002 | TGNT | BINP | 0.00009 | -0.00001 | -0.00036 | -468. | -1358. | -34. | 36641. | -4324. | -14636. | 1228. | | |
| 65-03-001 | ANKR | END | -0. | -0. | -0. | -468. | -8579. | -34. | -47823. | 3633. | -14636. | 1552. | | |
| 60-02-001 | TGNT | BINP | 0.00009 | -0.00001 | -0.00036 | 1135. | 4760. | 34. | -808. | -514. | 14636. | 780. | | |
| 60-02-001 | TGNT | BGIN | 0.00016 | -0.00001 | 0.00048 | 1135. | -4139. | 34. | -808. | 510. | 5315. | 287. | | |
| 45-01-009 | TGNT | BINP | 0.00016 | -0.00001 | 0.00048 | 1051. | -7077. | -821. | -21926. | 2142. | 8458. | 730. | | |
| 40-01-008 | RSNT | END | 0.00010 | -0.00005 | 0.00039 | 9401. | 6648. | 6648. | 0. | 0. | 0. | 0. | | |
| 20-01-007 | RSNT | END | 0.00010 | -0.00005 | 0.00039 | 16005. | -9632. | 12783. | 0. | 0. | 0. | 0. | | |

THE APERTURE CARD

Also Available On Aperture Card

8504040294-43

48

RUN NO. 0

PIPING FLEXIBILITY ANALYSIS PROGRAM MEC-21/7094
** WEIGHT LOADING EFFECTS **

PAGE 9 OF 10

DATE 0010'UCO TIME 2514 HRS.

MAIN STEAM SPHERE TO TURBINE Y-ACC 1.67G 4/26/65

PROBLEM NO. 011

| ELEMENT ID CRD-BR-ELM | ELEM TYPE | ELEM PCNT | ELEMENT POINT COORDINATES | | | LENGTH FT. | DIAM IN. | THCK IN. | RADIUS FT. | THETA DEG | DISPLACEMENTS, INCHES | | |
|--------------------------|-----------|-----------|---------------------------|---------|--------|---------------|-------------|-------------|---------------|--------------|-----------------------|---------|---------|
| | | | X, FT. | Y, FT. | Z, FT. | | | | | | DELTA X | DELTA Y | DELTA Z |
| 20-01-006 | TGNT | END | 5.000 | -14.000 | 18.920 | 3.250 | 24.000 | 0.968 | | | 0.000 | -0.000 | 0.000 |
| 15-01-005 | BEND | END | 5.000 | -14.000 | 15.670 | 4.712 | 24.000 | 0.968 | 3.000 | 90.000 | 0.003 | 0.002 | 0.000 |
| 15-01-004 | TGNT | END | 3.991 | -11.175 | 12.670 | 8.866 | 24.000 | 0.968 | | | -0.002 | -0.003 | -0.002 |
| 10-01-003 | BEND | END | 1.009 | -2.825 | 12.670 | 4.712 | 24.000 | 0.968 | 3.000 | 90.000 | -0.015 | -0.008 | -0.001 |
| 10-01-002 | TGNT | END | -0. | -0. | 9.670 | 9.670 | 24.000 | 0.968 | | | -0.010 | -0.006 | -0.000 |
| 5-01-001 | ANKR | END | -0. | -0. | -0. | | 24.000 | 0.968 | | | -0.000 | -0. | -0. |

II
APERTURE
CARD

Also Available On
Aperture Card

8504040294-44

RUN NO. 0

PIPING FLEXIBILITY ANALYSIS PROGRAM MEC-21/7094
** WEIGHT LOADING EFFECTS **

PAGE 10 OF 10

DATE 00C10'U00 TIME 2514 HRS.

MAIN STEAM SPHERE TO TURBINE Y-ACC 1.67G 4/26/65

PROBLEM NO. 011

| ELEMENT ID | ELEM TYPE | ELEM POINT | ROTATIONS, RADIANS | | | RSNT LOAD | FORCES, LBS. | | | MOMENTS, FT.-LBS. | | | STRESS SE, PSI |
|------------|-----------|------------|--------------------|----------|---------|-----------|--------------|-------|--------|-------------------|-------|-------|----------------|
| | | | PHI X | PHI Y | PHI Z | | FX | FY | FZ | MX | MY | MZ | |
| 20-01-006 | TGNT | END | 0.00010 | -0.00005 | 0.00039 | -1933. | 9273. | -821. | 40549. | 9761. | 8458. | 1317. | |
| 15-01-005 | BENC | END | 0.00001 | -0.00008 | 0.00036 | -1933. | 7893. | -821. | 12655. | 3477. | 8458. | 929. | |
| 15-01-004 | TGNT | END | 0.00004 | -0.00014 | 0.00017 | -1933. | 5891. | -821. | -6521. | -1494. | 9674. | 797. | |
| 10-01-003 | BENC | END | 0.00008 | -0.00014 | 0.00009 | -1933. | 2124. | -821. | 335. | 955. | 5483. | 376. | |
| 10-01-002 | TGNT | END | 0.00007 | -0.00014 | 0.00022 | -1933. | 123. | -821. | 104. | -4017. | 1430. | 276. | |
| 5-01-001 | ANKR | END | -0. | -0. | -0. | -1933. | -3985. | -821. | 18780. | -22712. | 1430. | 913. | |

END, EXECUTION TIME 1.69 MINUTES.

TI
APERTURE
CARD

Also Available On
Aperture Card

8504040294-45

2516 BEGIN PROBLEM 012

*****THE INITIAL LOAD SPECIFIED FOR THE RIGID RESTRAINT AT DATA POINT 20 HAS BEEN RESET TO ZERO.
TO INCLUDE AN INITIAL LOAD, SPECIFY A FLEXIBLE RESTRAINT.

*****THE INITIAL LOAD SPECIFIED FOR THE RIGID RESTRAINT AT DATA POINT 40 HAS BEEN RESET TO ZERO.
TO INCLUDE AN INITIAL LOAD, SPECIFY A FLEXIBLE RESTRAINT.

*****THE INITIAL LOAD SPECIFIED FOR THE RIGID RESTRAINT AT DATA POINT 71 HAS BEEN RESET TO ZERO.
TO INCLUDE AN INITIAL LOAD, SPECIFY A FLEXIBLE RESTRAINT.

*****THE INITIAL LOAD SPECIFIED FOR THE RIGID RESTRAINT AT DATA POINT 72 HAS BEEN RESET TO ZERO.
TO INCLUDE AN INITIAL LOAD, SPECIFY A FLEXIBLE RESTRAINT.

*****THE INITIAL LOAD SPECIFIED FOR THE RIGID RESTRAINT AT DATA POINT 85 HAS BEEN RESET TO ZERO.
TO INCLUDE AN INITIAL LOAD, SPECIFY A FLEXIBLE RESTRAINT.

*****THE INITIAL LOAD SPECIFIED FOR THE RIGID RESTRAINT AT DATA POINT 105 HAS BEEN RESET TO ZERO.
TO INCLUDE AN INITIAL LOAD, SPECIFY A FLEXIBLE RESTRAINT.

*****THE INITIAL LOAD SPECIFIED FOR THE RIGID RESTRAINT AT DATA POINT 250 HAS BEEN RESET TO ZERO.
TO INCLUDE AN INITIAL LOAD, SPECIFY A FLEXIBLE RESTRAINT.

*****THE INITIAL LOAD SPECIFIED FOR THE RIGID RESTRAINT AT DATA POINT 265 HAS BEEN RESET TO ZERO.
TO INCLUDE AN INITIAL LOAD, SPECIFY A FLEXIBLE RESTRAINT.

*****THE INITIAL LOAD SPECIFIED FOR THE RIGID RESTRAINT AT DATA POINT 266 HAS BEEN RESET TO ZERO.
TO INCLUDE AN INITIAL LOAD, SPECIFY A FLEXIBLE RESTRAINT.

*****THE INITIAL LOAD SPECIFIED FOR THE RIGID RESTRAINT AT DATA POINT 280 HAS BEEN RESET TO ZERO.
TO INCLUDE AN INITIAL LOAD, SPECIFY A FLEXIBLE RESTRAINT.

*****THE INITIAL LOAD SPECIFIED FOR THE RIGID RESTRAINT AT DATA POINT 290 HAS BEEN RESET TO ZERO.
TO INCLUDE AN INITIAL LOAD, SPECIFY A FLEXIBLE RESTRAINT.

*****THE INITIAL LOAD SPECIFIED FOR THE RIGID RESTRAINT AT DATA POINT 325 HAS BEEN RESET TO ZERO.
TO INCLUDE AN INITIAL LOAD, SPECIFY A FLEXIBLE RESTRAINT.

*****THE INITIAL LOAD SPECIFIED FOR THE RIGID RESTRAINT AT DATA POINT 326 HAS BEEN RESET TO ZERO.
TO INCLUDE AN INITIAL LOAD, SPECIFY A FLEXIBLE RESTRAINT.

*****THE INITIAL LOAD SPECIFIED FOR THE RIGID RESTRAINT AT DATA POINT 327 HAS BEEN RESET TO ZERO.
TO INCLUDE AN INITIAL LOAD, SPECIFY A FLEXIBLE RESTRAINT.

CONTROL ENTERED BLKFC8.
CONTROL ENTERED BLKF08.
CONTROL ENTERED BLKF08.
CONTROL ENTERED BLKF08.
CONTROL ENTERED BLKFC8.
CONTROL ENTERED BLKF12.

TH
PERTURBE
CARD

MAIN STEAM SPHERE TO TURBINE Z-ACC 1.0G 4/27/65 PROBLEM NO. 012
PROJECT NO. 3246 DATE 00010'U00
GROUP 0000 TIME 2516 HRS.

SUMMATION OF THE REACTIONS ON THE STRUCTURE

| FX, LBS. | FY, LBS. | FZ, LBS. | MX, FT.-LBS. | MY, FT.-LBS. | MZ, FT.-LBS. |
|----------|----------|----------|--------------|--------------|--------------|
| 2. | 1. | -58985. | 668885. | 311977. | 34. |

SUMMATION OF THE WEIGHT AND UNIFORM LOADING EFFECTS

| FX, LBS. | FY, LBS. | FZ, LBS. | MX, FT.-LBS. | MY, FT.-LBS. | MZ, FT.-LBS. |
|----------|----------|----------|--------------|--------------|--------------|
| 0. | 0. | -58990. | 668977. | 311927. | 0. |

CENTER-OF-FORCES COORDINATES

CENTER-OF-GRAVITY COORDINATES

| X, FT. | Y, FT. | Z, FT. | X, FT. | Y, FT. | Z, FT. |
|--------|--------|--------|--------|--------|--------|
| 5.3 | -11.3 | 0. | 5.3 | -0. | 0. |

SUMMATION OF THE REACTIONS AT THE BRANCH-INTERSECTION-POINTS

| BINP. NO. | FX, LBS. | FY, LBS. | FZ, LBS. | MX, FT.-LBS. | MY, FT.-LBS. | MZ, FT.-LBS. |
|-----------|----------|----------|----------|--------------|--------------|--------------|
| LINP 1 | 2. | 1. | 4. | -7. | 17. | -0. |
| LINP 2 | -0. | 0. | 0. | 0. | -0. | -0. |
| LINP 3 | 0. | -0. | -0. | 0. | 0. | -0. |
| LINP 4 | -0. | -0. | 0. | 0. | -0. | 0. |
| LINP 5 | 0. | -0. | 0. | -0. | 0. | 0. |

TI
APERTURE
CARD

Also Available On
Aperture Card

DATE 000000U00 TIME 2516 HRS.

MAIN STEAM SPHERE TO TURBINE Z-ACC 1.0G 4/27/65

PROBLEM NO. 012

TYPE ONE CARDS

| CNO | ART | TCTO | BRFR | DATA | PT | COORDINATES | DIAM | THCK | RAD | SPECIAL | COORDINATES | P | DIAGNOSTIC NOTES |
|-----|-----|------|------|--------|----|--|------|------|-----|---------|----------------------------------|---|-------------------|
| | | | | | | XFT / YFT / ZFT / V / VV / VFT / VXFT / YFT / ZFT / VV | | | | | | | |
| 51 | | | | 0101 | | | | | | | 240000968 | | ZERO COORDINATES. |
| 10 | 1 | | | | | | | | | | +01267024000096803 | | |
| 15 | 1 | | | | | | | | | | +005000-014000+01267024000096803 | | |
| 20 | 2 | 1 | | | | | | | | | +005000-014000+018920240000968 | | |
| 40 | 2 | 1 | | | | | | | | | | | |
| 45 | 1 | | | | | | | | | | +005000-014000+026170240000968 | | |
| 60 | 1 | | | C20201 | | | | | | | -025000-014000+026170240000968 | | |
| 65 | 1 | | | C203 | | | | | | | -025000-014000+043170240000968 | | |
| 70 | 1 | | | | | | | | | | -025000-014000+026170240000968 | | |
| 71 | 2 | 1 | | 030402 | | | | | | | -025000-014000+018920240000968 | | |
| 72 | 2 | 1 | | | | | | | | | | | |
| 75 | 1 | | | 040501 | | | | | | | +005000-014000+037170240000968 | | |
| 76 | 1 | | | | | | | | | | +004000-014000+037170300009 | | |
| 77 | 3 | | | | | | | | | | +004000-014000+041670 | | |

TYPE TWO CARDS

| CNO | CMPT | DATA | CR | ANCHOR | RESTRAINT | FLEX | C | CG-R | STR | LOC-A | COS | CR |
|-----|------|------|----|--------|-----------|------|----|--------|-------|-------|-----|----|
| | | | | E/ | E/ | E/ | E/ | EX / / | Y / / | Z / / | VV | |
| 5 | | | | | | | | | | | | |
| 10 | | | | | | | | | | | | |
| 15 | | | | | | | | | | | | |
| 20 | | | | | | | | | | | | |
| 40 | | | | | | | | | | | | |
| 45 | | | | | | | | | | | | |
| 60 | | | | | | | | | | | | |
| 65 | | | | | | | | | | | | |
| 70 | | | | | | | | | | | | |
| 71 | | | | | | | | | | | | |
| 72 | | | | | | | | | | | | |
| 75 | | | | | | | | | | | | |
| 76 | | | | | | | | | | | | |
| 77 | | | | | | | | | | | | |

TYPE THREE CARDS

| CNO | EXPAN | E | MU | LOAD | RHO | PSI | ULOAD | F | COS | ANK | DELTA | ANK | ROT | RSNT | MOVE |
|-----|-------|---|------|------|---------|-----|-------|-----|-----|-------|-------|-------|-----|------|------|
| | | | | | | | | | | | | | | | |
| | | V | VV | VV | VV / VV | V / | VX / | Y / | Z / | X / / | Y / / | Z / / | | | |
| 5 | | | | | | | | | | | | | | | |
| 10 | | | 2793 | | | | 21202 | | | | | | -1 | | |
| 15 | | | 2793 | | | | 21202 | | | | | | -1 | | |
| 20 | | | 2793 | | | | 21202 | | | | | | -1 | | |
| 40 | | | | | | | | | | | | | | | |
| 45 | | | 2793 | | | | 21202 | | | | | | -1 | | |
| 60 | | | 2793 | | | | 14802 | | | | | | -1 | | |
| 65 | | | | | | | | | | | | | | | |
| 70 | | | 2793 | | | | 21202 | | | | | | -1 | | |
| 71 | | | 2793 | | | | 21202 | | | | | | -1 | | |
| 72 | | | | | | | | | | | | | | | |
| 75 | | | 2793 | | | | 21202 | | | | | | -1 | | |
| 76 | | | 2793 | | | | | | | | | | | | |
| 77 | | | 2793 | | | | 16663 | | | | | | -1 | | |

TI
APERTURE
CARD

Also Available On
Aperture Card

RLN NO. 0

PIPING FLEXIBILITY ANALYSIS PROGRAM MEC-21/7094
** DATA CARD DISPLAY WITH DIAGNOSTIC NOTES **

PAGE 3 OF 10

CATE 00C)C'U00 TIME 2516 HRS.

MAIN STEAM SPHERE TO TURBINE Z-ACC 1.0G 4/27/65

PROBLEM NO. 012

TYPE ONE CARDS

| CNO | ARTTCTOBRFR | DATA | PT | COORDINATES | DIAM | THCK | RAD | SPECIAL | COORDINATES | P | DIAGNOSTIC | NOTES |
|-----|-------------|--------|----|--|------|------|-----|---------|-------------|---|------------|-------|
| | | | | XFT / YFT / ZFT / V / VV/ VFT/ VXFT / YFT / ZFT / VV | | | | | | | | |
| 80 | 1 | | | +005000-014000+04167030009 | | | | | | | | |
| 85 | 2 | 1 | | +005000-014000+043170240000968 | | | | | | | | |
| 105 | 2 | 1 | | | | | | | | | | |
| 120 | 1 | | | +005000-014000+066500240000968 | | | | | | | | |
| 235 | 1 | 050604 | | +005000-008750+06650024000096803 | | | | | | | | |
| 240 | 1 | | | +008516-008750+07001624000096803 | | | | | | | | |
| 245 | 1 | | | +016016-008750+070016240000968 | | | | | | | | |
| 250 | 1 | 1 | | +016016-008750+067516300009000 | | | | | | | | |
| 255 | 1 | | | +016016-008750+070016300009000 | | | | | | | | |
| 260 | 1 | | | +026516-008750+070016240000968 | | | | | | | | |
| 265 | 2 | 1 | | +026516-008750+067516300009 | | | | | | | | |
| 266 | 2 | 1 | | | | | | | | | | |
| 270 | 1 | | | +026516-008750+070016300009 | | | | | | | | |
| 275 | 1 | | | +031766-008750+070016240000968 | | | | | | | | |

TYPE TWO CARDS

| CNO | CMPT | DATA | CR | ANCHOR | RESTRAINT | FLEX | C | CG-R | STR | LOC-A | COS | CR |
|-----|------|------|----|--------|-----------|------|----|--------|-------|-------|-----|-------------------------|
| | | | | E/ | E/ | E/ | E/ | EX / / | Y / / | Z / / | VV | |
| 80 | | | | | | | | | | | | |
| 85 | | | | | | | | | | | | +000186-007611+043170 1 |
| 105 | | | | | | | | | | | | +010657-008343+043170 1 |
| 120 | | | | | | | | | | | | |
| 235 | | | | | | | | | | | | |
| 240 | | | | | | | | | | | | |
| 245 | | | | | | | | | | | | |
| 250 | | | | | | | | | | | | +016016+010000+067516 1 |
| 255 | | | | | | | | | | | | |
| 260 | | | | | | | | | | | | |
| 265 | | | | | | | | | | | | +010000-008750+067516 1 |
| 266 | | | | | | | | | | | | +026516+010000+067516 1 |
| 270 | | | | | | | | | | | | |
| 275 | | | | | | | | | | | | |

TYPE THREE CARDS

| CNO | EXPAN | E | MU | LOAD | RHO | PSI | ULOAD | F | COS | ANK | DELTA | ANK | ROT | RSNT | MOVE |
|-----|-------|---|----|-------------|---------|-----|-------|-----|-----|-------|-------|-------|-----|------|------|
| | | | | V / VV / VV | VV / VV | V / | VX / | Y / | Z / | X / / | Y / / | Z / / | | | |
| 80 | | | | 2793 | | | | | | | | | | | |
| 85 | | | | 2793 | | | 21202 | | | | | | -1 | | |
| 105 | | | | | | | | | | | | | | | |
| 120 | | | | 2793 | | | 21202 | | | | | | -1 | | |
| 235 | | | | 2793 | | | 21202 | | | | | | -1 | | |
| 240 | | | | 2793 | | | 21202 | | | | | | -1 | | |
| 245 | | | | 2793 | | | 21202 | | | | | | -1 | | |
| 250 | | | | 2793 | | | | | | | | | | | |
| 255 | | | | 2793 | | | | | | | | | | | |
| 260 | | | | 2793 | | | 53002 | | | | | | -1 | | |
| 265 | | | | 2793 | | | | | | | | | | | |
| 266 | | | | | | | | | | | | | | | |
| 270 | | | | 2793 | | | | | | | | | | | |
| 275 | | | | 2793 | | | 53002 | | | | | | -1 | | |

APERTURE CARD

Also Available On Aperture Card

8504040294-49

DATE 00010'UCO TIME 2516 HRS.

MAIN STEAM SPHERE TO TURBINE Z-ACC 1.0G 4/27/65

PROBLEM NO. 012

TYPE ONE CARDS

CNOARTTCTOBRFR DATA PT COORDINATES DIAM THCK RAD SPECIAL COORDINATES P DIAGNOSTIC NOTES

XFT / YFT / ZFT / V / VV / VFT / VXFT / YFT / ZFT / VV

| | | | | | | | | | | |
|------|---|------|--|--|--|--|--|--|----------------------------------|--|
| 280 | 1 | 1 | | | | | | | +031766-C08750+C67516300009 | |
| 285 | 1 | | | | | | | | +031766-C08750+070016300009 | |
| 290 | 1 | 1 | | | | | | | +038266-C08750+070016240000968 | |
| 3001 | | C4C7 | | | | | | | +032878-C07726+124250240000968 | |
| 305 | 1 | | | | | | | | +032878-C07726+09300024000096803 | |
| 320 | 1 | | | | | | | | +005000-014000+09300024000096803 | |
| 325 | 3 | 1 | | | | | | | +005000-014000+073500240000968 | |
| 326 | 3 | 1 | | | | | | | | |
| 327 | 3 | 1 | | | | | | | | |
| 330 | 1 | | | | | | | | +005000-014000+066500240000968 | |

TYPE TWO CARDS

CNO CMPT DATA OR ANCHOR, RESTRAINT FLEX C CG-R STR LOC-A COS CR

/ E/ E/ E/ E/ E/ EX // Y // Z // VV

| | | | | | | | | |
|-----|--|--|--|--|--|--|-----------------------|---|
| 280 | | | | | | | +031766+010000+C67516 | 1 |
| 285 | | | | | | | | |
| 290 | | | | | | | +038266-008750+06 | 1 |
| 300 | | | | | | | | |
| 305 | | | | | | | | |
| 320 | | | | | | | | |
| 325 | | | | | | | +010000-014000+0735 | 1 |
| 326 | | | | | | | +005000-010000+0735 | 1 |
| 327 | | | | | | | +009000-014000+066572 | 1 |
| 330 | | | | | | | | |

TYPE THREE CARDS

CNOEXPAN E MU LCAC RHC PSI ULOAD F COS, ANK DELTA ANK ROT, RSNT MOVE

/ V VV VV VV / VV V/ VX / Y / Z / X// Y// Z//

| | | | | | | | | | | | | | |
|-----|------|--|--|-------|--|--|----|--|--|--|--|--|--|
| 280 | 2793 | | | | | | | | | | | | |
| 285 | 2793 | | | | | | | | | | | | |
| 290 | 2793 | | | 46802 | | | -1 | | | | | | |
| 300 | | | | | | | | | | | | | |
| 305 | 2793 | | | | | | | | | | | | |
| 320 | 2793 | | | | | | | | | | | | |
| 325 | 2793 | | | | | | | | | | | | |
| 326 | | | | | | | | | | | | | |
| 327 | | | | | | | | | | | | | |
| 330 | 2793 | | | 21202 | | | -1 | | | | | | |

III
APERTURE
CARD

Also Available On
Aperture Card

55

RLN NO. C

PIPING FLEXIBILITY ANALYSIS PROGRAM MEC-21/7094
** WEIGHT LOADING EFFECTS **

PAGE 5 OF 10

DATE 00010'00 TIME 2516 HRS.

MAIN STEAM SPHERE TO TURBINE Z-ACC 1.0G 4/27/65

PROBLEM NO. 012

| ELEMENT ID | ELEM TYPE | ELEM PCNT | ELEMENT POINT COORDINATES | | | LENGTH FT. | DIAM IN. | THCK IN. | RADIUS FT. | THETA DEG | DISPLACEMENTS, INCHES | | |
|------------|-----------|-----------|---------------------------|---------|---------|------------|----------|----------|------------|-----------|-----------------------|---------|---------|
| | | | X, FT. | Y, FT. | Z, FT. | | | | | | DELTA X | DELTA Y | DELTA Z |
| 330-07-C10 | TGNT | BINP | 5.000 | -14.000 | 66.500 | 7.000 | 24.000 | 0.968 | | | -0.011 | -0.011 | -0.002 |
| 327-07-0C9 | RSNT | END | 5.000 | -14.000 | 73.500 | | | | | | -0.000 | 0.000 | -0.000 |
| 326-07-CC8 | RSNT | END | 5.000 | -14.000 | 73.500 | | | | | | -0.000 | 0.000 | -0.000 |
| 325-07-0C7 | RSNT | END | 5.000 | -14.000 | 73.500 | | | | | | -0.000 | 0.000 | -0.000 |
| 325-07-006 | TGNT | END | 5.000 | -14.000 | 73.500 | 16.500 | 24.000 | 0.968 | | | -0.000 | 0.000 | -0.000 |
| 320-07-CC5 | BENC | END | 5.000 | -14.000 | 90.000 | 4.712 | 24.000 | 0.968 | 3.000 | 90.000 | 0.018 | 0.014 | -0.000 |
| 320-07-CC4 | TGNT | END | 7.927 | -13.341 | 93.000 | 22.575 | 24.000 | 0.968 | | | 0.019 | 0.018 | -0.001 |
| 305-07-CC3 | BENC | END | 29.951 | -8.385 | 93.000 | 4.712 | 24.000 | 0.968 | 3.000 | 90.000 | 0.018 | 0.020 | -0.002 |
| 305-07-0C2 | TGNT | END | 32.878 | -7.726 | 96.000 | 28.250 | 24.000 | 0.968 | | | 0.017 | 0.017 | 0.000 |
| 300-07-CC1 | ANKR | END | 32.878 | -7.726 | 124.250 | | 24.000 | 0.968 | | | 0.000 | -0. | -0. |
| 290-06-019 | RSNT | BINP | 38.266 | -8.750 | 70.016 | | | | | | -0.010 | 0.017 | -0.000 |
| 290-06-018 | TGNT | END | 38.266 | -8.750 | 70.016 | 6.500 | 24.000 | 0.968 | | | -0.010 | 0.017 | -0.000 |
| 285-06-C17 | TGNT | END | 31.766 | -8.750 | 70.016 | 2.500 | 30.000 | 9.000 | | | -0.010 | 0.017 | -0.062 |
| 280-06-C16 | RSNT | END | 31.766 | -8.750 | 67.516 | | | | | | 0.010 | 0.000 | -0.062 |
| 280-06-015 | TGNT | END | 31.766 | -8.750 | 67.516 | 2.500 | 30.000 | 9.000 | | | 0.010 | 0.000 | -0.062 |
| 275-06-014 | TGNT | END | 31.766 | -8.750 | 70.016 | 5.250 | 24.000 | 0.968 | | | -0.009 | 0.017 | -0.062 |
| 270-06-C13 | TGNT | END | 26.516 | -8.750 | 70.016 | 2.500 | 30.000 | 9.000 | | | -0.009 | 0.016 | -0.093 |
| 266-06-C12 | RSNT | END | 26.516 | -8.750 | 67.516 | | | | | | 0.000 | -0.000 | -0.093 |
| 265-06-011 | RSNT | END | 26.516 | -8.750 | 67.516 | | | | | | 0.000 | -0.000 | -0.093 |
| 265-06-010 | TGNT | END | 26.516 | -8.750 | 67.516 | 2.500 | 30.000 | 9.000 | | | 0.000 | -0.000 | -0.093 |
| 260-06-009 | TGNT | END | 26.516 | -8.750 | 70.016 | 10.500 | 24.000 | 0.968 | | | -0.009 | 0.016 | -0.093 |
| 255-06-008 | TGNT | END | 16.016 | -8.750 | 70.016 | 2.500 | 30.000 | 9.000 | | | -0.008 | 0.017 | -0.086 |
| 250-06-007 | RSNT | END | 16.016 | -8.750 | 67.516 | | | | | | -0.019 | 0.000 | -0.086 |
| 250-06-006 | TGNT | END | 16.016 | -8.750 | 67.516 | 2.500 | 30.000 | 9.000 | | | -0.019 | 0.000 | -0.086 |
| 245-06-005 | TGNT | END | 16.016 | -8.750 | 70.016 | 6.257 | 24.000 | 0.968 | | | -0.008 | 0.017 | -0.086 |

TI
APERTURE
CARD

Also Available On
Aperture Card

8504040294-51

56

RLN NO. 0

PIPING FLEXIBILITY ANALYSIS PROGRAM MEC-21/7094
** WEIGHT LOADING EFFECTS **

PAGE 6 OF 10

DATE 00C10'U00 TIME 2516 HRS.

MAIN STEAM SPHERE TO TURBINE Z-ACC 1.0G 4/27/65

PROBLEM NO. 012

| ELEMENT | IC | ELEM | ELEM | ROTATIONS, RADIANS | | | RSNT | FORCES, LBS. | | | MOMENTS, FT.-LBS. | | | STRESS |
|------------|------|------|------|--------------------|----------|----------|---------|--------------|-------|---------|-------------------|---------|-------|--------|
| | | | | CRD-BR-ELM | TYPE | PCNT | | PHI X | PHI Y | PHI Z | LOAD | FX | FY | |
| 330-07-010 | TGNT | BINP | | -0.00017 | 0.00012 | 0.00026 | | -1733. | 943. | -34505. | -11675. | -6693. | 4047. | 435. |
| 327-07-009 | RSNT | END | | -0.00011 | 0.00013 | 0.00022 | -41932. | -20967. | 0. | 36314. | 0. | 0. | 0. | |
| 326-07-008 | RSNT | END | | -0.00011 | 0.00013 | 0.00022 | -736. | -0. | -736. | -0. | 0. | 0. | 0. | |
| 325-07-007 | RSNT | END | | -0.00011 | 0.00013 | 0.00022 | 22926. | 22926. | 0. | 0. | 0. | 0. | 0. | |
| 325-07-006 | TGNT | END | | -0.00011 | 0.00013 | 0.00022 | | 226. | 207. | 29. | -5076. | 5439. | 4047. | 262. |
| 320-07-005 | BEND | END | | -0.00005 | 0.00006 | 0.00012 | | 226. | 207. | 29. | -1668. | 1708. | 4047. | 205. |
| 320-07-004 | TGNT | END | | 0.00002 | 0.00002 | 0.00004 | | 226. | 207. | 29. | -1067. | 1113. | 3592. | 261. |
| 305-07-003 | BEND | END | | 0.00005 | -0.00001 | -0.00001 | | 226. | 207. | 29. | -1209. | 1746. | 163. | 136. |
| 305-07-002 | TGNT | END | | 0.00007 | -0.00006 | -0.00001 | | 226. | 207. | 29. | -608. | 1152. | -293. | 89. |
| 300-07-001 | ANKR | END | | -0. | -0. | -0. | | 226. | 207. | 29. | 5227. | -5236. | -293. | 229. |
| 250-06-019 | RSNT | BINP | | -0.00055 | -0.00085 | 0.00000 | -8833. | -0. | -0. | 8833. | 0. | 0. | 0. | |
| 250-06-018 | TGNT | END | | -0.00055 | -0.00085 | 0.00000 | | 0. | -0. | 8833. | -0. | 0. | 0. | 0. |
| 285-06-017 | TGNT | END | | -0.00055 | -0.00068 | 0.00000 | | 0. | -0. | 5182. | -0. | -45549. | -0. | 212. |
| 280-06-016 | RSNT | END | | -0.00055 | -0.00066 | 0.00000 | -16. | -0. | -16. | -0. | 0. | 0. | 0. | |
| 280-06-015 | TGNT | END | | -0.00055 | -0.00066 | 0.00000 | | 0. | -16. | 5182. | -0. | -45549. | -0. | 212. |
| 275-06-014 | TGNT | END | | -0.00055 | -0.00065 | 0.00000 | | 0. | -16. | 5182. | -39. | -45549. | -0. | 1410. |
| 270-06-013 | TGNT | END | | -0.00055 | -0.00032 | 0.00000 | | 0. | -16. | 1843. | -39. | -63992. | -83. | 297. |
| 266-06-012 | RSNT | END | | -0.00055 | -0.00030 | 0.00000 | 94. | 0. | 94. | 0. | 0. | 0. | 0. | |
| 265-06-011 | RSNT | END | | -0.00055 | -0.00030 | 0.00000 | 3261. | -3261. | 0. | 0. | 0. | 0. | 0. | |
| 265-06-010 | TGNT | END | | -0.00055 | -0.00030 | 0.00000 | | -3261. | 78. | 1843. | -0. | -63992. | -83. | 297. |
| 260-06-009 | TGNT | END | | -0.00055 | -0.00028 | 0.00000 | | -3261. | 78. | 1843. | 196. | -55838. | -83. | 1728. |
| 255-06-008 | TGNT | END | | -0.00055 | 0.00035 | -0.00000 | | -3261. | 78. | -4835. | 196. | -40134. | 739. | 186. |
| 250-06-007 | RSNT | END | | -0.00055 | 0.00036 | -0.00000 | -977. | -0. | -977. | -0. | 0. | 0. | 0. | |
| 250-06-006 | TGNT | END | | -0.00055 | 0.00036 | -0.00000 | | -3261. | -899. | -4835. | -0. | -48288. | 739. | 224. |
| 245-06-005 | TGNT | END | | -0.00055 | 0.00038 | -0.00000 | | -3261. | -899. | -4835. | -2247. | -40134. | 739. | 1244. |

TI
APERTURE
CARD

Also Available On
Aperture Card

8504040294-52

| ELEMENT ID | ELEM TYPE | ELEM PCNT | ELEMENT POINT COORDINATES | | | LENGTH FT. | DIAM IN. | THCK IN. | RADIUS FT. | THETA DEG | DISPLACEMENTS, INCHES | | |
|------------|-----------|-----------|---------------------------|---------|--------|------------|----------|----------|------------|-----------|-----------------------|---------|---------|
| | | | X, FT. | Y, FT. | Z, FT. | | | | | | DELTA X | DELTA Y | DELTA Z |
| 240-06-004 | BEND | END | 9.759 | -8.750 | 70.016 | 2.356 | 24.000 | 0.968 | 3.000 | 45.000 | -0.008 | 0.017 | -0.050 |
| 240-06-003 | TGNT | END | 7.637 | -8.750 | 69.137 | 0.730 | 24.000 | 0.968 | | | -0.014 | 0.010 | -0.036 |
| 235-06-002 | BEND | END | 7.121 | -8.750 | 68.621 | 4.712 | 24.000 | 0.968 | 3.000 | 90.000 | -0.017 | 0.006 | -0.033 |
| 235-06-001 | TGNT | END | 5.000 | -11.750 | 66.500 | 2.250 | 24.000 | 0.968 | | | -0.018 | -0.011 | -0.008 |
| 235-06-001 | TGNT | BGIN | 5.000 | -14.000 | 66.500 | 2.250 | 24.000 | 0.968 | | | -0.011 | -0.011 | -0.002 |
| 120-05-008 | TGNT | BINP | 5.000 | -14.000 | 66.500 | 23.330 | 24.000 | 0.968 | | | -0.011 | -0.011 | -0.002 |
| 105-05-007 | RSNT | END | 5.000 | -14.000 | 43.170 | | | | | | -0.000 | -0.000 | -0.005 |
| 85-05-006 | RSNT | END | 5.000 | -14.000 | 43.170 | | | | | | -0.000 | -0.000 | -0.005 |
| 85-05-005 | TGNT | END | 5.000 | -14.000 | 43.170 | 1.500 | 24.000 | 0.968 | | | -0.000 | -0.000 | -0.005 |
| 80-05-004 | TGNT | END | 5.000 | -14.000 | 41.670 | 1.000 | 30.000 | 9.000 | | | 0.001 | 0.001 | -0.005 |
| 77-05-003 | CMPT | END | 4.000 | -14.000 | 41.670 | 4.500 | | | | | 0.001 | -0.000 | -0.005 |
| 76-05-002 | TGNT | END | 4.000 | -14.000 | 37.170 | 1.000 | 30.000 | 9.000 | | | 0.002 | 0.002 | -0.005 |
| 75-05-001 | TGNT | END | 5.000 | -14.000 | 37.170 | 11.000 | 24.000 | 0.968 | | | 0.002 | 0.004 | -0.005 |
| 75-05-001 | TGNT | BGIN | 5.000 | -14.000 | 26.170 | 11.000 | 24.000 | 0.968 | | | 0.002 | 0.004 | -0.006 |
| 72-04-003 | RSNT | BINP | -25.000 | -14.000 | 18.920 | | | | | | -0.000 | -0.000 | -0.001 |
| 71-04-002 | RSNT | END | -25.000 | -14.000 | 18.920 | | | | | | -0.000 | -0.000 | -0.001 |
| 71-04-001 | TGNT | END | -25.000 | -14.000 | 18.920 | 7.250 | 24.000 | 0.812 | | | -0.000 | -0.000 | -0.001 |
| 71-04-001 | TGNT | BGIN | -25.000 | -14.000 | 26.170 | 7.250 | 24.000 | 0.812 | | | 0.002 | -0.000 | -0.001 |
| 70-03-002 | TGNT | BINP | -25.000 | -14.000 | 26.170 | 17.000 | 24.000 | 0.968 | | | 0.002 | -0.000 | -0.001 |
| 65-03-001 | ANKR | END | -25.000 | -14.000 | 43.170 | | 24.000 | 0.968 | | | 0.000 | -0. | -0. |
| 60-02-001 | TGNT | BINP | -25.000 | -14.000 | 26.170 | 30.000 | 20.000 | 0.812 | | | 0.002 | -0.000 | -0.001 |
| 60-02-001 | TGNT | BGIN | 5.000 | -14.000 | 26.170 | 30.000 | 20.000 | 0.812 | | | 0.002 | 0.004 | -0.006 |
| 45-01-009 | TGNT | BINP | 5.000 | -14.000 | 26.170 | 7.250 | 24.000 | 0.968 | | | 0.002 | 0.004 | -0.006 |
| 40-01-008 | RSNT | END | 5.000 | -14.000 | 18.920 | | | | | | 0.000 | 0.000 | -0.006 |
| 20-01-007 | RSNT | END | 5.000 | -14.000 | 18.920 | | | | | | 0.000 | 0.000 | -0.006 |

TI APERTURE CARD

Also Available On Aperture Card

DATE 00C10'U00 TIME 2516 HRS.

MAIN STEAM SPHERE TO TURBINE Z-ACC 1.0G 4/27/65

PROBLEM NO. 012

| ELEMENT ID | ELEM TYPE | ELEM PCNT | ROTATIONS, RADIANS | | | RSNT LOAD | FORCES, LBS. | | | MOMENTS, FT.-LBS. | | | STRESS SE, PSI |
|------------|-----------|-----------|--------------------|----------|----------|-----------|--------------|--------|--------|-------------------|---------|--------|----------------|
| | | | PHI X | PHI Y | PHI Z | | FX | FY | FZ | MX | MY | MZ | |
| 240-06-004 | BENC | END | -0.00053 | 0.00054 | 0.00001 | | -3261. | -899. | -6426. | -2247. | -4902. | -4885. | 475. |
| 240-06-003 | TGNT | END | -0.00055 | 0.00052 | 0.00008 | | -3261. | -899. | -7026. | -1457. | 6466. | -6792. | 539. |
| 235-06-002 | BENC | END | -0.00054 | 0.00051 | 0.00009 | | -3261. | -899. | -7212. | -994. | 8456. | -7256. | 673. |
| 235-06-001 | TGNT | END | -0.00026 | 0.00018 | 0.00027 | | -3261. | -899. | -8410. | -23011. | 17760. | 621. | 1657. |
| 235-06-001 | TGNT | BGIN | -0.00017 | 0.00012 | 0.00026 | | -3261. | -899. | -8983. | -42578. | 17760. | 7959. | 1449. |
| 120-05-008 | TGNT | BINP | -0.00017 | 0.00012 | 0.00026 | | -1528. | -1842. | 25522. | -30903. | 24453. | 3912. | 1226. |
| 105-05-007 | RSNT | END | 0.00007 | -0.00005 | 0.00013 | 3887. | 2749. | 2749. | 0. | 0. | 0. | 0. | |
| 85-05-006 | RSNT | END | 0.00007 | -0.00005 | 0.00013 | -538. | 324. | -430. | -0. | 0. | 0. | 0. | |
| 85-05-005 | TGNT | END | 0.00007 | -0.00005 | 0.00013 | | 1544. | 477. | 19587. | 12061. | -11200. | 3912. | 524. |
| 80-05-004 | TGNT | END | 0.00005 | -0.00003 | 0.00012 | | 1544. | 477. | 19205. | 11345. | -8884. | 3912. | 69. |
| 77-05-003 | CMPT | END | 0.00005 | -0.00003 | 0.00012 | | 1544. | 477. | 19205. | 11345. | -28089. | 4389. | 0. |
| 76-05-002 | TGNT | END | 0.00005 | -0.00003 | 0.00012 | | 1544. | 477. | 10209. | 9199. | -21139. | 4389. | 109. |
| 75-05-001 | TGNT | END | 0.00005 | -0.00003 | 0.00012 | | 1544. | 477. | 10209. | 9199. | -10930. | 3912. | 458. |
| 75-05-001 | TGNT | BGIN | -0.00003 | 0.00000 | 0.00006 | | 1544. | 477. | 7410. | 3953. | 6058. | 3912. | 255. |
| 72-04-003 | RSNT | BINP | 0.00000 | 0.00001 | -0.00001 | 533. | 533. | 0. | 0. | 0. | 0. | 0. | |
| 71-04-002 | RSNT | END | 0.00000 | 0.00001 | -0.00001 | 66. | 0. | 66. | 0. | 0. | 0. | 0. | |
| 71-04-001 | TGNT | END | 0.00000 | 0.00001 | -0.00001 | | 533. | 66. | -0. | 0. | 0. | -0. | 0. |
| 71-04-001 | TGNT | BGIN | -0.00000 | 0.00003 | -0.00001 | | 533. | 66. | -1844. | 475. | -3864. | -0. | 141. |
| 70-03-002 | TGNT | BINP | -0.00000 | 0.00003 | -0.00001 | | 852. | -14. | -4494. | 106. | 8838. | -275. | 274. |
| 65-03-001 | ANKR | END | -0. | -0. | -0. | | 852. | -14. | -8819. | -136. | -5642. | -275. | 175. |
| 60-02-001 | TGNT | BINP | -0.00000 | 0.00003 | -0.00001 | | -319. | 80. | 2650. | 369. | -12702. | 275. | 676. |
| 60-02-001 | TGNT | BGIN | -0.00003 | 0.00000 | 0.00006 | | -319. | 80. | -2678. | 369. | -13132. | -2118. | 708. |
| 45-01-009 | TGNT | BINP | -0.00003 | 0.00000 | 0.00006 | | 1228. | 558. | 4737. | 4314. | -7057. | 1794. | 262. |
| 40-01-008 | RSNT | END | -0.00005 | 0.00002 | 0.00004 | -1430. | -1011. | -1011. | -0. | 0. | 0. | 0. | |
| 20-01-007 | RSNT | END | -0.00005 | 0.00002 | 0.00004 | 723. | -435. | 578. | 0. | 0. | 0. | 0. | |

TI APERTURE CARD

Also Available On Aperture Card

8504040294-54

RLN NO. 0

PIPING FLEXIBILITY ANALYSIS PROGRAM MEC-21/7094
** WEIGHT LOADING EFFECTS **

PAGE 9 OF 10

DATE 00010'UGO TIME 2516 HRS.

MAIN STEAM SPHERE TO TURBINE Z-ACC 1.0G 4/27/65

PROBLEM NO. 012

| ELEMENT ID | ELEM TYPE | ELEM PCNT | ELEMENT POINT COORDINATES | | | LENGTH FT. | DIAM IN. | THCK IN. | RADIUS FT. | THETA DEG | DISPLACEMENTS, INCHES | | |
|------------|-----------|-----------|---------------------------|---------|--------|------------|----------|----------|------------|-----------|-----------------------|---------|---------|
| | | | X, FT. | Y, FT. | Z, FT. | | | | | | DELTA X | DELTA Y | DELTA Z |
| 20-01-CC6 | TGNT | ENC | 5.000 | -14.000 | 18.920 | 3.250 | 24.000 | 0.968 | | | 0.000 | 0.000 | -0.006 |
| 15-01-C05 | BEND | END | 5.000 | -14.000 | 15.670 | 4.712 | 24.000 | 0.968 | 3.000 | 90.000 | -0.001 | -0.002 | -0.006 |
| 15-01-C04 | TGNT | END | 3.991 | -11.175 | 12.670 | 8.866 | 24.000 | 0.968 | | | -0.001 | -0.004 | -0.007 |
| 10-01-C03 | BEND | ENC | 1.009 | -2.825 | 12.670 | 4.712 | 24.000 | 0.968 | 3.000 | 90.000 | -0.000 | -0.003 | -0.002 |
| 10-01-CC2 | TGNT | ENC | -0. | -0. | 9.670 | 9.670 | 24.000 | 0.968 | | | -0.000 | -0.001 | -0.000 |
| 5-01-C01 | ANKR | END | -0. | -0. | -0. | | 24.000 | 0.968 | | | -0.000 | -0. | -0. |

TI
APERTURE
CARD

Also Available On
Aperture Card

20

DATE 00010*UCO TIME 2516 HRS.

MAIN STEAM SPHERE TO TURBINE Z-ACC 1.0G 4/27/65

PROBLEM NO. 012

| ELEMENT ID | ELEM | ELEM | ROTATIONS, RADIANS | | | RSNT | FORCES, LBS. | | | MOMENTS, FT.-LBS. | | | STRESS SE, PSI |
|------------|------|------|--------------------|---------|----------|------|--------------|-------|--------|-------------------|-------|-------|----------------|
| | | | CRD-BR-ELM | TYPE | PCNT | | PHI X | PHI Y | PHI Z | LOAD | FX | FY | |
| 20-01-006 | TGNT | END | -0.00005 | 0.00002 | 0.00004 | | -219. | 124. | 2892. | 272. | 1844. | 1794. | 80. |
| 15-01-005 | BEND | END | -0.00005 | 0.00002 | 0.00003 | | -219. | 124. | 2065. | -130. | 1132. | 1794. | 95. |
| 15-01-004 | TGNT | END | 0.00001 | 0.00001 | -0.00001 | | -219. | 124. | 867. | -4181. | -839. | 1300. | 300. |
| 10-01-003 | BEND | END | 0.00006 | 0.00002 | -0.00001 | | -219. | 124. | -1389. | -2000. | -61. | -159. | 131. |
| 10-01-002 | TGNT | END | 0.00002 | 0.00000 | -0.00001 | | -219. | 124. | -2588. | 2783. | 1123. | -653. | 205. |
| 5-01-001 | ANKR | END | -0. | -0. | -0. | | -219. | 124. | -5048. | 1586. | -995. | -653. | 61. |

END, EXECUTION TIME 1.65 MINUTES.

II
APERTURE
CARD

Also Available On
Aperture Card

85-04040294-56

PROJECT **SONGS - No 1**

SUBJECT **MAIN-STEAM LINE**

SHEET 1 OF 1

BY Davis DATE 6-19-73


AREA(S) 2

REFERENCE DWGS.


MECH. CIVIL P&I

MAXIMUM STRESS

| TYPE | PT. | PSI |
|---------|-----|---------|
| THERML | 2 | 12,858. |
| WEIGHT | 12 | 2,681. |
| SEISMIC | 11 | 2,815. |

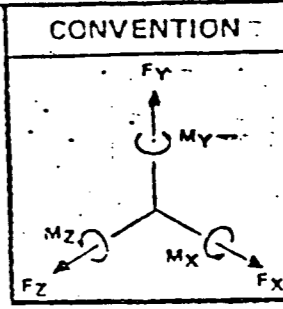

(ADDITIONAL INFORMATION ON ISOMETRIC DATA AND DETAIL SHEET)

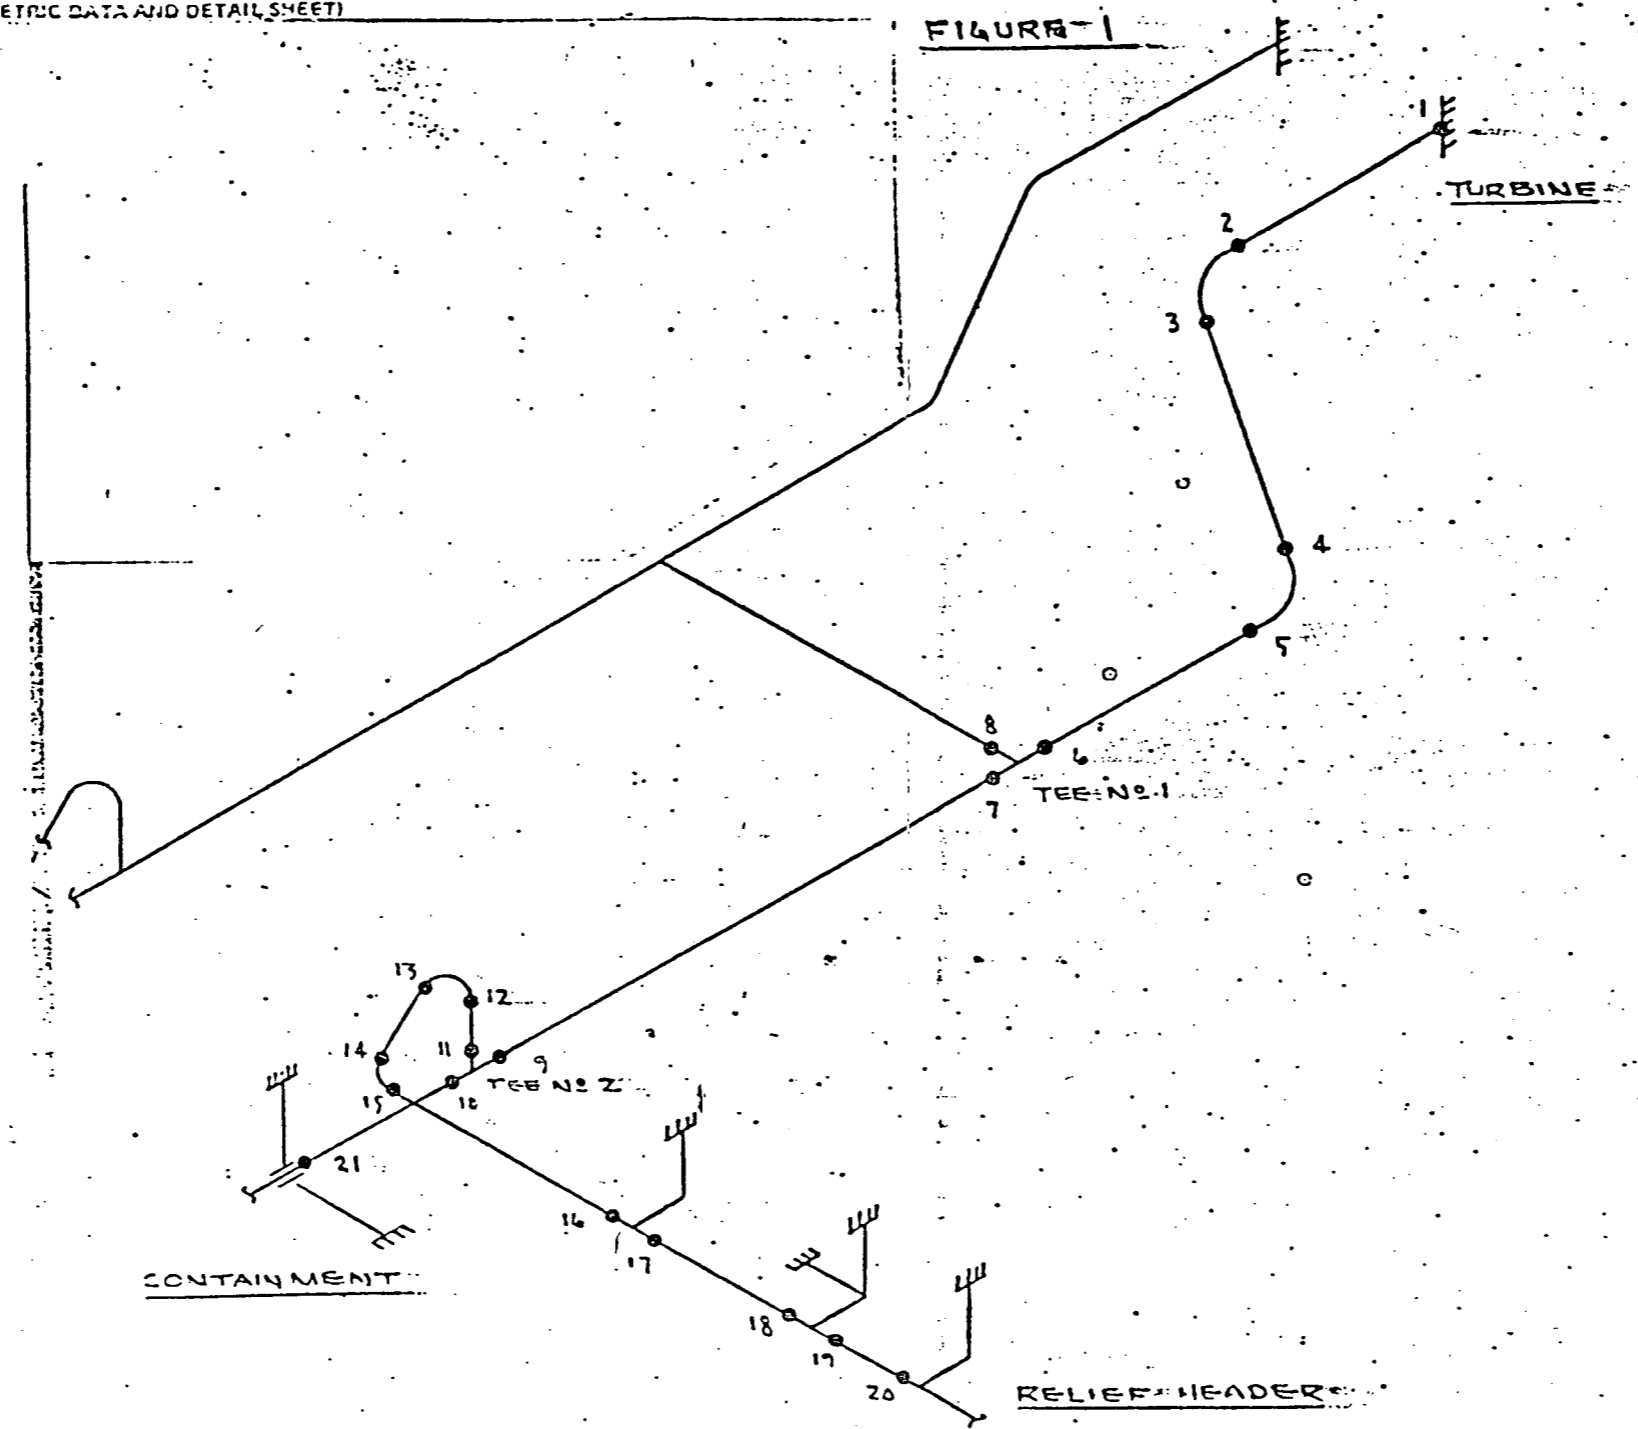

Also Available On
Aperture Card
TI
APERTURE
CARD

| REV. | BY | DATE | CHK'D | DATE | DESCRIPTION | REV. | BY | DATE | CHK'D | DATE | DESCRIPTION |
|-----------|----|------|-------|------|-------------|-----------|----|------|-------|------|-------------|
| | | | | | | | | | | | |
| REVISIONS | | | | | | REVISIONS | | | | | |

BECHTEL JOB NO. 1304-794

8504040294-57



NAUO STEAM LINE (TABLE-1)

162

| NODE | SEISMIC | | | | | WEIGHT | THERMAL | PRESSURE | | | | $\frac{\sigma_x + \sigma_y}{2}$ | $\frac{\sigma_x - \sigma_y}{2}$ | $\frac{\sigma_z}{8}$ |
|------|---------|-------|---------------|-------|-----------|--------|---------|----------|--------|-----|---------------------|---------------------------------|---------------------------------|----------------------|
| | X | Z | Y INC. WEIGHT | Y | RESULTANT | | | P | d | D | $\frac{Pd^2}{8D^3}$ | | | |
| 1 | 973. | 61. | 9.13. | 365. | 994. | 548. | 5312. | 1000. | 22.06. | 24. | 5446. | 12,300. | .328 | .236 |
| 2 | 81. | 235. | 276. | 110. | 248. | 162. | 12,958. | | | | | 18,718. | .499 | .571 |
| 3 | 338. | 131. | 278. | 150. | 392. | 226. | 8193. | | | | | 14,257. | .380 | .364 |
| 4 | 165. | 300. | 795. | 319. | 428. | 478. | 7059. | | | | | 13,441. | .358 | .313 |
| 5 | 323. | 95. | 929. | 372. | 502. | 557. | 11,747. | | | | | 18,252. | .486 | .522 |
| 6 | | | | | 1258.* | 733.* | 8279.* | | | | | 15,716. | .419 | .368 |
| 7 | | | | | 991.* | 691.* | 7052.* | | 22.06 | 24. | 5446. | 14,180. | .378 | .313 |
| 8 | | | | | 1385.* | 297.* | 5064.* | | 18.38 | 20. | 5433. | 12,179. | .325 | .225 |
| 9 | | | | | 2343.* | 314.* | 2090.* | | 22.06 | 24. | 5446. | 12,493. | .333 | .192 |
| 10 | | | | | 1568.* | 1837.* | 3653.* | | | | | 12,536. | .333 | .162 |
| 11 | | | | | 2815.* | 2102.* | 1104.* | | | | | 11,467. | .306 | .049 |
| 12 | 298. | 1257. | 4408. | 1787. | 2455. | 2681. | 1273. | | | | | 11,855. | .316 | .057 |
| 13 | 53. | 673. | 3151. | 1262. | 1429. | 1891. | 1232. | | | | | 7,798. | .257 | .055 |
| 14 | 49. | 539. | 3155. | 1262. | 1373. | 1893. | 1200. | | | | | 7,936. | .265 | .052 |
| 15 | 302. | 475. | 2370. | 948. | 1102. | 1422. | 1319. | | | | | 9,289. | .248 | .059 |
| 16 | 393. | 1244. | 2211. | 834. | 1576. | 1237. | 5125. | | | | | 3,561. | .236 | .023 |
| 17 | 59. | 182. | 194. | 76. | 210. | 116. | 515. | 1000. | 22.06 | 24. | 5446. | 5,287. | .125 | .023 |

NOTES

MATL. A-106-GR B

T_c = 70° F, T_w = 505° F

S_c = S_w = 15,000 LBS/IN²

S_A = f (1.25 S_c + .25 S_w)
 = (1) [(1.25) 15,000 + (.25) 15,000.]

S_A = 22,500 LBS/IN²

S_A + S_w = 22,500 + 15,000 =

S_A + S_w = 37,500 LBS/IN²

* HAND-CALCULATED BY USING MOMENTS FROM PROGRAM OUTPUT WITH AN APPROPRIATE STRESS INTENSIFICATION FACTOR.

Also Available On Aperture Card
 III APERTURE CARD




MAIN STEAM LINE (TABLE 1) CONT.

(63)


| NODE | SEISMIC | | | | | WEIGHT | THERMAL | PRESSURE | | | | $\frac{\sigma_x + \sigma_y}{\sigma_x + \sigma_y}$ | $\frac{\sigma_z}{\sigma_x + \sigma_y}$ | $\frac{\sigma_r}{\sigma_x + \sigma_y}$ |
|------|---------------|---------------|-----------------------------|-----------------------------|--------------------------|----------------------|------------|----------|-------|-----|-------------------------------|---|--|--|
| | X | Z | INC. WEIGHT | Y | RESULTANT | | | | | | | | | |
| | σ_{sx} | σ_{sz} | $\sigma_{xy} + \sigma_{yx}$ | $\sigma_{yz} + \sigma_{zy}$ | $\sqrt{\sum \sigma_i^2}$ | $\sigma_w = 6\sigma$ | σ_T | P | d | D | $\sigma_p = \frac{Pd^2}{D^3}$ | $\sigma_x + \sigma_y + \sigma_z$ | $\frac{\sigma_z}{\sigma_x + \sigma_y}$ | $\frac{\sigma_r}{\sigma_x + \sigma_y}$ |
| 18 | 822. | 1725. | 1259. | 504. | 1979. | 755. | 134. | 1000 | 22.06 | 24. | 5446 | 8,314. | .222 | .005 |
| 19 | 72. | 297. | 153. | 61. | 312. | 72. | 137. | | | | | 5,987. | .160 | .006 |
| 20 | 266. | 1410. | 1173. | 469. | 1510. | 704. | 34. | | | | | 7,744. | .207 | .004 |
| 21 | 167. | 262. | 183. | 73. | 319. | 110. | 3457. | 1000 | 22.56 | 24. | 5446 | 7,332. | .249 | .154 |

Also Available On Aperture Card.


TI APERTURE CARD

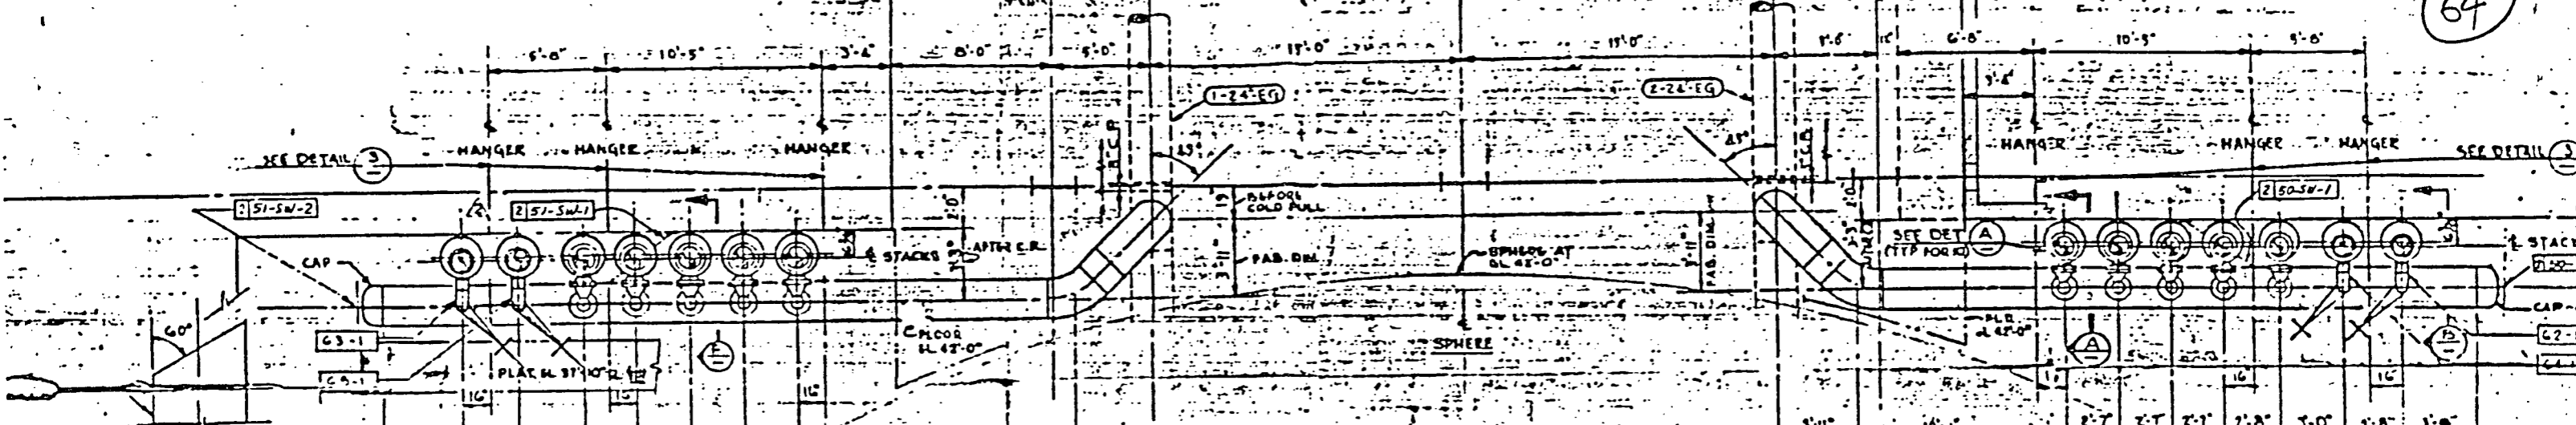


PLAN SCALE: 1/4" = 1'-0"

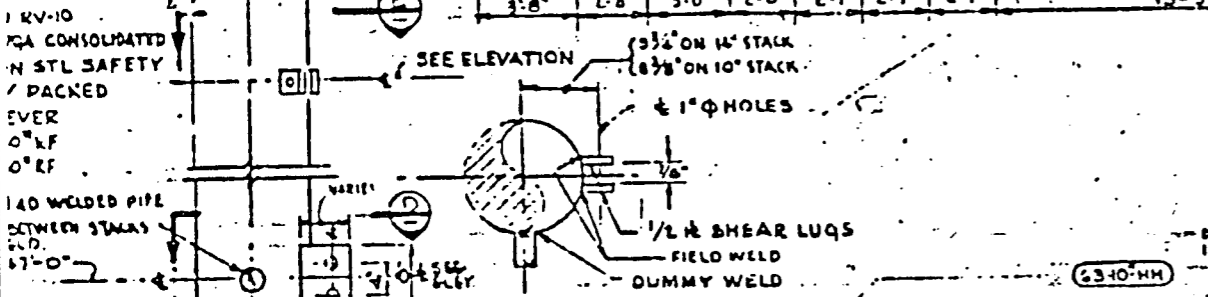


SECTION D NO SCALE

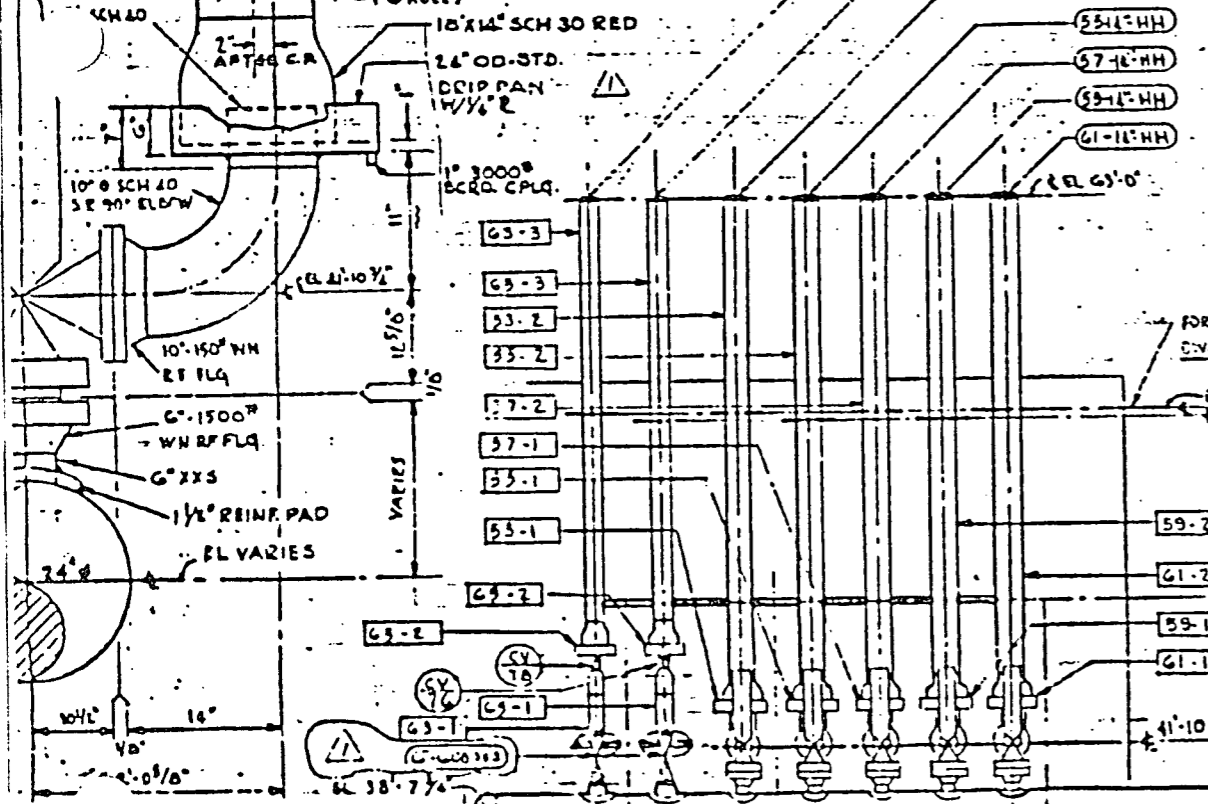


SECTION E

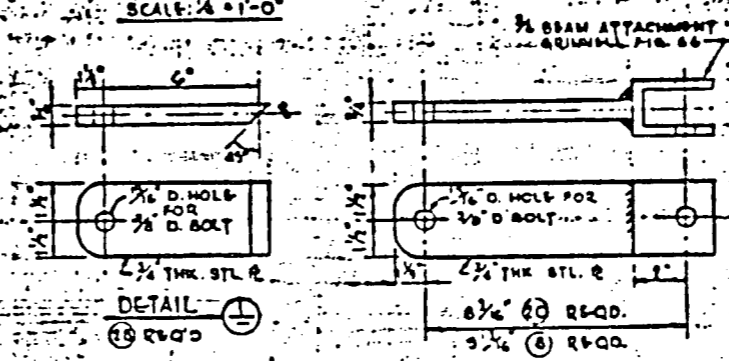


DETAIL 1

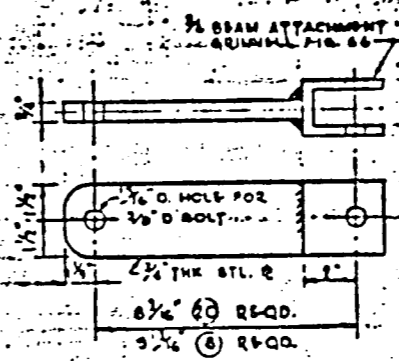

DETAIL 2


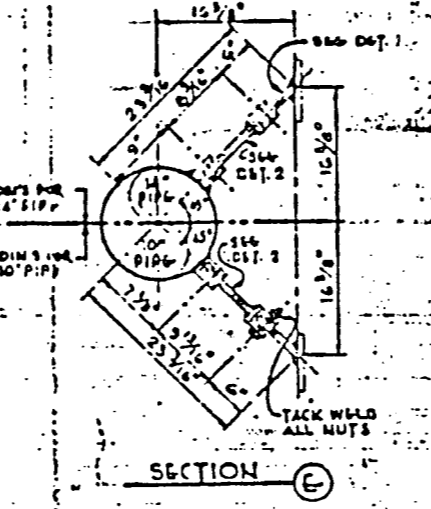


SECTION A SCALE: 1/2" = 1'-0"

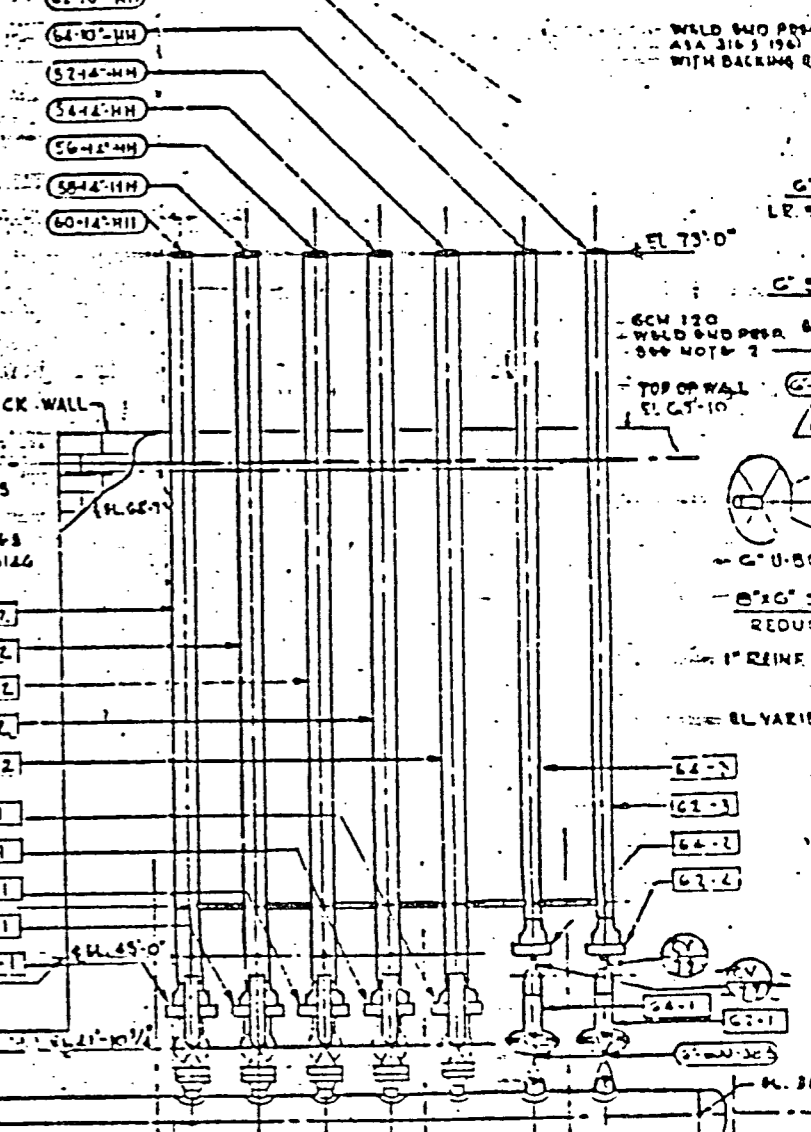


SECTION B

SEE NOTE 4 ON PAGE 65

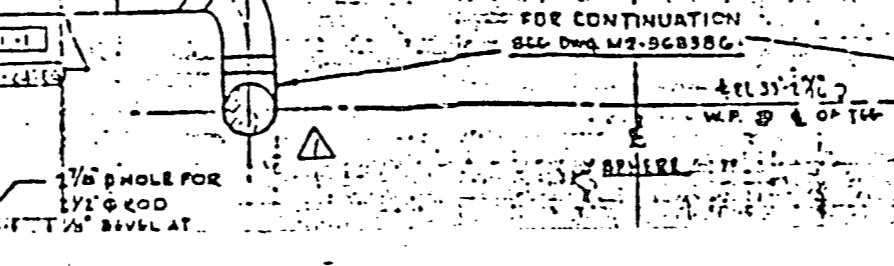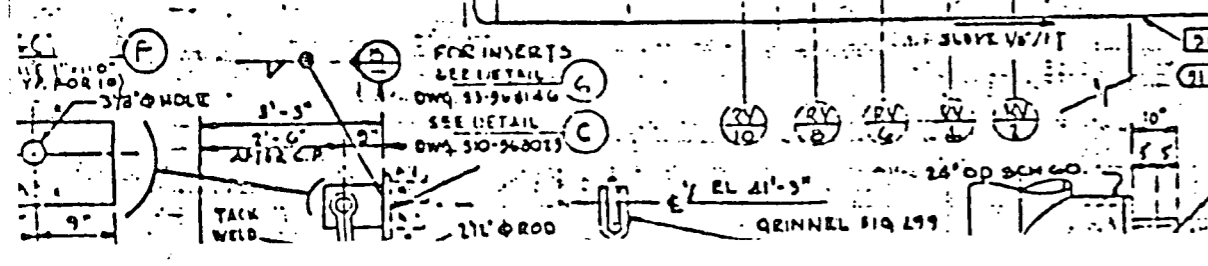


TI APERTURE CARD

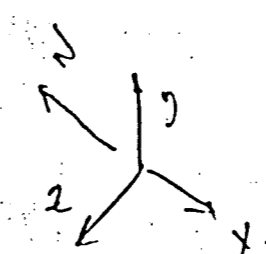

ORIGINATOR A. Kaloni
 CHECKER C. Stein
 CALC. NO.
 SHEET 4
 JOB 14000

M.S. 04

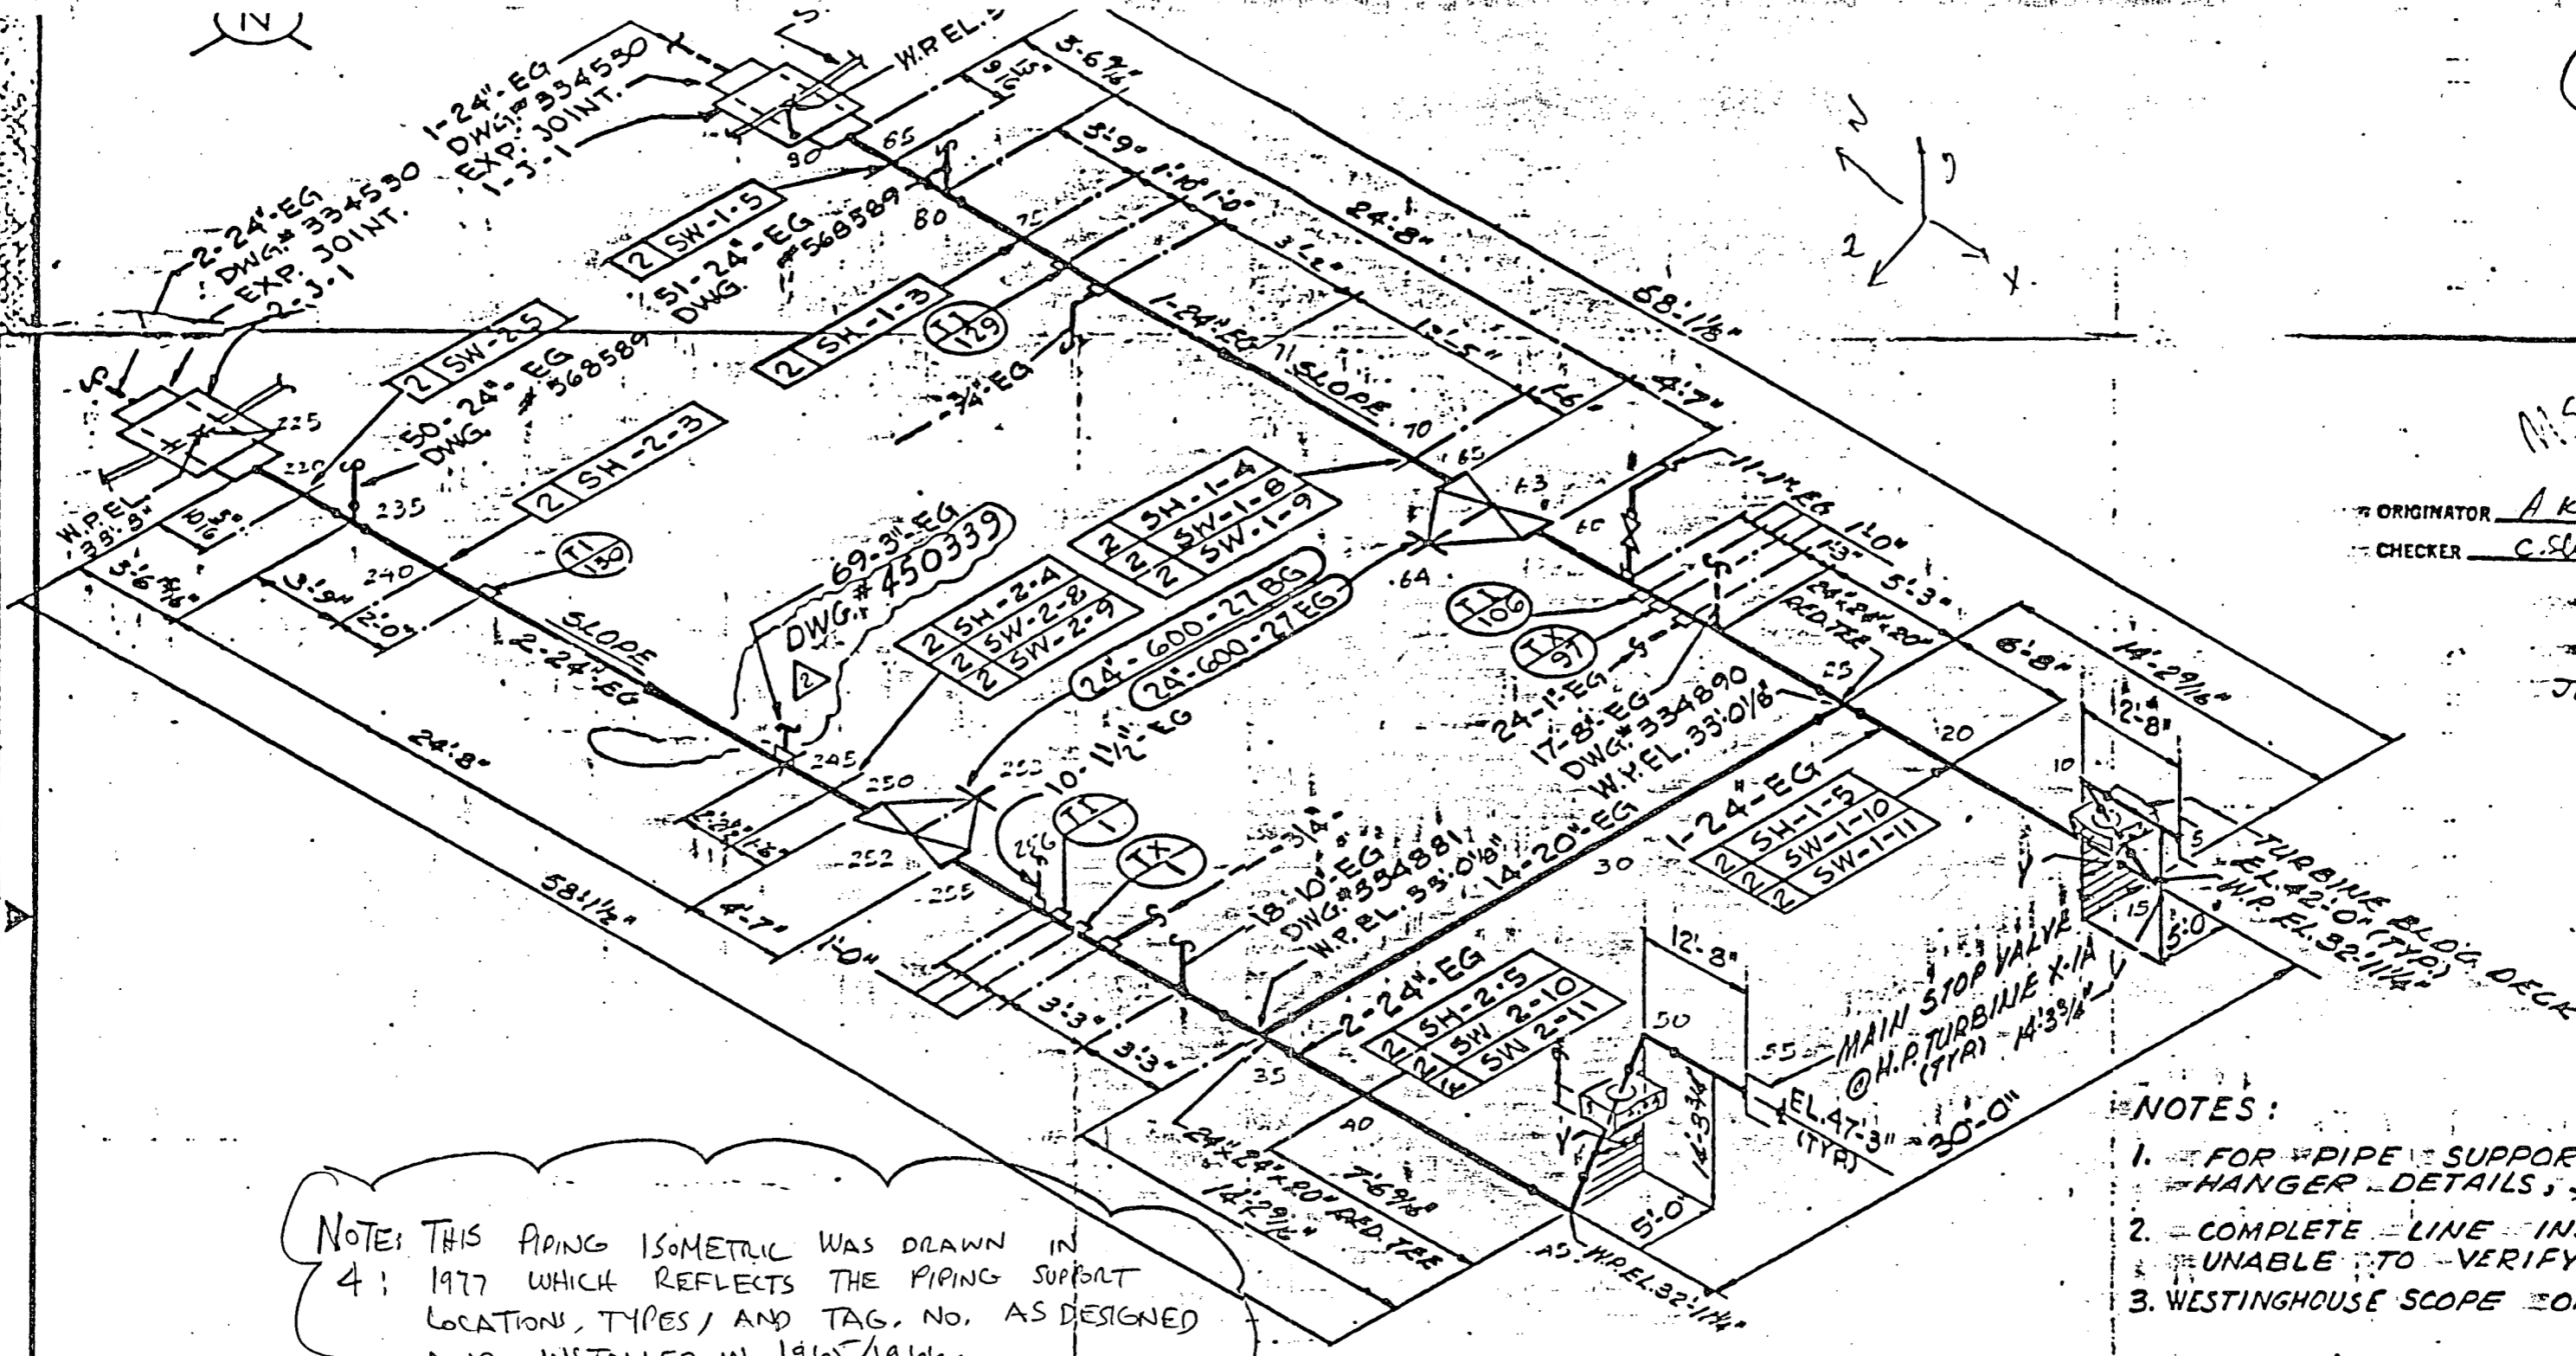

NOTE: THIS PIPING ISOMETRIC WAS DRAWN IN 4: 1977 WHICH REFLECTS THE PIPING SUPPORT LOCATIONS, TYPES, AND TAG. NO. AS DESIGNED AND INSTALLED IN 1965/1966, THIS PIPE SUPPORT LOCATIONS & TYPES HAVE BEEN RE-VERIFIED IN 79-14 PROGRAM

- NOTES:
- FOR PIPE SUPPORT AND HANGER DETAILS, SEE M...
 - COMPLETE LINE INSULATE UNABLE TO VERIFY FITT...
 - WESTINGHOUSE SCOPE OF ANAL...

CLASS 2-PIPE SAFETY-RELATED

TI APERTURE CARD

Also Available On Aperture Card.
 BOP-SEISMIC REEVALUATION ANALYSIS BOUNDARY-ISOMETRIC

CERTIFIED AS BUILT

UNIT 1

| NO. | SC. P. E. | DATE |
|-----|-----------|----------|
| 2 | ms | 12/20/78 |
| 1 | ms | 7/14/78 |
| 0 | ms | 9/17/71 |



PIPING FLEXIBILITY CALCULATION
 BECHTEL CORPORATION
 4550 SEVILLE AVENUE
 VERNON, CALIFORNIA



Sc = _____
 Sh = _____
 SA = 1.25Sc + .25Sh
 SA = _____

MAXIMUM STRESS

 AT POINT

SIGNATURE W. P. Grant DATE 12-29-64
 PROJECT SAN ONFRE JOB NO. 3246
 SUBJECT FEEDWATER - SPHERE TO GEN. E-1B X & Z ACCELERATION (.5G)

CONVENTION FOR
 POSITIVE
 FORCES & MOMENTS

DESIGN DATA

PRESS. _____
 TEMP. 71°F


MAT'L CARB. STL.
 EXP. COEF. .00000638
 Ec x 10⁶ 29.9

MEMBER DATA

30" O.D. x 9" W.T. 2, 3, 10, 11, 19, 20
10.75" x .5 W.T. ALL OTHERS

ANCHOR DATA

| ANCHOR | | COORDINATES | | | END DEFLECTION | | |
|--------|-----|-------------|-------|------|----------------|----|----|
| No. | Pt. | X | Y | Z | ΔX | ΔY | ΔZ |
| A1 | 0 | 0 | 0 | 0 | 0 | 0 | 0 |
| A12 | 22 | -107.69' | 9.56' | 9.0' | 0 | 0 | 0 |

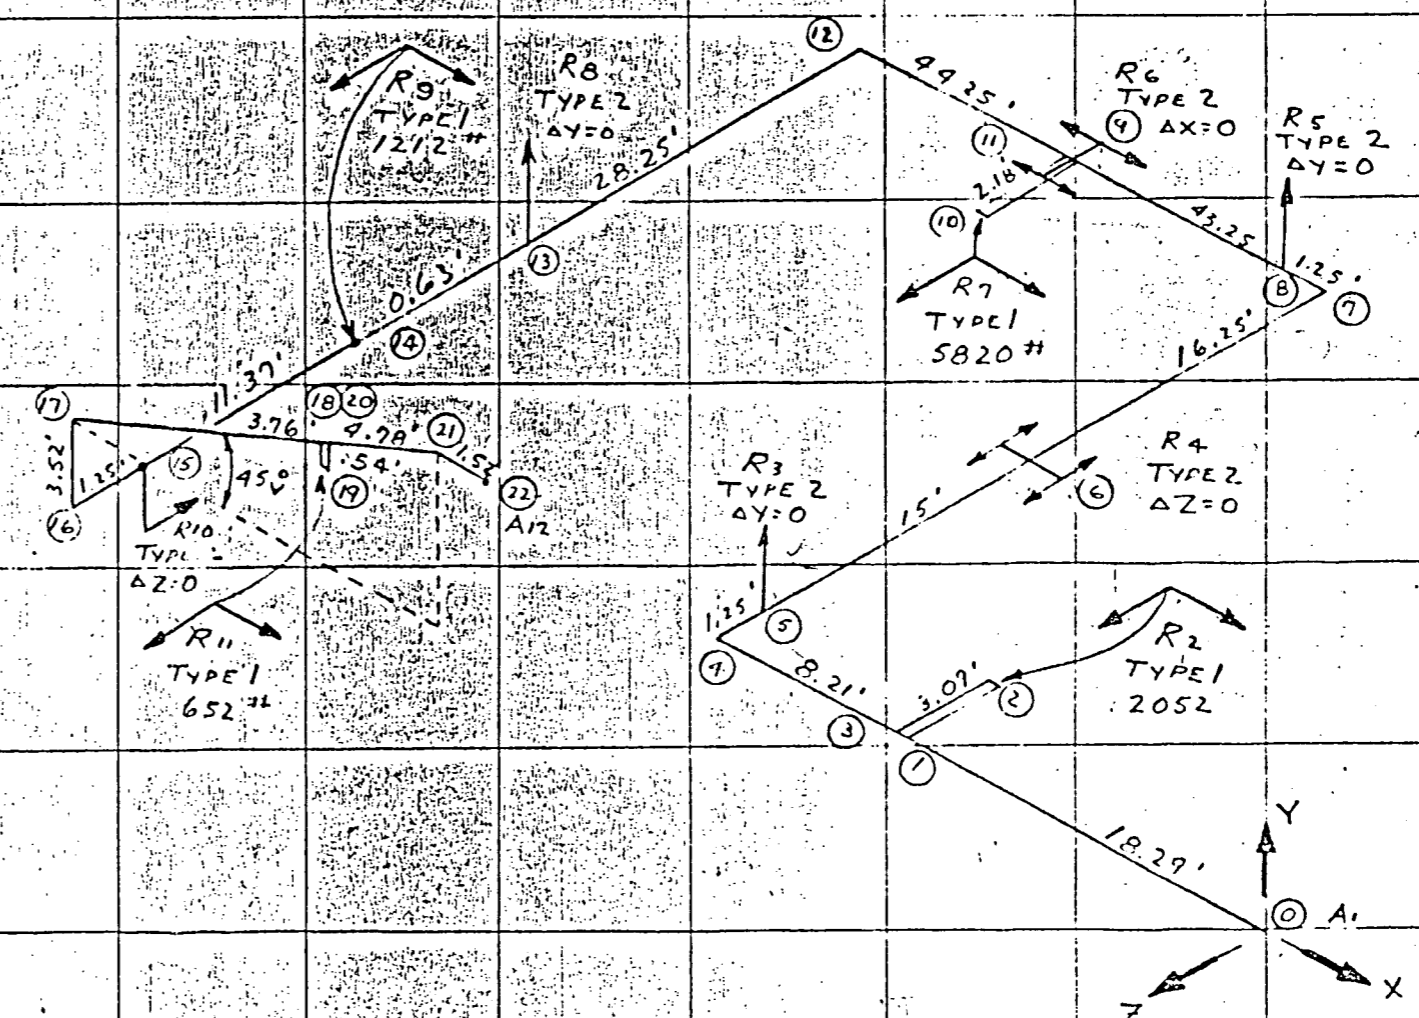


APERTURE
 CARD

Also Available On
 Aperture Card

INSTRUCTIONS

- REFER TO DESIGN PRACTICE FOR DESCRIPTION OF PROGRAM.
- USE ONLY CAPITAL LETTERS AND ARABIC FIGURES, WRITE ALPHABETICAL LETTERS 0 THUS "Ø", AND 1 THUS "I"; FIGURES ZERO THUS "Ø", ONE THUS "I".
- ENTER DATA FOR EACH ANCHOR, STRAIGHT OR CURVED MEMBER, JUNCTION, OR RESTRAINT ON A SEPARATE LINE.
- NO ENTRY NEED BE MADE FOR ANCHOR DISPLACEMENTS, RESTRAINT DEFLECTION OR FORCE IF VALUES ARE ZERO.
- THE O.D., THICK., & TEMP. NEED TO BE ENTERED ONLY FOR THE FIRST STRAIGHT OR CURVED MEMBER. THESE VALUES WILL BE USED FOR ALL SUCCEEDING MEMBERS UNTIL DIFFERENT VALUES ARE ENTERED. THE NEW VALUES WILL THEN BE USED UNTIL ANOTHER ENTRY IS MADE.
- NUMBER STRAIGHT & CURVED MEMBERS CONSECUTIVELY STARTING WITH 1; DITTO FOR ANCHORS & RESTRAINTS; DITTO FOR JUNCTIONS.

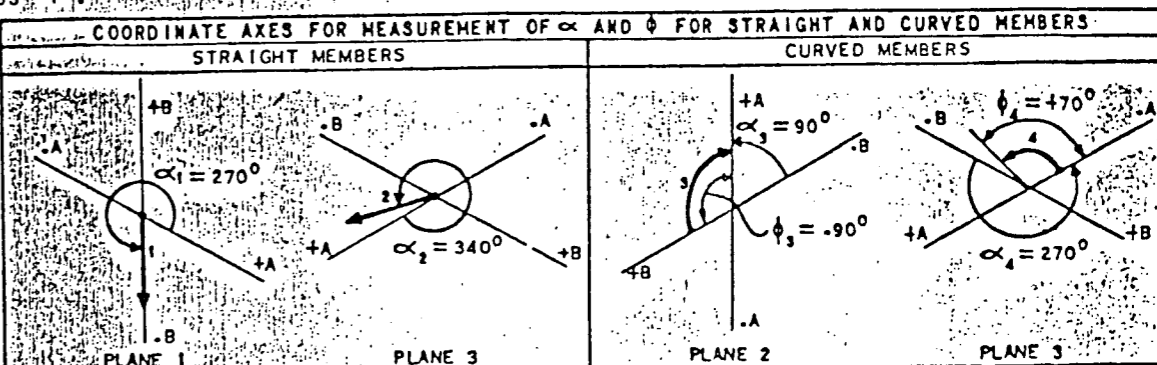

| | | | | | | | | | | |
|---|---|--------------------------------------|----------------------|--------------------------|---------------|-------------------------|-----------------|------------------------|--|--|
| NUMBER OF PROBLEMS IN RUN (FILL IN ON FIRST SHEET ONLY) | | | | | | | | | | |
| PROJECT | SAN ONOFRE | | | | | | | | | |
| NAME | W. D. GROSS | | | | | | | | | |
| LINE DESIG. | FIELDWATER SPHERE TO GEN E-JB X ACCELERATION .5G CASE 1 | | | | | | | | | |
| SHAPE COEFFICIENT CHECK | MODULUS OF ELASTICITY (PSI) | EXPANSION COEFFICIENT (IN/IN/DEG. F) | NUMBER OF RESTRAINTS | NO. OF TYPE 1 & 3 RESTR. | NO. OF PASSES | PRINT SHAPE COEFFICIENT | PRINT EQUATIONS | ALLOWABLE STRESS (PSI) | | |
| 101.0 | 27900000 | 0.00000638 | 10 | 4 | 16 | 0 | 0 | 0 | | |

| TYPE OF MEMBER | MEMBER NO. | STRAIGHT AND CURVED MEMBERS | | | | | | | | | | | ANCHOR DISPLACEMENT | | | | | | | | | | | | RESTRAINTS | | | | | | | | | | | |
|----------------|------------|-----------------------------|----------|------------------|-----------------|----------------------|-----------------------|-----------------------|----------------|----------------------|-----------------------------------|-----------------|---------------------|-----------------|----------------|----------------|----------------|---------------------|---------------------------------------|---|-----------------------------|--|--|--|------------|--|--|--|--|--|--|--|--|--|--|--|
| | | STRAIGHT OR CURVED | JUNCTION | ANCHORS & RESTR. | PLANE 1, 2 OR 3 | ANGLE α (DEG) | LENGTH OR RADIUS (FT) | OUTSIDE DIAMETER (IN) | THICKNESS (IN) | TEMP ΔT (F°) | ROTATION AND ϕ (+ OR -, DEG) | ΔX (IN) | ΔY (IN) | ΔZ (IN) | ϕX (DEG) | ϕY (DEG) | ϕZ (DEG) | DIRECTION 1, 2 OR 3 | DEFLECTION FOR TYPE 2 RESTRAINTS (IN) | FORCE FOR TYPES 1 & 3 RESTRAINTS ONLY (LBS) | TYPE OF RESTRAINT 1, 2 OR 3 | | | | | | | | | | | | | | | |
| 75 | 1 | 2 | 1 | 2 | 270 | 18.27 | 10.75 | .5 | 1 | | 0.00 | 0.00 | 0.00 | . | . | . | 1 | | 2052 | 1 | | | | | | | | | | | | | | | | |
| 100 | 2 | 2 | 2 | 2 | 180 | 3.09 | 30. | 9. | | | | | | | | | | 2 | | | 2 | | | | | | | | | | | | | | | |
| 100 | 3 | 2 | 2 | 2 | 0 | 3.09 | | | | | | | | | | | | 2 | | | 2 | | | | | | | | | | | | | | | |
| 100 | 4 | 2 | 2 | 2 | 270 | 8.21 | 10.75 | .5 | | | | | | | | | | 2 | | | 2 | | | | | | | | | | | | | | | |
| 100 | 5 | 2 | 2 | 2 | 180 | 1.25 | | | | | | | | | | | | 2 | 000 | | 2 | | | | | | | | | | | | | | | |
| 100 | 6 | 2 | 2 | 2 | 180 | 1.5 | | | | | | | | | | | | 2 | 000 | | 2 | | | | | | | | | | | | | | | |
| 100 | 7 | 2 | 2 | 2 | 180 | 16.25 | | | | | | | | | | | | 2 | | | 2 | | | | | | | | | | | | | | | |
| 100 | 8 | 2 | 2 | 2 | 270 | 1.25 | | | | | | | | | | | | 2 | 000 | | 2 | | | | | | | | | | | | | | | |
| 100 | 9 | 2 | 2 | 2 | 270 | 43.25 | | | | | | | | | | | | 1 | 000 | | 2 | | | | | | | | | | | | | | | |
| 100 | 10 | 2 | 2 | 2 | 0 | 2.18 | 30. | 9. | | | | | | | | | | 1 | | 5820 | 1 | | | | | | | | | | | | | | | |
| 100 | 11 | 2 | 2 | 2 | 180 | 2.18 | | | | | | | | | | | | 1 | | | 2 | | | | | | | | | | | | | | | |
| 100 | 12 | 2 | 2 | 2 | 270 | 44.25 | 10.75 | .5 | | | | | | | | | | 2 | | | 2 | | | | | | | | | | | | | | | |
| 100 | 13 | 2 | 2 | 2 | 0 | 28.25 | | | | | | | | | | | | 2 | 000 | | 2 | | | | | | | | | | | | | | | |
| 100 | 14 | 2 | 2 | 2 | 0 | .63 | | | | | | | | | | | | 1 | | 1212 | 1 | | | | | | | | | | | | | | | |
| 100 | 15 | 2 | 2 | 2 | 0 | 11.37 | | | | | | | | | | | | 3 | 000 | | 2 | | | | | | | | | | | | | | | |
| 100 | 16 | 2 | 2 | 2 | 0 | 1.25 | | | | | | | | | | | | 1 | | | 2 | | | | | | | | | | | | | | | |
| 100 | 17 | 3 | 3 | 3 | 90 | 3.52 | | | | | | | | | | | | 1 | | | 2 | | | | | | | | | | | | | | | |
| 100 | 18 | 3 | 3 | 3 | 45 | 3.26 | | | | | | | | | | | | 1 | | | 2 | | | | | | | | | | | | | | | |
| 100 | 19 | 3 | 3 | 3 | 270 | .54 | 30. | 9. | | | | | | | | | | 1 | | 652 | 1 | | | | | | | | | | | | | | | |
| 100 | 20 | 3 | 3 | 3 | 90 | .54 | | | | | | | | | | | | 1 | | | 2 | | | | | | | | | | | | | | | |
| 100 | 21 | 3 | 3 | 3 | 45 | 7.79 | 10.75 | .5 | | | | | | | | | | 1 | | | 2 | | | | | | | | | | | | | | | |
| 100 | 22 | 3 | 3 | 3 | 0 | 1.52 | | | | | | | | | | | | 1 | | | 2 | | | | | | | | | | | | | | | |

PIPING FLEXIBILITY ANALYSIS

SAN ONOFRE FEEDWATER SPHERE TO GEN E-IB X ACCELERATION .5G CASE 1

W D GROSS ENGINEERING DEPT. PROGRAM ENGR 33

DECEMBER 29, 1964 SHEET 1

MODULUS OF ELASTICITY= 27900000. PSI EXPANSION COEFFICIENT= 0.00000638 IN/IN/DEG F ALLOWABLE STRESS= -0. PSI

STRAIGHT OR CURVED MEMBERS ANCHORS AND RESTRAINTS

MEMB. NO. ALPHA DEG. LENGTH OR RADIUS, FT. O.D. IN. THICK. IN. TEMP. DEG. F. PHI DEG. (PHI X, Y, Z IN DEGREES---DELTA X, Y, Z IN INCHES)

| MEMB. NO. | ALPHA DEG. | LENGTH OR RADIUS, FT. | O.D. IN. | THICK. IN. | TEMP. DEG. F. | PHI DEG. | ANCHOR NO. | PHI X | PHI Y | PHI Z | DELTA X | DELTA Y | DELTA Z | RESTRAINT NO. | TYPE | DIRECTION | DEFLECTION, IN. | FORCE, LBS. |
|-----------|------------|-----------------------|----------|------------|---------------|----------|------------|-------|-------|-------|---------|---------|---------|---------------|------|-----------|-----------------|-------------|
| 1 | 2 | 270. | 18.29 | 10.750 | 0.500 | 1. | NO. 1 | 0.000 | 0.000 | 0.000 | 0.000 | 0.000 | 0.000 | | | | | |
| 2 | 2 | 180. | 3.09 | 30.000 | 9.000 | 1. | | | | | | | | NO. 2 | 1 | 1 | 0.000 | -2052.00 |
| 3 | 2 | 0. | 3.09 | 30.000 | 9.000 | 1. | | | | | | | | | | | | |
| 4 | 2 | 270. | 8.21 | 10.750 | 0.500 | 1. | | | | | | | | | | | | |
| 5 | 2 | 180. | 1.25 | 10.750 | 0.500 | 1. | | | | | | | | NO. 3 | 2 | 2 | 0.000 | 0.00 |
| 6 | 2 | 180. | 15.00 | 10.750 | 0.500 | 1. | | | | | | | | NO. 4 | 2 | 3 | 0.000 | 0.00 |
| 7 | 2 | 180. | 16.25 | 10.750 | 0.500 | 1. | | | | | | | | | | | | |
| 8 | 2 | 270. | 1.25 | 10.750 | 0.500 | 1. | | | | | | | | NO. 5 | 2 | 2 | 0.000 | 0.00 |
| 9 | 2 | 270. | 43.25 | 10.750 | 0.500 | 1. | | | | | | | | | | | | |
| 10 | 2 | 0. | 2.18 | 30.000 | 9.000 | 1. | | | | | | | | NO. 6 | 2 | 1 | 0.000 | 0.00 |
| 11 | 2 | 180. | 2.18 | 30.000 | 9.000 | 1. | | | | | | | | | | | | |
| 12 | 2 | 270. | 44.25 | 10.750 | 0.500 | 1. | | | | | | | | | | | | |
| 13 | 2 | 0. | 28.25 | 10.750 | 0.500 | 1. | | | | | | | | NO. 7 | 1 | 1 | 0.000 | 5820.00 |
| 14 | 2 | 0. | 0.63 | 10.750 | 0.500 | 1. | | | | | | | | NO. 8 | 2 | 2 | 0.000 | 0.00 |
| 15 | 2 | 0. | 11.37 | 10.750 | 0.500 | 1. | | | | | | | | NO. 9 | 1 | 1 | 0.000 | 1212.00 |
| 16 | 2 | 0. | 1.25 | 10.750 | 0.500 | 1. | | | | | | | | NO. 10 | 2 | 3 | 0.000 | 0.00 |
| 17 | 3 | 90. | 3.52 | 10.750 | 0.500 | 1. | | | | | | | | | | | | |
| 18 | 3 | 45. | 3.76 | 10.750 | 0.500 | 1. | | | | | | | | | | | | |
| 19 | 3 | 270. | 0.54 | 30.000 | 9.000 | 1. | | | | | | | | | | | | |
| 20 | 3 | 90. | 0.54 | 30.000 | 9.000 | 1. | | | | | | | | NO. 11 | 1 | 1 | 0.000 | 652.00 |
| 21 | 3 | 45. | 4.78 | 10.750 | 0.500 | 1. | | | | | | | | | | | | |
| 22 | 3 | 0. | 1.52 | 10.750 | 0.500 | 1. | | | | | | | | | | | | |

TI APERTURE CARD

PIPING FLEXIBILITY ANALYSIS

STRAIGHT OR CURVED MEMBERS

ANCHORS AND RESTRAINTS

MEMB. ALPHA LENGTH OR O.D. THICK. TEMP. PHI
NO. PLANE DEG. RADIUS, FT. IN. IN. DEG. F. DEG.

(PHI X, Y, Z IN DEGREES---DELTA X, Y, Z IN INCHES)

| ANCHOR | PHI X | PHI Y | PHI Z | DELTA X | DELTA Y | DELTA Z |
|--------|-------|-------|-------|---------|---------|---------|
| NO. 12 | 0.000 | 0.000 | 0.000 | 0.000 | 0.000 | 0.000 |

TI
APERTURE
CARD

8504040294-66

Also Available On
Aperture Card

PIPING FLEXIBILITY ANALYSIS-ENGR 33
FEEDWATER SPHERE TO GEN E-IB X ACCELERATION .5G CASE 1 W D GROSS DECEMBER 29, 1964

| ANCHOR | X (FT) | Y (FT) | Z (FT) | EIDX (LB-FT*3) | EIDY (LB-FT*3) | EIDZ (LB-FT*3) |
|--------|-----------|-----------|-----------|-------------------|-------------------|-------------------|
| 12 | -107.69 ✓ | 9.56 ✓ | 9.00 ✓ | 28214.78 | -2504.35 | -2357.97 |

TEST NO. 5 CKAY OK

TI
APERTURE
CARD

8504040294-67

Also Available On
Aperture Card

PIPING FLEXIBILITY ANALYSIS-ENGR 33
FEEDWATER SPHERE TO GEN E-IB X ACCELERATION .5G CASE 1 W D GROSS DECEMBER 29, 1964

| RESTRAINT NUMBER TYPE 1 OR 3 -- TYPE 2 | DEFLECTION OR FORCE AT RESTRAINTS | |
|---|-----------------------------------|-----------------------------|
| | DEFLECTION (IN) | FORCE ON RESTRAINT (LBS) |
| 2 | .01103 | |
| 7 | .04453 | |
| 9 | .26264 | |
| 11 | .03420 | |
| 3 | | -7.43 7.43 |
| 4 | | 489.01 -489.01 |
| 5 | | -15.49 15.49 |
| 6 | | -6303.96 6303.96 |
| 8 | | 302.72 -302.72 |
| 10 | | 305.60 -305.60 |

| ANCHOR | TOTAL MOMENTS AND FORCES ON ANCHORS | | | | | |
|--------|-------------------------------------|----------------|----------------|-------------|-------------|-------------|
| | MX (FT-LBS) | MY (FT-LBS) | MZ (FT-LBS) | FX (LBS) | FY (LBS) | FZ (LBS) |
| 1 | -26.48 | 1797.89 | 100.15 | 1940.82 | -11.75 | 272.42 |
| 12 | -1567.12 | 281.53 | 7612.74 | 1491.22 | 291.54 | 522.19 |

| MEMBER | ROTATION AND DEFLECTION OF MEMBERS | | | | | |
|--------|------------------------------------|----------------|----------------|-----------------|-----------------|-----------------|
| | PHI X (DEG) | PHI Y (DEG) | PHI Z (DEG) | DELTA X (IN) | DELTA Y (IN) | DELTA Z (IN) |
| ORIGIN | .000 | .000 | .000 | .000 | .000 | .000 |
| 1 | -.001 | -.018 | -.000 | -.000 | -.001 | .007 |
| 2 | -.001 | -.013 | -.000 | .011 | -.002 | .007 |
| 3 | -.001 | -.018 | -.000 | -.000 | -.001 | .007 |
| 4 | -.001 | .006 | -.002 | -.001 | .000 | .001 |
| 5 | -.001 | .007 | -.003 | -.003 | -.000 | .001 |
| 6 | -.001 | .006 | -.008 | -.033 | -.004 | -.000 |
| 7 | .001 | -.035 | -.015 | .004 | -.004 | -.001 |
| 8 | .001 | -.039 | -.015 | .003 | .000 | -.011 |
| 9 | .011 | .097 | -.013 | -.000 | .150 | -.174 |
| 10 | .011 | .097 | -.013 | .045 | .145 | -.174 |
| 11 | .011 | .097 | -.013 | .000 | .150 | -.174 |
| 12 | .021 | .039 | .018 | -.003 | .150 | -.003 |
| 13 | .032 | -.018 | .057 | .265 | .000 | -.001 |
| 14 | .032 | -.024 | .058 | .263 | -.004 | -.001 |
| 15 | .010 | -.058 | .074 | .134 | -.066 | .000 |
| 16 | .004 | -.052 | .076 | .120 | -.068 | .000 |
| 17 | -.008 | -.029 | .072 | .064 | -.067 | -.002 |
| 18 | -.011 | -.012 | .057 | .028 | -.031 | .003 |
| 19 | -.011 | -.012 | .057 | .034 | -.031 | .004 |
| 20 | -.011 | -.012 | .057 | .028 | -.031 | .003 |
| 21 | -.004 | -.000 | .017 | -.000 | -.003 | .000 |
| 22 | -.000 | -.000 | -.000 | -.000 | .000 | -.000 |

FI
APERTURE
CARD

STRESS, MOMENTS AND FORCES ON MEMBERS

| MEMBER START/END | STRESS (PSI) | MX (FT-LBS) | MY (FT-LBS) | MZ (FT-LBS) | FX (LBS) | FY (LBS) | FZ (LBS) |
|---------------------|-----------------|----------------|----------------|----------------|-------------|-------------|-------------|
| 1 | 548.03 | -26.48 | 1797.89 | 100.15 | 1940.82 | -11.75 | 272.42 |
| | 969.81 | -26.48 | -3184.68 | -114.70 | 1940.82 | -11.75 | 272.42 |
| 2 | 14.91 | -26.48 | -3184.68 | -114.70 | 1940.82 | -11.75 | 272.42 |
| | 13.08 | 9.82 | 2812.45 | -114.70 | 1940.82 | -11.75 | 272.42 |
| 3 | 13.08 | 9.82 | 2812.45 | -114.70 | -111.18 | -11.75 | 272.42 |
| | 14.67 | -26.48 | 3156.00 | -114.70 | -111.18 | -11.75 | 272.42 |
| 4 | 961.09 | -26.48 | 3156.00 | -114.70 | -111.18 | -11.75 | 272.42 |
| | 287.19 | -26.48 | 919.42 | -211.14 | -111.18 | -11.75 | 272.42 |
| 5 | 287.19 | -26.48 | 919.42 | -211.14 | -111.18 | -11.75 | 272.42 |
| | 246.07 | -11.79 | 780.45 | -211.14 | -111.18 | -11.75 | 272.42 |
| 6 | 246.07 | -11.79 | 780.45 | -211.14 | -111.18 | -4.31 | 272.42 |
| | 278.01 | 52.88 | -887.24 | -211.14 | -111.18 | -4.31 | 272.42 |
| 7 | 278.01 | 52.88 | -887.24 | -211.14 | -111.18 | -4.31 | -216.58 |
| | 823.17 | 122.95 | -2693.90 | -211.14 | -111.18 | -4.31 | -216.58 |
| 8 | 823.17 | 122.95 | -2693.90 | -211.14 | -111.18 | -4.31 | -216.58 |
| | 741.30 | 122.95 | -2423.17 | -216.53 | -111.18 | -4.31 | -216.58 |
| 9 | 741.30 | 122.95 | -2423.17 | -216.53 | -111.18 | 11.17 | -216.58 |
| | 2115.10 | 122.95 | 6944.12 | 266.78 | -111.18 | 11.17 | -216.58 |
| 10 | 32.29 | 122.95 | 6944.11 | 266.78 | 6192.78 | 11.17 | -216.58 |
| | 30.49 | 147.31 | -6556.15 | 266.78 | 6192.78 | 11.17 | -216.58 |
| 11 | 30.49 | 147.31 | -6556.14 | 266.78 | 372.78 | 11.17 | -216.58 |
| | 26.72 | 122.95 | -5743.49 | 266.78 | 372.78 | 11.17 | -216.58 |
| 12 | 1750.12 | 122.95 | -5743.49 | 266.78 | 372.78 | 11.17 | -216.58 |
| | 1192.02 | 122.95 | 3840.39 | 761.26 | 372.78 | 11.17 | -216.58 |
| 13 | 1192.02 | 122.95 | 3840.39 | 761.26 | 372.78 | 11.17 | -216.58 |
| | 2053.55 | 438.63 | -6690.61 | 761.26 | 372.78 | 11.17 | -216.58 |
| 14 | 2053.55 | 438.63 | -6690.61 | 761.26 | 372.78 | -291.54 | -216.58 |
| | 2121.65 | 254.96 | -6925.47 | 761.26 | 372.78 | -291.54 | -216.58 |
| 15 | 2121.65 | 254.96 | -6925.47 | 761.26 | -839.22 | -291.54 | -216.58 |
| | 1246.89 | -3059.86 | 2616.48 | 761.26 | -839.22 | -291.54 | -216.58 |
| 16 | 1246.89 | -3059.86 | 2616.48 | 761.26 | -839.22 | -291.54 | -522.19 |
| | 1543.98 | -3424.29 | 3665.50 | 761.26 | -839.22 | -291.54 | -522.19 |
| 17 | 1543.98 | -3424.29 | 3665.50 | 761.26 | -839.22 | -291.54 | -522.19 |
| | 1386.57 | -1586.20 | 3665.50 | -2192.80 | -839.22 | -291.54 | -522.19 |
| 18 | 1386.57 | -1586.20 | 3665.50 | -2192.80 | -839.22 | -291.54 | -522.19 |
| | 1310.30 | -197.85 | 2277.16 | -3648.92 | -839.22 | -291.54 | -522.19 |
| 19 | 20.00 | -197.85 | 2277.16 | -3648.92 | -839.22 | -291.54 | -522.19 |
| | 18.37 | -479.83 | 2277.16 | -3195.74 | -839.22 | -291.54 | -522.19 |
| 20 | 18.37 | -479.83 | 2277.16 | -3195.74 | -1491.22 | -291.54 | -522.19 |
| | 21.41 | -197.85 | 2277.16 | -4001.00 | -1491.22 | -291.54 | -522.19 |
| 21 | 1402.26 | -197.85 | 2277.16 | -4001.00 | -1491.22 | -291.54 | -522.19 |
| | 2502.36 | 1567.12 | 512.19 | -8055.89 | -1491.22 | -291.54 | -522.19 |
| 22 | 2502.36 | 1567.12 | 512.19 | -8055.89 | -1491.22 | -291.54 | -522.19 |
| | 2366.31 | 1567.12 | -281.53 | -7612.74 | -1491.22 | -291.54 | -522.19 |

TI
APERTURE
CARD

8504040294-69

Also Available On
Aperture Card

PIPING FLEXIBILITY ANALYSIS

10

SAN ONOFRE FEEDWATER SPHERE TO GEN E-1B Z ACCELERATION .5G CASE 1 W D GROSS ENGINEERING DEPT. PROGRAM ENGR 33 DECEMBER 29, 1964 SHEET 1

MODULUS OF ELASTICITY= 27900000. PSI EXPANSION COEFFICIENT= 0.00000638 IN/IN/DEG F ALLOWABLE STRESS= -0. PSI

STRAIGHT OR CURVED MEMBERS ANCHORS AND RESTRAINTS

| MEMB NO. | ALPHA PLANE DEG. | LENGTH OR RADIUS, FT. | O.D. IN. | THICK. IN. | TEMP. DEG. F. | PHI DEG. | ANCHOR NO. | PHI X | PHI Y | PHI Z | DELTA X | DELTA Y | DELTA Z |
|----------|------------------|-----------------------|----------|------------|---------------|----------|------------------|-------|-------|-------|---------|---------|---------|
| 1 | 2 | 270. | 18.29 | 10.750 | 0.500 | 1. | NO. 1 | 0.000 | 0.000 | 0.000 | 0.000 | 0.000 | 0.000 |
| 2 | 2 | 180. | 3.09 | 30.000 | 9.000 | 1. | | | | | | | |
| 3 | 2 | 0. | 3.09 | 30.000 | 9.000 | 1. | RESTRAINT NO. 2 | 1 | 3 | | 0.000 | | 2058.00 |
| 4 | 2 | 270. | 8.21 | 10.750 | 0.500 | 1. | | | | | | | |
| 5 | 2 | 180. | 1.25 | 10.750 | 0.500 | 1. | | | | | | | |
| 6 | 2 | 180. | 15.00 | 10.750 | 0.500 | 1. | RESTRAINT NO. 3 | 2 | 2 | | 0.000 | | 0.00 |
| 7 | 2 | 180. | 16.25 | 10.750 | 0.500 | 1. | | | | | | | |
| 8 | 2 | 270. | 1.25 | 10.750 | 0.500 | 1. | RESTRAINT NO. 4 | 2 | 3 | | 0.000 | | 0.00 |
| 9 | 2 | 270. | 43.25 | 10.750 | 0.500 | 1. | RESTRAINT NO. 5 | 2 | 2 | | 0.000 | | 0.00 |
| 10 | 2 | 0. | 2.18 | 30.000 | 9.000 | 1. | RESTRAINT NO. 6 | 2 | 1 | | 0.000 | | 0.00 |
| 11 | 2 | 180. | 2.18 | 30.000 | 9.000 | 1. | RESTRAINT NO. 7 | 1 | 3 | | 0.000 | | 5820.00 |
| 12 | 2 | 270. | 44.25 | 10.750 | 0.500 | 1. | | | | | | | |
| 13 | 2 | 0. | 28.25 | 10.750 | 0.500 | 1. | | | | | | | |
| 14 | 2 | 0. | 0.63 | 10.750 | 0.500 | 1. | RESTRAINT NO. 8 | 2 | 2 | | 0.000 | | 0.00 |
| 15 | 2 | 0. | 11.37 | 10.750 | 0.500 | 1. | RESTRAINT NO. 9 | 1 | 3 | | 0.000 | | 1212.00 |
| 16 | 2 | 0. | 1.25 | 10.750 | 0.500 | 1. | RESTRAINT NO. 10 | 2 | 3 | | 0.000 | | 0.00 |
| 17 | 3 | 90. | 3.52 | 10.750 | 0.500 | 1. | | | | | | | |
| 18 | 3 | 45. | 3.76 | 10.750 | 0.500 | 1. | | | | | | | |
| 19 | 3 | 270. | 0.54 | 30.000 | 9.000 | 1. | | | | | | | |
| 20 | 3 | 90. | 0.54 | 30.000 | 9.000 | 1. | RESTRAINT NO. 11 | 1 | 3 | | 0.000 | | 652.00 |
| 21 | 3 | 45. | 4.78 | 10.750 | 0.500 | 1. | | | | | | | |
| 22 | 3 | 0. | 1.52 | 10.750 | 0.500 | 1. | | | | | | | |

TI APERTURE CARD

PIPING FLEXIBILITY ANALYSIS

STRAIGHT OR CURVED MEMBERS

ANCHORS AND RESTRAINTS

MEMB. NO. ALPHA PLANE DEG. LENGTH OR RADIUS, FT. O.D. IN. THICK. IN. TEMP. DEG.F. PHI DEG. (PHI X,Y,Z IN DEGREES---DELTA X,Y,Z IN INCHES)

ANCHOR NO.12 PHI X 0.000 PHI Y 0.000 PHI Z 0.000 DELTA X 0.000 DELTA Y 0.000 DELTA Z 0.000

TI APERTURE CARD

8504040294-71

Also Available On Aperture Card

12

PIPING FLEXIBILITY ANALYSIS-ENGR. 33
FEEDWATER SPHERE TO GEN E-1B Z ACCELERATION .5G CASE 1 W D GROSS DECEMBER 29, 1964

| ANCHOR | X (FT) | Y (FT) | Z (FT) | EIDX (LB-FT*3) | EIDY (LB-FT*3) | EIDZ (LB-FT*3) |
|--------|-----------|-----------|-----------|-------------------|-------------------|-------------------|
| 12 | -107.69 | 9.56 | 9.00 | 28214.78 | -2504.35 | -2357.97 |

TEST NO. 5 OKAY

TI
APERTURE
CARD

8504040294-72

Also Available On
Aperture Card

| RESTRAINT NUMBER | | DEFLECTION OR FORCE AT RESTRAINTS | |
|------------------|--------|-----------------------------------|--------------------------|
| TYPE 1 OR 3 | TYPE 2 | DEFLECTION (IN) | FORCE ON ORIGIN (LBS) |
| 2 | | .20537 | |
| 7 | | 9.85970 | |
| 9 | | .00036 | |
| 11 | | -.00107 | |
| | 3 | | 10.32 |
| | 4 | | -3314.55 |
| | 5 | | 22.93 |
| | 6 | | 615.10 |
| | 8 | | -702.68 |
| | 10 | | -5713.80 |
| | | | FORCE ON RESTRAINT (LBS) |
| | | | -10.32 |
| | | | 3314.55 |
| | | | -22.93 |
| | | | -615.10 |
| | | | 702.68 |
| | | | 5713.80 |

| TOTAL MOMENTS AND FORCES ON ANCHORS | | | | | | |
|-------------------------------------|-------------|-------------|-------------|----------|----------|----------|
| ANCHOR | MX (FT-LBS) | MY (FT-LBS) | MZ (FT-LBS) | FX (LBS) | FY (LBS) | FZ (LBS) |
| 1 | 41.13 | 14527.34 | -147.47 | 2107.82 | 17.33 | 1707.39 |
| 12 | 4724.69 | 3534.49 | -8005.33 | -1492.71 | -686.77 | -993.73 |

| ROTATION AND DEFLECTION OF MEMBERS | | | | | | |
|------------------------------------|-------------|-------------|-------------|--------------|--------------|--------------|
| MEMBER | PHI X (DEG) | PHI Y (DEG) | PHI Z (DEG) | DELTA X (IN) | DELTA Y (IN) | DELTA Z (IN) |
| ORIGIN | .000 | .000 | .000 | .000 | .000 | .000 |
| 1 | .001 | -.028 | .000 | -.000 | .002 | .206 |
| 2 | .001 | -.028 | .000 | .018 | .003 | .205 |
| 3 | .001 | -.028 | .000 | -.001 | .002 | .206 |
| 4 | .002 | -.203 | .003 | -.001 | -.001 | .001 |
| 5 | .002 | -.225 | .004 | .056 | -.000 | .001 |
| 6 | .001 | -.128 | .012 | .788 | .006 | .000 |
| 7 | -.002 | .723 | .021 | .001 | .006 | .000 |
| 8 | -.002 | .815 | .022 | .001 | -.000 | .202 |
| 9 | -.018 | .024 | .021 | .000 | -.224 | 9.860 |
| 10 | -.018 | .022 | .021 | .011 | -.216 | 9.860 |
| 11 | -.018 | .021 | .021 | .001 | -.224 | 9.860 |
| 12 | -.034 | -.845 | -.024 | -.001 | -.242 | .000 |
| 13 | -.051 | .262 | -.079 | -.898 | -.000 | .000 |
| 14 | -.051 | .268 | -.080 | -.863 | .007 | .000 |
| 15 | .007 | .230 | -.102 | -.215 | .085 | -.000 |
| 16 | .021 | .209 | -.105 | -.157 | .081 | .000 |
| 17 | .049 | .127 | -.097 | -.080 | .081 | .028 |
| 18 | .043 | .064 | -.069 | -.033 | .035 | .004 |
| 19 | .043 | .064 | -.069 | -.041 | .035 | -.001 |
| 20 | .043 | .064 | -.069 | -.033 | .035 | .004 |
| 21 | .013 | .009 | -.018 | -.000 | .003 | .001 |
| 22 | .000 | -.000 | .000 | .000 | -.000 | -.000 |

TI
APERTURE
CARD

8504040294-73


Also Available On
Aperture Card

PIPING FLEXIBILITY ANALYSIS-ENGR 33
FEEDWATER SPHERE TO GEN E-IB Z ACCELERATION .5G CASE 1 W D GROSS DECEMBER 29, 1964

| MEMBER START/END | STRESS (PSI) | STRESS, MOMENTS AND FORCES ON MEMBERS | | | | | |
|---------------------|-----------------|---------------------------------------|----------------|----------------|-------------|-------------|-------------|
| | | MX (FT-LBS) | MY (FT-LBS) | MZ (FT-LBS) | FX (LBS) | FY (LBS) | FZ (LBS) |
| 1 | 4421.16 | 41.13 | 14527.34 | -147.47 | 2107.82 | 17.33 | 1707.38 |
| | 5082.56 | 41.13 | -16700.64 | 169.48 | 2107.82 | 17.33 | 1707.38 |
| 2 | 77.60 | 41.13 | -16700.64 | 169.48 | 2107.82 | 17.33 | 1707.38 |
| | 47.34 | -12.42 | -10187.49 | 169.48 | 2107.82 | 17.33 | 1707.38 |
| 3 | 47.34 | -12.42 | -10187.49 | 169.48 | 2107.82 | 17.33 | -350.62 |
| | 77.60 | 41.13 | -16700.64 | 169.48 | 2107.82 | 17.33 | -350.62 |
| 4 | 5082.56 | 41.13 | -16700.64 | 169.48 | 2107.82 | 17.33 | -350.62 |
| | 4207.37 | 41.13 | -13822.05 | 311.75 | 2107.82 | 17.33 | -350.62 |
| 5 | 4207.37 | 41.13 | -13822.05 | 311.75 | 2107.82 | 17.33 | -350.62 |
| | 3405.80 | 19.47 | -11187.28 | 311.75 | 2107.82 | 17.33 | -350.62 |
| 6 | 3405.80 | 19.47 | -11187.28 | 311.75 | 2107.82 | 7.01 | -350.62 |
| | 6217.96 | -85.69 | 20429.97 | 311.75 | 2107.82 | 7.01 | -350.62 |
| 7 | 6217.96 | -85.69 | 20429.97 | 311.75 | 2107.82 | 7.01 | 2963.93 |
| | 16641.03 | -199.62 | 54681.98 | 311.75 | 2107.82 | 7.01 | 2963.93 |
| 8 | 16641.03 | -199.62 | 54681.98 | 311.75 | 2107.82 | 7.01 | 2963.93 |
| | 15513.61 | -199.62 | 50977.07 | 320.51 | 2107.82 | 7.01 | 2963.93 |
| 9 | 15513.61 | -199.62 | 50977.07 | 320.51 | 2107.82 | -15.91 | 2963.93 |
| | 23497.52 | -199.62 | -77212.85 | -367.77 | 2107.82 | -15.91 | 2963.93 |
| 10 | 358.74 | -199.62 | -77212.85 | -367.77 | 1492.71 | -15.91 | 2963.93 |
| | 373.86 | -234.31 | -80466.96 | -367.77 | 1492.71 | -15.91 | 2963.93 |
| 11 | 373.86 | -234.31 | -80466.96 | -367.77 | 1492.71 | -15.91 | -2856.07 |
| | 358.74 | -199.62 | -77212.85 | -367.77 | 1492.71 | -15.91 | -2856.07 |
| 12 | 23497.52 | -199.62 | -77212.85 | -367.77 | 1492.71 | -15.91 | -2856.07 |
| | 14966.42 | -199.62 | 49168.29 | -1071.98 | 1492.71 | -15.91 | -2856.07 |
| 13 | 14966.42 | -199.62 | 49168.29 | -1071.98 | 1492.71 | -15.91 | -2856.07 |
| | 2163.85 | -649.20 | 6999.20 | -1071.98 | 1492.71 | -15.91 | -2856.07 |
| 14 | 2163.85 | -649.20 | 6999.20 | -1071.97 | 1492.71 | 686.77 | -2856.07 |
| | 1873.59 | -216.53 | 6058.79 | -1071.97 | 1492.71 | 686.77 | -2856.07 |
| 15 | 1873.59 | -216.53 | 6058.79 | -1071.97 | 1492.71 | 686.77 | -4068.07 |
| | 4058.83 | 7592.02 | -10913.34 | -1071.97 | 1492.71 | 686.77 | -4068.07 |
| 16 | 4058.83 | 7592.02 | -10913.34 | -1071.97 | 1492.71 | 686.77 | 1645.73 |
| | 4673.70 | 8450.48 | -12779.23 | -1071.97 | 1492.71 | 686.77 | 1645.73 |
| 17 | 4673.70 | 8450.48 | -12779.23 | -1071.97 | 1492.71 | 686.77 | 1645.73 |
| | 4171.07 | 2657.52 | -12779.23 | 4182.37 | 1492.71 | 686.77 | 1645.73 |
| 18 | 4171.07 | 2657.52 | -12779.23 | 4182.37 | 1492.71 | 686.77 | 1645.73 |
| | 3243.24 | -1718.00 | -8403.71 | 6325.15 | 1492.71 | 686.77 | 1645.73 |
| 19 | 49.51 | -1718.00 | -8403.71 | 6325.15 | 1492.71 | 686.77 | 1645.73 |
| | 46.87 | -829.31 | -8403.71 | 5519.08 | 1492.71 | 686.77 | 1645.73 |
| 20 | 46.87 | -829.31 | -8403.71 | 5519.08 | 1492.71 | 686.77 | 993.73 |
| | 49.28 | -1365.92 | -8403.71 | 6325.15 | 1492.71 | 686.77 | 993.73 |
| 21 | 3227.70 | -1365.92 | -8403.71 | 6325.15 | 1492.71 | 686.77 | 993.73 |
| | 3465.24 | -4724.69 | -5044.94 | 9049.21 | 1492.71 | 686.77 | 993.73 |
| 22 | 3465.24 | -4724.69 | -5044.94 | 9049.21 | 1492.71 | 686.77 | 993.73 |
| | 3026.39 | -4724.69 | -3534.48 | 8005.33 | 1492.71 | 686.77 | 993.73 |

TI
APERTURE
CARD

SHT. 37
23

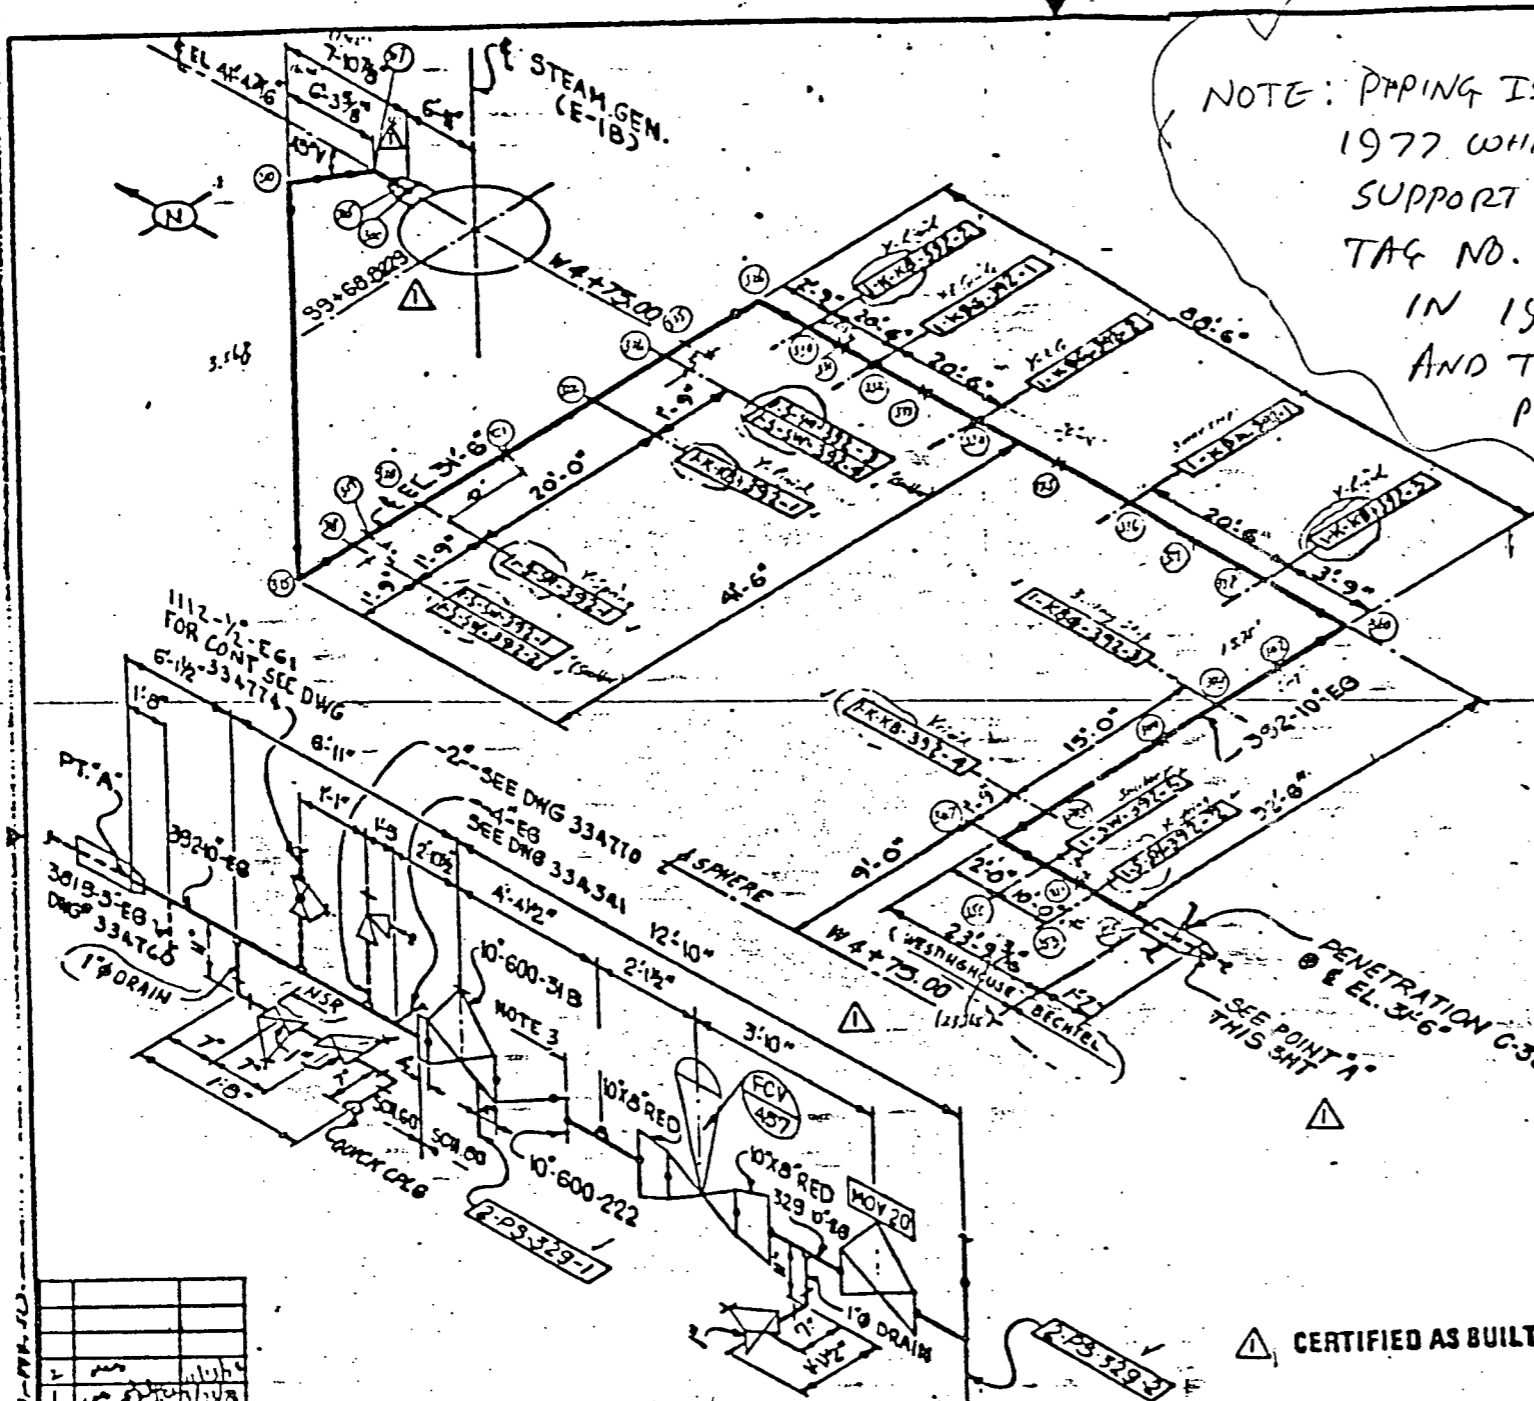

NOTE: PIPING ISOMETRIC WAS DRAWN IN 1977 WHICH REFLECTS THE PIPING SUPPORT LOCATIONS, TYPES, AND TAG NO. AS DESIGNED AND INSTALLED IN 1965/66. THESE SUPPORT LOCATIONS AND TYPES ^{HAVE BEEN} REVERIFIED IN 79-14 PROGRAM.

- NOTES:
1. FOR PIPE SUPPORT AND HANGER DETAILS, SEE M-31736
 2. COMPLETE LINE INSULATED - UNABLE TO VERIFY FITTINGS.
 3. PRESSURE BOUNDARY FOR BOP PROGRAM
 4. WESTINGHOUSE / BECHTEL SCOPE OF ANALYSIS AS SHOWN.

△ CLASS 2 PIPING

SAFETY RELATED
(EXCEPT AS NOTED)
BOP-SEISMIC REEVALUATION
ANALYSIS BOUNDARY-ISOMETRIC

△ CERTIFIED AS BUILT

| | | |
|-----|-------|----------|
| NO. | SCALE | DATE |
| 1 | | 11/17/77 |
| 2 | | 11/17/77 |
| 3 | | 11/17/77 |
| 4 | | 11/17/77 |

BECHTEL CORPORATION
ENGINEERS & CONSTRUCTORS
LOS ANGELES, CALIF.

JOB NO. 12186001
DATE 11/17/77
APPROVED

| NO. | REVISIONS | DATE | BY | CHK. | APP. | DATE | BY | CHK. | APP. |
|-----|-----------------------------------|----------|-----|------|------|------|-----|------|----------|
| 2 | INCORPORATED CCN #1 (NEW D.R. NA) | 01-17-77 | JCB | DS | | | N/A | | 18A |
| 1 | INCORPORATED DCN #1 & #2 | 7-29-78 | SMO | SA | | | N/A | | PKK/AY |
| 0 | AS BUILT (OLD P&A 456494) | 9-9-77 | ZS | RWM | | | N/A | | 11/17/77 |

10. NO. SAN ONOFRE NUCLEAR GENERATING STATION
P&E ISOMETRIC-LINE # 392-10-EG FROM FCV-457 THRU PEN. C-30 TO STM. GEN. E-18
SOUTHERN CALIFORNIA EDISON COMPANY
SCALE NONE

△ 334538-2

TI
APERTURE
CARD


17X

8504040294-75



PIPING FLEXIBILITY CALCULATION

BECHTEL CORPORATION
4550 SEVILLE AVENUE
VERNON, CALIFORNIA

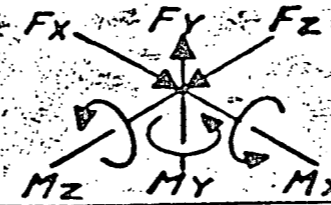

Sc = _____
Sh = _____
SA = 1.25Sc + .25Sh
SA = _____

MAXIMUM STRESS
AT POINT

PAGE 1 OF 24
3246-14

SIGNATURE W. I. [unclear] DATE 3-23-65
PROJECT SAH ONDRE JOB NO. 3256
SUBJECT FEEDWATER INSIDE SHELF X ASS. LOG STM GEN. E-1C


CONVENTION FOR
POSITIVE
FORCES & MOMENTS

DESIGN DATA
PRESS. _____
TEMP. ΔT = 10°F FOR SEISMIC ANALYSIS
MAT'L. CARB. STL.
EXP. COEF. .00000609
Ec x 10⁶ 29.9

MEMBER DATA
10.75" O.D. x .500" W.T. 1 → 9, 7 → 18, 17, 26, 27, 28 → 30, 33 → 36
8.625" O.D. x .500" W.T. 23 & 25
2" O.D. x .20" W.T. 6, 16, 29, & 29
30" O.D. x 9" W.T. 5, 18, 19, 22, 26, 31, & 32

ANCHOR DATA

| ANCHOR | | COORDINATES | | | END DEFLECTION | | |
|--------|-----|-------------|--------|--------|----------------|----|----|
| No. | Pt. | X | Y | Z | ΔX | ΔY | ΔZ |
| A1 | 0 | 0 | 0 | 0 | 0 | 0 | 0 |
| A4 | 6 | 0 | -1.42' | 28.75' | 0 | 0 | 0 |
| A10 | 10 | -33.69' | 2.00' | 28.60' | 0 | 0 | 0 |
| A13 | 24 | -38.42' | 6.50' | 47.50' | 0 | 0 | 0 |
| A14 | 27 | -38.39' | 2.00' | 53.78' | 0 | 0 | 0 |
| A16 | 36 | -35.68' | 9.92' | 49.96' | 0 | 0 | 0 |

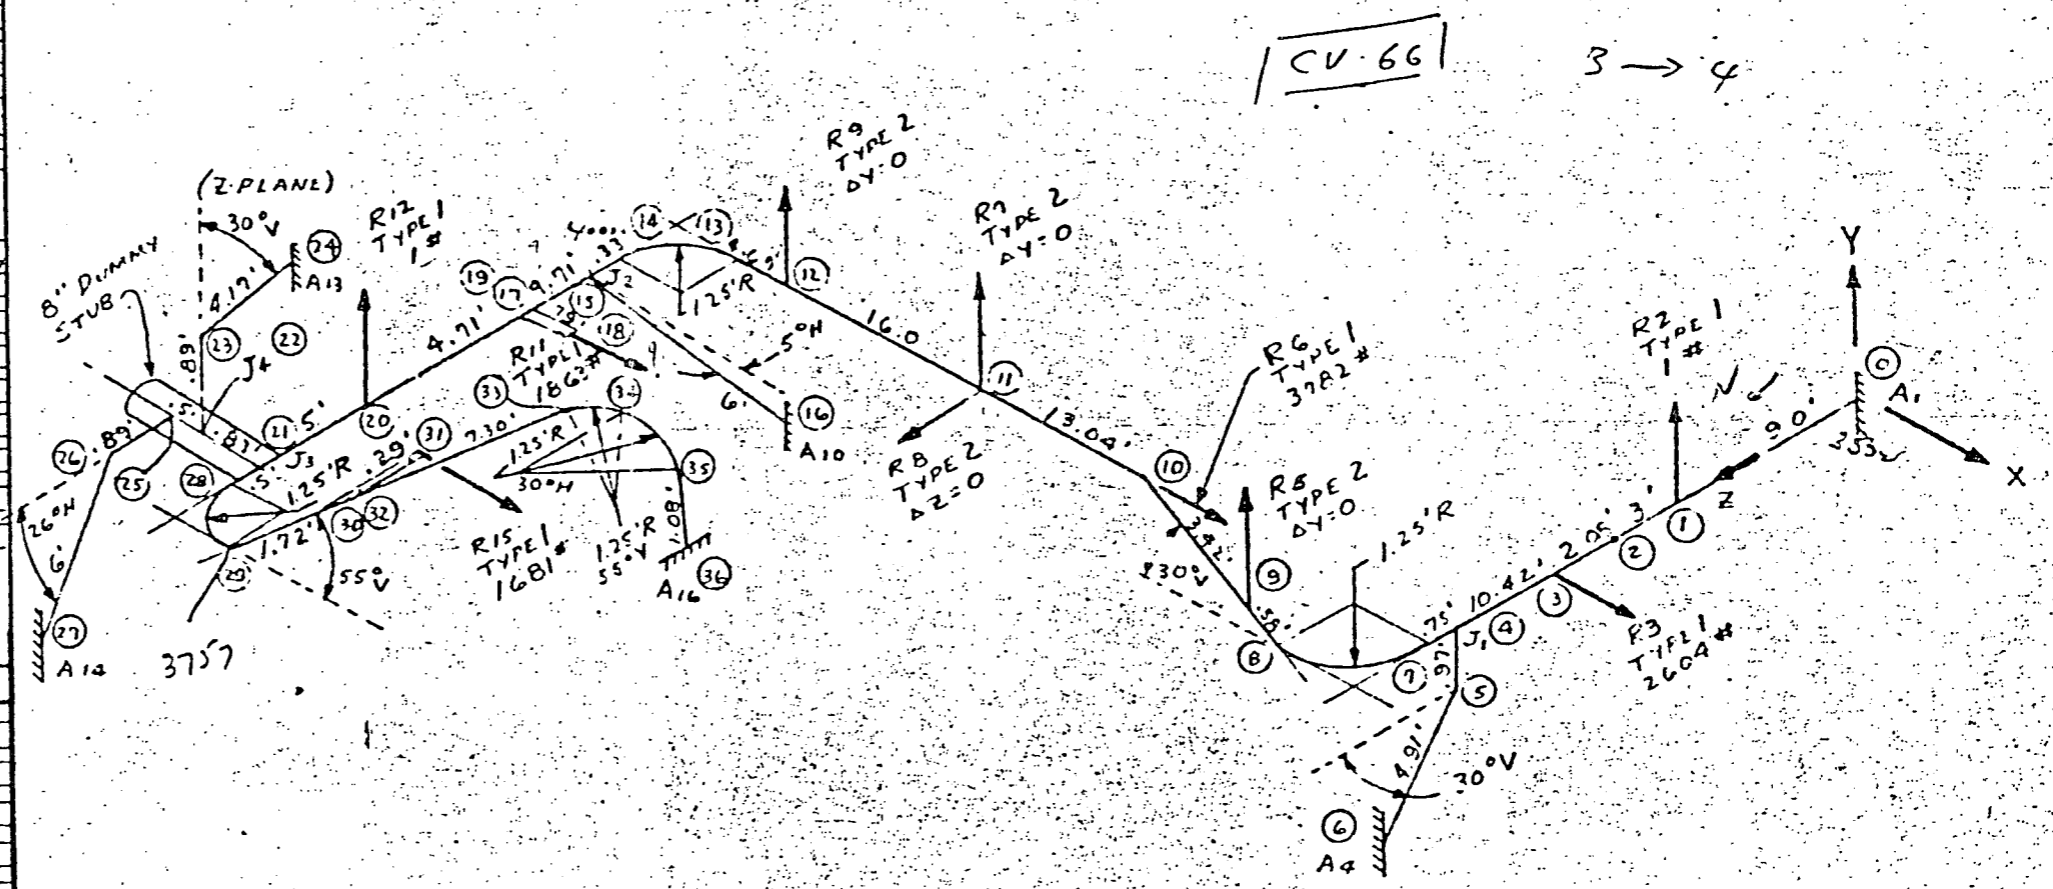

Also Available On
Aperture Card

TI
APERTURE
CARD

8504040294-76

FEEDWATER INSIDE SPHERE X ACC 1.0G STM GEN E-1C CASE 1 W D GROSS FEB 23, 1965

PIPING FLEXIBILITY ANALYSIS-ENGR 33

| RESTRAINT NUMBER | DEFLECTION OR FORCE AT RESTRAINTS | FORCE ON ORIGIN | FORCE ON RESTRAINT |
|-----------------------|-----------------------------------|-----------------|--------------------|
| TYPE 1 OR 3 -- TYPE 2 | DEFLECTION (IN) | (LBS) | (LBS) |
| 2 | .00189 | | |
| 3 | .12662 | | |
| 6 | .02602 | | |
| 11 | .11670 | | |
| 12 | -.04310 | | |
| 15 | .10476 | | |
| 5 | | -86.50 | 86.50 |
| 7 | | 217.56 | -217.56 |
| 8 | | 330.63 | -330.63 |
| 9 | | -185.73 | 185.73 |

| ANCHOR | MX (FT-LBS) | MY (FT-LBS) | MZ (FT-LBS) | FX (LBS) | FY (LBS) | FZ (LBS) |
|--------|-------------|-------------|-------------|----------|----------|----------|
| 1 | -223.48 | 11505.18 | 103.73 | 1542.14 | 22.12 | 316.67 |
| 4 | 6.97 | -59.73 | -25.52 | 20.35 | 41.85 | -67.18 |
| 10 | 1.47 | -69.43 | -.29 | 6271.34 | -.11 | 516.63 |
| 13 | 91.29 | -50.01 | 386.69 | -1204.04 | -2456.41 | -41.83 |
| 14 | -114.04 | -166.87 | 59.80 | -162.13 | -46.23 | -456.26 |
| 16 | 2934.93 | -2912.68 | 669.53 | 3462.34 | 2386.12 | 62.59 |

| MEMBER | PHI X (DEG) | PHI Y (DEG) | PHI Z (DEG) | DELTA X (IN) | DELTA Y (IN) | DELTA Z (IN) |
|--------|-------------|-------------|-------------|--------------|--------------|--------------|
| ORIGIN | .000 | .000 | .000 | .000 | .000 | .000 |
| 1 | -.002 | .057 | .002 | .083 | .002 | .001 |
| 2 | -.002 | .038 | .002 | .115 | .003 | .001 |
| 3 | -.001 | .013 | .003 | .127 | .004 | .001 |
| 4 | .001 | -.055 | .005 | .049 | .004 | .002 |
| 5 | .001 | -.055 | .005 | .050 | .004 | .002 |
| 6 | -.000 | -.000 | .000 | .000 | .000 | .000 |
| 7 | .002 | -.054 | .005 | .041 | .004 | .002 |
| 8 | .007 | -.016 | .008 | .030 | .001 | -.006 |
| 9 | .007 | -.014 | .009 | .029 | .000 | -.007 |
| 10 | .007 | -.003 | .005 | .026 | .005 | -.010 |
| 11 | .007 | -.000 | -.002 | .023 | .000 | -.009 |
| 12 | .006 | -.018 | -.002 | .020 | -.000 | -.039 |
| 13 | .006 | -.018 | -.003 | .019 | .003 | -.057 |
| 14 | .007 | .021 | -.002 | .018 | .002 | -.060 |
| 15 | .007 | .024 | -.002 | .019 | .002 | -.060 |
| 16 | .000 | .000 | -.000 | .000 | .000 | -.000 |
| 17 | .018 | .038 | .001 | .117 | -.021 | -.060 |
| 18 | .018 | .039 | .001 | .117 | -.021 | -.060 |
| 19 | .018 | .038 | .001 | .117 | -.021 | -.060 |
| 20 | .028 | -.005 | .002 | .136 | -.043 | -.059 |
| 21 | .043 | -.016 | .004 | .129 | -.080 | -.057 |
| 22 | .043 | -.015 | -.000 | .129 | -.080 | -.061 |
| 23 | .043 | -.015 | -.000 | .129 | -.080 | -.054 |
| 24 | .000 | -.000 | .000 | .000 | .000 | .000 |

Also Available On Aperture Card

TI APERTURE CARD

FEEDWATER INSIDE SPHERE X ACC 1.0G STM GEN E-1C CASE 1 W.D. GROSS

FEB 23, 1965

ROTATION AND DEFLECTION OF MEMBERS

| MEMBER | PHI X (DEG) | PHI Y (DEG) | PHI Z (DEG) | DELTA X (IN) | DELTA Y (IN) | DELTA Z (IN) |
|--------|----------------|----------------|----------------|-----------------|-----------------|-----------------|
| 25 | .043 | -.015 | .000 | .129 | -.080 | -.063 |
| 26 | .043 | -.015 | .000 | .126 | -.088 | -.063 |
| 27 | -.000 | -.000 | .000 | -.000 | -.000 | .000 |
| 28 | .044 | -.018 | .006 | .127 | -.085 | -.059 |
| 29 | .028 | -.023 | .051 | .121 | -.089 | -.052 |
| 30 | .024 | -.022 | .065 | .103 | -.077 | -.040 |
| 31 | .024 | -.022 | .065 | .105 | -.076 | -.040 |
| 32 | .024 | -.022 | .065 | .103 | -.077 | -.040 |
| 33 | .039 | -.015 | .069 | .006 | -.010 | -.004 |
| 34 | .003 | -.007 | .020 | .001 | -.001 | -.001 |
| 35 | .004 | -.003 | .003 | .000 | .000 | -.001 |
| 36 | -.000 | -.000 | .000 | .000 | -.000 | -.000 |

Also Available On Aperture Card

TI APERTURE CARD

| MEMBER START/END | STRESS (PSI) | STRESS, MOMENTS AND FORCES ON MEMBERS | | | | | |
|---------------------|--------------------|---------------------------------------|----------------|----------------|-------------|-------------|-------------|
| | | MX (FT-LBS) | MY (FT-LBS) | MZ (FT-LBS) | FX (LBS) | FY (LBS) | FZ (LBS) |
| 1 | 3502.08 | -223.48 | 11505.38 | 103.73 | 1542.14 | 22.12 | 316.67 |
| | 723.13 | -24.44 | -2373.84 | 103.73 | 1542.14 | 22.12 | 316.67 |
| 2 | 723.13 | -24.44 | -2373.84 | 103.73 | 1542.14 | 21.12 | 316.67 |
| | 2130.56 | 38.90 | -7000.25 | 103.73 | 1542.14 | 21.12 | 316.67 |
| 3 | 2130.56 | 38.90 | -7000.25 | 103.73 | 1542.14 | 21.12 | 316.67 |
| | 3106.70 | 82.82 | -10207.89 | 103.73 | 1542.14 | 21.12 | 316.67 |
| 4 | 3106.70 | 82.82 | -10207.89 | 103.73 | -1061.86 | 21.12 | 316.67 |
| | 278.33 | 302.85 | 856.74 | 103.73 | -1061.86 | 21.12 | 316.67 |
| 5 | 30 | -59.12 | -26.78 | -44.17 | -20.35 | -41.85 | 67.18 |
| | 117 | 6.04 | -26.78 | -24.43 | -20.35 | -41.85 | 67.18 |
| 6 | 951.54 | 6.04 | -26.78 | -24.43 | -20.35 | -41.85 | 67.18 |
| | 1690.64 | -6.97 | 59.73 | 25.52 | -20.35 | -41.85 | 67.18 |
| 7 | 294.03 | 361.97 | 883.52 | 147.90 | -1041.52 | 62.96 | 249.49 |
| | 523.65 | 409.19 | 1664.66 | 147.90 | -1041.52 | 62.96 | 249.49 |
| 8 | 1083.66 | 409.19 | 1664.66 | 147.90 | -1041.52 | 62.96 | 249.49 |
| | 1669.38 | 487.89 | 2654.70 | 226.60 | -1041.52 | 62.96 | 249.49 |
| 9 | 824.29 | 487.89 | 2654.70 | 226.60 | -1041.52 | 62.96 | 249.49 |
| | 760.17 | 415.54 | 2529.38 | -43.82 | -1041.52 | 62.96 | 249.49 |
| 10 | 780.17 | 415.54 | 2529.38 | -43.82 | -1041.52 | 149.46 | 249.49 |
| | 688.33 | -11.08 | 1790.45 | -1382.14 | -1041.52 | 149.46 | 249.49 |
| 11 | 688.33 | -11.08 | 1790.45 | -1382.14 | -4823.52 | 149.46 | 249.49 |
| | 477.44 | -11.08 | -1462.86 | 566.83 | -4823.52 | 149.46 | 249.49 |
| 12 | 477.44 | -11.08 | -1462.86 | 566.83 | -4823.52 | -68.10 | -81.14 |
| | 166.82 | -11.08 | -154.62 | -522.77 | -4823.52 | -68.10 | -81.14 |
| 13 | 166.82 | -11.08 | -154.62 | -522.77 | -4823.52 | 117.63 | -81.14 |
| | 65.80 | -11.08 | 214.30 | 26.57 | -4823.52 | 117.63 | -81.14 |
| 14 | 136.44 | -11.08 | 214.30 | 26.57 | -4823.52 | 117.63 | -81.14 |
| | 4008.94 | 135.96 | 6345.13 | 173.61 | -4823.52 | 117.63 | -81.14 |
| 15 | 1932.09 | 135.96 | 6345.13 | 173.61 | -4823.52 | 117.63 | -81.14 |
| | 2416.49 | 174.77 | 7936.89 | 173.61 | -4823.52 | 117.63 | -81.14 |
| 16 | 2641.77 | -1.53 | -102.07 | .94 | -6271.34 | .11 | -516.63 |
| | 2314.60 | -1.47 | 89.43 | .29 | -6271.34 | .11 | -516.63 |
| 17 | 2447.54 | 176.30 | 8038.96 | 172.67 | 1447.83 | 117.52 | 435.49 |
| | 1875.91 | 1317.45 | -6019.42 | 172.67 | 1447.83 | 117.52 | 435.49 |
| 18 | 28.64 | 1317.45 | -6019.42 | 172.67 | 1447.83 | 117.52 | 435.49 |
| | 27.07 | 1317.45 | -5675.38 | 79.83 | 1447.83 | 117.52 | 435.49 |
| 19 | 27.67 | 1317.45 | -5675.38 | 79.83 | -415.17 | 117.52 | 435.49 |
| | 28.54 | 1317.45 | -6019.42 | 172.67 | -415.17 | 117.52 | 435.49 |
| 20 | 1875.91 | 1317.45 | -6019.42 | 172.67 | -415.17 | 117.52 | 435.49 |
| | 1362.51 | 1870.98 | -4053.95 | 172.67 | -415.17 | 117.52 | 435.49 |
| 21 | 1362.51 | 1870.98 | -4053.95 | 172.67 | -415.17 | 116.52 | 435.49 |
| | 962.45 | 2453.60 | -1988.08 | 172.67 | -415.17 | 116.52 | 435.49 |
| 22 | 1364.59 | -79.45 | 589.76 | -2723.35 | 1366.17 | 2502.64 | 498.08 |
| | 330.18 | -79.45 | 176.36 | -646.16 | 1366.17 | 2502.64 | 498.08 |
| 23 | 3.22 | 96.98 | -37.19 | -684.85 | 1204.04 | 2456.41 | 41.83 |
| | 1.83 | 59.76 | -37.19 | 386.74 | 1204.04 | 2456.41 | 41.83 |
| 24 | 10172.87 | 59.76 | -37.19 | 386.74 | 1204.04 | 2456.41 | 41.83 |
| | 10363.15 | -91.29 | 50.01 | -386.68 | 1224.04 | 2456.41 | 41.83 |
| 25 | 136.91 | -176.43 | 213.55 | 38.69 | 162.13 | 46.23 | 456.26 |
| | 91.79 | -176.43 | -14.58 | 61.81 | 162.13 | 46.23 | 456.26 |

Also Available On Aperture Card

II APERTURE CARD

5504040294-79

FEEDWATER INSIDE SPHERE X ACC. 1. CG STM GEN E-1C CASE 1 W D. GROSS

FEB 23, 1965

STRESS, MOMENTS AND FORCES ON MEMBERS

| MEMBER START/END | STRESS (PSI) | MX (FT-LBS) | MY (FT-LBS) | MZ (FT-LBS) | FX (LBS) | FY (LBS) | FZ (LBS) |
|---------------------|--------------------|----------------|----------------|----------------|-------------|-------------|-------------|
| 26 | 87 | -176.43 | -14.58 | 61.81 | 162.13 | 46.23 | 456.26 |
| | 1.01 | -135.28 | -158.87 | 61.81 | 162.13 | 46.23 | 456.26 |
| 27 | 5631.98 | -135.28 | -158.87 | 61.81 | 162.13 | 46.23 | 456.26 |
| | 5454.63 | 114.04 | 166.87 | -59.80 | 162.13 | 46.23 | 456.26 |
| 28 | 1409.37 | 2533.05 | -2577.85 | 2896.02 | -1781.34 | -2386.12 | -62.59 |
| | 1098.46 | 1339.99 | -1687.17 | 2896.02 | -1781.34 | -2386.12 | -62.59 |
| 29 | 1621.30 | 1339.99 | -1687.17 | 2896.02 | -1781.34 | -2386.12 | -62.59 |
| | 3757.87 | -1642.66 | 461.27 | 5878.67 | -1781.34 | -2386.12 | -62.59 |
| 30 | 1862.80 | -1642.66 | 461.27 | 5878.67 | -1781.34 | -2386.12 | -62.59 |
| | 1808.77 | -1554.47 | 399.52 | 5722.89 | -1781.34 | -2386.12 | -62.59 |
| 31 | 27.61 | -1554.47 | 399.52 | 5722.89 | -1781.34 | -2386.12 | -62.59 |
| | 26.89 | -862.50 | -117.07 | 5722.89 | -1781.34 | -2386.12 | -62.59 |
| 32 | 21.99 | -862.50 | -117.07 | 5722.89 | -3462.34 | -2386.12 | -62.59 |
| | 27.70 | -1554.47 | 387.01 | 5722.89 | -3462.34 | -2386.12 | -62.59 |
| 33 | 1824.75 | -1554.47 | 387.01 | 5722.89 | -3462.34 | -2386.12 | -62.59 |
| | 1572.08 | -1180.19 | 624.93 | -4990.32 | -3462.34 | -2386.12 | -62.59 |
| 34 | 3261.57 | -1180.19 | 624.93 | -4990.32 | -3462.34 | -2386.12 | -62.59 |
| | 2818.05 | -1146.83 | 560.85 | -4392.61 | -3462.34 | -2386.12 | -62.59 |
| 35 | 2818.05 | -1146.83 | 560.85 | -4392.61 | -3462.34 | -2386.12 | -62.59 |
| | 1553.01 | -1546.43 | 1101.56 | -2901.28 | -3462.34 | -2386.12 | -62.59 |
| 36 | 1055.16 | -1546.43 | 1101.56 | -2901.28 | -3462.34 | -2386.12 | -62.59 |
| | 1253.58 | -2834.93 | 2912.68 | -669.53 | -3462.34 | -2386.12 | -62.59 |


Also Available On Aperture Card

TI APERTURE CARD



PIPING FLEXIBILITY CALCULATION

BECHTEL CORPORATION
4550 SEVILLE AVENUE
VERNON, CALIFORNIA

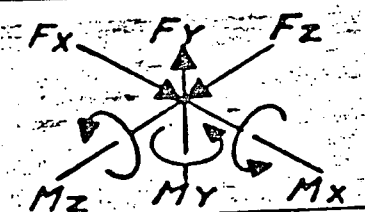

Sc = _____
Sh = _____
SA = 1.25Sc + .25Sh
SA = _____

MAXIMUM STRESS
AT POINT

PAGE 1 OF 8
3746-75

SIGNATURE W. C. [Signature] DATE 2-24-66
PROJECT SAN ONOBE JOB NO. 3296
SUBJECT FEEDWATER TO GEN. E-TC-LINE 326-V ACC 1.67G.

CONVENTION FOR
POSITIVE
FORCES & MOMENTS

DESIGN DATA


PRESS. _____
TEMP. $\Delta T = 100^\circ F$ FOR SEISMIC ANALYSIS

MAT'L. CARB. STE.
EXP. COEF. .000060
 $E_c \times 10^6$ 27.9

MEMBER DATA
10.75" O.D. x .500" W.T. 2-3, 9-19, 22, 25, 26,
27-30, 33-35
8.625" O.D. x .500" W.T. 36-49
2" O.D. x .20" W.T. 7, 21, 38 & 41
30" O.D. x 9" W.T. 8, 22, 24, 31, 22, 39 & 42

ANCHOR DATA (THERMAL)

| ANCHOR NO. | PT. | X | Y | Z | ΔX | ΔY | ΔZ |
|------------|-----|---------|--------|--------|------------|------------|------------|
| A1 | 1 | 0 | 0 | 0 | 0 | 0 | 0 |
| A2 | 6 | 0 | -3.42' | 28.75' | 0 | 0 | 0 |
| A3 | 20 | -33.69' | 2.00' | 25.65' | 0 | 0 | 0 |
| A4 | 27 | -30.68' | 9.92' | 45.96' | 0 | 0 | 0 |
| A5 | 37 | -36.42' | 6.50' | 47.50' | 0 | 0 | 0 |
| A6 | 40 | -38.37' | 2.00' | 53.78' | 0 | 0 | 0 |

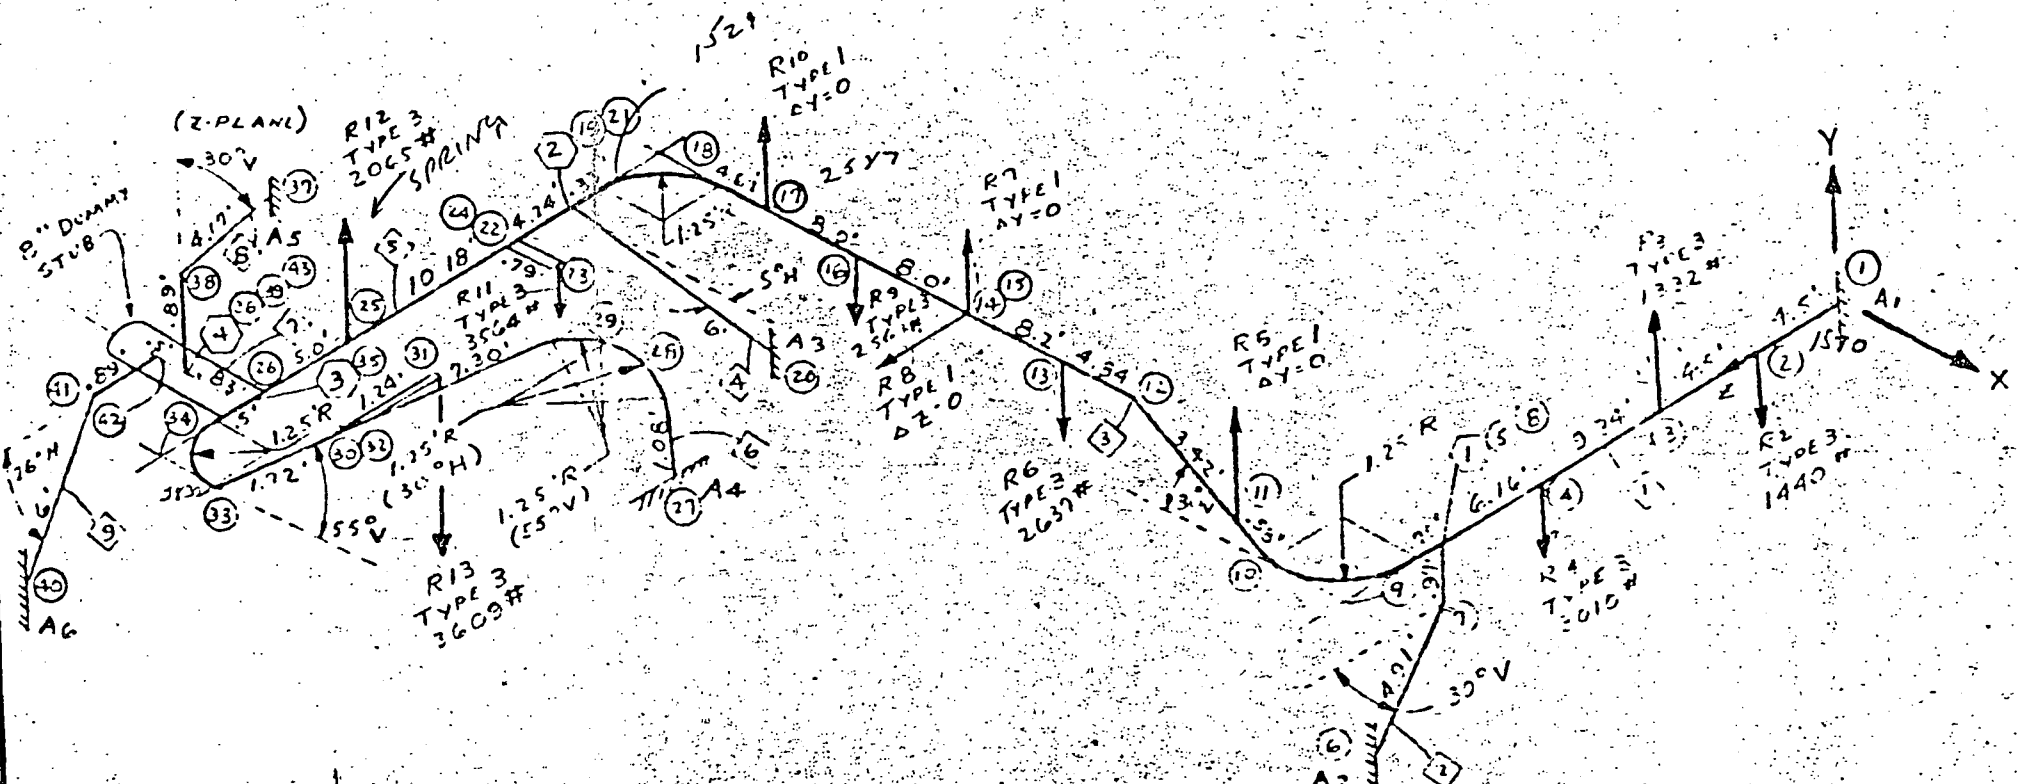

Also Available On
Aperture Card

TI
APERTURE
CARD

8504040294-81

RUN NO. 0

PIPING FLEXIBILITY ANALYSIS PROGRAM MEC-21/7094
•• THERMAL LOADING EFFECTS ••

DATE 00010'000 TIME 7506 HRS.

FEEDWATER TO GEN F-1C-LINE 326-Y ACC 1.67G 4/8/65

PROBLEM NO. X03

| ELEMENT ID CRD-BR-ELM | ELEM TYPE | FLEM PCNT | ELEMENT X, FT. | POINT Y, FT. | COORDINATES Z, FT. | LENGTH FT. | DIAM IN. | THCK IN. | RADIUS FT. | THETA DEG | DISPLACEMENTS, INCHES DELTA X | DELTA Y | DELTA Z |
|--------------------------|-----------|-----------|----------------|--------------|--------------------|------------|----------|----------|------------|-----------|----------------------------------|---------|---------|
| 43-09-004 | TGNT | BINP | -40.500 | 2.000 | 47.500 | 0.500 | 8.625 | 0.500 | | | 0.067 | -0.045 | -0.030 |
| 42-09-003 | TGNT | END | -41.000 | 2.000 | 47.500 | 0.890 | 30.000 | 9.000 | | | 0.067 | -0.043 | -0.031 |
| 41-09-002 | TGNT | END | -41.000 | 2.000 | 48.390 | 5.997 | 2.000 | 0.200 | | | 0.065 | -0.043 | -0.031 |
| 40-09-001 | ANKR | END | -38.370 | 2.000 | 53.780 | | 2.000 | 0.200 | | | 0.000 | -0. | -0. |
| 39-08-003 | TGNT | BINP | -40.500 | 2.000 | 47.500 | 0.890 | 30.000 | 9.000 | | | 0.067 | -0.045 | -0.030 |
| 38-08-002 | TGNT | END | -40.500 | 2.890 | 47.500 | 4.166 | 2.000 | 0.200 | | | 0.071 | -0.045 | -0.030 |
| 37-08-001 | ANKR | END | -38.420 | 6.500 | 47.500 | | 2.000 | 0.200 | | | -0.000 | -0. | -0. |
| 36-07-001 | TGNT | BINP | -40.500 | 2.000 | 47.500 | 0.830 | 8.625 | 0.500 | | | 0.067 | -0.045 | -0.030 |
| 36-07-001 | TGNT | BGIN | -39.670 | 2.000 | 47.500 | 0.830 | 8.625 | 0.500 | | | 0.067 | -0.049 | -0.029 |
| 35-06-012 | TGNT | BINP | -39.670 | 2.000 | 47.500 | 0.500 | 10.750 | 0.500 | | | 0.067 | -0.049 | -0.029 |
| 34-06-011 | BEND | END | -39.670 | 2.000 | 48.000 | 1.963 | 10.750 | 0.500 | 1.250 | 90.000 | 0.066 | -0.049 | -0.029 |
| 34-06-010 | TGNT | END | -38.420 | 2.000 | 49.250 | 0.010 | 10.750 | 0.500 | | | 0.063 | -0.052 | -0.024 |
| 33-06-009 | TGNT | END | -38.410 | 2.000 | 49.250 | 1.720 | 10.750 | 0.500 | | | 0.063 | -0.052 | -0.024 |
| 32-06-008 | TGNT | END | -37.423 | 3.409 | 49.250 | 1.240 | 30.000 | 9.000 | | | 0.057 | -0.048 | -0.021 |
| 31-06-007 | RSNT | END | -37.423 | 3.409 | 48.010 | | | | | | 0.065 | -0.052 | -0.021 |
| 31-06-006 | TGNT | END | -37.423 | 3.409 | 48.010 | 1.240 | 30.000 | 9.000 | | | 0.065 | -0.052 | -0.021 |
| 30-06-005 | TGNT | END | -37.423 | 3.409 | 49.250 | 7.281 | 10.750 | 0.500 | | | 0.057 | -0.048 | -0.021 |
| 29-06-004 | BEND | END | -33.263 | 9.384 | 49.250 | 1.203 | 10.750 | 0.500 | 1.250 | 55.154 | 0.005 | -0.011 | -0.005 |
| 28-06-003 | BEND | END | -37.237 | 9.920 | 49.250 | 0.659 | 10.750 | 0.500 | 1.250 | 30.198 | 0.000 | -0.003 | -0.001 |
| 28-06-002 | TGNT | END | -31.609 | 9.920 | 49.420 | 1.074 | 10.750 | 0.500 | | | 0.000 | -0.001 | -0.000 |
| 27-06-001 | ANKR | END | -30.680 | 9.920 | 49.960 | | 10.750 | 0.500 | | | 0.000 | -0. | -0. |
| 26-05-007 | TGNT | BINP | -39.670 | 2.000 | 47.500 | 5.000 | 10.750 | 0.500 | | | 0.067 | -0.049 | -0.029 |
| 25-05-006 | RSNT | END | -39.670 | 2.000 | 42.500 | | | | | | 0.063 | -0.058 | -0.030 |
| 25-05-005 | TGNT | END | -39.670 | 2.000 | 42.500 | 10.180 | 10.750 | 0.500 | | | 0.063 | -0.058 | -0.030 |
| 24-05-004 | TGNT | END | -39.670 | 2.000 | 32.320 | 0.790 | 30.000 | 9.000 | | | 0.021 | -0.106 | -0.030 |

Also Available On Aperture Card

II APERTURE CARD

3504040294-82

DATE 00010*000 TIME 7506 HRS.

FEEDWATER TO GEN E-1C-LINE 326-Y ACC 1.67G 4/8/65

PROBLEM NO. X33

| ELEMENT ID | ELEM CRD-BR-ELM | ELEM TYPE | ELEM PCNT | ROTATIONS, RADIANS | | | RSNT LOAD | FORCES, LBS. | | | MOMENTS, FT.-LBS. | | | STRESS SE, PSI |
|------------|-----------------|-----------|-----------|--------------------|----------|----------|-----------|--------------|--------|-------|-------------------|--------|--------|----------------|
| | | | | PHI X | PHI Y | PHI Z | | FX | FY | FZ | MX | MY | MZ | |
| 43-09-004 | TGNT | BINP | | 0.00005 | -0.00017 | -0.00041 | | 267. | -21. | -483. | 78. | 567. | -22. | 277. |
| 42-09-003 | TGNT | END | | 0.00005 | -0.00013 | -0.00040 | | 267. | -21. | 483. | 78. | 320. | -33. | 2. |
| 41-09-002 | TGNT | END | | 0.00005 | -0.00013 | -0.00040 | | 267. | -21. | 483. | 59. | 83. | -33. | 2757. |
| 40-09-001 | ANKR | END | | -0. | -0. | -0. | | 267. | -21. | 483. | -56. | -86. | 23. | 2734. |
| 39-08-003 | TGNT | RINP | | 0.00005 | -0.00012 | -0.00041 | | -924. | -1837. | -34. | -90. | 33. | 569. | 3. |
| 38-08-002 | TGNT | END | | 0.00005 | -0.00012 | -0.00041 | | -924. | -1837. | -34. | -60. | 33. | -253. | 6775. |
| 37-08-001 | ANKR | END | | -0. | -0. | -0. | | -924. | -1837. | -34. | 62. | -37. | -235. | 6373. |
| 36-07-001 | TGNT | RINP | | 0.00005 | -0.00012 | -0.00041 | | 656. | 1859. | -449. | 12. | -595. | -547. | 396. |
| 36-07-001 | TGNT | BGIN | | 0.00005 | -0.00009 | -0.00035 | | 656. | 1859. | -449. | 12. | -968. | -2090. | 1127. |
| 35-06-012 | TGNT | BINP | | 0.00005 | -0.00009 | -0.00035 | | 443. | 2390. | -356. | -2413. | 1951. | -1354. | 1030. |
| 34-06-011 | REND | END | | 0.00007 | -0.00011 | -0.00033 | | 443. | 2390. | -356. | -1219. | 1729. | -1354. | 1398. |
| 34-06-010 | TGNT | END | | -0.00014 | -0.00045 | 0.00020 | | 443. | 2390. | -356. | 1768. | 730. | -4341. | 2832. |
| 33-06-009 | TGNT | END | | -0.00014 | -0.00045 | 0.00020 | | 443. | 2390. | -356. | 1768. | 727. | -4365. | 1450. |
| 32-06-008 | TGNT | END | | -0.00023 | -0.00049 | 0.00042 | | 443. | 2390. | -356. | 2270. | 375. | -6099. | 30. |
| 31-06-007 | RSNT | END | | -0.00023 | -0.00049 | 0.00042 | 3607. | 0. | -3609. | 0. | 0. | 0. | 0. | 0. |
| 31-06-006 | TGNT | END | | -0.00023 | -0.00049 | 0.00042 | | 443. | -1219. | -356. | -693. | 925. | -6099. | 29. |
| 30-06-005 | TGNT | END | | -0.00023 | -0.00049 | 0.00043 | | 443. | -1219. | -356. | -2205. | 375. | -6099. | 1977. |
| 29-06-004 | REND | END | | -0.00000 | -0.00038 | 0.00082 | | 443. | -1219. | -356. | -78. | -1106. | 1622. | 1173. |
| 28-06-003 | REND | END | | -0.00006 | -0.00020 | 0.00042 | | 443. | -1219. | -356. | 113. | -1471. | 3110. | 2173. |
| 28-06-002 | TGNT | END | | 0.00000 | -0.00005 | 0.00012 | | 443. | -1219. | -356. | -94. | -1770. | 3877. | 2486. |
| 27-06-001 | ANKR | END | | -0. | -0. | -0. | | 443. | -1219. | -356. | -753. | -2340. | 5009. | 1698. |
| 26-05-007 | TGNT | RINP | | 0.00005 | -0.00009 | -0.00035 | | 213. | -531. | -93. | 2426. | -2919. | -736. | 1176. |
| 25-05-006 | RSNT | END | | -0.00041 | 0.00020 | -0.00024 | 2065. | 0. | 2065. | 0. | 0. | 0. | 0. | 0. |
| 25-05-005 | TGNT | END | | -0.00041 | 0.00020 | -0.00024 | | 213. | 1534. | -93. | 5090. | -1852. | -736. | 1661. |
| 24-05-004 | TGNT | END | | 0.00027 | 0.00039 | 0.00000 | | 213. | 1534. | -93. | -10538. | 320. | -736. | 49. |

6775. 2
6373.

Also Available On
Aperture Card
TI
APERTURE
CARD

RUN NO. 0

PIPING FLEXIBILITY ANALYSIS PROGRAM MEC-21/7094
THERMAL LOADING EFFECTS

PAGE 8 OF 11

DATE 00010'UGO TIME 7506 HRS.

FEEDWATER TO GEN E-1C-LINE 326-Y ACC 1.67G-4/8/65

PROBLEM NO. X03

| ELEMENT ID | ELEM CRD-BR-ELM | FLEM TYPE | FLEM PCNT | ELEMENT X, FT. | ELEMENT Y, FT. | ELEMENT Z, FT. | LENGTH FT. | DIAM IN. | THCK IN. | RADIUS FT. | THETA DEG | DISPLACEMENTS, INCHES | DELTA X | DELTA Y | DELTA Z |
|------------|-----------------|-----------|-----------|----------------|----------------|----------------|------------|----------|----------|------------|-----------|-----------------------|---------|---------|---------|
| 23-05-003 | RSNT | END | | -38.880 | 2.000 | 37.320 | | | | | | 0.021 | -0.106 | -0.034 | |
| 23-05-002 | IGNT | END | | -38.880 | 2.000 | 37.320 | 0.790 | 30.000 | 9.000 | | | 0.021 | -0.106 | -0.034 | |
| 22-05-001 | IGNT | END | | -39.670 | 2.000 | 37.320 | 4.240 | 10.750 | 0.500 | | | 0.021 | -0.106 | -0.030 | |
| 22-05-001 | IGNT | BGIN | | -39.670 | 2.000 | 28.080 | 4.240 | 10.750 | 0.500 | | | 0.003 | -0.072 | -0.031 | |
| 21-04-002 | IGNT | BINP | | -39.670 | 2.000 | 28.080 | 6.003 | 2.000 | 0.200 | | | 0.003 | -0.072 | -0.031 | |
| 20-04-001 | ANKR | END | | -33.690 | 2.000 | 28.600 | | 2.000 | 0.200 | | | 0.000 | -0. | -0. | |
| 19-03-018 | IGNT | BINP | | -39.670 | 2.000 | 28.080 | 0.330 | 10.750 | 0.500 | | | 0.003 | -0.072 | -0.031 | |
| 18-03-017 | BEND | END | | -39.670 | 2.000 | 27.750 | 1.963 | 10.750 | 0.500 | 1.250 | 90.000 | 0.001 | -0.068 | -0.031 | |
| 18-03-016 | IGNT | END | | -33.420 | 2.000 | 26.500 | 4.670 | 10.750 | 0.500 | | | -0.001 | -0.042 | -0.032 | |
| 17-03-015 | RSNT | END | | -33.750 | 2.000 | 26.500 | | | | | | -0.001 | -0.000 | -0.028 | |
| 17-03-014 | IGNT | END | | -33.750 | 2.000 | 26.500 | 8.000 | 10.750 | 0.500 | | | -0.001 | -0.000 | -0.028 | |
| 16-03-013 | RSNT | END | | -25.750 | 2.000 | 26.500 | | | | | | -0.000 | 0.001 | -0.013 | |
| 16-03-012 | IGNT | END | | -25.750 | 2.000 | 26.500 | 8.000 | 10.750 | 0.500 | | | -0.000 | 0.001 | -0.013 | |
| 15-03-011 | RSNT | END | | -17.750 | 2.000 | 26.500 | | | | | | 0.000 | -0.000 | -0.000 | |
| 14-03-010 | RSNT | END | | -17.750 | 2.000 | 26.500 | | | | | | 0.000 | -0.000 | -0.000 | |
| 14-03-009 | IGNT | END | | -17.750 | 2.000 | 26.500 | 8.200 | 10.750 | 0.500 | | | 0.000 | -0.000 | -0.000 | |
| 13-03-008 | RSNT | END | | -9.550 | 2.000 | 26.500 | | | | | | 0.001 | -0.037 | 0.002 | |
| 13-03-007 | IGNT | END | | -9.550 | 2.000 | 26.500 | 4.840 | 10.750 | 0.500 | | | 0.001 | -0.037 | 0.002 | |
| 12-03-006 | IGNT | END | | -4.710 | 2.000 | 26.500 | 3.418 | 10.750 | 0.500 | | | 0.001 | -0.020 | -0.002 | |
| 11-03-005 | RSNT | END | | -1.750 | 0.290 | 26.500 | | | | | | 0.013 | -0.000 | 0.001 | |
| 11-03-004 | IGNT | END | | -1.750 | 0.290 | 26.500 | 0.569 | 10.750 | 0.500 | | | 0.013 | -0.000 | 0.001 | |
| 10-03-003 | IGNT | END | | -1.260 | -0.000 | 26.500 | 0.010 | 10.750 | 0.500 | | | 0.015 | 0.003 | 0.001 | |
| 9-03-002 | BEND | END | | -1.250 | -0.000 | 26.500 | 1.963 | 10.750 | 0.500 | 1.250 | 90.000 | 0.015 | 0.003 | 0.001 | |
| 9-03-001 | IGNT | END | | -0. | -0.000 | 25.250 | 0.750 | 10.750 | 0.500 | | | 0.014 | 0.004 | -0.000 | |
| 9-03-001 | IGNT | BGIN | | -0. | -0.000 | 24.500 | 0.750 | 10.750 | 0.500 | | | 0.013 | -0.002 | -0.000 | |

Also Available On Aperture Card

TI APERTURE CARD

8504040294-84

RUN NO. 0

PIPING FLEXIBILITY ANALYSIS PROGRAM MEC-21/7094
THERMAL LOADING EFFECTS

PAGE 9 OF 11

DATE 00010'U00 TIME 7506 HRS.

FEEDWATER TO GEN E-1C-LINE 326-Y ACC 1.67G 4/8/65

PROBLEM NO. X03

| ELEMENT ID CRD-BR-ELM | FLEM TYPE | FLEM PCNT | ROTATIONS, RADIANS | | | RSNT LOAD | FORCES, LBS. | | | MOMENTS, FT.-LBS. | | | STRESS SE, PSI |
|--------------------------|-----------|-----------|--------------------|----------|----------|-----------|--------------|--------|------|-------------------|-------|--------|----------------|
| | | | PHI X | PHI Y | PHI Z | | FX | FY | FZ | MX | MY | MZ | |
| 23-05-003 | RSNT | END | 0.00027 | 0.00039 | 0.00000 | 3564. | 0. | -3564. | 0. | 0. | 0. | 0. | |
| 23-05-002 | TGNT | END | 0.00027 | 0.00039 | 0.00000 | | 213. | -2030. | -93. | -10538. | 246. | -1948. | 50. |
| 22-05-001 | TGNT | END | 0.00027 | 0.00039 | 0.00000 | | 213. | -2030. | -93. | -10530. | 320. | -3551. | 3385. |
| 22-05-001 | TGNT | RGIN | 0.00092 | 0.00031 | 0.00048 | | 213. | -2030. | -93. | -1931. | 1224. | -3551. | 4295. |
| 21-04-002 | TGNT | BINP | 0.00092 | 0.00031 | 0.00048 | | 189. | -24. | -1. | 17. | 57. | -65. | 2276. |
| 20-04-001 | ANKR | END | -0. | -0. | -0. | | 189. | -24. | -1. | 4. | -48. | 79. | 2381. |
| 19-03-018 | TGNT | BINP | 0.00092 | 0.00031 | 0.00048 | | 24. | -2006. | -92. | -1948. | 1167. | -3487. | 1255. |
| 18-03-017 | BEND | END | 0.00093 | 0.00030 | 0.00052 | | 24. | -2006. | -92. | -1286. | 1175. | -3487. | 1529. |
| 18-03-016 | TGNT | END | 0.00111 | -0.00002 | 0.00087 | | 24. | -2006. | -92. | 1222. | 1090. | -979. | 997. |
| 17-03-015 | RSNT | END | 0.00093 | -0.00011 | 0.00045 | 3469. | 0. | 3469. | 0. | 0. | 0. | 0. | |
| 17-03-014 | TGNT | END | 0.00093 | -0.00011 | 0.00045 | | 24. | 1463. | -92. | 1222. | 660. | 8388. | 2587. |
| 16-03-013 | RSNT | END | 0.00062 | -0.00017 | -0.00005 | 2563. | 0. | -2563. | 0. | 0. | 0. | 0. | |
| 16-03-012 | TGNT | END | 0.00062 | -0.00017 | -0.00005 | | 24. | -1100. | -92. | 1222. | -78. | -3318. | 1076. |
| 15-03-011 | RSNT | END | 0.00031 | -0.00008 | -0.00026 | 142. | 0. | 0. | 142. | 0. | 0. | 0. | |
| 14-03-010 | RSNT | END | 0.00031 | -0.00008 | -0.00026 | 2680. | 0. | 2680. | 0. | 0. | 0. | 0. | |
| 14-03-009 | TGNT | END | 0.00031 | -0.00008 | -0.00026 | | 24. | 1580. | 50. | 1222. | -815. | 5481. | 1727. |
| 13-03-008 | RSNT | END | -0.00000 | 0.00004 | -0.00006 | 2637. | 0. | -2637. | 0. | 0. | 0. | 0. | |
| 13-03-007 | TGNT | END | -0.00000 | 0.00004 | -0.00006 | | 24. | -1057. | 50. | 1222. | -408. | -7479. | 2309. |
| 12-03-006 | TGNT | END | -0.00019 | 0.00007 | 0.00052 | | 24. | -1057. | 50. | 1222. | -167. | -2365. | 812. |
| 11-03-005 | RSNT | END | -0.00032 | 0.00009 | 0.00059 | 1158. | 0. | 1158. | 0. | 0. | 0. | 0. | |
| 11-03-004 | TGNT | END | -0.00032 | 0.00009 | 0.00059 | | 24. | 101. | 50. | 1307. | -20. | 721. | 454. |
| 10-03-003 | TGNT | END | -0.00034 | 0.00010 | 0.00058 | | 24. | 101. | 50. | 1321. | 4. | 665. | 450. |
| 9-03-002 | BEND | END | -0.00034 | 0.00010 | 0.00058 | | 24. | 101. | 50. | 1321. | 5. | 664. | 581. |
| 9-03-001 | TGNT | END | -0.00059 | 0.00008 | 0.00039 | | 24. | 101. | 50. | 1194. | 97. | 537. | 774. |
| 9-03-001 | TGNT | RGIN | -0.00062 | 0.00008 | 0.00038 | | 24. | 101. | 50. | 1118. | 115. | 537. | 379. |

Also Available On Aperture Card

TI APERTURE CARD

15

RUN NO. 0

PIPING FLEXIBILITY ANALYSIS PROGRAM-MEC-2177094

PAGE 10 OF 11

•• THERMAL LOADING EFFECTS ••

DATE 00010*U00 TIME 7506 HRS.

FEEDWATER TO GEN E-1C-LINE-326-Y-ACC-1.67G 4/8/65

PROBLEM NO. X03

| ELEMENT ID CRD-BR-ELM | FLEM TYPE | ELEM PCNT | ELEMENT X, FT. | POINT COORDINATES | | | LENGTH FT. | DIAM IN. | THCK. IN. | RADIUS FT. | THETA DEG | DISPLACEMENTS, INCHES | | |
|--------------------------|--------------|--------------|-------------------|-------------------|--------|---------|---------------|-------------|--------------|---------------|--------------|-----------------------|---------|--------|
| | | | | Y, FT. | Z, FT. | DELTA X | | | | | | DELTA Y | DELTA Z | |
| 8-02-003 | TGNT | RINP | -0. | -0.000 | 24.500 | 0.970 | 30.000 | 9.000 | | | | 0.013 | -0.002 | -0.000 |
| 7-02-002 | TGNT | END | -0. | -0.970 | 24.500 | 4.906 | 2.000 | 0.200 | | | | 0.018 | -0.002 | 0.007 |
| 6-02-001 | ANKP | END | -0. | -3.420 | 28.750 | | 2.000 | 0.200 | | | | 0.000 | -0. | -0. |
| 5-01-008 | TGN | RINP | -0. | -0. | 24.500 | 6.160 | 10.750 | 0.500 | | | | 0.013 | -0.002 | -0.000 |
| 4-01-007 | RSNT | END | -0. | -0. | 18.340 | | | | | | | 0.008 | -0.049 | -0.000 |
| 4-01-006 | TGNT | END | -0. | -0. | 18.340 | 9.340 | 10.750 | 0.500 | | | | 0.008 | -0.049 | -0.000 |
| 3-01-005 | RSNT | END | -0. | -0. | 9.000 | | | | | | | 0.002 | -0.027 | -0.000 |
| 3-01-004 | TGNT | END | -0. | -0. | 9.000 | 4.500 | 10.750 | 0.500 | | | | 0.002 | -0.027 | -0.000 |
| 2-01-003 | RSNT | END | -0. | -0. | 4.500 | | | | | | | 0.001 | -0.010 | -0.000 |
| 2-01-002 | TGNT | END | -0. | -0. | 4.500 | 4.500 | 10.750 | 0.500 | | | | 0.001 | -0.010 | -0.000 |
| 1-01-001 | ANKR | END | -0. | -0. | -0. | | 10.750 | 0.500 | | | | 0.000 | -0. | -0. |

Also Available On Aperture Card

TI APERTURE CARD

8504040204-86

RUN NO. 0

PIPING FLEXIBILITY ANALYSIS PROGRAM MEC-2177094

THERMAL LOADING EFFECTS

DATE 00010'000 TIME 7506 HRS.

FEEDWATER TO GEN E-1C-LINE 326-Y ACC 1.67G 4/8/65

PROBLEM NO. X33

| ELEMENT ID CRD-BR-ELM | ELFM TYPE | FLEP PCNT | ROTATIONS, - RADIANS | | | RSNT LOAD | FORCES, LBS. | | | MOMENTS, FT.-LBS. | | | STRESS SE, PSI |
|--------------------------|--------------|--------------|----------------------|---------|---------|--------------|-----------------|--------|--------|----------------------|------|------|-------------------|
| | | | PHI X | PHI Y | PHI Z | | FX | FY | FZ | MX | MY | MZ | |
| 8-02-003 | TGNT | BINP | -0.00062 | 0.00008 | 0.00038 | | 19. | -1897. | 3321. | -3270. | 43. | 48. | 15. |
| 7-02-002 | TGNT | END | -0.00062 | 0.00008 | 0.00038 | | 19. | -1897. | 3321. | -49. | 43. | 29. | 1845. |
| 6-02-001 | ANKR | END | -0. | -0. | -0. | | 19. | -1897. | 3321. | 26. | -39. | -18. | 1295. |
| 5-01-008 | TGNT | BINP | -0.00062 | 0.00008 | 0.00038 | | 5. | 1998. | -3271. | 4388. | 72. | 489. | 1344. |
| 4-01-007 | RSNT | END | -0.00035 | 0.00007 | 0.00028 | 3010. | 0. | -3010. | 0. | 0. | 0. | 0. | |
| 4-01-006 | TGNT | END | -0.00035 | 0.00007 | 0.00028 | | 5. | -1012. | -3271. | -7920. | 102. | 489. | 2415. |
| 3-01-005 | RSNT | END | 0.00038 | 0.00004 | 0.00014 | 1332. | 0. | 1332. | 0. | 0. | 0. | 0. | |
| 3-01-004 | TGNT | END | 0.00038 | 0.00004 | 0.00014 | | 5. | 320. | -3271. | 1537. | 148. | 489. | 491. |
| 2-01-003 | RSNT | END | 0.00029 | 0.00002 | 0.00007 | 1440. | 0. | -1440. | 0. | 0. | 0. | 0. | |
| 2-01-002 | TGNT | END | 0.00029 | 0.00002 | 0.00007 | | 5. | -1120. | -3271. | 92. | 170. | 489. | 160. |
| 1-01-001 | ANKR | END | -0. | -0. | -0. | | 5. | -1120. | -3271. | 5132. | 192. | 489. | 1570. |

END, EXECUTION TIME 1.57 MINUTES.


Also Available On Aperture Card

TI APERTURE CARD

8504040294-87



PIPING FLEXIBILITY CALCULATION
BECHTEL CORPORATION
4550 SEVILLE AVENUE
VERNON, CALIFORNIA

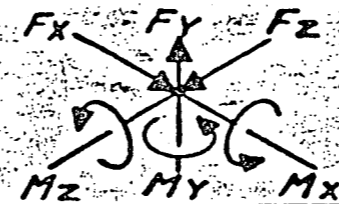

Sc = _____
 Sh = _____
 SA = 1.25Sc + .25Sh
 SA = _____

MAXIMUM STRESS
 AT POINT

PAGE 1 OF 8
 3246-16

SIGNATURE J. D. [unclear] DATE 2-24-65
 PROJECT SAN ONOPE JOB NO. 3246
 SUBJECT FEEDWATER TO GEN. E-1C - LINE 326 - 7 ACC. LOG

CONVENTION FOR
 POSITIVE
 FORCES & MOMENTS

DESIGN DATA

PRESS. _____
 TEMP. $\Delta T = 10F$ FOR SEISMIC ANALYSIS


MAT'L. CARB. STL.
 EXP. COEF. .0000607
 $E_c \times 10^6$ 27.9

MEMBER DATA

10.75" O.D. x .500" W.T. 2 → 5, 9 → 19, 22, 25, 26, 28 → 33
 8.625" O.D. x .500" W.T. 34 & 41
 2" O.D. x .20" W.T. 7, 21, 36, & 39
 30" O.D. x 9" W.T. 8, 23, 29, 37, & 40

ANCHOR DATA

| ANCHOR COORDINATES | | END DEFLECTION | | | | | |
|--------------------|-----|----------------|--------|--------|------------|------------|------------|
| No. | Pt. | X | Y | Z | ΔX | ΔY | ΔZ |
| A1 | 0 | 0 | 0 | 0 | 0 | 0 | 0 |
| A2 | 6 | 0 | -3.42' | 28.75' | 0 | 0 | 0 |
| A3 | 20 | -33.69' | 2.00' | 28.60' | 0 | 0 | 0 |
| A4 | 27 | -30.68' | 9.92' | 49.96' | 0 | 0 | 0 |
| A5 | 35 | -38.42' | 6.50' | 47.50' | 0 | 0 | 0 |
| A6 | 38 | -38.37' | 2.00' | 53.78' | 0 | 0 | 0 |

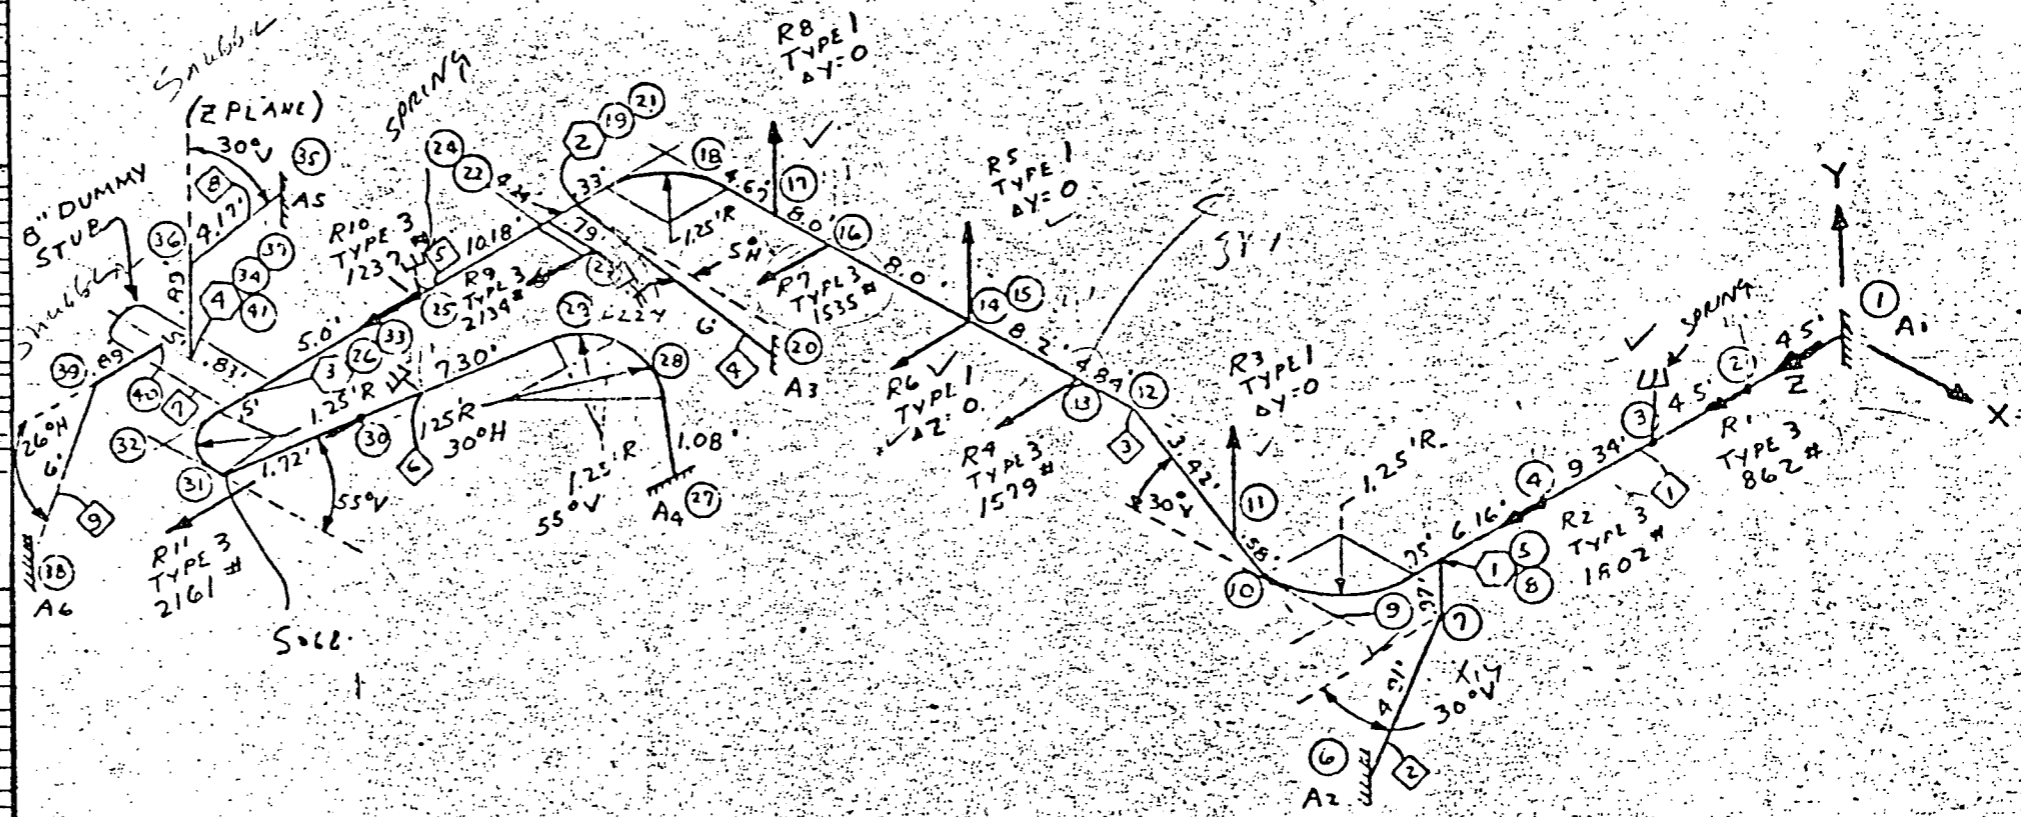

Also Available On
 Aperture Card

TI
 APERTURE
 CARD

3504040204-88

RUN NO. C

PIPING FLEXIBILITY ANALYSIS PROGRAM MEC-21/7C94

*** THERMAL LOADING EFFECTS ***

DATE 26 APR 65 TIME 2319 HRS.

FEEDWATER TO GEN F-1C LINE 326-Z ACC 1.0G 4/9/65

PROBLEM NO. X04

| ELEMENT ID | ELEM CL-FL | ELEMENT POINT COORDINATES | LENGTH | DIAM | THICK | RADIUS | THETA | DISPLACEMENTS, INCHES | | |
|------------|------------|---------------------------|--------|--------|-------|--------|--------|-----------------------|---------|---------|
| CRD-BR-ELM | TYPE | X, FT. Y, FT. Z, FT. | FT. | IN. | IN. | FT. | DEG | DELTA X | DELTA Y | DELTA Z |
| 41-C9-CC4 | TGNT PINF | -40.500 2.000 47.500 | 0.500 | 8.625 | 0.500 | | | -0.127 | 0.080 | 0.086 |
| 40-C9-CC3 | TGNT END | -41.000 2.000 47.500 | 0.890 | 30.000 | 9.000 | | | -0.127 | 0.079 | 0.080 |
| 39-C9-CC2 | TGNT END | -41.000 2.000 48.390 | 5.997 | 2.000 | 0.200 | | | -0.138 | 0.091 | 0.080 |
| 38-C9-CC1 | ANKR END | -39.370 2.000 53.780 | | 2.000 | 0.200 | | | 0.000 | -0. | -0. |
| 37-C8-CC3 | TGNT PINF | -40.500 2.000 47.500 | 0.890 | 30.000 | 9.000 | | | -0.127 | 0.080 | 0.086 |
| 36-C8-CC2 | TGNT END | -40.500 2.890 47.500 | 4.166 | 2.000 | 0.200 | | | -0.128 | 0.080 | 0.074 |
| 35-C8-CC1 | ANKR END | -38.420 6.500 47.500 | | 2.000 | 0.200 | | | 0.000 | -0. | -0. |
| 34-C7-CC1 | TGNT PINF | -40.500 2.000 47.500 | 0.830 | 8.625 | 0.500 | | | -0.127 | 0.080 | 0.086 |
| 34-C7-CC1 | TGNT PCIN | -39.670 2.000 47.500 | 0.830 | 8.625 | 0.500 | | | -0.127 | 0.080 | 0.094 |
| 33-C6-C10 | TGNT PINF | -39.670 2.000 47.500 | 0.500 | 10.750 | 0.500 | | | -0.127 | 0.080 | 0.094 |
| 32-C6-CC9 | PEND END | -39.670 2.000 48.000 | 1.963 | 10.750 | 0.500 | 1.250 | 90.000 | -0.130 | 0.087 | 0.094 |
| 32-C6-CC8 | TGNT END | -38.420 2.000 49.250 | 0.010 | 10.750 | 0.500 | | | -0.135 | 0.097 | 0.096 |
| 31-C6-CC7 | TGNT END | -38.410 2.000 49.250 | 1.720 | 10.750 | 0.500 | | | -0.135 | 0.096 | 0.096 |
| 30-C6-CC6 | PENT END | -37.423 3.409 49.250 | | | | | | -0.114 | 0.082 | 0.081 |
| 30-C6-CC5 | TGNT END | -37.423 3.409 49.250 | 7.281 | 10.750 | 0.500 | | | -0.114 | 0.082 | 0.081 |
| 29-C6-CC4 | PEND END | -33.263 9.334 49.250 | 1.203 | 10.750 | 0.500 | 1.250 | 55.154 | -0.007 | 0.010 | 0.008 |
| 28-C6-CC3 | PEND END | -32.237 9.920 49.250 | 0.659 | 10.750 | 0.500 | 1.250 | 30.198 | -0.001 | 0.000 | 0.002 |
| 28-C6-CC2 | TGNT END | -31.609 9.920 49.420 | 1.074 | 10.750 | 0.500 | | | -0.000 | -0.000 | 0.000 |
| 27-C6-CC1 | ANKR END | -30.680 9.920 49.760 | | 10.750 | 0.500 | | | -0.000 | -0. | -0. |
| 26-C5-CC7 | TGNT PINF | -39.670 2.000 47.500 | 5.000 | 10.750 | 0.500 | | | -0.127 | 0.080 | 0.094 |
| 25-C5-CC6 | RSNT END | -39.670 2.000 42.500 | | | | | | -0.090 | 0.029 | 0.094 |
| 25-C5-CC5 | TGNT END | -39.670 2.000 42.500 | 10.180 | 10.750 | 0.500 | | | -0.090 | 0.029 | 0.094 |
| 24-C5-CC4 | TGNT END | -39.670 2.000 32.320 | 0.790 | 30.000 | 9.000 | | | -0.029 | -0.009 | 0.094 |
| 23-C5-CC3 | RSNT END | -38.880 2.000 32.320 | | | | | | -0.029 | -0.008 | 0.099 |
| 23-C5-CC2 | TGNT END | -38.880 2.000 32.320 | 0.790 | 30.000 | 9.000 | | | -0.029 | -0.008 | 0.099 |

Also Available On Aperture Card

TI APERTURE CARD

RUN NO. 0

PIPING FLEXIBILITY ANALYSIS PROGRAM MEC-21/7094
THERMAL LOADING EFFECTS

DATE 26 APR 65 TIME 2319 HRS.

FEEDWATER TO GEN E-1C LINE 326-Z ACC 1.0G 4/9/65

PROBLEM NO. X04

| ELEMENT ID CRD-BR-ELM | ELEM TYPE | ELEM POINT | ROTATIONS, RADIANS | | | PSAT LOAD | FORCES, LBS. | | | MOMENTS, FT.-LBS. | | | STRESS SE, PSI |
|--------------------------|-----------|------------|--------------------|----------|----------|-----------|--------------|--------|--------|-------------------|--------|--------|----------------|
| | | | PHI X | PHI Y | PHI Z | | FX | FY | FZ | MX | MY | MZ | |
| 41-C9-CC4 | TGNT | PINP | -0.00104 | -0.00033 | 0.00009 | | 2267. | 53. | 4832. | -205. | 4175. | -46. | 2047. |
| 40-C9-CC3 | TGNT | END | -0.00106 | -0.00100 | 0.00009 | | 2267. | 53. | 4832. | -205. | 1760. | 72. | 8. |
| 39-C9-CC2 | TGNT | END | -0.00108 | -0.00100 | 0.00009 | | 2267. | 53. | 4832. | -158. | -258. | 72. | 8059. |
| 38-C9-CC1 | ANKR | END | -0. | -0. | -0. | | 2267. | 53. | 4832. | 127. | 228. | -67. | 6982. |
| 37-C8-CC3 | TGNT | PINP | -0.00108 | -0.00093 | 0.00009 | | 1647. | 3238. | 78. | 189. | -95. | -1068. | 5. |
| 36-C8-CC2 | TGNT | END | -0.00108 | -0.00093 | 0.00009 | | 1647. | 3238. | 78. | 120. | -95. | 397. | 11017. |
| 35-C8-CC1 | ANKR | END | -0. | -0. | -0. | | 1647. | 3238. | 78. | -160. | 66. | -393. | 11126. |
| 34-C7-CC1 | TGNT | PINP | -0.00102 | -0.00073 | 0.00007 | | -3914. | -3791. | -4909. | 16. | -4080. | 1023. | 2059. |
| 34-C7-CC1 | TGNT | PGIN | -0.00109 | -0.00068 | -0.00001 | | -3914. | -3791. | -4909. | 16. | -8155. | 3755. | 4395. |
| 33-C6-C10 | TGNT | PINP | -0.00109 | -0.00068 | -0.00001 | | -4016. | -3099. | -1411. | 4197. | -6839. | 3972. | 2725. |
| 32-C6-CC9 | PEND | END | -0.00113 | -0.00061 | -0.00007 | | -4016. | -3099. | -1411. | 2648. | -4831. | 3972. | 3683. |
| 32-C6-CC8 | TGNT | END | -0.00089 | 0.00002 | -0.00107 | | -4016. | -3099. | -1411. | -1226. | -1575. | 7845. | 5068. |
| 31-C6-CC7 | TGNT | END | -0.00089 | 0.00002 | -0.00107 | | -4016. | -3099. | -1411. | -1226. | -1589. | 7876. | 2473. |
| 30-C6-CC6 | RSNT | END | -0.00086 | 0.00013 | -0.00134 | 2161. | 0. | 0. | 2161. | 0. | 0. | 0. | 0. |
| 30-C6-CC5 | TGNT | END | -0.00086 | 0.00013 | -0.00134 | | -4016. | -3099. | 750. | 761. | -2981. | 5277. | 1859. |
| 29-C6-CC4 | PEND | END | -0.00054 | 0.00047 | -0.00129 | | -4016. | -3099. | 750. | -3722. | 141. | -5826. | 4274. |
| 28-C6-CC3 | PEND | END | -0.00024 | 0.00027 | -0.00031 | | -4016. | -3099. | 750. | -4174. | 911. | -4799. | 3331. |
| 28-C6-CC2 | TGNT | END | -0.00018 | 0.00009 | -0.00006 | | -4016. | -3099. | 750. | -4650. | 2064. | -2850. | 2117. |
| 27-C6-CC1 | ANKR | END | -0. | -0. | -0. | | -4016. | -3099. | 750. | -6325. | 4930. | 27. | 2440. |
| 26-C5-CC7 | TGNT | PINP | -0.00109 | -0.00068 | -0.00001 | | 101. | -192. | -3495. | -4181. | -1316. | -217. | 1336. |
| 25-C5-CC6 | RSNT | END | -0.00063 | -0.00055 | 0.00003 | 1237. | 0. | 0. | 1237. | 0. | 0. | 0. | 0. |
| 25-C5-CC5 | TGNT | END | -0.00063 | -0.00055 | 0.00003 | | 101. | -192. | -2262. | -3219. | -809. | -217. | 1017. |
| 24-C5-CC4 | TGNT | END | -0.00008 | -0.00048 | 0.00010 | | 101. | -192. | -2262. | -1261. | 224. | -217. | 6. |
| 23-C5-CC3 | RSNT | END | -0.00008 | -0.00048 | 0.00010 | 2134. | 0. | 0. | 2134. | 0. | 0. | 0. | 0. |
| 23-C5-CC2 | TGNT | END | -0.00008 | -0.00048 | 0.00010 | | 101. | -192. | -128. | -1261. | -1563. | -65. | 9. |

Also Available On Aperture Card

TI APERTURE CARD

RUN NO. 0

PIPING FLEXIBILITY ANALYSIS PROGRAM MEC-2177094

•• THERMAL LOADING EFFECTS ••

DATE 26 APR 65 TIME 2318 HRS.

FEEDWATER TO GEN E-1C LINE 326-7 ACC 1.00 4/9/65

PROBLEM NO. X04

| ELEMENT ID CRD-PR-FLM | ELEM TYPE | ELEM POINT | ELEMENT POINT COORDINATES | | | LENGTH FT. | DIAM IN. | THICK IN. | RADIUS FT. | THETA DEG. | DISPLACEMENTS, INCHES | | |
|--------------------------|-----------|------------|---------------------------|--------|--------|---------------|-------------|--------------|---------------|---------------|-----------------------|---------|---------|
| | | | X, FT. | Y, FT. | Z, FT. | | | | | | DELTA X | DELTA Y | DELTA Z |
| 22-C5-CC1 | TGNT | END | -39.670 | 2.000 | 32.320 | 4.240 | 10.750 | 0.500 | | | -0.029 | -0.009 | 0.094 |
| 22-C5-CC1 | TGNT | BGIN | -39.670 | 2.000 | 28.080 | 4.240 | 10.750 | 0.500 | | | -0.008 | -0.011 | 0.094 |
| 21-C4-CC2 | TGNT | BIAP | -39.670 | 2.000 | 24.080 | 6.003 | 2.000 | 0.200 | | | -0.008 | -0.011 | 0.094 |
| 20-C4-CC1 | ANKR | END | -32.690 | 2.000 | 28.600 | | 2.000 | 0.200 | | | 0.000 | -0. | -0. |
| 19-C3-C18 | TGNT | BIAP | -39.670 | 2.000 | 28.080 | 0.330 | 10.750 | 0.500 | | | -0.008 | -0.011 | 0.094 |
| 18-C3-C17 | PEND | END | -39.670 | 2.000 | 27.750 | 1.963 | 10.750 | 0.500 | 1.250 | 90.000 | -0.007 | -0.011 | 0.094 |
| 18-C3-C16 | TGNT | END | -28.420 | 2.000 | 26.500 | 4.670 | 10.750 | 0.500 | | | -0.003 | -0.008 | 0.096 |
| 17-C3-C15 | RSNT | END | -33.750 | 2.000 | 26.500 | | | | | | -0.003 | -0.000 | 0.095 |
| 17-C3-C14 | TGNT | END | -33.750 | 2.000 | 26.500 | 8.000 | 10.750 | 0.500 | | | -0.003 | -0.000 | 0.095 |
| 16-C3-C13 | PSNT | END | -25.750 | 2.000 | 26.500 | | | | | | -0.002 | 0.003 | 0.061 |
| 16-C3-C12 | TGNT | END | -25.750 | 2.000 | 26.500 | 8.000 | 10.750 | 0.500 | | | -0.002 | 0.003 | 0.061 |
| 15-C3-C11 | RSNT | END | -17.750 | 2.000 | 26.500 | | | | | | -0.002 | 0.000 | 0.000 |
| 14-C3-C10 | RSNT | END | -17.750 | 2.000 | 26.500 | | | | | | -0.002 | 0.000 | 0.000 |
| 14-C3-CC9 | TGNT | END | -17.750 | 2.000 | 26.500 | 8.200 | 10.750 | 0.500 | | | -0.002 | 0.000 | 0.000 |
| 13-C3-CC8 | RSNT | END | -9.550 | 2.000 | 26.500 | | | | | | -0.001 | -0.001 | 0.012 |
| 13-C3-CC7 | TGNT | END | -9.550 | 2.000 | 26.500 | 4.640 | 10.750 | 0.500 | | | -0.001 | -0.001 | 0.017 |
| 12-C3-CC6 | TGNT | END | -4.710 | 2.000 | 26.500 | 3.418 | 10.750 | 0.500 | | | -0.001 | -0.001 | 0.014 |
| 11-C3-CC5 | RSNT | END | -1.750 | 0.250 | 26.500 | | | | | | 0.000 | 0.000 | 0.006 |
| 11-C3-CC4 | TGNT | END | -1.750 | 0.230 | 26.500 | 0.569 | 10.750 | 0.500 | | | 0.000 | 0.000 | 0.006 |
| 10-C3-CC3 | TGNT | END | -1.260 | -0.000 | 26.500 | 0.010 | 10.750 | 0.500 | | | 0.000 | 0.000 | 0.005 |
| 9-C3-CC2 | PEND | END | -1.250 | -0.000 | 26.500 | 1.963 | 10.750 | 0.500 | 1.250 | 90.000 | 0.000 | 0.000 | 0.005 |
| 9-C3-CC1 | TGNT | END | -0. | -0.000 | 25.250 | 0.750 | 10.750 | 0.500 | | | -0.001 | 0.003 | 0.003 |
| 9-C3-CC1 | TGNT | BGIN | -0. | -0.000 | 24.500 | 0.750 | 10.750 | 0.500 | | | -0.001 | 0.003 | 0.003 |
| 8-C2-CC3 | TGNT | BIAP | -0. | -0.000 | 24.500 | 0.970 | 30.000 | 9.000 | | | -0.001 | 0.003 | 0.003 |
| 7-C2-CC2 | TGNT | END | -0. | -0.970 | 24.500 | 4.906 | 2.000 | 0.200 | | | -0.002 | 0.003 | 0.002 |

Also Available On Aperture Card

TI APERTURE CARD

18504040294-91

RUN NO. 0

PIPING FLEXIBILITY ANALYSIS PROGRAM MEC-21/7094
THERMAL LOADING EFFECTS

DATE 26 APR 65 TIME 2319 HRS.

FRESHWATER TO GEN E-1C LINE 326-Z ACC 1.00 4/9/65

PROBLEM NO. X04

| ELEMENT ID CRD-BR-FLM | ELFM TYPE | FLEM PCNT | ROTATIONS, RADIANS | | | RSNT LOAD | FORCES, LBS. | | | MOMENTS, FT.-LBS. | | | STRESS SE, PSI |
|--------------------------|--------------|--------------|--------------------|----------|----------|--------------|--------------|-------|--------|-------------------|--------|-------|-------------------|
| | | | PHI X | PHI Y | PHI Z | | FX | FY | FZ | MX | MY | MZ | |
| 22-05-001 | IGNT | END | -0.00008 | -0.00042 | 0.00010 | | 101. | -192. | -128. | -1261. | -1462. | -217. | 591. |
| 22-05-001 | IGNT | BCIR | 0.00001 | -0.00035 | 0.00013 | | 101. | -192. | -128. | -446. | -1031. | -217. | 348. |
| 21-04-002 | IGNT | PINP | 0.00001 | -0.00035 | 0.00013 | | 126. | -3. | 55. | 1. | -138. | -6. | 3587. |
| 20-04-001 | ANKR | END | -0. | -0. | -0. | | 126. | -3. | 55. | -1. | 128. | 10. | 3320. |
| 19-03-018 | IGNT | PINP | 0.00001 | -0.00035 | 0.00013 | | -24. | -190. | -183. | -446. | -893. | -211. | 311. |
| 18-03-017 | PEND | END | 0.00001 | -0.00034 | 0.00013 | | -24. | -190. | -183. | -384. | -901. | -211. | 622. |
| 18-03-016 | IGNT | END | 0.00007 | -0.00007 | 0.00016 | | -24. | -190. | -183. | -147. | -1160. | 26. | 734. |
| 17-03-015 | RSNT | END | 0.00009 | 0.00011 | 0.00011 | 259. | 0. | 259. | 0. | 0. | 0. | 0. | |
| 17-03-014 | IGNT | END | 0.00009 | 0.00011 | 0.00011 | | -24. | 70. | -183. | -147. | -2017. | 912. | 675. |
| 16-03-013 | RSNT | END | 0.00013 | 0.00065 | -0.00002 | 1535. | 0. | 0. | 1535. | 0. | 0. | 0. | |
| 16-03-012 | IGNT | END | 0.00013 | 0.00065 | -0.00002 | | -24. | 70. | 1352. | -147. | -3484. | 354. | 1066. |
| 15-03-011 | RSNT | END | 0.00016 | 0.00027 | -0.00003 | -2590. | 0. | 0. | -2590. | 0. | 0. | 0. | |
| 14-03-010 | RSNT | END | 0.00016 | 0.00027 | -0.00003 | -76. | 0. | 0. | -76. | 0. | 0. | 0. | |
| 14-03-009 | IGNT | END | 0.00016 | 0.00027 | -0.00003 | | -24. | -6. | -1239. | -147. | 7329. | -204. | 2232. |
| 13-03-008 | RSNT | END | 0.00020 | -0.00012 | 0.00000 | 1579. | 0. | 0. | 1579. | 0. | 0. | 0. | |
| 13-03-007 | IGNT | END | 0.00020 | -0.00012 | 0.00000 | | -24. | -6. | 340. | -147. | -2928. | -153. | 863. |
| 12-03-006 | IGNT | END | 0.00022 | 0.00006 | 0.00002 | | -24. | -6. | 340. | -147. | -1181. | -123. | 364. |
| 11-03-005 | RSNT | END | 0.00020 | 0.00012 | 0.00003 | -27. | 0. | 0. | -27. | 0. | 0. | 0. | |
| 11-03-004 | IGNT | END | 0.00020 | 0.00012 | 0.00003 | | -24. | -28. | 340. | 435. | -174. | -64. | 144. |
| 10-03-003 | IGNT | END | 0.00015 | 0.00013 | 0.00003 | | -24. | -28. | 340. | 534. | -7. | -43. | 163 |
| 9-03-002 | PEND | END | 0.00019 | 0.00013 | 0.00003 | | -24. | -28. | 340. | 534. | -4. | -43. | 165 |
| 9-03-001 | IGNT | END | 0.00010 | 0.00006 | -0.00001 | | -24. | -28. | 340. | 569. | 391. | -7. | 436. |
| 9-03-001 | IGNT | BCIR | 0.00009 | 0.00005 | -0.00000 | | -24. | -28. | 340. | 591. | 373. | -7. | 213. |
| 8-02-003 | IGNT | PINP | 0.00007 | 0.00005 | -0.00000 | | 0. | -75. | 137. | -129. | 0. | -1. | 1. |
| 7-02-002 | IGNT | END | 0.00007 | 0.00005 | -0.00000 | | 0. | -75. | 137. | -1. | 0. | -0. | 21. |

Also Available On Aperture Card

APERTURE CARD

3504040294-92

RUN NO. 0

PIPING FLEXIBILITY ANALYSIS PROGRAM MEC-71/7094

PAGE 9 OF 10

*** THERMAL LOADING EFFECTS ***

DATE 26 APR 69 TIME 2319 HRS.

FEEDWATER IC GEN E-1C LINE 376-2 ACC 1.CG 4/9/65

PROBLEM NO. X04

| ELEMENT ID | FILEM | ELFM | ELEMENT POINT | ELEMENT POINT COORDINATES | | | LENGTH | DIAM | THICK | RADIUS | THETA | DISPLACEMENTS, INCHES | | |
|------------|-------|------|---------------|---------------------------|--------|--------|--------|-------|-------|--------|-------|-----------------------|---------|---------|
| | | | | X, FT. | Y, FT. | Z, FT. | | | | | | DELTA X | DELTA Y | DELTA Z |
| 6-02-001 | ANKR | END | -C. | -3.420 | 28.750 | | 2.000 | 0.200 | | | | -0.000 | -0. | -0. |
| 5-01-007 | TGNT | PIAF | -C. | -C. | 24.500 | 6.160 | 10.750 | 0.500 | | | | -0.001 | 0.003 | 0.003 |
| 4-01-006 | RSNT | END | -C. | -C. | 18.340 | | | | | | | -0.003 | 0.007 | 0.002 |
| 4-01-005 | TGNT | END | -C. | -C. | 18.340 | 9.340 | 10.750 | 0.500 | | | | -0.003 | 0.007 | 0.002 |
| 3-01-004 | TGNT | END | -C. | -C. | 9.000 | 4.500 | 10.750 | 0.500 | | | | -0.002 | 0.003 | 0.001 |
| 2-01-003 | RSNT | END | -C. | -C. | 4.500 | | | | | | | -0.001 | 0.001 | 0.001 |
| 2-01-002 | TGNT | END | -C. | -C. | 4.500 | 4.500 | 10.750 | 0.500 | | | | -0.001 | 0.001 | 0.001 |
| 1-01-001 | ANKR | END | -C. | -C. | -0. | | 10.750 | 0.500 | | | | -0.000 | -0. | -0. |

Also Available On Aperture Card

TI APERTURE CARD

8504040294-93

RUN NO. 0

PIPING FLEXIBILITY ANALYSIS PROGRAM MEC-71/7094

PAGE 10 OF 10

2.4

*** THERMAL LOADING EFFECTS ***

DATE 26 APR 65 TIME 2319 HRS.

FEEDWATER TO GEN F-1C LINE 326-Z ACC 1.0G 4/9/65

PROBLEM NO. X04

| ELEMENT ID CRD-PR-ELM | ELEM TYPE | ELEM POINT | ROTATIONS, RADIANS | | | RSMT LOAD | FORCES, LBS. | | | MOMENTS, FT.-LBS. | | | STRESS SE, PSI |
|--------------------------|--------------|---------------|--------------------|----------|----------|--------------|--------------|------|-------|-------------------|-------|-----|-------------------|
| | | | PHI X | PHI Y | PHI Z | | FX | FY | FZ | MX | MY | MZ | |
| 6-02-001 | ANKR | END | -0. | -0. | -0. | | -0. | -75. | 112. | 4. | 1. | 0. | 110. |
| 5-01-007 | TGNT | FINF | 0.00009 | 0.00005 | -0.00000 | | -74. | 46. | 209. | 719. | 373. | -6. | 247. |
| 4-01-006 | RSMT | END | 0.00000 | 0.00000 | -0.00000 | 1802. | 0. | 0. | 1802. | 0. | 0. | 0. | - |
| 4-01-005 | TGNT | END | -0.00000 | 0.00000 | -0.00000 | | -74. | 46. | 2010. | 433. | 226. | -6. | 149. |
| 3-01-004 | TGNT | END | -0.00005 | -0.00007 | -0.00000 | | -74. | 46. | 2010. | -1. | 3. | -6. | 2. |
| 2-01-003 | RSMT | END | -0.00004 | -0.00002 | -0.00000 | 862. | 0. | 0. | 862. | 0. | 0. | 0. | - |
| 2-01-002 | TGNT | END | -0.00003 | -0.00002 | -0.00000 | | -74. | 46. | 2872. | -210. | -104. | -6. | 71. |
| 1-01-001 | ANKR | END | -0. | -0. | -0. | | -74. | 46. | 2872. | -419. | -212. | -6. | 143. |

END, EXECUTION TIME 2.76 MINUTES.


3009 # ON SHELL & SVI-326-4

Also Available On Aperture Card

TI APERTURE CARD

8504040294-94

NOTE: PIPING ISOMETRIC WAS DRAWN IN 1977 WHICH REFLECTS THE PIPING SUPPORT LOCATIONS, TYPES AND TAG NO. AS DESIGNED AND INSTALLED IN 1965/66. THESE PIPE SUPPORT LOCATIONS AND TYPES HAVE BEEN REVERIFIED IN 79-14 PROGRAM.

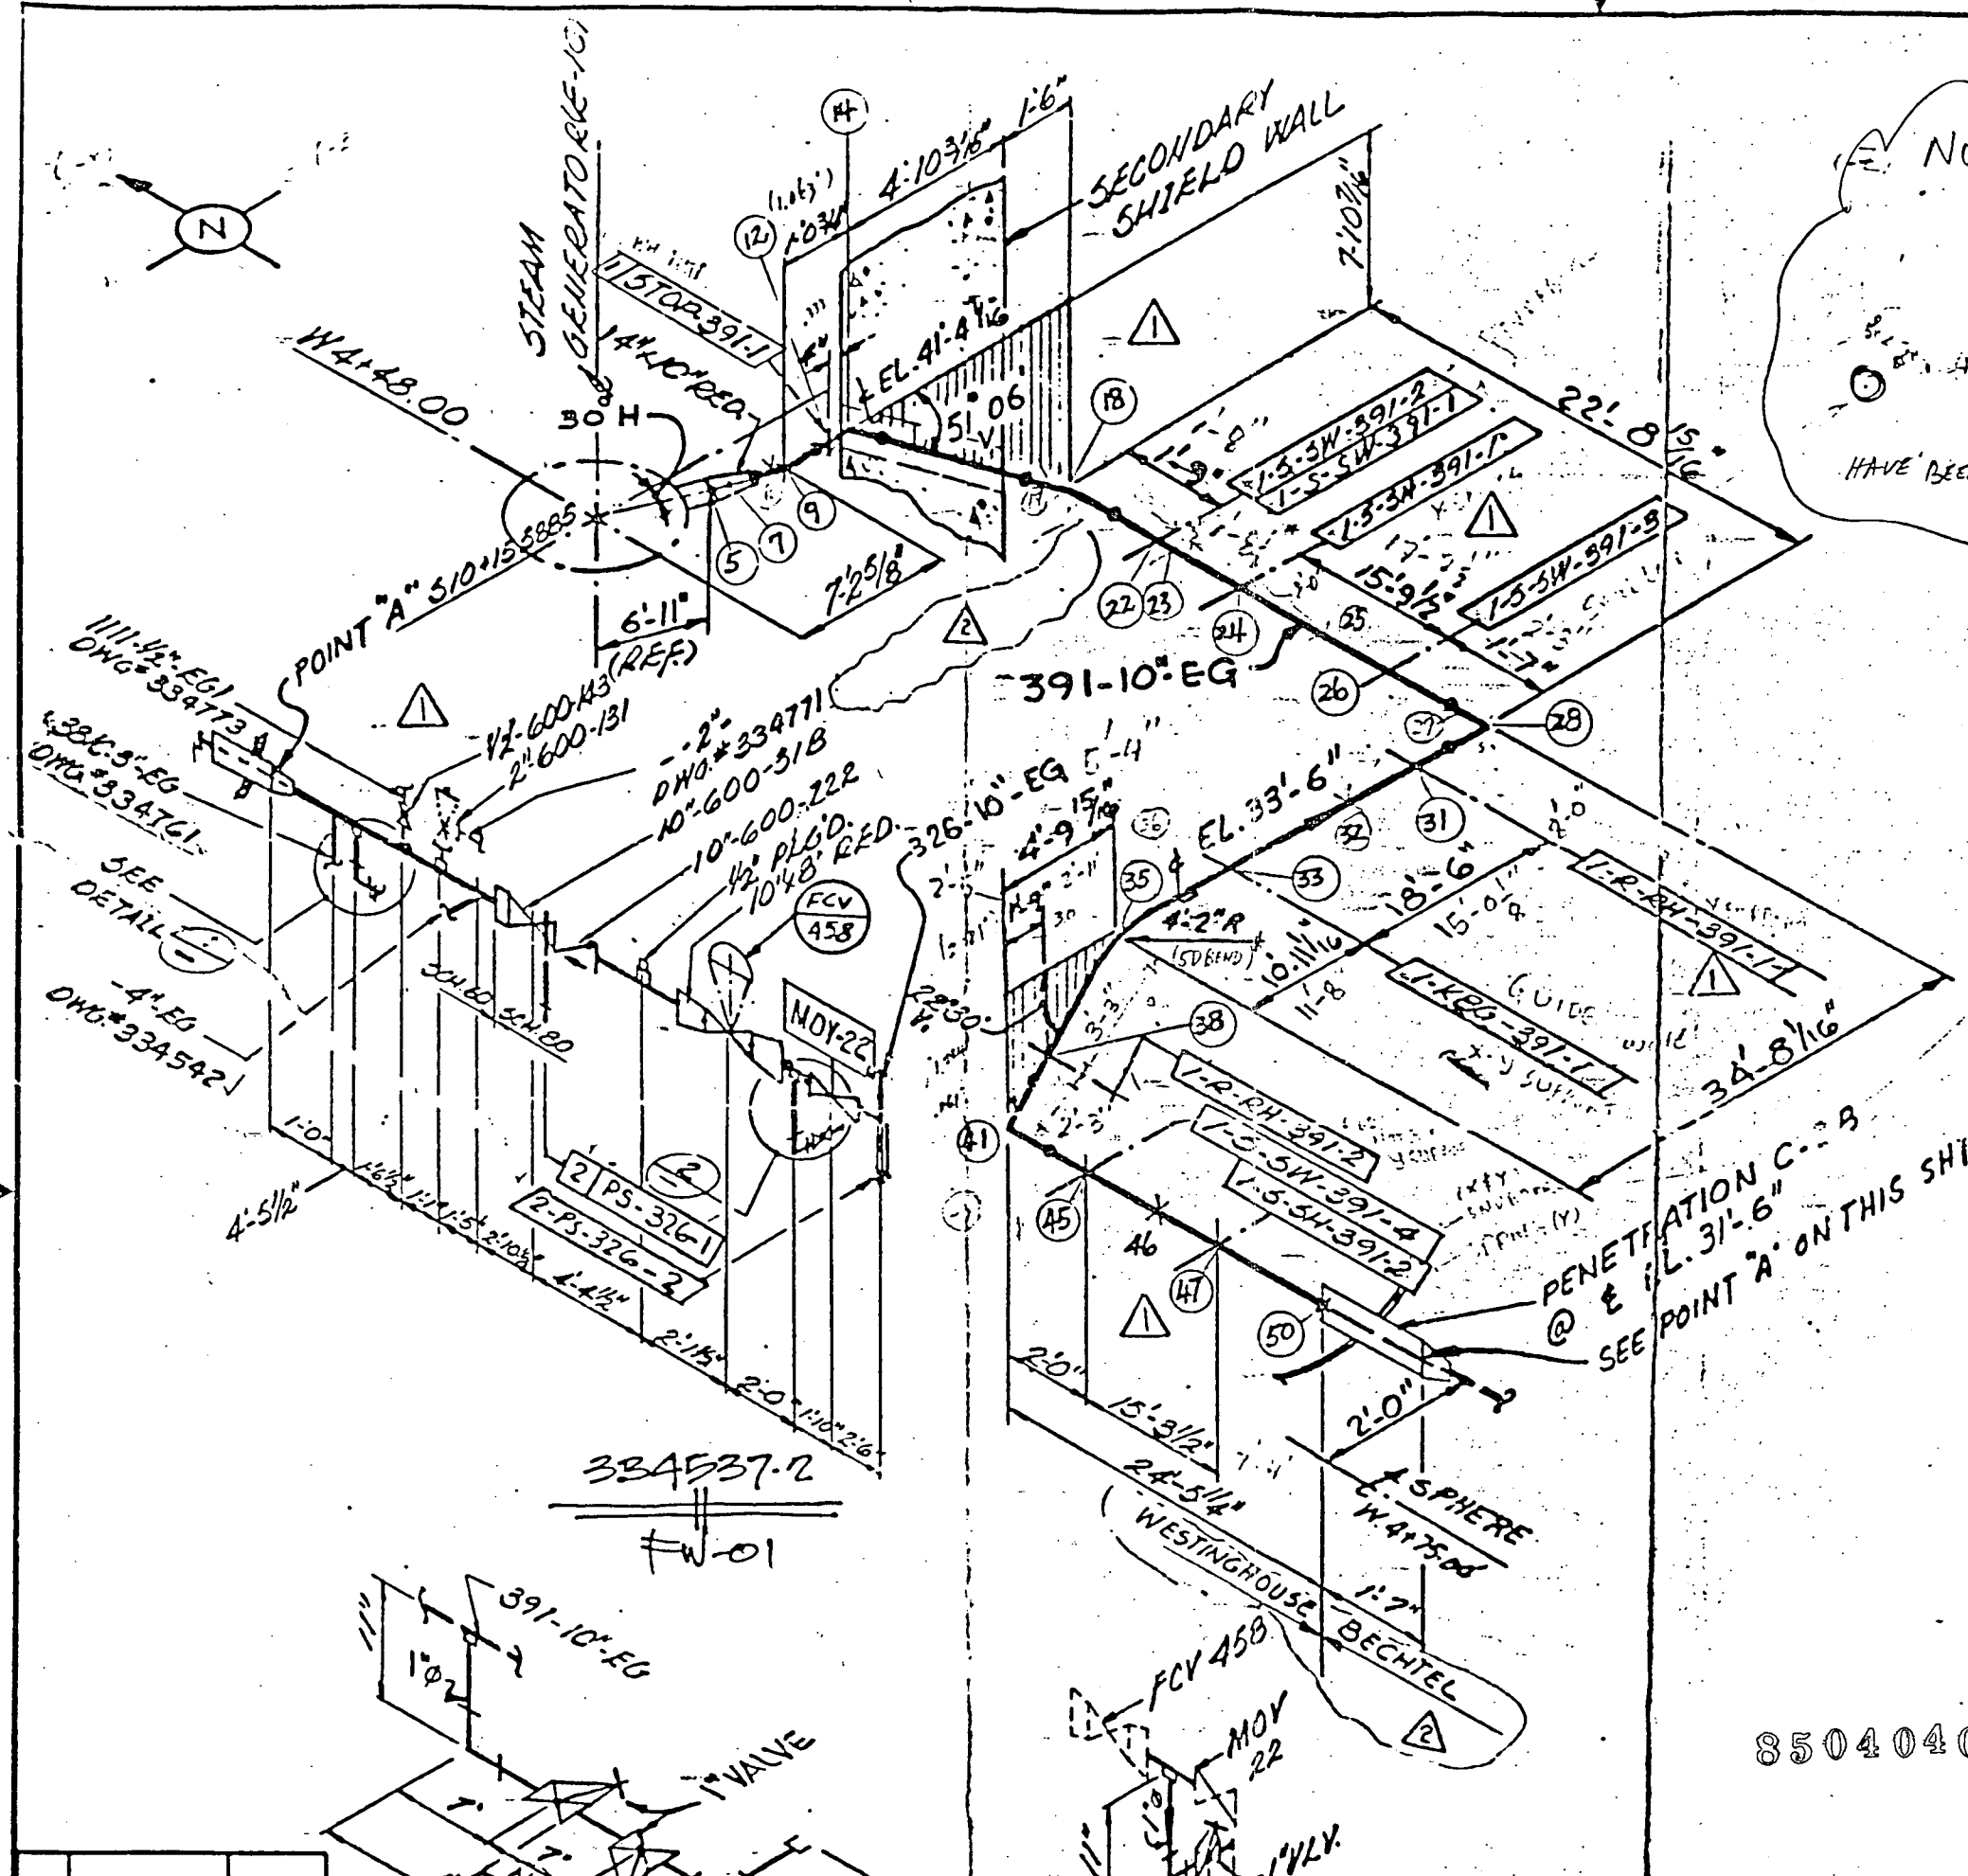

insul.
= 0.74 %
-B
L60

- NOTES:
1. FOR PIPE SUPP DETAILS, SEE 1
 2. ALL PIPING IS TO VERIFY FIT TO WESTINGHOUSE 1 OF ANALYSIS.

Also Available On Aperture Card

TI APERTURE CARD

8504040294-95

CLAS: SAFETY (EXCEPT)



CALCULATION SHEET

11400 E. IMPERIAL HWY.
NORWALK, CALIFORNIA 90650-07


21

SIGNATURE AGP DATE _____ CHECKED _____ DATE _____

PROJECT SAN ONOFRE UNIT - 1 JOB NO. 1304-794

SUBJECT FEED WATER PIPING SHEET 1 OF 1 SHEETS

1
2
3
4
5
6
7
8
9
10
11
12
13
14
15
16
17
18
19
20
21
22
23
24
25
26
27
28
29
30
31
32
33
34
35
36

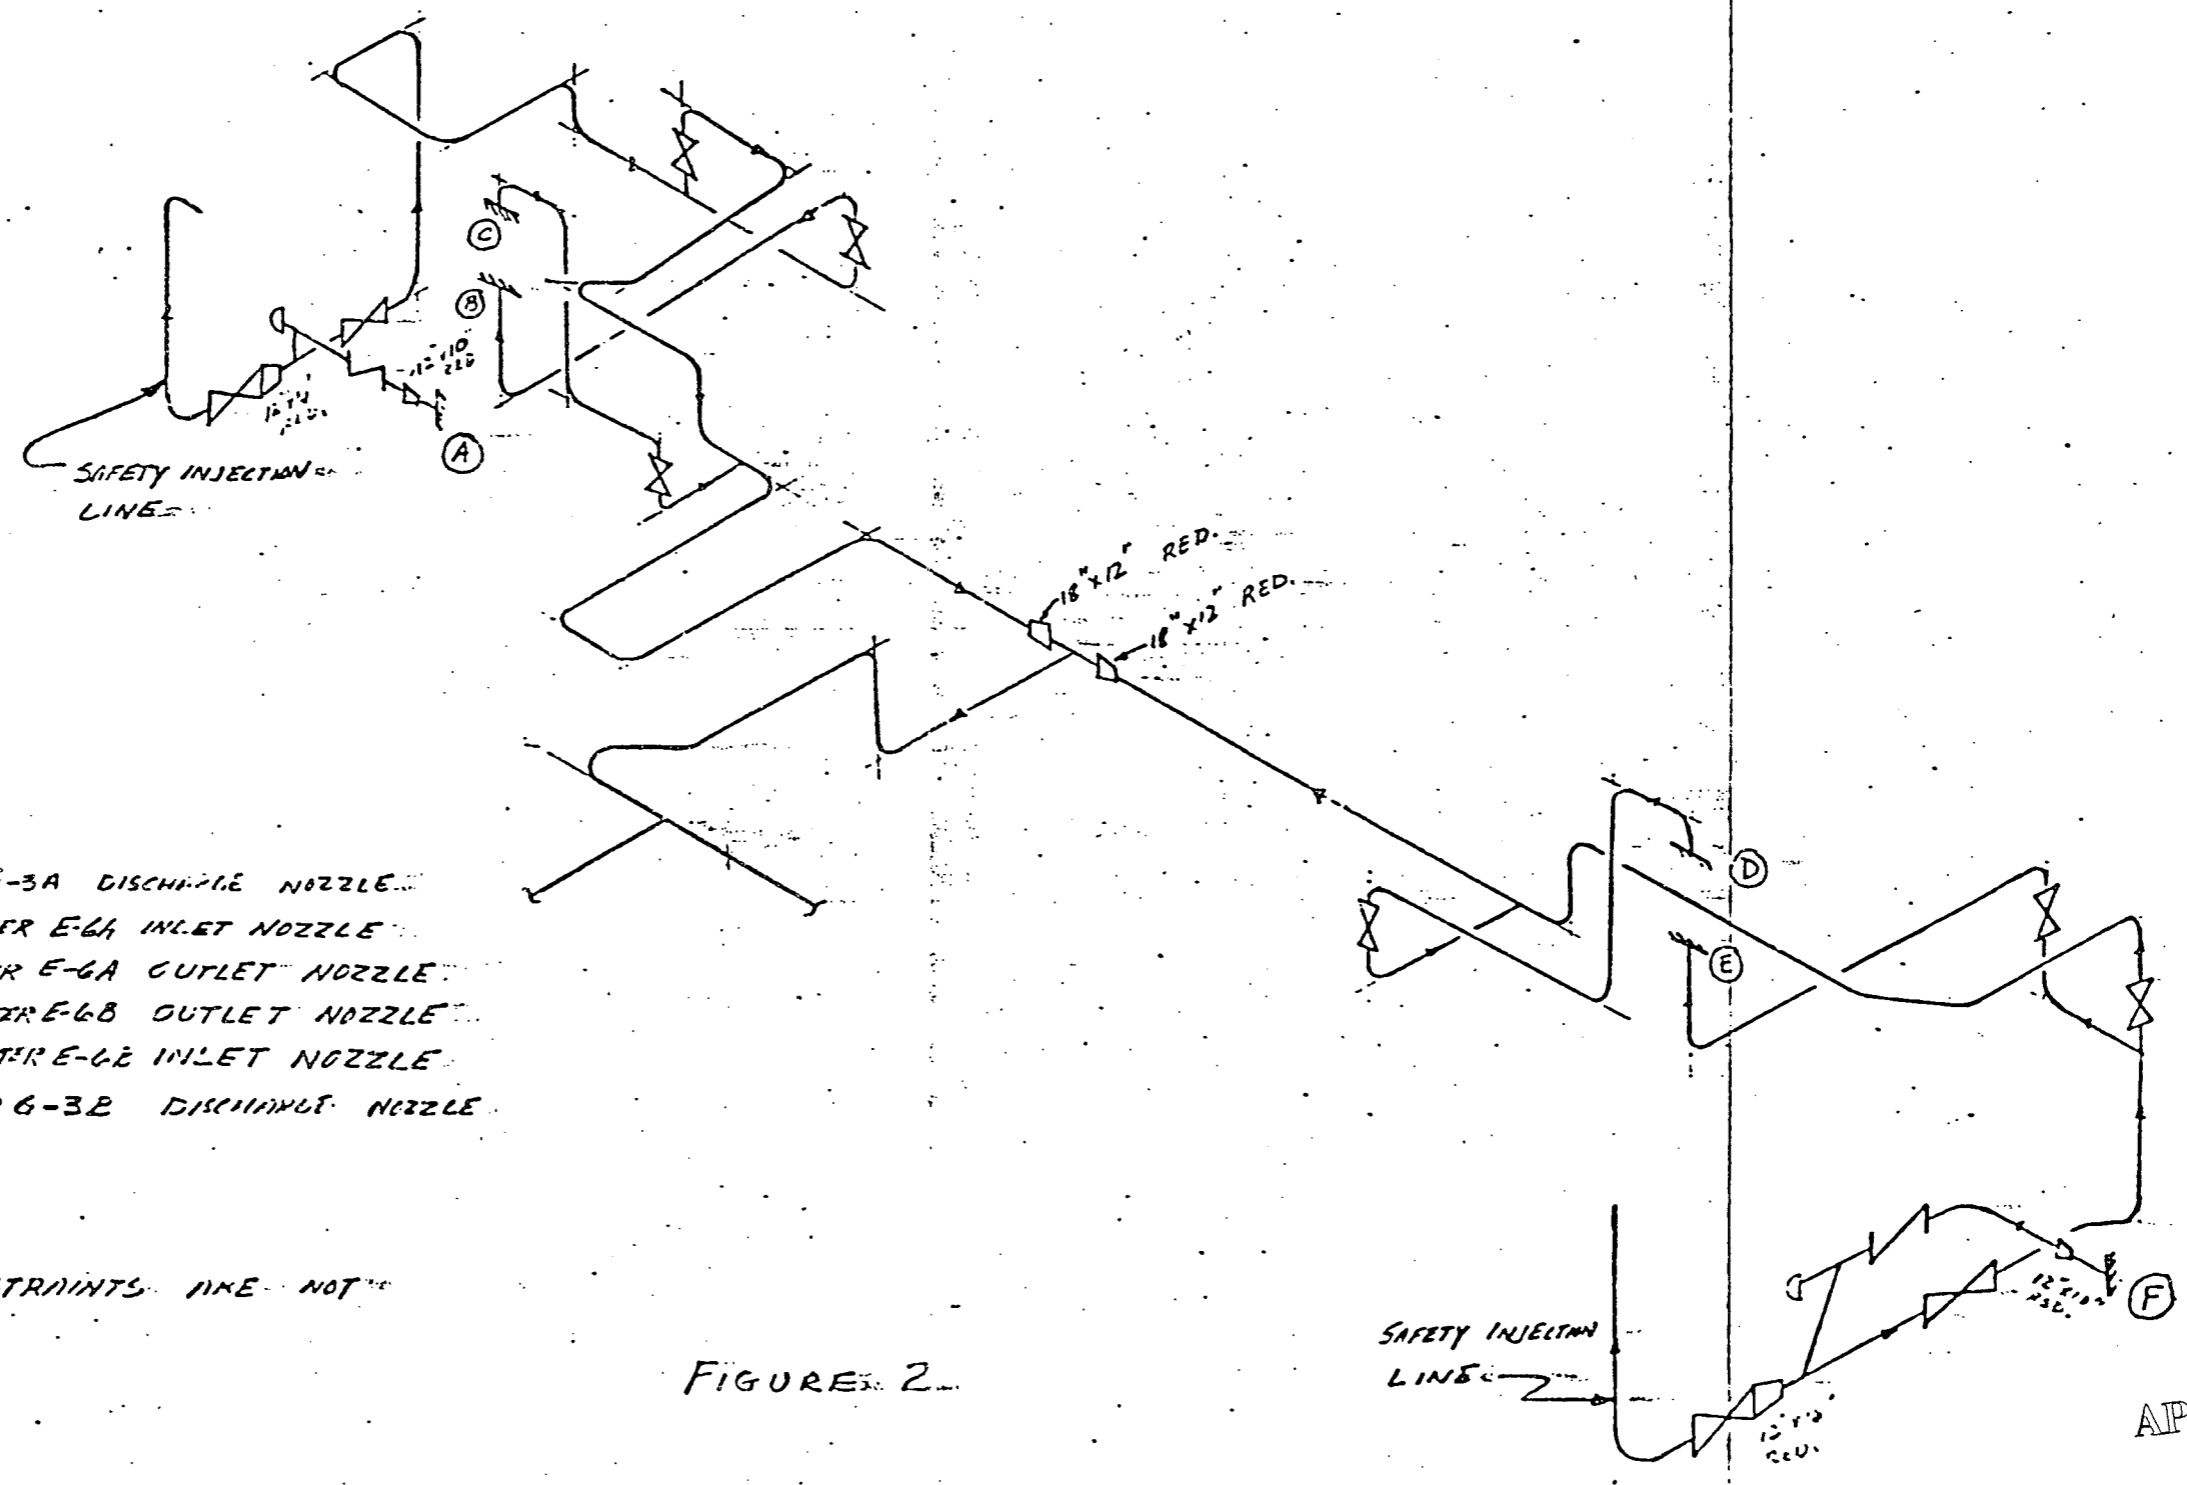

-LEGENDS:

- A = FLD WATER PUMP 6-3A DISCHARGE NOZZLE
- B = 1ST. POINT H.P. HEATER E-6A INLET NOZZLE
- C = 1ST. POINT H.P. HEATER E-6A OUTLET NOZZLE
- D = 1ST. POINT H.P. HEATER E-6B OUTLET NOZZLE
- E = 1ST. POINT H.P. HEATER E-6B INLET NOZZLE
- F = FEED WATER PUMP 6-3B DISCHARGE NOZZLE

NOTES:

1. FOR CLARITY RESTRAINTS ARE NOT SHOWN

FIGURE 2

Also Available On Aperture Card

TI APERTURE CARD



CALCULATION SHEET

11400 E. IMPERIAL HWY.
NORWALK, CALIFORNIA 90650

LAD 0044 070

3

SIGNATURE _____ DATE _____ CHECKED _____ DATE _____
 PROJECT S.O. UNIT-1 JOB NO. 1304-794
 SUBJECT FEED WATER PIPING SHEET _____ OF _____ SHEETS

1
2
3
4
5
6
7
8
9
10
11
12
13
14
15
16
17
18
19
20
21
22
23
24
25
26
27
28
29
30
31
32
33
34
35

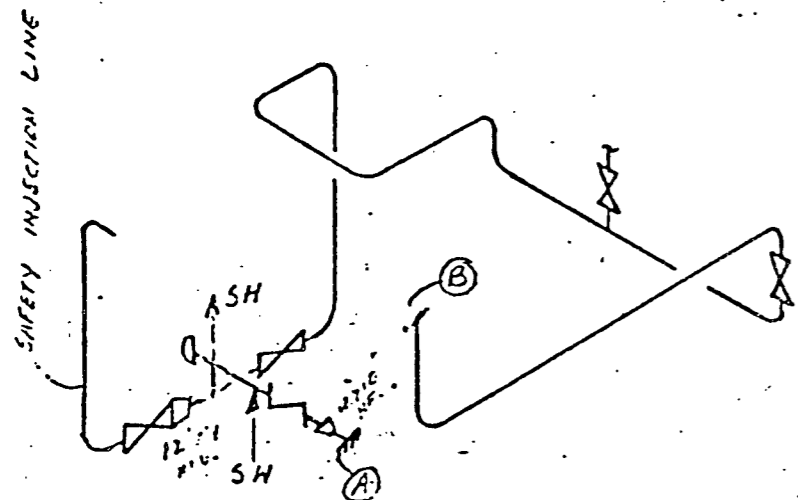


FIGURE 4

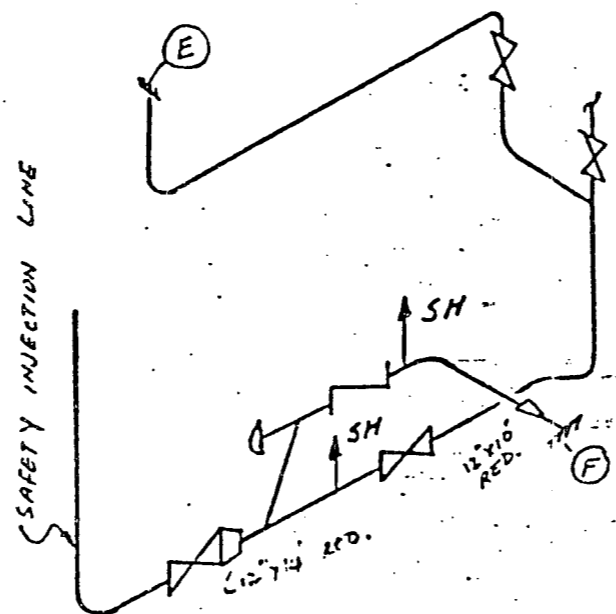


FIGURE 5

LEGENDS:

- A = FEED WATER PUMP 6-3A DISCHARGE NOZZLE
- B = 1ST. POINT H.P. HEATER E-6A INLET NOZZLE
- F = FEED WATER PUMP 6-3B DISCHARGE NOZZLE
- E = 1ST. POINT H.P. HEATER E-6B INLET NOZZLE
- SH = SPRING-HANGER (ADDITIONAL)
- SN = SWAY-SNUBBER (ADDITIONAL)
- CS = CONTAINMENT STRUCTURES (ANCHORS)

NOTES:

1. FOR CLARITY NO RESTRAINTS EXCEPT THE FOUR ADDITIONAL ONES ARE SHOWN IN THESE FIGURES.

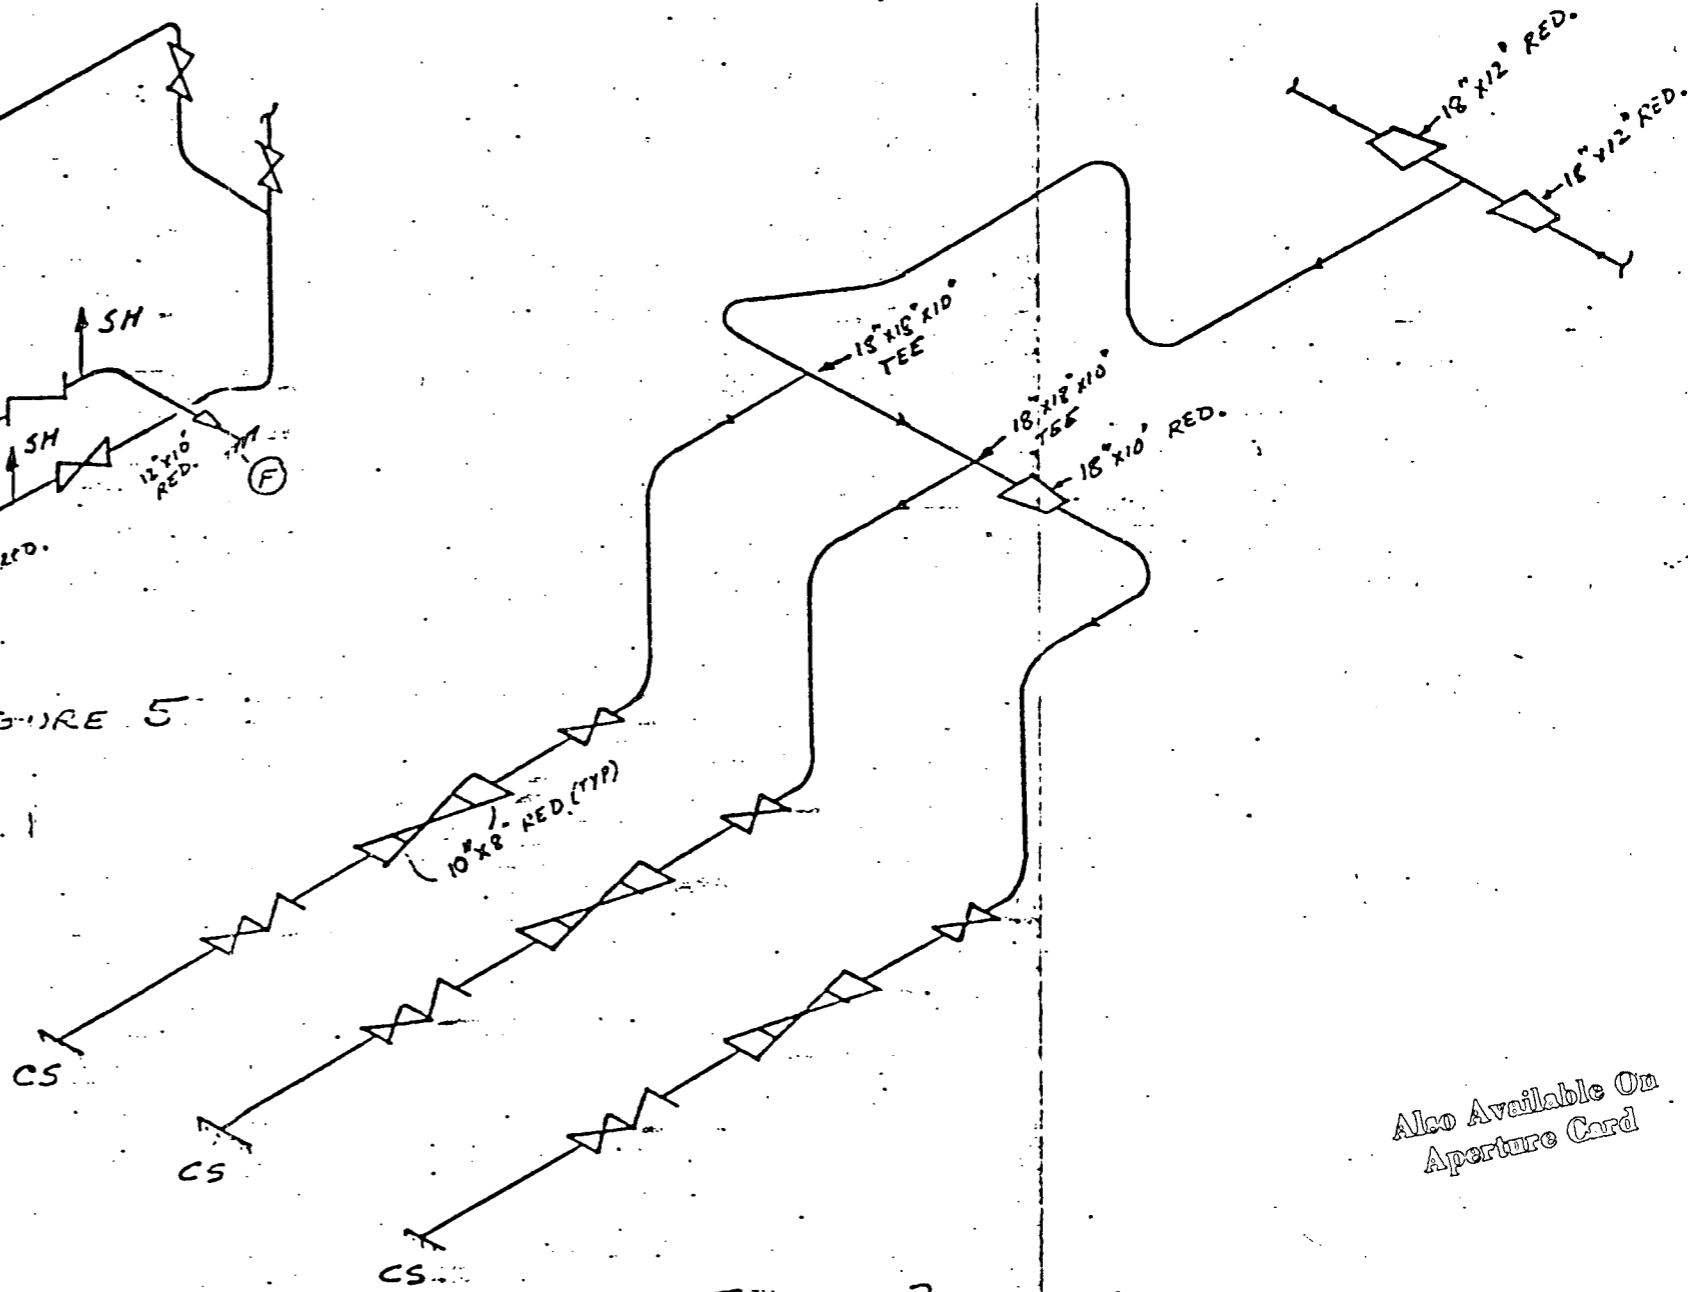


FIGURE 3


Also Available On Aperture Card

TI APERTURE CARD


PROJECT: SONGS No. 1

FEED WATER LINE

FIGURE 6, SHEET 1

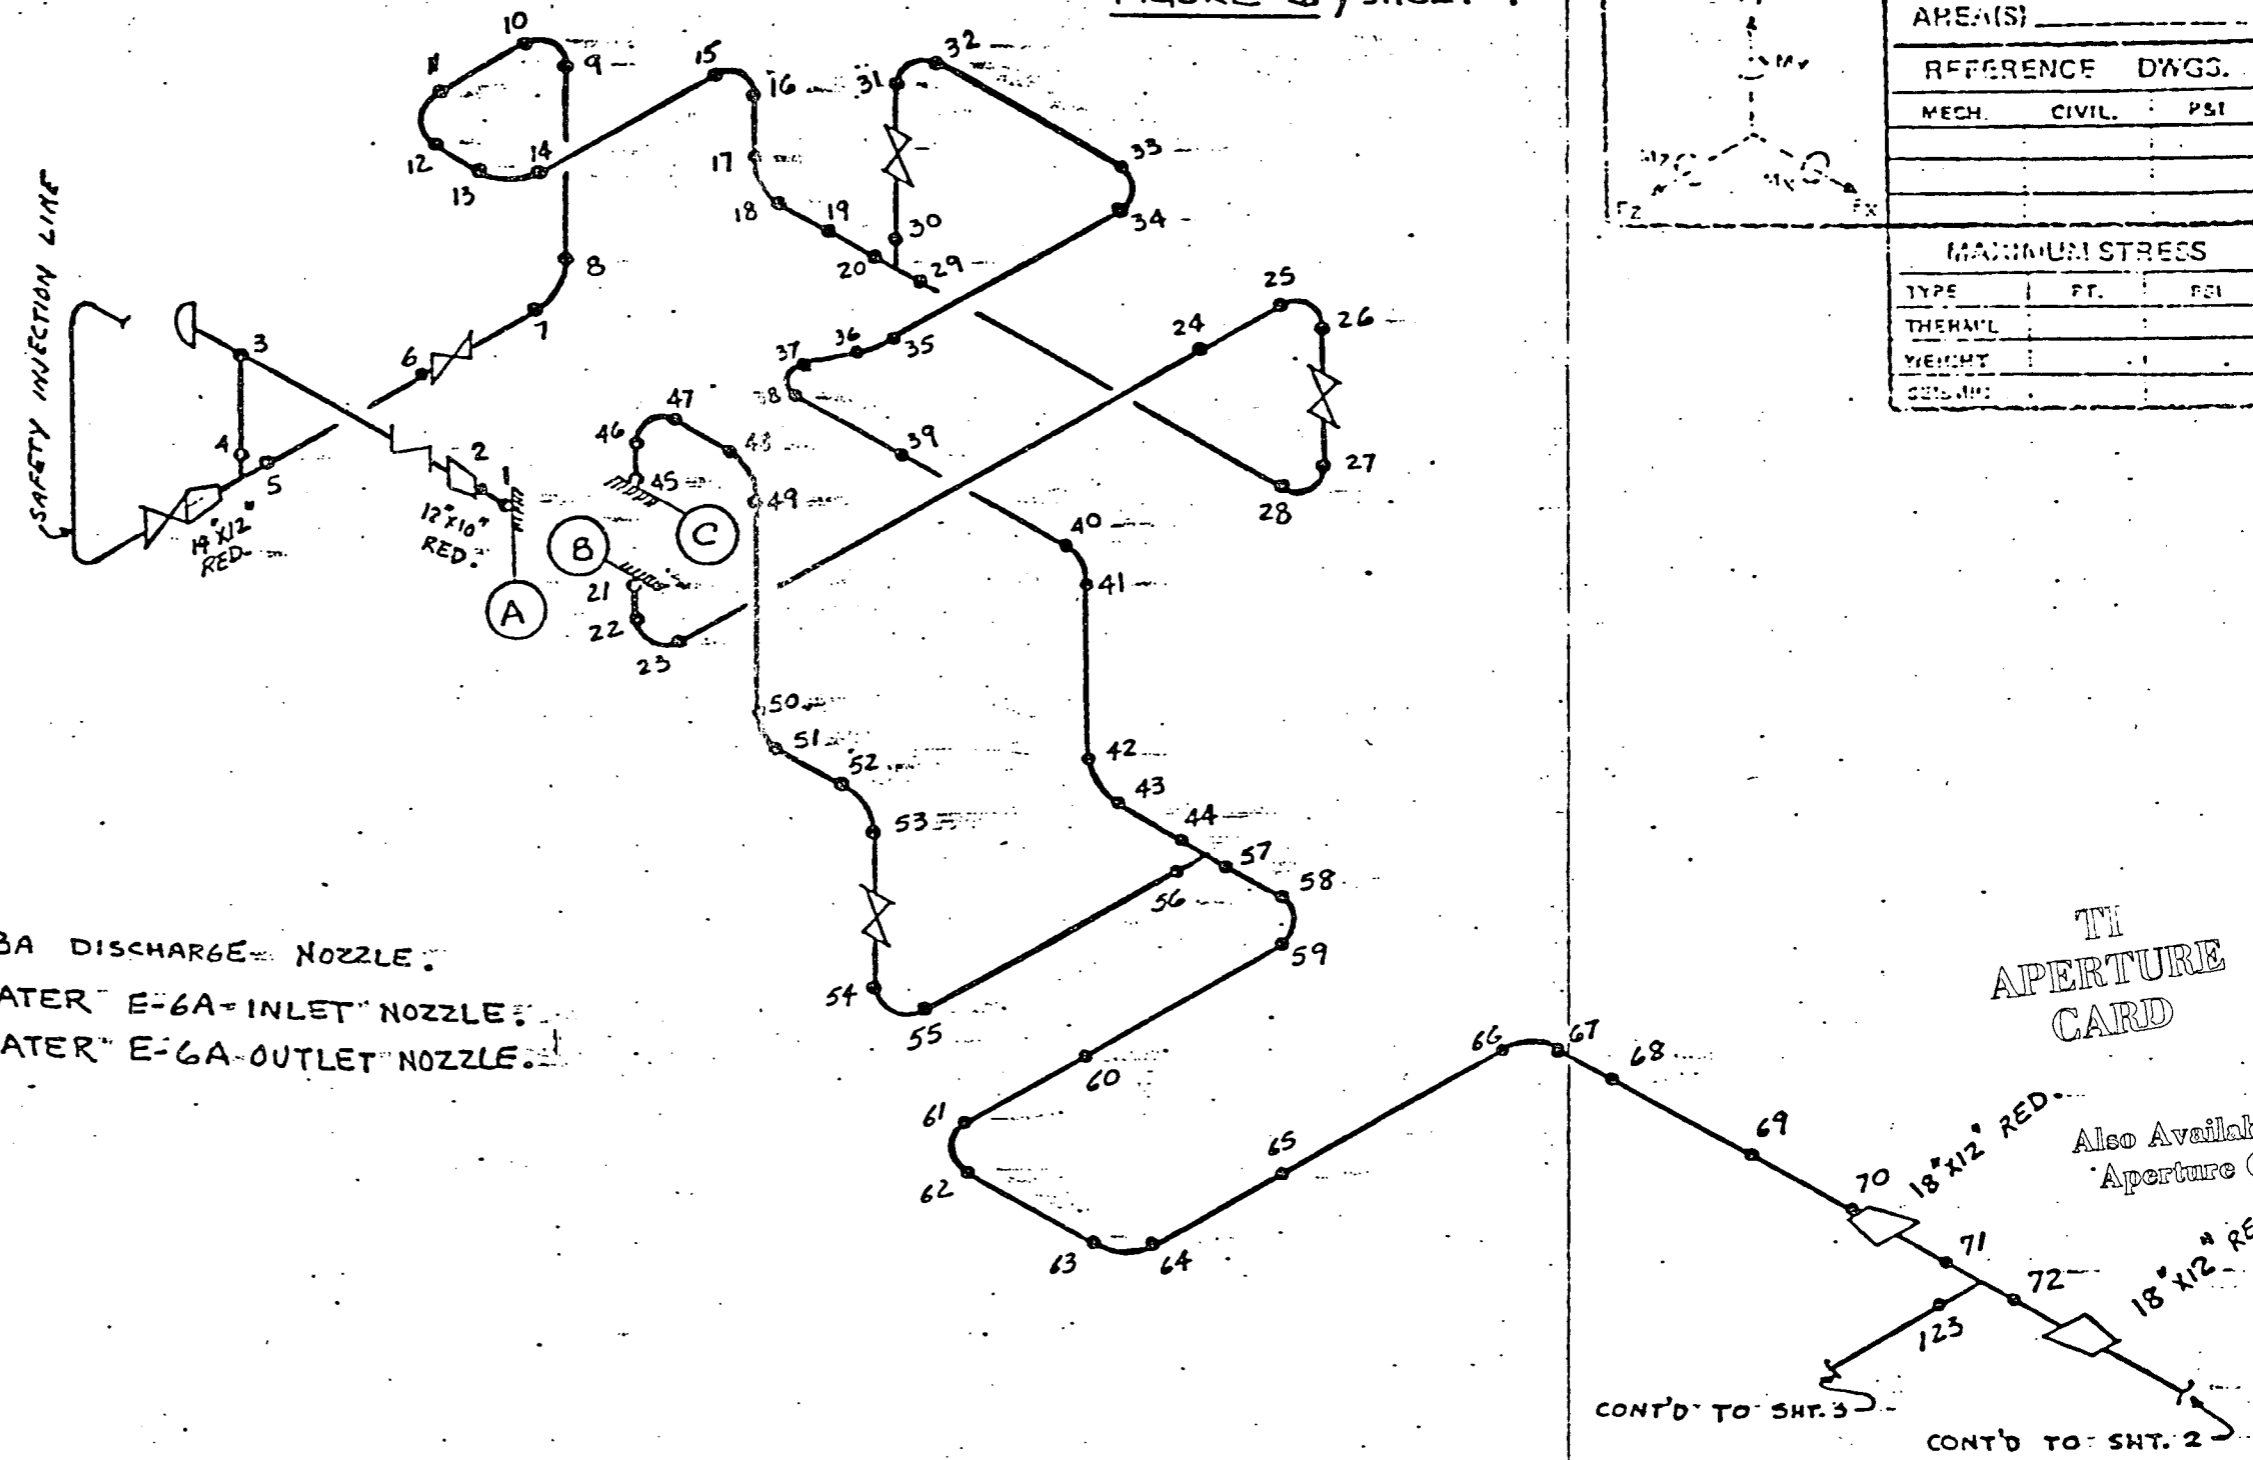

- A = FEED WATER PUMP G-3A DISCHARGE NOZZLE.
- B = 1ST. POINT H.P. HEATER E-6A INLET NOZZLE.
- C = 1ST. POINT H.P. HEATER E-6A OUTLET NOZZLE.

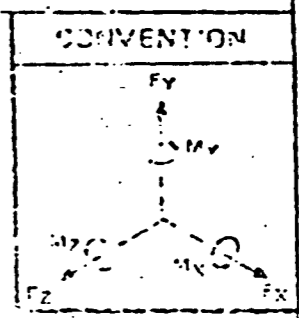

| | | |
|---------------------|--------|-----|
| SHEET 1 OF 3 | | |
| BY AGA DATE 6-20-73 | | |
| AREA(S) _____ | | |
| REFERENCE DWGS. | | |
| MECH. | CIVIL. | PSI |
| | | |
| MAXIMUM STRESS | | |
| TYPE | FT. | PSI |
| THERMAL | | |
| WEIGHT | | |
| SEISMIC | | |

TI APERTURE CARD

Also Available On Aperture Card

CONT'D TO SHT. 3

CONT'D TO SHT. 2


| | | | | | | | | | | | |
|------|----|------|-------------|------|----|------|-------------|------|----|------|-------------|
| REV. | BY | DATE | DESCRIPTION | REV. | BY | DATE | DESCRIPTION | REV. | BY | DATE | DESCRIPTION |
| | | | | | | | | | | | |

PROJECT **SONGS - No 1**

SUBJECT **FEED WATER PIPE**

ADDITIONAL INFORMATION (ISOMETRIC DATA AND DETAIL SHEET)

FIGURE 1, SHEET 2

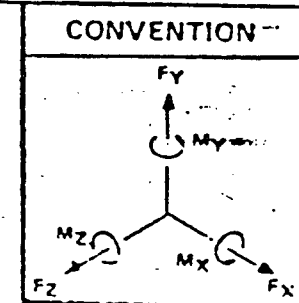

SHEET 2 OF 3

BY AGA-DATE 6-20-73


AREA(S)

REFERENCE DWGS.

| MECH. | CIVIL | PSI |
|-------|-------|-----|
| | | |
| | | |
| | | |

MAXIMUM STRESS

| TYPE | PT. | PSI |
|---------|-----|-----|
| THERML | | |
| WEIGHT | | |
| SEISMIC | | |

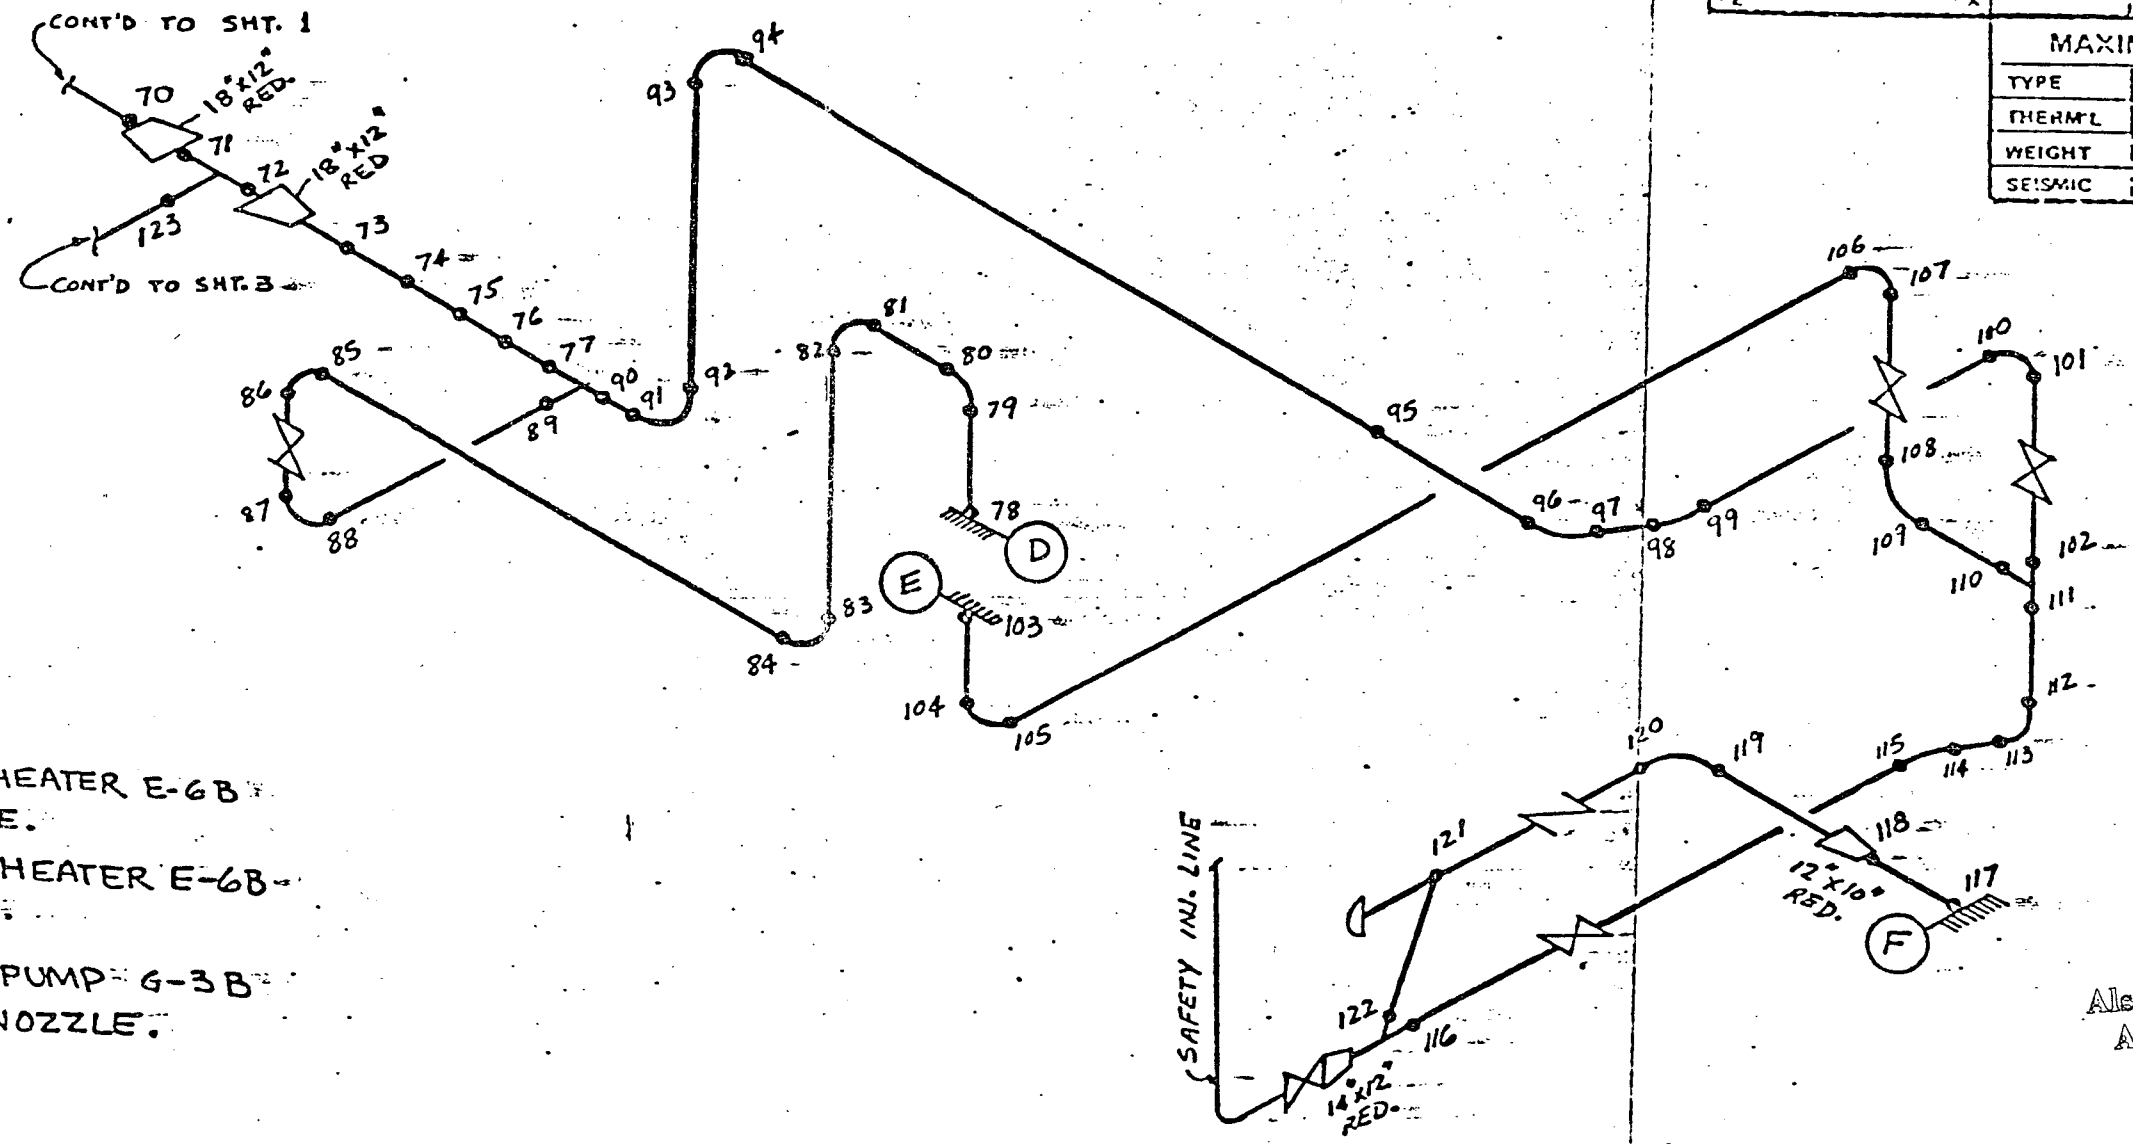

- D = 1ST. POINT H.P. HEATER E-6B OUTLET NOZZLE.
- E = 1ST. POINT H.P. HEATER E-6B INLET NOZZLE.
- F = FEED WATER PUMP G-3B DISCHARGE NOZZLE.

Also Available On Aperture Card

TI APERTURE CARD

| REV. | BY | DATE | CHK'D | DATE | DESCRIPTION | REV. | BY | DATE | CHK'D | DATE | DESCRIPTION |
|-----------|----|------|-------|------|-------------|-----------|----|------|-------|------|-------------|
| REVISIONS | | | | | | REVISIONS | | | | | |

PROJECT **SONGS No 1**

SUBJECT **FEED WATER PIPE**

SHEET 3 OF 3

BY AGA DATE 6-20-73

AREA(S) _____

REFERENCE DWGS. _____

MECH. CIVIL PSI

MAXIMUM STRESS

| TYPE | PT. | PSI |
|---------|-----|-----|
| THERMAL | | |
| WEIGHT | | |
| SEISMIC | | |


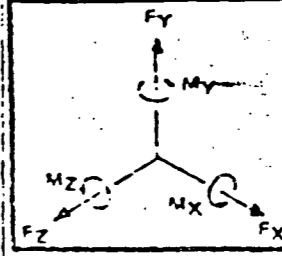


FIGURE 6, SHEET 3.

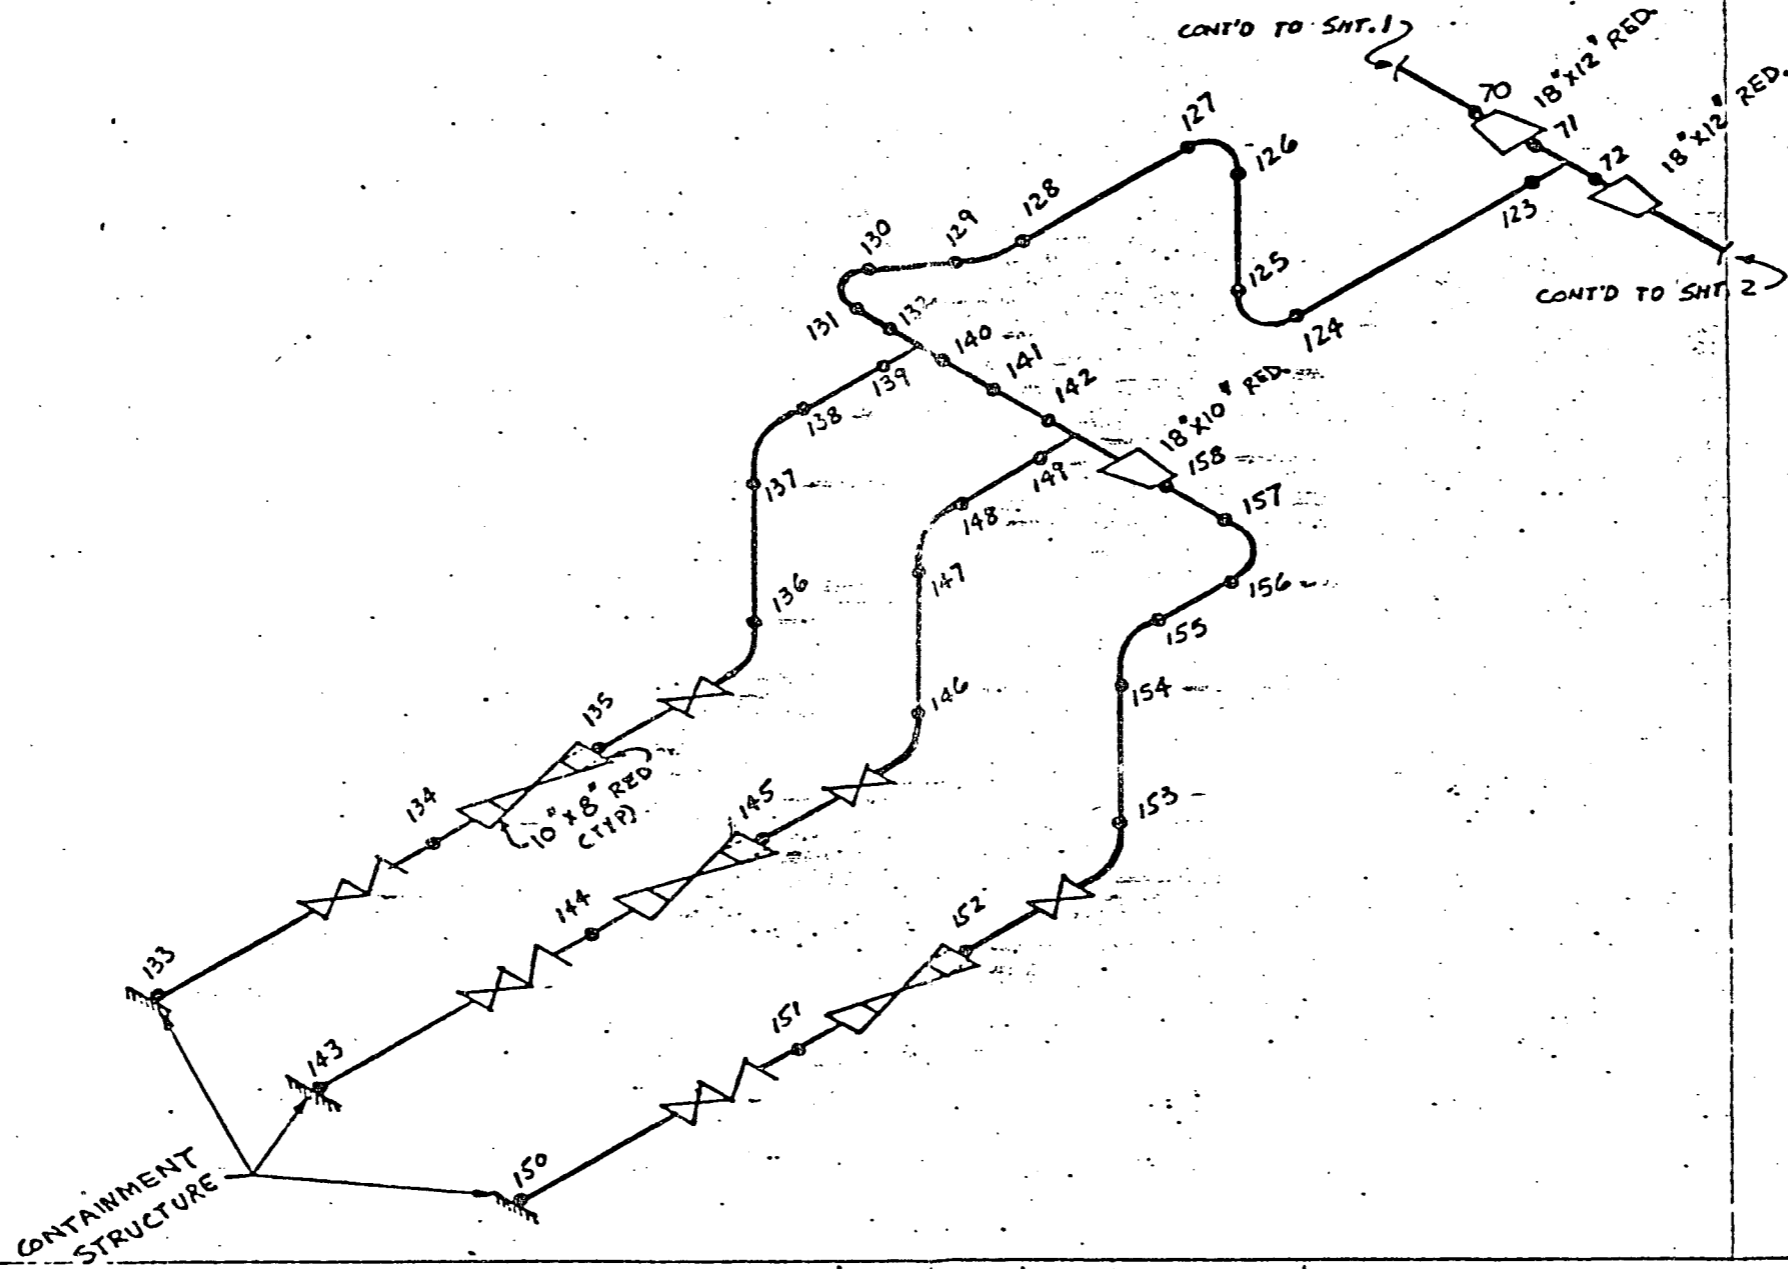

Also Available On Aperture Card

TI APERTURE CARD

| REV. | BY | DATE | CHK'D | DATE | DESCRIPTION | REV. | BY | DATE | CHK'D | DATE | DESCRIPTION |
|-----------|----|------|-------|------|-------------|-----------|----|------|-------|------|-------------|
| REVISIONS | | | | | | REVISIONS | | | | | |

BECHTEL JOB NO. _____

LAD 10 15 73



' FEED WATER PIPING' (TABLE Z)

JUL 19 73 A.G. ATHAR

7

| NODE | SEISMIC | | | | | WEIGHT | THERMAL | PRESSURE | | | | NODE | σ_{T+Q} | $\frac{\sigma_{T+Q}}{S_A+S_H}$ | $\frac{\sigma_T}{S_A}$ |
|------|---------|------|---------------|-----|-----------|--------|---------|----------|--------|-------|--------------------|------|----------------|--------------------------------|------------------------|
| | X | Z | Y INC. WEIGHT | Y | RESULTANT | | | P | d | D | $\frac{Pd^2}{D^3}$ | | | | |
| 1 | 1727 | 3545 | 73 | 29 | 3943 | 44 | 2747 | 1385 | 9.564 | 10.75 | 5258 | 1 | 11,992 | .32 | .12 |
| 2 | 1545 | 2958 | 30 | 12 | 3337 | 18 | 2696 | | 9.564 | 10.75 | 5258 | 2 | 11,319 | .30 | .12 |
| 3 | | | | | 2320 | 69 | 1803 | | 11.376 | 12.75 | 5407 | 3 | 9,599 | .26 | .08 |
| 4 | | | | | 3818 | 210 | 2348 | | | | | 4 | 11,783 | .31 | .10 |
| 5 | | | | | 3699 | 1090 | 2037 | | | | | 5 | 12,233 | .33 | .09 |
| 6 | 1435 | 1373 | 385 | 154 | 1992 | 231 | 1410 | | | | | 6 | 9,040 | .24 | .06 |
| 7 | 750 | 2147 | 313 | 125 | 2278 | 188 | 1211 | | | | | 7 | 9,084 | .24 | .05 |
| 8 | 1759 | 1666 | 236 | 94 | 2425 | 142 | 1587 | | | | | 8 | 9,561 | .25 | .07 |
| 9 | 396 | 1005 | 353 | 141 | 1089 | 212 | 1866 | | | | | 9 | 8,574 | .23 | .08 |
| 10 | 477 | 183 | 572 | 229 | 560 | 343 | 1375 | | | | | 10 | 7,685 | .20 | .06 |
| 11 | 1502 | 1581 | 241 | 96 | 2183 | 145 | 2290 | | | | | 11 | 10,025 | .27 | .10 |
| 12 | 1821 | 1211 | 987 | 395 | 2222 | 592 | 3281 | | | | | 12 | 11,502 | .31 | .15 |
| 13 | 1416 | 580 | 534 | 214 | 1545 | 320 | 1767 | | | | | 13 | 9,039 | .24 | .08 |
| 14 | 2039 | 1138 | 865 | 346 | 2361 | 519 | 908 | | | | | 14 | 9,195 | .25 | .04 |
| 15 | 4464 | 1596 | 418 | 167 | 4744 | 251 | 1230 | | | | | 15 | 11,632 | .31 | .05 |
| 16 | 1195 | 1317 | 907 | 363 | 1815 | 544 | 1221 | | | | | 16 | 8,987 | .24 | .05 |
| 17 | 1200 | 1375 | 905 | 362 | 1861 | 543 | 1182 | | | | | 17 | 8,993 | .24 | .05 |
| 18 | 4388 | 1319 | 1637 | 655 | 4629 | 982 | 1726 | | | | | 18 | 12,744 | .34 | .08 |
| 19 | 2799 | 946 | 1193 | 477 | 2993 | 716 | 1041 | | | | | 19 | 10,157 | .27 | .05 |
| 20 | | | | | 6250 | 1886 | 2712 | | | | | 20 | 16,255 | .43 | .12 |
| 21 | 1203 | 2875 | 80 | 32 | 3117 | 48 | 2098 | | | | | 21 | 10,670 | .28 | .09 |
| 22 | 1378 | 231 | 415 | 166 | 1407 | 249 | 2674 | | | | | 22 | 9,737 | .26 | .12 |
| 23 | 921 | 1399 | 46 | 18 | 1675 | 28 | 1838 | | | | | 23 | 8,948 | .24 | .08 |
| 24 | 1856 | 1318 | 64 | 26 | 2277 | 38 | 664 | | | | | 24 | 8,386 | .22 | .03 |
| 25 | 2912 | 2478 | 199 | 80 | 3824 | 119 | 725 | | | | | 25 | 10,075 | .27 | .03 |
| 26 | 395 | 1636 | 1383 | 553 | 1772 | 830 | 1062 | | | | | 26 | 9,071 | .24 | .05 |
| 27 | 3420 | 1429 | 1522 | 609 | 3756 | 913 | 2974 | | | | | 27 | 13,050 | .35 | .13 |
| 28 | 3800 | 309 | 525 | 210 | 3818 | 315 | 2252 | | | | | 28 | 11,792 | .31 | .10 |
| 29 | | | | | 5217 | 2361 | 2117 | | | | | 29 | 15,102 | .40 | .09 |
| 30 | | | | | 3356 | 854 | 4281 | | | | | 30 | 13,898 | .37 | .19 |
| 31 | 1071 | 3575 | 1402 | 561 | 3774 | 841 | 2507 | | | | | 31 | 12,529 | .33 | .11 |
| 32 | 1419 | 1571 | 595 | 238 | 2130 | 357 | 2050 | | | | | 32 | 9,944 | .27 | .09 |
| 33 | 1064 | 1345 | 513 | 205 | 1727 | 308 | 1606 | | | | | 33 | 9,048 | .24 | .07 |
| 34 | 407 | 1511 | 352 | 141 | 1571 | 211 | 1344 | | | | | 34 | 8,533 | .23 | .06 |

$P = 1385 \text{ psig (MAX)}$
 $T = 420^\circ \text{F (MAX)}$
 MATERIAL: CB-A-106-GR.B
 $S_C = 15,000 \text{ psi}$
 $S_H = 15,000 \text{ psi}$
 $S_A = 1.25 S_C + 0.25 S_H$
 $= 22,500 \text{ psi}$
 $S_A + S_H = 37,500 \text{ psi}$

NOTE:
 FOR TEE'S STRESSES WERE
 HAND-CALCULATED BY USING
 MOMENTS FROM COMPUTER
 OUTPUT WITH AN APPROPRIATE
 STRESS INTENSIFICATION
 FACTOR.
 STATIC ANALYSIS FROM ORIGINAL

Also Available On Aperture Card

APERTURE CARD



"FEED WATER PIPING" (TABLE 2) CONT.

| NODE | SEISMIC | | | | | WEIGHT | THERMAL | PRESSURE | | | | NODE | $\frac{\sigma_x + \sigma_y}{2}$ | $\frac{\sigma_x - \sigma_y}{2}$ | $\frac{\sigma_z}{3}$ |
|------|---------|------|-------------|-----|----------|--------|---------|----------|--------|-------|------------------|------|---------------------------------|---------------------------------|----------------------|
| | X | Z | Y WEIGHT | Y | CONSTANT | | | P | d | D | $\frac{Pd}{D^2}$ | | | | |
| 35 | 2190 | 416 | 350 | 140 | 2234 | 210 | 4746 | 1385 | 11.376 | 12.75 | 5407 | 35 | 12597 | .34 | .21 |
| 36 | 2024 | 739 | 427 | 171 | 2161 | 256 | 4142 | | | | | 36 | 11966 | .32 | .18 |
| 37 | 2027 | 753 | 429 | 172 | 2169 | 257 | 4241 | | | | | 37 | 12074 | .32 | .19 |
| 38 | 1810 | 1039 | 297 | 119 | 2090 | 178 | 5542 | | | | | 38 | 13217 | .35 | .25 |
| 39 | 1005 | 807 | 273 | 109 | 1294 | 164 | 3036 | | | | | 39 | 9901 | .26 | .13 |
| 40 | 1849 | 1262 | 422 | 169 | 2245 | 253 | 2651 | | | | | 40 | 10556 | .28 | .12 |
| 41 | 633 | 1016 | 1080 | 432 | 1273 | 648 | 1754 | | | | | 41 | 9082 | .24 | .08 |
| 42 | 2192 | 2352 | 1414 | 566 | 3265 | 848 | 1527 | | | | | 42 | 11047 | .29 | .07 |
| 43 | 1673 | 2733 | 845 | 338 | 3222 | 507 | 3214 | | | | | 43 | 12350 | .33 | .14 |
| 44 | | | | | 2605 | 897 | 2892 | | | | | 44 | 11801 | .31 | .13 |
| 45 | 858 | 391 | 1304 | 522 | 1078 | 782 | 2640 | | | | | 45 | 9907 | .26 | .12 |
| 46 | 1578 | 489 | 2392 | 957 | 1909 | 1435 | 4120 | | | | | 46 | 12871 | .34 | .18 |
| 47 | 1827 | 687 | 597 | 239 | 1966 | 358 | 3320 | | | | | 47 | 11051 | .29 | .15 |
| 48 | 1853 | 680 | 325 | 130 | 1978 | 195 | 3628 | | | | | 48 | 11208 | .30 | .16 |
| 49 | 1712 | 599 | 1345 | 538 | 538 | 807 | 4047 | | | | | 49 | 10799 | .29 | .18 |
| 50 | 2405 | 1356 | 259 | 104 | 2763 | 155 | 6046 | | | | | 50 | 14371 | .38 | .27 |
| 51 | 2450 | 1229 | 316 | 126 | 2744 | 190 | 5265 | | | | | 51 | 13606 | .36 | .23 |
| 52 | 1322 | 3539 | 306 | 122 | 3780 | 184 | 3459 | | | | | 52 | 12830 | .34 | .15 |
| 53 | 1397 | 3079 | 419 | 168 | 3385 | 251 | 4255 | | | | | 53 | 13298 | .35 | .19 |
| 54 | 3469 | 3247 | 2092 | 839 | 4825 | 1259 | 941 | | | | | 54 | 12432 | .33 | .04 |
| 55 | 4352 | 2284 | 753 | 381 | 4927 | 572 | 2786 | | | | | 55 | 13692 | .37 | .12 |
| 56 | | | | | 3105 | 1322 | 4331 | | | | | 56 | 14165 | .38 | .19 |
| 57 | | | | | 2088 | 652 | 5515 | | | | | 57 | 13662 | .36 | .25 |
| 58 | 3246 | 670 | 1301 | 520 | 3355 | 781 | 5789 | | | | | 58 | 15332 | .41 | .26 |
| 59 | 2695 | 275 | 1687 | 675 | 2795 | 1012 | 6117 | | | | | 59 | 15331 | .41 | .27 |
| 60 | 1945 | 1362 | 1034 | 414 | 2413 | 620 | 4241 | | | | | 60 | 12681 | .34 | .19 |
| 61 | 1755 | 2416 | 1024 | 410 | 3032 | 614 | 11494 | | | | | 61 | 20547 | .55 | .51 |
| 62 | 510 | 1204 | 559 | 224 | 1327 | 335 | 12954 | | | | | 62 | 20023 | .53 | .58 |
| 63 | 203 | 1560 | 502 | 201 | 1586 | 301 | 11094 | | | | | 63 | 18388 | .49 | .49 |
| 64 | 229 | 2978 | 341 | 136 | 2990 | 204 | 7770 | | | | | 64 | 16371 | .44 | .35 |
| 65 | 497 | 1555 | 330 | 132 | 1638 | 198 | 2226 | | | | | 65 | 9469 | .25 | .10 |
| 66 | 1545 | 2543 | 681 | 272 | 3165 | 409 | 7111 | | | | | 66 | 16092 | .43 | .32 |
| 67 | 1297 | 4726 | 495 | 198 | 4903 | 297 | 10235 | | | | | 67 | 20842 | .56 | .45 |
| 68 | 982 | 2900 | 364 | 146 | 3065 | 218 | 5764 | | | | | 68 | 14454 | .39 | .26 |
| 69 | 1152 | 1584 | 1083 | 433 | 2009 | 650 | 8476 | | | | | 69 | 16542 | .44 | .38 |

TEE

TEE
TEE

Also Available On Aperture Card

APERTURE CARD

RECEIVED

" FEED WATER PIPING " (TABLE 2) CONT.

| NODE | SEISMIC | | | | | WEIGHT | THERMAL | PRESSURE | | | | NODE | S ₁ | S ₂ | S ₃ | TEE |
|------|---------------|---------------|-----------------------------|-----------------------------|-----------------------------|-----------------------------|------------|----------|--------|-------|-----------------|-----------------------|-----------------------|-----------------------|----------------|-----|
| | X | Z | Y INC. WEIGHT | Y | RESULTANT | | | P | d | D | Pd ² | | | | | |
| | σ_{sx} | σ_{sz} | $\sigma_{1y} + \sigma_{2y}$ | $\sigma_{1z} + \sigma_{2z}$ | $\sigma_{1r} + \sigma_{2r}$ | $\sigma_{1s} + \sigma_{2s}$ | σ_T | | | | | $\sigma_1 + \sigma_2$ | $\sigma_1 + \sigma_2$ | $\sigma_1 + \sigma_2$ | | |
| 70 | 1658 | 3493 | 1333 | 533 | 3916 | 780 | 10058 | 1385 | 11.376 | 12.75 | 5407 | 70 | 20161 | .54 | .45 | |
| 71 | | | | | 2690 | 626 | 5805 | 1385 | 16.126 | 18.0 | 5632 | 71 | 14,753 | .39 | .26 | TEE |
| 72 | | | | | 2557 | 1416 | 3455 | | | | | 72 | 13,060 | .35 | .15 | TEE |
| 73 | 1474 | 3008 | 2068 | 827 | 3450 | 1241 | 5416 | 1385 | 11.376 | 12.75 | 5407 | 73 | 15,514 | .41 | .24 | |
| 74 | 1351 | 3447 | 1316 | 526 | 3750 | 790 | 3624 | | | | | 74 | 13,571 | .36 | .16 | |
| 75 | 557 | 2189 | 1215 | 486 | 2400 | 729 | 3013 | | | | | 75 | 11,549 | .31 | .13 | |
| 76 | 748 | 1991 | 675 | 270 | 2144 | 405 | 5066 | | | | | 76 | 13,022 | .35 | .23 | |
| 77 | | | | | 3078 | 2022 | 11547 | | | | | 77 | 22,054 | .59 | .51 | TEE |
| 78 | 642 | 414 | 1623 | 649 | 1002 | 974 | 2462 | | | | | 78 | 9,845 | .26 | .11 | |
| 79 | 1178 | 644 | 2940 | 1176 | 1785 | 1764 | 3855 | | | | | 79 | 12,811 | .34 | .17 | |
| 80 | 1429 | 1095 | 821 | 328 | 1830 | 493 | 6738 | | | | | 80 | 14,468 | .39 | .30 | |
| 81 | 1369 | 1209 | 558 | 223 | 1840 | 335 | 8379 | | | | | 81 | 15,961 | .43 | .38 | |
| 82 | 1073 | 1310 | 1632 | 653 | 1815 | 979 | 9812 | | | | | 82 | 18,013 | .48 | .44 | |
| 83 | 1190 | 1835 | 966 | 386 | 2221 | 580 | 11799 | | | | | 83 | 20,007 | .53 | .52 | |
| 84 | 1447 | 1564 | 683 | 273 | 2148 | 410 | 10279 | | | | | 84 | 18,244 | .49 | .46 | |
| 85 | 1517 | 3121 | 769 | 308 | 3625 | 461 | 5847 | | | | | 85 | 15,340 | .41 | .26 | |
| 86 | 1403 | 2602 | 1668 | 667 | 3030 | 1001 | 7182 | | | | | 86 | 16,620 | .44 | .32 | |
| 87 | 1473 | 3663 | 2010 | 804 | 4029 | 1206 | 7336 | | | | | 87 | 17,978 | .48 | .33 | |
| 88 | 1451 | 2805 | 945 | 378 | 3181 | 567 | 5990 | | | | | 88 | 13,145 | .35 | .18 | |
| 89 | | | | | 2970 | 590 | 5179 | | | | | 89 | 14,146 | .38 | .23 | TEE |
| 90 | | | | | 2115 | 1264 | 7963 | | | | | 90 | 16,749 | .47 | .35 | TEE |
| 91 | 1735 | 2656 | 904 | 362 | 3193 | 542 | 9229 | | | | | 91 | 18,371 | .49 | .41 | |
| 92 | 860 | 1329 | 1375 | 550 | 1676 | 825 | 4894 | | | | | 92 | 12,802 | .34 | .22 | |
| 93 | 1489 | 1772 | 1032 | 413 | 2351 | 619 | 7305 | | | | | 93 | 15,682 | .42 | .32 | |
| 94 | 1642 | 2348 | 720 | 288 | 2998 | 432 | 9193 | | | | | 94 | 18,030 | .48 | .41 | |
| 95 | 743 | 2033 | 680 | 272 | 2182 | 408 | 4828 | | | | | 95 | 12,825 | .34 | .21 | |
| 96 | 1176 | 3419 | 837 | 335 | 3631 | 502 | 8439 | | | | | 96 | 17,979 | .48 | .38 | |
| 97 | 1102 | 2062 | 646 | 258 | 2352 | 388 | 8385 | | | | | 97 | 16,532 | .44 | .37 | |
| 98 | 1096 | 2071 | 636 | 254 | 2357 | 382 | 8133 | | | | | 98 | 16,279 | .43 | .36 | |
| 99 | 1158 | 2178 | 279 | 112 | 2469 | 167 | 8461 | | | | | 99 | 16,504 | .44 | .39 | |
| 100 | 1425 | 2078 | 748 | 299 | 2537 | 449 | 9267 | | | | | 100 | 17,660 | .47 | .41 | |
| 101 | 347 | 882 | 476 | 190 | 967 | 286 | 7026 | | | | | 101 | 13,686 | .36 | .31 | |
| 102 | | | | | 2765 | 518 | 8152 | | | | | 102 | 16,842 | .45 | .36 | TEE |
| 103 | 589 | 2720 | 170 | 68 | 2784 | 102 | 5225 | | | | | 103 | 13,568 | .36 | .23 | |

Also Available On Aperture Card

APERTURE CARD



FEED WATER PIPING (TABLE 2) CONT.

| NODE | SEISMIC | | | | | WEIGHT | | THERMAL | | PRESSURE | | | NODE | TEE | |
|------|---------------|---------------|-----------------------------|-----------------------------|-----------------------|-----------------------|------------|---------|--------|----------|--------------------|-----|-------|-----|-----|
| | X | Z | Y INC. WEIGHT | -Y- | RESULTANT | W | T | P | D | D | $\frac{Pd^2}{L^3}$ | | | | |
| | σ_{sx} | σ_{sz} | $\sigma_{xy} + \sigma_{yx}$ | $\sigma_{yz} + \sigma_{zy}$ | $\sigma_{\sqrt{203}}$ | $\sigma_{w \cdot 60}$ | σ_T | P | D | D | $\frac{Pd^2}{L^3}$ | | | | |
| 104 | 245 | 479 | 437 | 175 | 562 | 262 | 4028 | 1385 | 11.376 | 12.75 | 5407 | 104 | 10259 | .27 | .18 |
| 105 | 221 | 1147 | 136 | 54 | 1177 | 82 | 1108 | | | | | 105 | 7774 | .21 | .05 |
| 106 | 318 | 790 | 366 | 146 | 864 | 220 | 6022 | | | | | 106 | 12513 | .33 | .27 |
| 107 | 623 | 212 | 924 | 370 | 755 | 554 | 5210 | | | | | 107 | 11926 | .32 | .23 |
| 108 | 1543 | 1410 | 504 | 202 | 2100 | 302 | 11412 | | | | | 108 | 19221 | .51 | .51 |
| 109 | 1766 | 598 | 331 | 132 | 1869 | 199 | 10627 | | | | | 109 | 18102 | .48 | .47 |
| 110 | | | | | 1300 | 154 | 12310 | | | | | 110 | 19171 | .51 | .55 |
| 111 | | | | | 1748 | 426 | 6376 | | | | | 111 | 13957 | .37 | .28 |
| 112 | 1543 | 1912 | 1698 | 679 | 2549 | 1019 | 2932 | | 11.376 | 12.75 | 5407 | 112 | 11907 | .32 | .13 |
| 113 | 1200 | 1556 | 544 | 218 | 1977 | 326 | 5738 | | | | | 113 | 13448 | .36 | .26 |
| 114 | 1203 | 1572 | 537 | 215 | 1991 | 322 | 5739 | | | | | 114 | 13459 | .36 | .26 |
| 115 | 1525 | 1555 | 1374 | 550 | 2660 | 824 | 4891 | | | | | 115 | 13782 | .37 | .22 |
| 116 | | | | | 2334 | 283 | 5866 | | | | | 116 | 13890 | .37 | .26 |
| 117 | 2178 | 3253 | 2986 | 1194 | 4093 | 1792 | 1989 | | 9.564 | 10.75 | 5258 | 117 | 13132 | .35 | .09 |
| 118 | 2635 | 2757 | 2520 | 1003 | 3945 | 1512 | 1594 | | | | | 118 | 12309 | .33 | .07 |
| 119 | 3574 | 2307 | 1866 | 746 | 4319 | 1120 | 1203 | | 11.376 | 12.75 | 5407 | 119 | 12049 | .32 | .05 |
| 120 | 1913 | 826 | 340 | 136 | 2088 | 204 | 1748 | | | | | 120 | 9447 | .25 | .08 |
| 121 | | | | | 4846 | 1323 | 4392 | | | | | 121 | 15968 | .43 | .20 |
| 122 | 2997 | 1775 | 2997 | 1199 | 3684 | 1798 | 5230 | | | | | 122 | 16119 | .43 | .23 |
| 123 | | | | | 2198 | 1154 | 2361 | | 16.126 | 18.0 | 5632 | 123 | 11345 | .30 | .11 |
| 124 | 2792 | 1212 | 431 | 172 | 3049 | 259 | 2893 | | | | | 124 | 11833 | .32 | .13 |
| 125 | 2877 | 1025 | 1054 | 422 | 3083 | 632 | 2053 | | | | | 125 | 11400 | .30 | .09 |
| 126 | 1537 | 829 | 2614 | 1046 | 2311 | 1538 | 1151 | | | | | 126 | 10662 | .28 | .05 |
| 127 | 3644 | 1758 | 2616 | 1046 | 4179 | 1570 | 1728 | | | | | 127 | 7477 | .20 | .08 |
| 128 | 2163 | 3079 | 406 | 162 | 3766 | 244 | 1865 | | 16.126 | 18.0 | 5632 | 128 | 11507 | .31 | .08 |
| 129 | 2044 | 3104 | 805 | 322 | 3730 | 483 | 1793 | | | | | 129 | 11638 | .31 | .08 |
| 130 | 3220 | 4805 | 1559 | 744 | 5832 | 1115 | 2136 | | | | | 130 | 14714 | .39 | .09 |
| 131 | 3794 | 3745 | 1201 | 480 | 5355 | 721 | 1828 | | | | | 131 | 13536 | .36 | .08 |
| 132 | | | | | 2385 | 800 | 1411 | | | | | 132 | 10228 | .27 | .06 |
| 133 | 1308 | 265 | 1561 | 624 | 1473 | 937 | 3862 | | 7.75 | 10.75 | 6423 | 133 | 12695 | .34 | .17 |
| 134 | 912 | 900 | 1404 | 562 | 1399 | 842 | 3043 | | 9.564 | 10.75 | 5258 | 134 | 10542 | .29 | .14 |
| 135 | 1250 | 1187 | 479 | 192 | 1734 | 287 | 4780 | | 7.625 | 8.625 | 4955 | 135 | 11756 | .31 | .21 |
| 136 | 3021 | 3192 | 590 | 236 | 4401 | 354 | 2192 | | 7.64 | 10.75 | 5258 | 136 | 12205 | .33 | .10 |
| 137 | 2218 | 1055 | 1506 | 302 | 2529 | 904 | 2260 | | | | | 137 | 10951 | .29 | .10 |
| 138 | 2185 | 2244 | 853 | 341 | 3911 | 512 | 3257 | | | | | 138 | 12938 | .35 | .14 |

Also Available On Aperture Card

TI APERTURE CARD

8504040294-104

BEANTE

"FEED WATER PIPING" (TABLE 2) CONT.

JL 19 73 A.GATHAR

| NODE | SEISMIC | | | | | WEIGHT | THERMAL | PRESSURE | | | | NODE | $\frac{\sigma_x + \sigma_y + \sigma_z}{3}$ | $\frac{\sigma_1 + \sigma_2 + \sigma_3}{3}$ | $\frac{\sigma_1 - \sigma_2}{2}$ | TEE |
|------|---------|------|---------------|-----|-----------|--------|---------|----------|-------|-------|------------------|------|--|--|---------------------------------|-----|
| | X | Z | Y INC. WEIGHT | Y | RESULTANT | | | P | d | O | $\frac{Pd}{D^2}$ | | | | | |
| 139 | | | | | 3737 | 1960 | 3141 | 1385 | 9.564 | 10.75 | 5258 | 139 | 14096 | .38 | .14 | TEE |
| 140 | | | | | 3033 | 584 | 912 | | 16.26 | 18.0 | 5632 | 140 | 10161 | .27 | .04 | TEE |
| 141 | 1510 | 1142 | 1655 | 662 | 2006 | 993 | 716 | | | | | 141 | 9347 | .25 | .03 | |
| 142 | | | | | 1029 | 445 | 1205 | | | | | 142 | 8311 | .22 | .05 | TEE |
| 143 | 1075 | 256 | 1538 | 615 | 1265 | 923 | 4073 | | 9.75 | 10.75 | 6423 | 143 | 12684 | .34 | .18 | |
| 144 | 665 | 258 | 1469 | 588 | 924 | 881 | 3538 | | 9.564 | 10.75 | 5258 | 144 | 10601 | .28 | .16 | |
| 145 | 385 | 444 | 543 | 217 | 626 | 326 | 4052 | | 7.625 | 8.625 | 4985 | 145 | 9989 | .27 | .18 | |
| 146 | 445 | 415 | 493 | 197 | 640 | 296 | 872 | | 9.564 | 10.75 | 5258 | 146 | 7066 | .19 | .04 | |
| 147 | 1005 | 243 | 1627 | 651 | 1222 | 976 | 1308 | | | | | 147 | 8764 | .23 | .06 | |
| 148 | 714 | 546 | 1080 | 432 | 1149 | 648 | 1639 | | | | | 148 | 8694 | .23 | .07 | |
| 149 | | | | | 3287 | 1615 | 3230 | | | | | 149 | 13390 | .36 | .14 | TEE |
| 150 | 1299 | 379 | 1540 | 616 | 1487 | 924 | 4180 | | 9.75 | 10.75 | 6423 | 150 | 13014 | .35 | .19 | |
| 151 | 928 | 582 | 1519 | 608 | 1177 | 911 | 3791 | | 9.564 | 10.75 | 5258 | 151 | 11137 | .30 | .17 | |
| 152 | 1267 | 1011 | 674 | 270 | 1643 | 404 | 3649 | | 7.625 | 8.625 | 4985 | 152 | 10681 | .28 | .16 | |
| 153 | 3068 | 2772 | 622 | 249 | 4142 | 373 | 1217 | | 9.564 | 10.75 | 5258 | 153 | 10990 | .29 | .05 | |
| 154 | 2158 | 1334 | 2206 | 882 | 2686 | 1324 | 969 | | | | | 154 | 10237 | .27 | .04 | |
| 155 | 3153 | 2583 | 1641 | 656 | 4128 | 984 | 1374 | | | | | 155 | 11744 | .31 | .06 | |
| 156 | 1431 | 987 | 225 | 90 | 1741 | 135 | 2318 | | | | | 156 | 9452 | .25 | .10 | |
| 157 | 2981 | 2920 | 1633 | 653 | 4224 | 980 | 2544 | | | | | 157 | 13006 | .35 | .11 | |
| 158 | 3526 | 2208 | 1711 | 684 | 4216 | 1527 | 1525 | | | | | 158 | 12026 | .32 | .07 | |

50-206
98/1/4
46204040298

Also Available On Aperture Card

TI APERTURE CARD