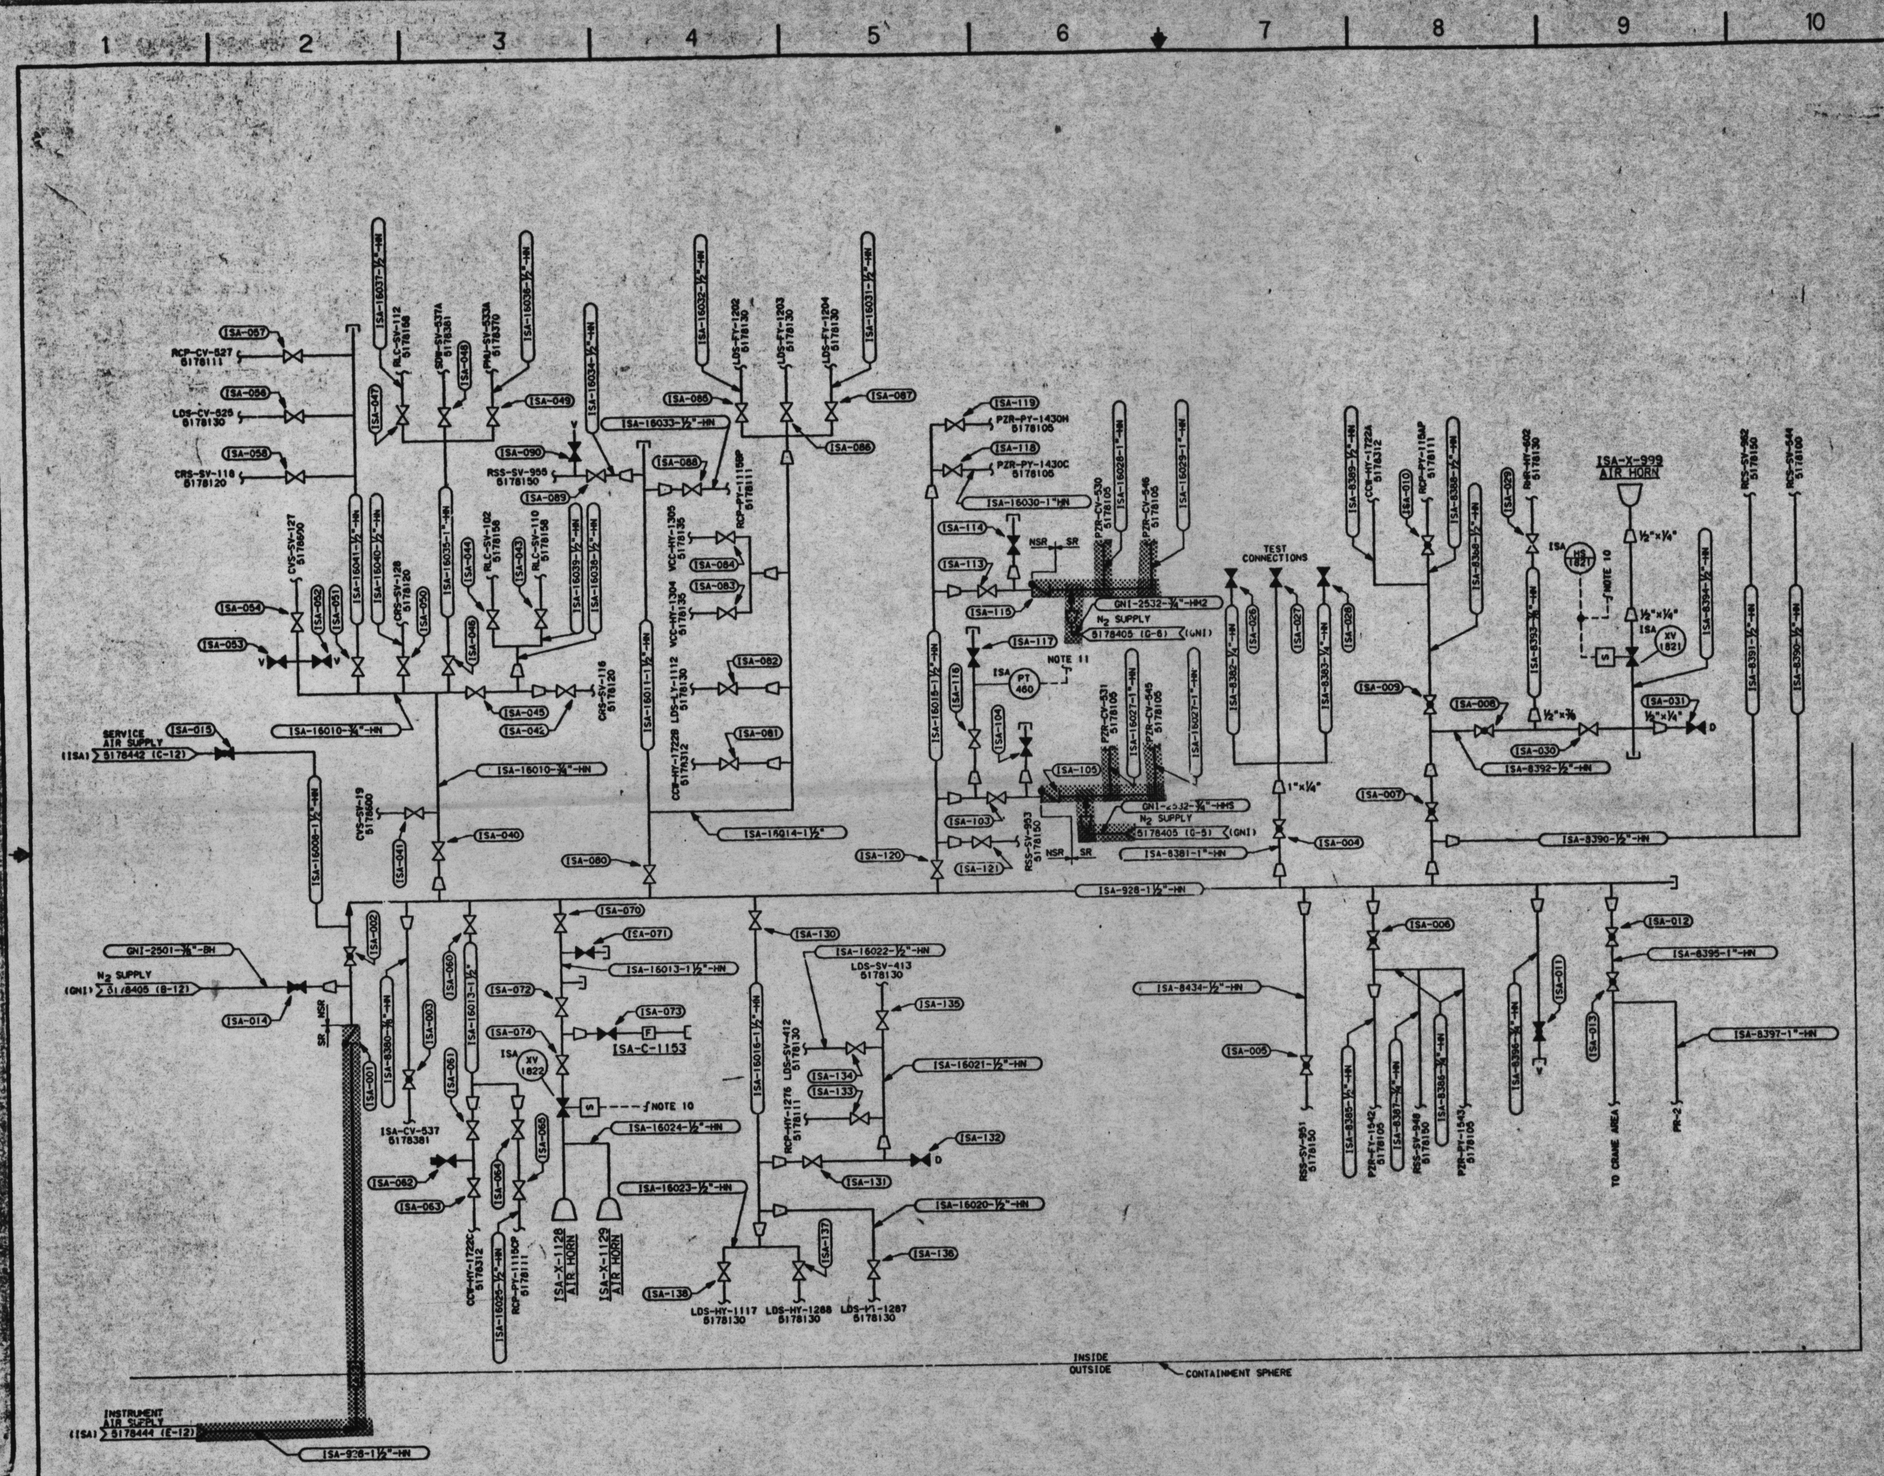

NOTES:

1. SEE DWG 5178440 FOR SH 1
2. SEE DWG 5178441 FOR SH 2
3. SEE DWG 5178442 FOR SH 3
4. SEE DWG 5178443 FOR SH 4
5. SEE DWG 5178444 FOR SH 5
6. SEE DWG 5178445 FOR SH 6
7. SEE DWG 5178446 FOR SH 7
8. SEE DWG 5178447 FOR SH 8
9. SEE DWG 5178448 FOR SH 9
10. SEE DWG 455377 FOR CONTROL DETAILS
11. SEE DWG 5154618 FOR CONTROL DETAILS
12. THIS DRAWING SUPERSEDES DRAWING 568780 AND ALL CON'S WHICH PERTAIN TO IT.

CHECK GLH 8-21-85
BCM 5-12-86

DWG. LIST M-
* REVISE ON CADD SYSTEM ONLY *

(SRAN) WP 82-297

REFERENCE DRAWINGS		REFERENCE DRAWINGS
5178000	P & I DIAGRAM LEGEND SH 1	
5178001	P & I DIAGRAM LEGEND SH 2	
5178002	P & I DIAGRAM LEGEND SH 3	

NO.	REVISIONS	M	DATE	P.E.	QAE	SUPV	APPROVED	ENGR	CK'D	MADE	J.O.
3	AS BUILT-INCORP DCN #6									DVT	8661
2	AS BUILT-INCORP DCN #5, DCN#4 CANCELLED									DVT	8744
1	AS BUILT-INCORP DCN #2 & #3-CC #1 CANCELLED									DVT	8252
0	ISSUED AS BUILT									DVT	8083

NO.	REVISIONS	M	DATE	P.E.	QAE	SUPV	APPROVED	ENGR	CK'D	MADE	J.O.
	SEE CDM FILES FOR SIGNATURES										
	SEE CDM FILES FOR SIGNATURES										
	SEE CDM FILES FOR SIGNATURES										

LOCATION: SAN ONOFRE NUCLEAR GEN. STA. UNIT 1

P & I DIAGRAM
INSTRUMENT & SERVICE AIR SYSTEM SHEET 10

SCE EDISON Rosemead California

ISA

SHEET NO. M

SCALE: NONE

OF SHTS.

568780

03-10-86

5178449-3

TI APERTURE CARD

MICROFILMED FROM BEST AVAILABLE COPY

26X