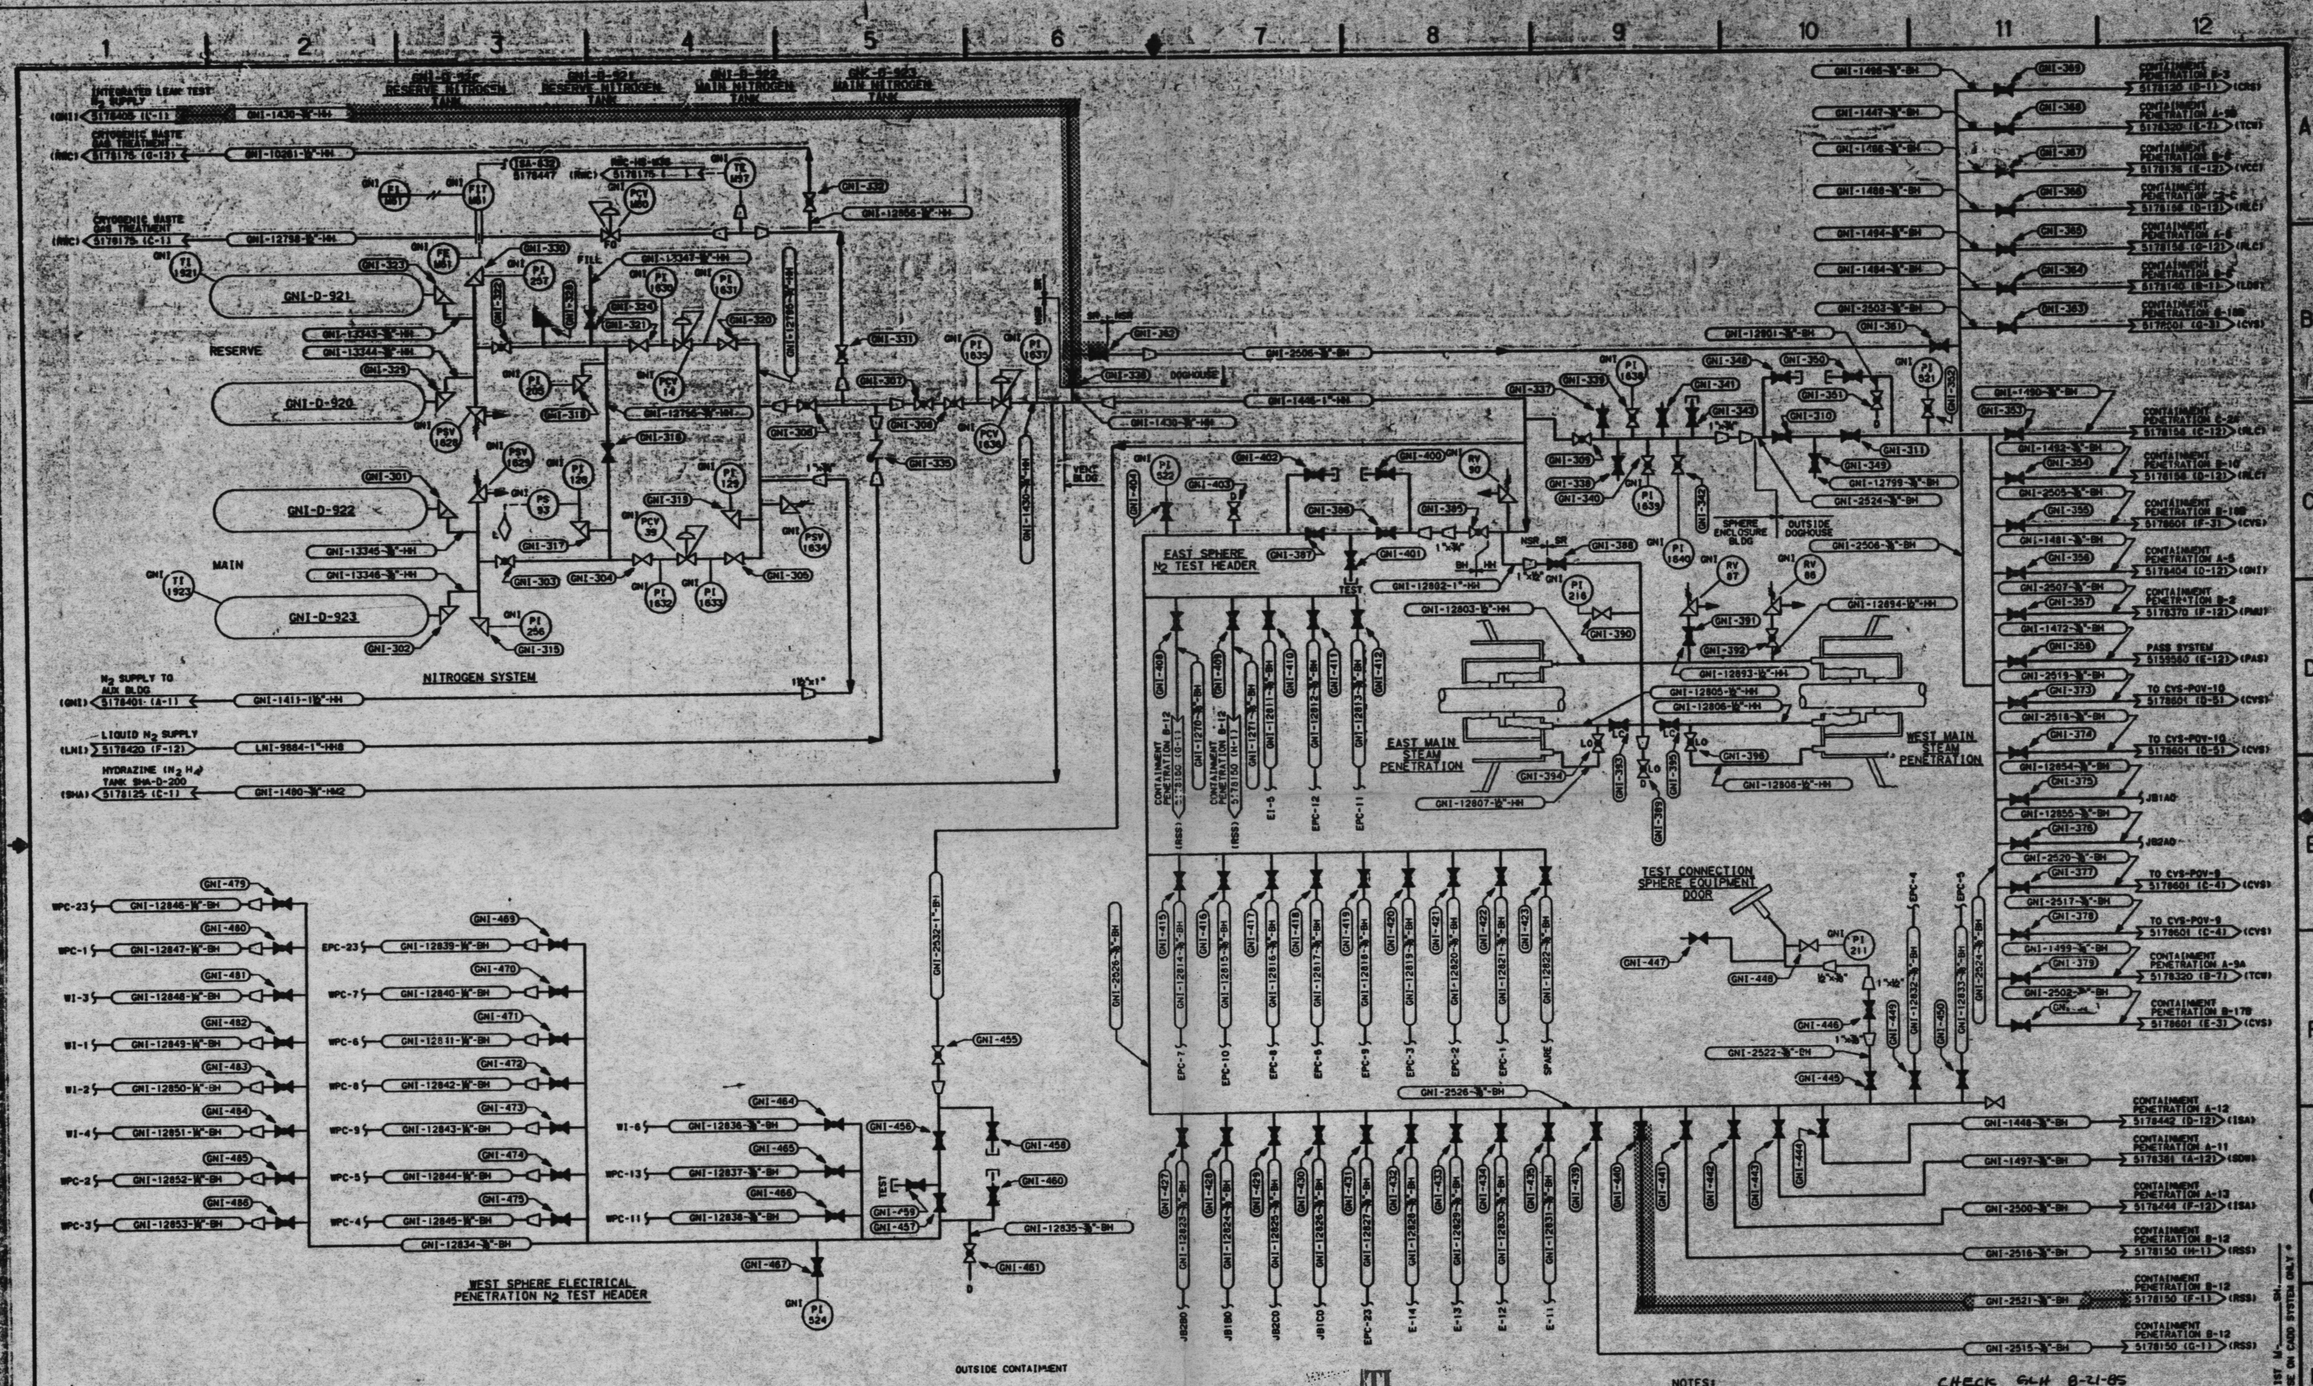

NOTES:

1. SEE DWG 5178401 FOR SH 2
2. SEE DWG 5178402 FOR SH 3
3. SEE DWG 5178403 FOR SH 4
4. SEE DWG 5178404 FOR SH 5
5. SEE DWG 5178405 FOR SH 6
6. THIS DRAWING SUPERSEDES DRAWING 568784 AND ALL CCN'S WHICH PERTAIN TO IT.

CHECK GLH 8-21-85
BCM 5-12-86

SAFETY RELATED AS NOTED (SRAN)

WP 82-297

DWG. LIST M-___ SH. ___
* REVISE ON CADD SYSTEM ONLY *

GNI

5178000	P & I DIAGRAM LEGEND SH 1
5178001	P & I DIAGRAM LEGEND SH 2
5178002	P & I DIAGRAM LEGEND SH 3

REFERENCE DRAWINGS

NO.	REVISIONS	M	DATE	P.E.	GAE	SUPV	APPROVED	ENGR	CK'D	MADE	J.O.
2	AS BUILT-INCORP DCN #3							DH	NKY	BLS	8881
1	AS BUILT-INCORP DCN #2-CC #1 CANCELED			SEE	CDM	FILES	FOR SIGNATURES			DVY	8744
0	ISSUED AS BUILT			SEE	CDM	FILES	FOR SIGNATURES			DVY	8252

LOCATION: SAN ONOFRE NUCLEAR GEN. STA. UNIT 1

P & I DIAGRAM
GASEOUS NITROGEN
SYSTEM SHEET 1

SCE EDISON
Rosemead California

SHEET NO. M

SCALE: NONE

___ OF ___ SHTS.

12-27-84

568784

5178400-2

MICROFILM