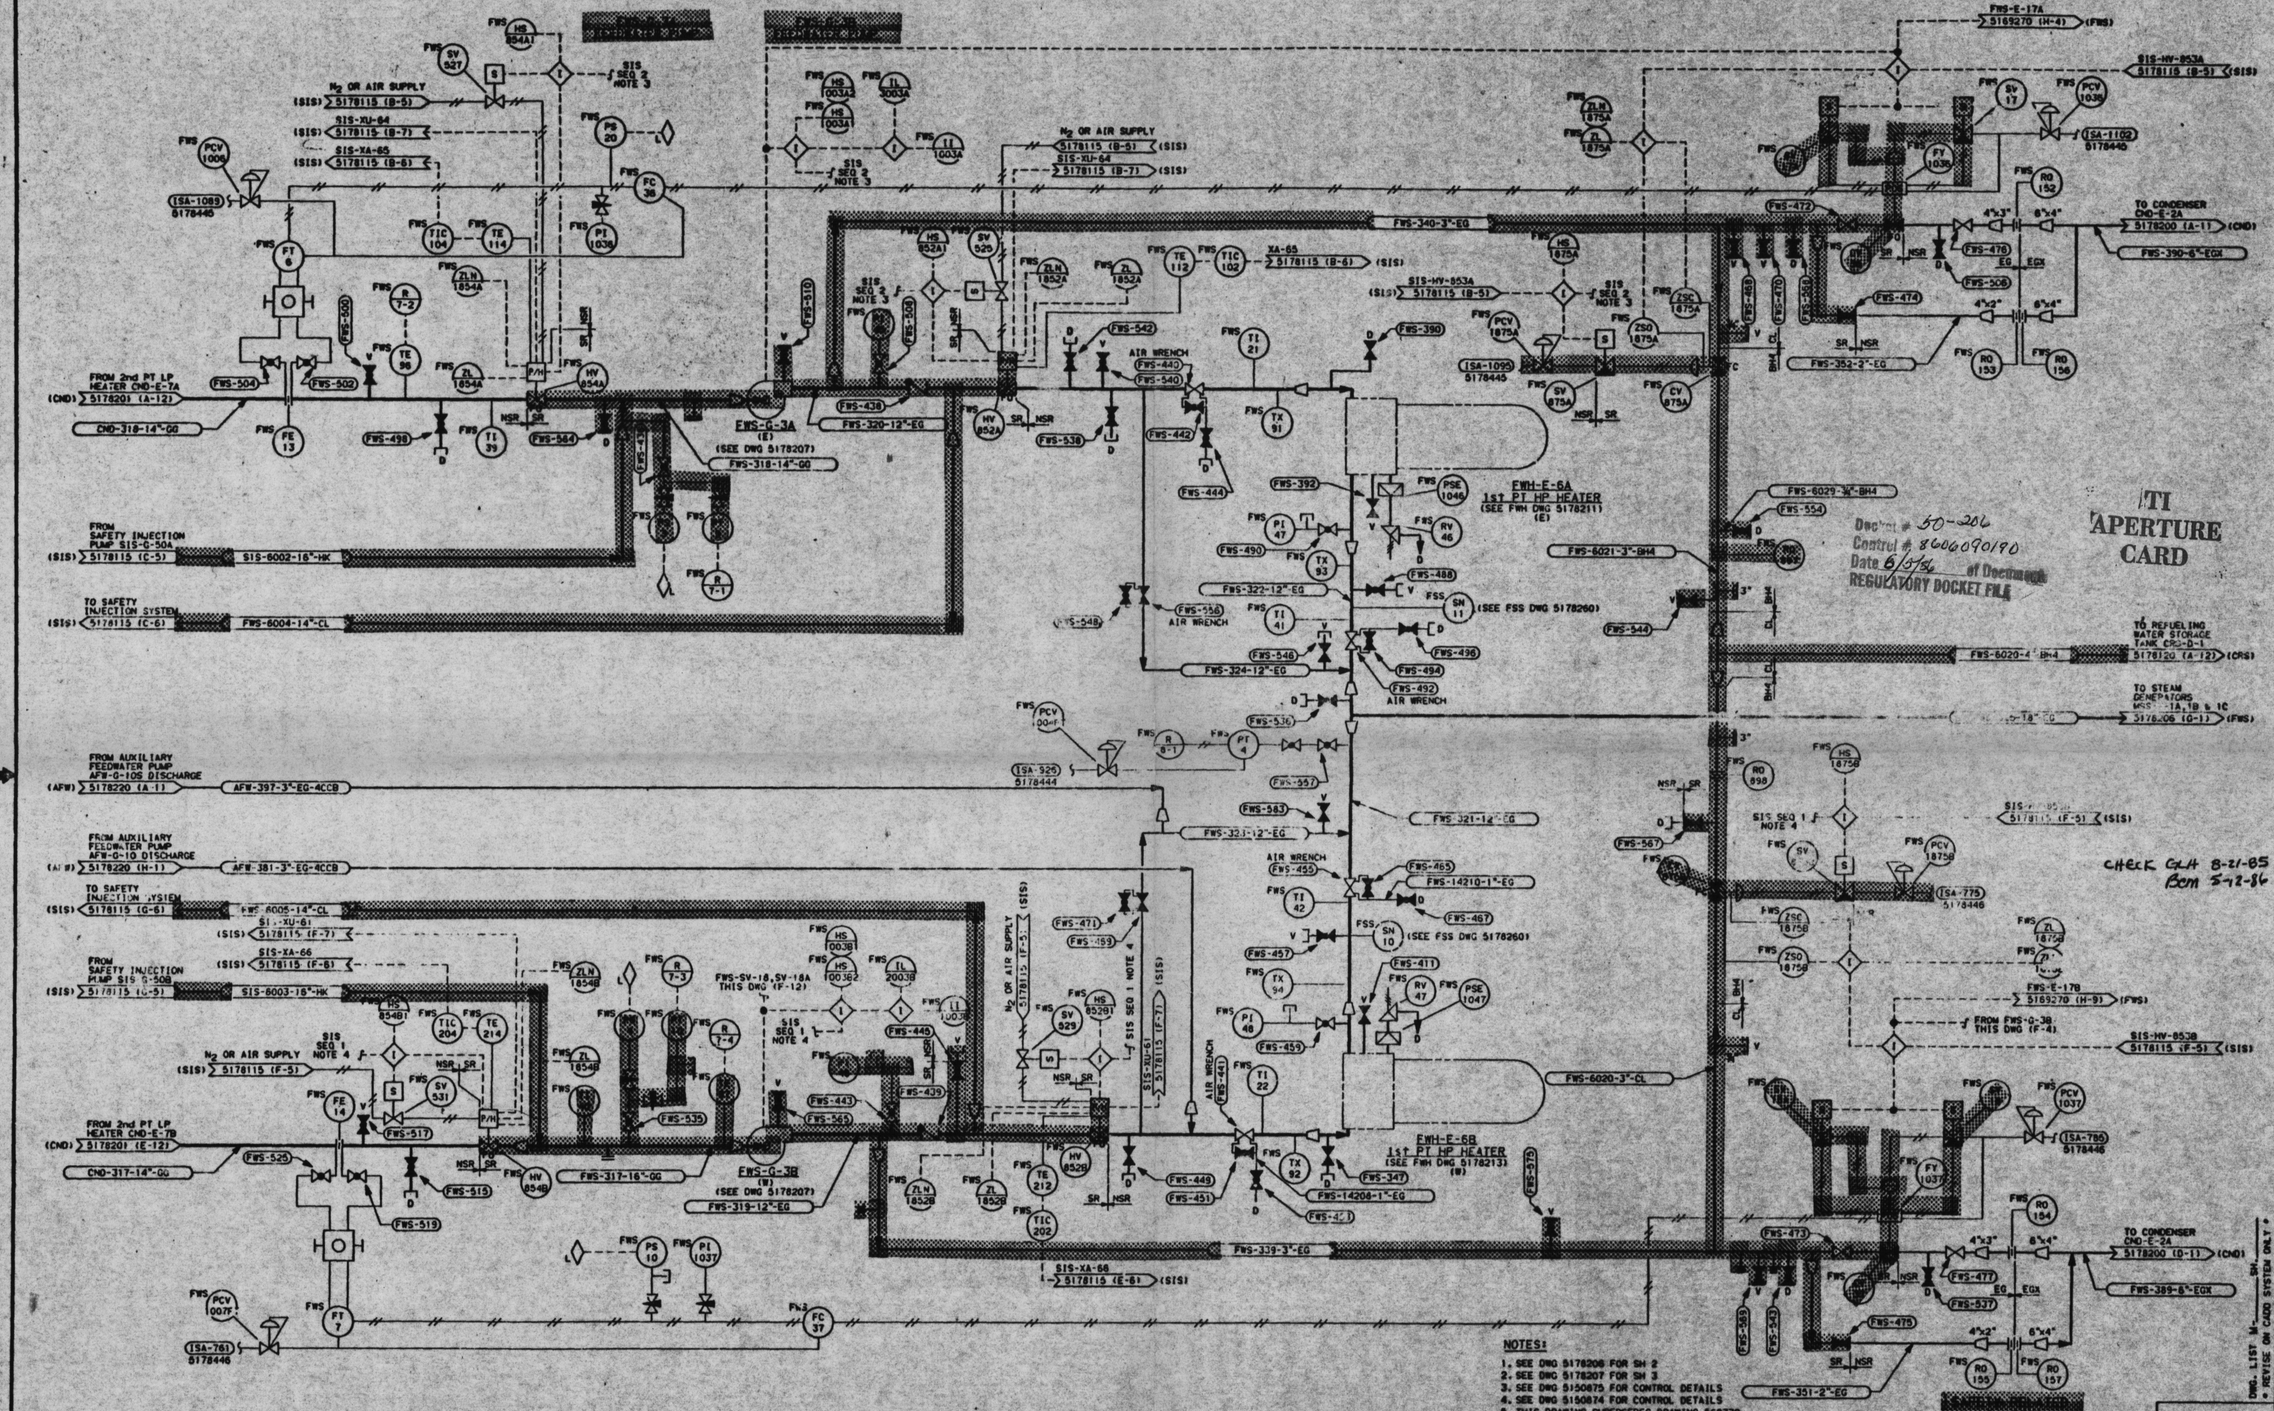

REFERENCE DRAWINGS		REFERENCE DRAWINGS
5178000	P & I DIAGRAM LEGEND SH 1	
5178001	P & I DIAGRAM LEGEND SH 2	
5178002	P & I DIAGRAM LEGEND SH 3	
5149858	ELEM DIAGRAM-PUMPS G-3A & G-3B	
455374	ELEM DIAGRAM-HV-854A & B	
455375	ELEM DIAGRAM-HV-852A & B	

NO.	REVISIONS	M	DATE	P.E.	DAE	SUPV	APPROVED	ENGR	CK'D	MADE	J.O.
1	AS BUILT-INCORP DCR #2,#3,#4-GC#1 CANCELED									BLS	8744
0	ISSUED AS BUILT						SEE CCM FILES FOR SIGNATURES			DVY	5292

LOCATION: SAN ONOFRE NUCLEAR GEN. STA. UNIT 1

P & I DIAGRAM
FEEDWATER SYSTEM
SHEET 1

SCE EDISON
Rosemead California

FWS

SHEET NO. M

SCALE: NONE

OF SHTS.

5178205-1

Document # 50-206
Control # 8606090180
Date 6/5/86 of Document
REGULATORY DOCKET FILE

TI APERTURE CARD

MICROFILMED FROM BEST AVAILABLE COPY