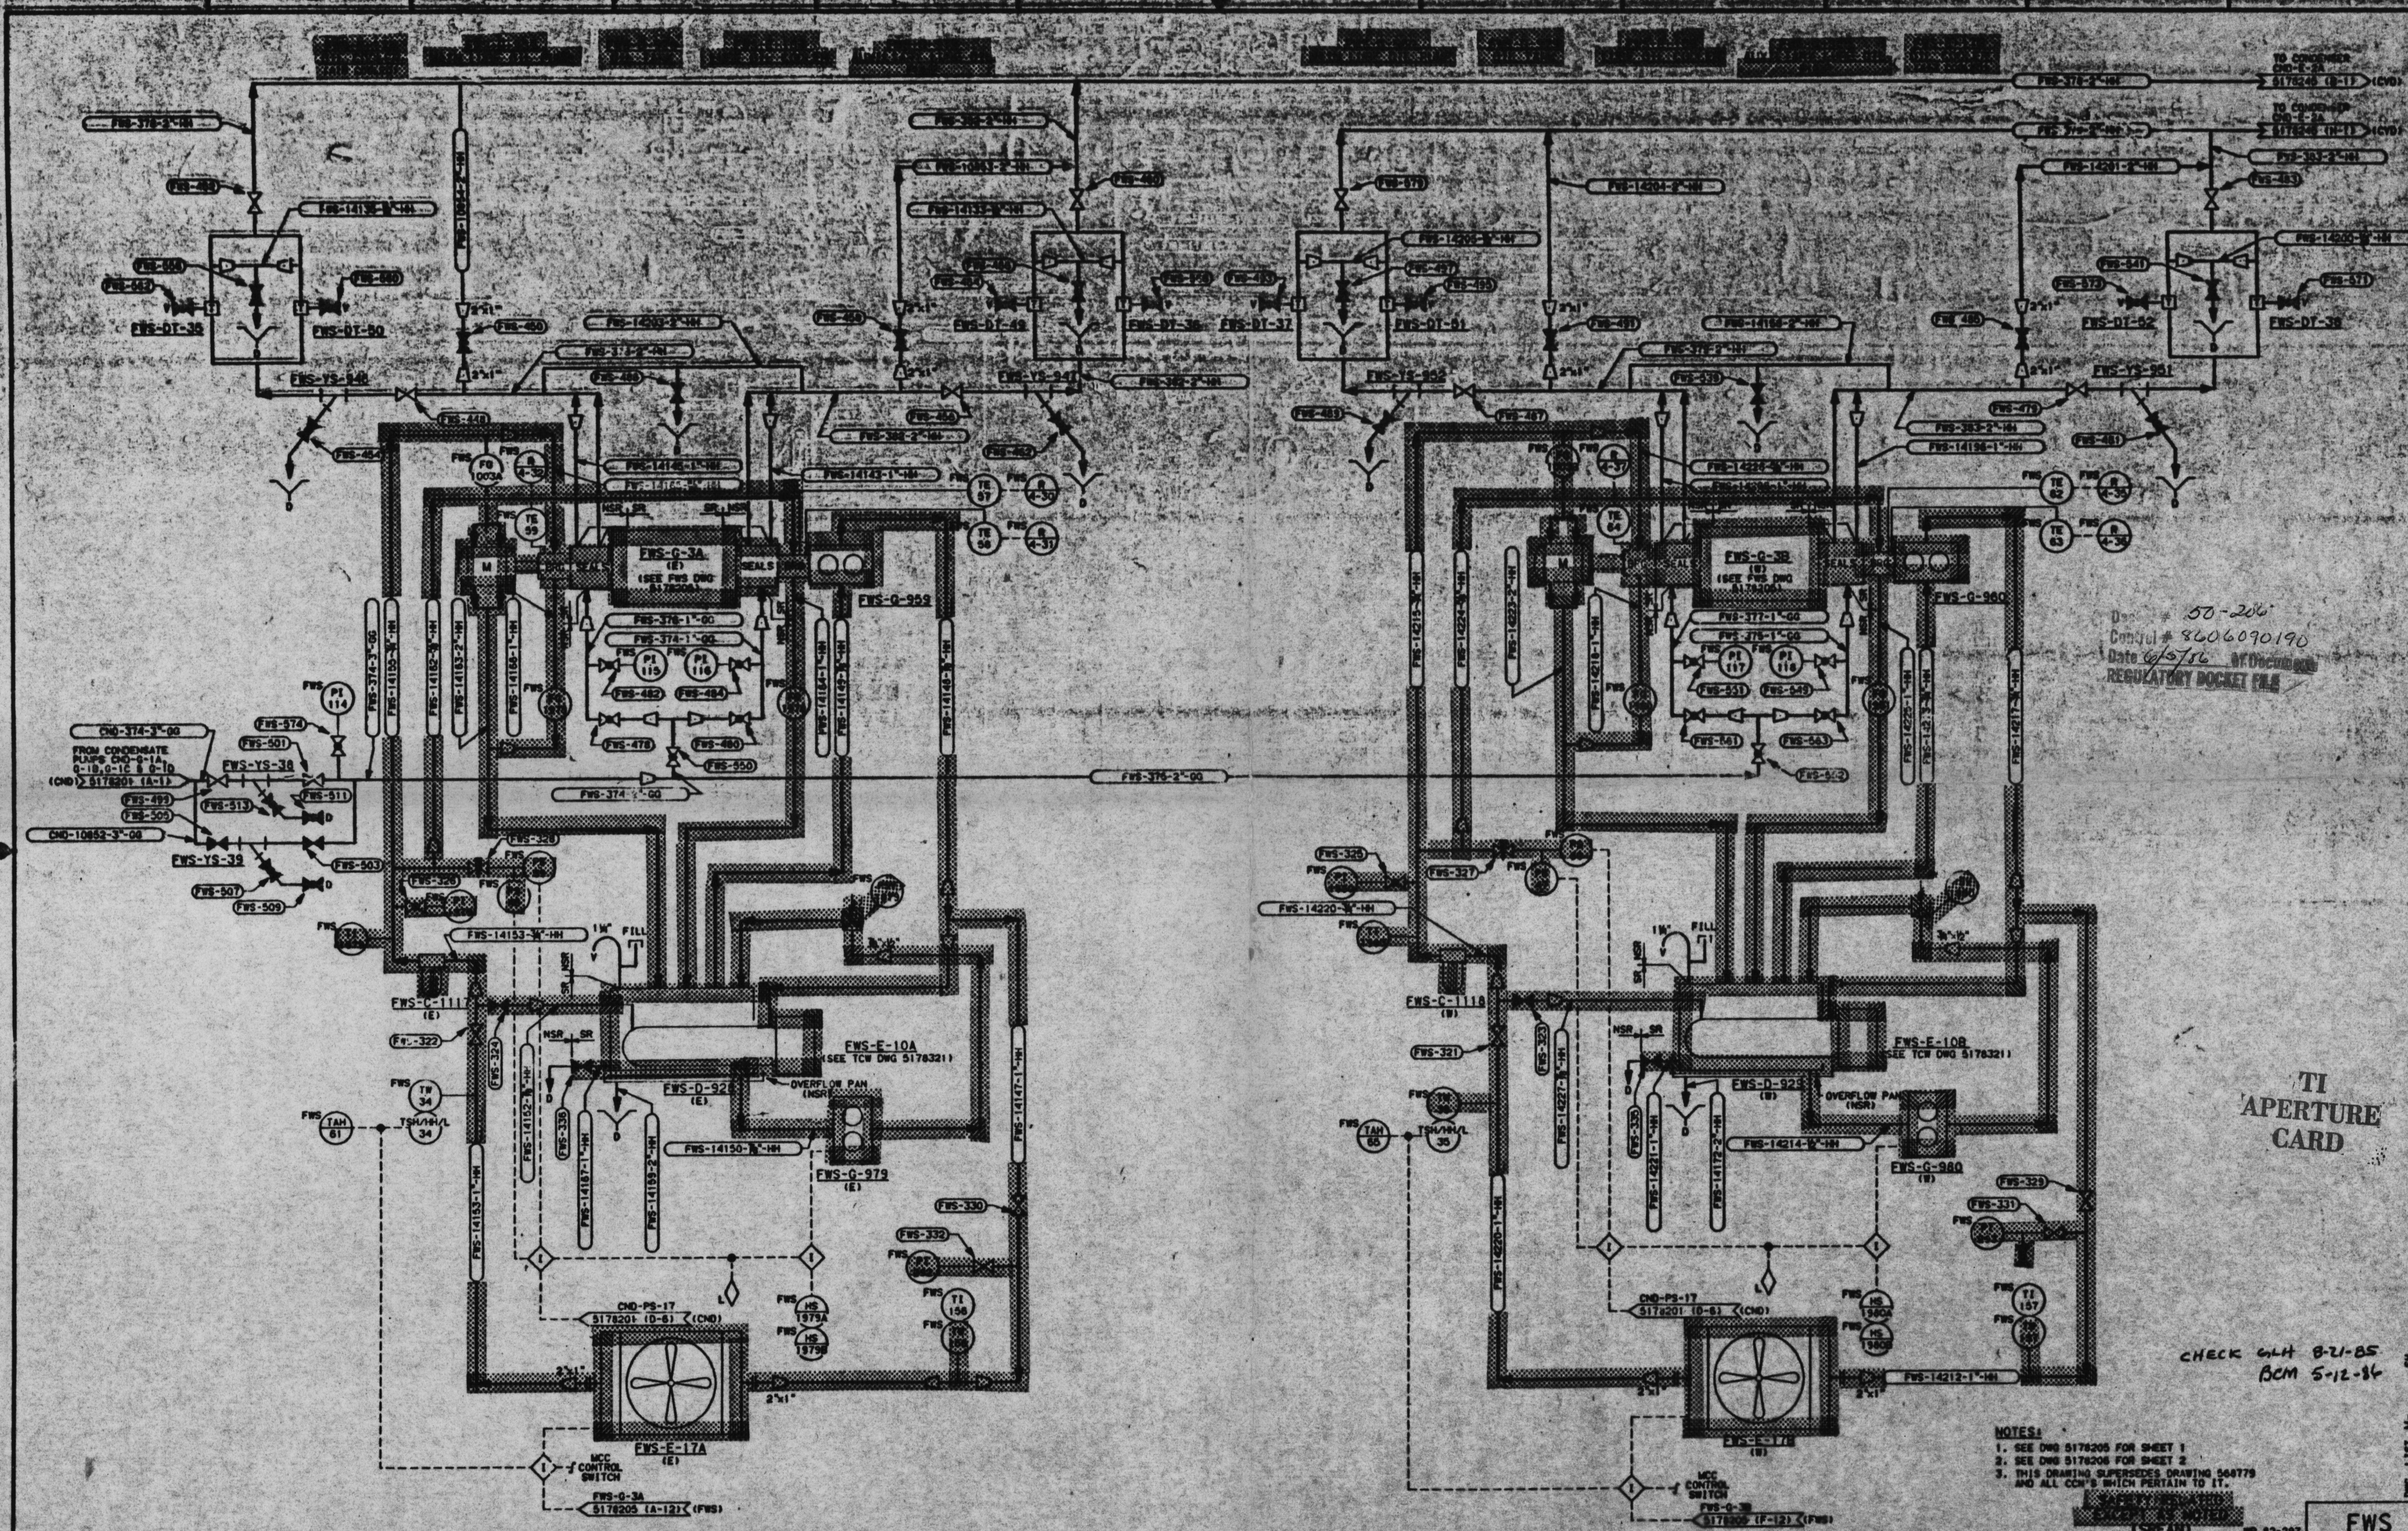

NOTES:
1. SEE DWG 5178205 FOR SHEET 1
2. SEE DWG 5178206 FOR SHEET 2
3. THIS DRAWING SUPERSEDES DRAWING 568779 AND ALL CCN'S WHICH PERTAIN TO IT.

SAFETY RELATED EXCEPT AS NOTED (SREAN)

WP 82-297

CHECK GLH 8-21-85
BCM 5-12-86

TI APERTURE CARD

Docket # 50-206
Control # 8606090190
Date 6/5/86 of Document
REGULATORY DOCKET FILE

5178000	P & I DIAGRAM LEGEND SH 1
5178001	P & I DIAGRAM LEGEND SH 2
5178002	P & I DIAGRAM LEGEND SH 3
455517	ELEM DIAGRAM - LO PUMPS G-979 & G-980
REFERENCE DRAWINGS	

NO.	REVISIONS	M	DATE	P.E.	GAE	SUPV	APPROVED	ENGR	CH'D	MADE	J.O.
2	AS BUILT-INCORP DCN #4							DH	MKY	DVY	8881
1	AS BUILT-INCORP DCN #1, #2 & #3			SEE	CDM	FILES	FOR SIGNATURES			BLS	6744
0	ISSUED AS BUILT			SEE	CDM	FILES	FOR SIGNATURES			BLS	8252

LOCATION: SAN ONOFRE NUCLEAR GEN. STA. UNIT 1

P & I DIAGRAM
FEEDWATER SYSTEM
SHEET 3

SCE EDISON
Rosemead California

FWS

SHEET NO.
M

SCALE: NONE
____OF____SHTS.

DWG. LIST M-____SH.____
• REVISE ON CADD SYSTEM ONLY •

12-28-84

568779

5178207-2

JM E4-003-CADD 10-83