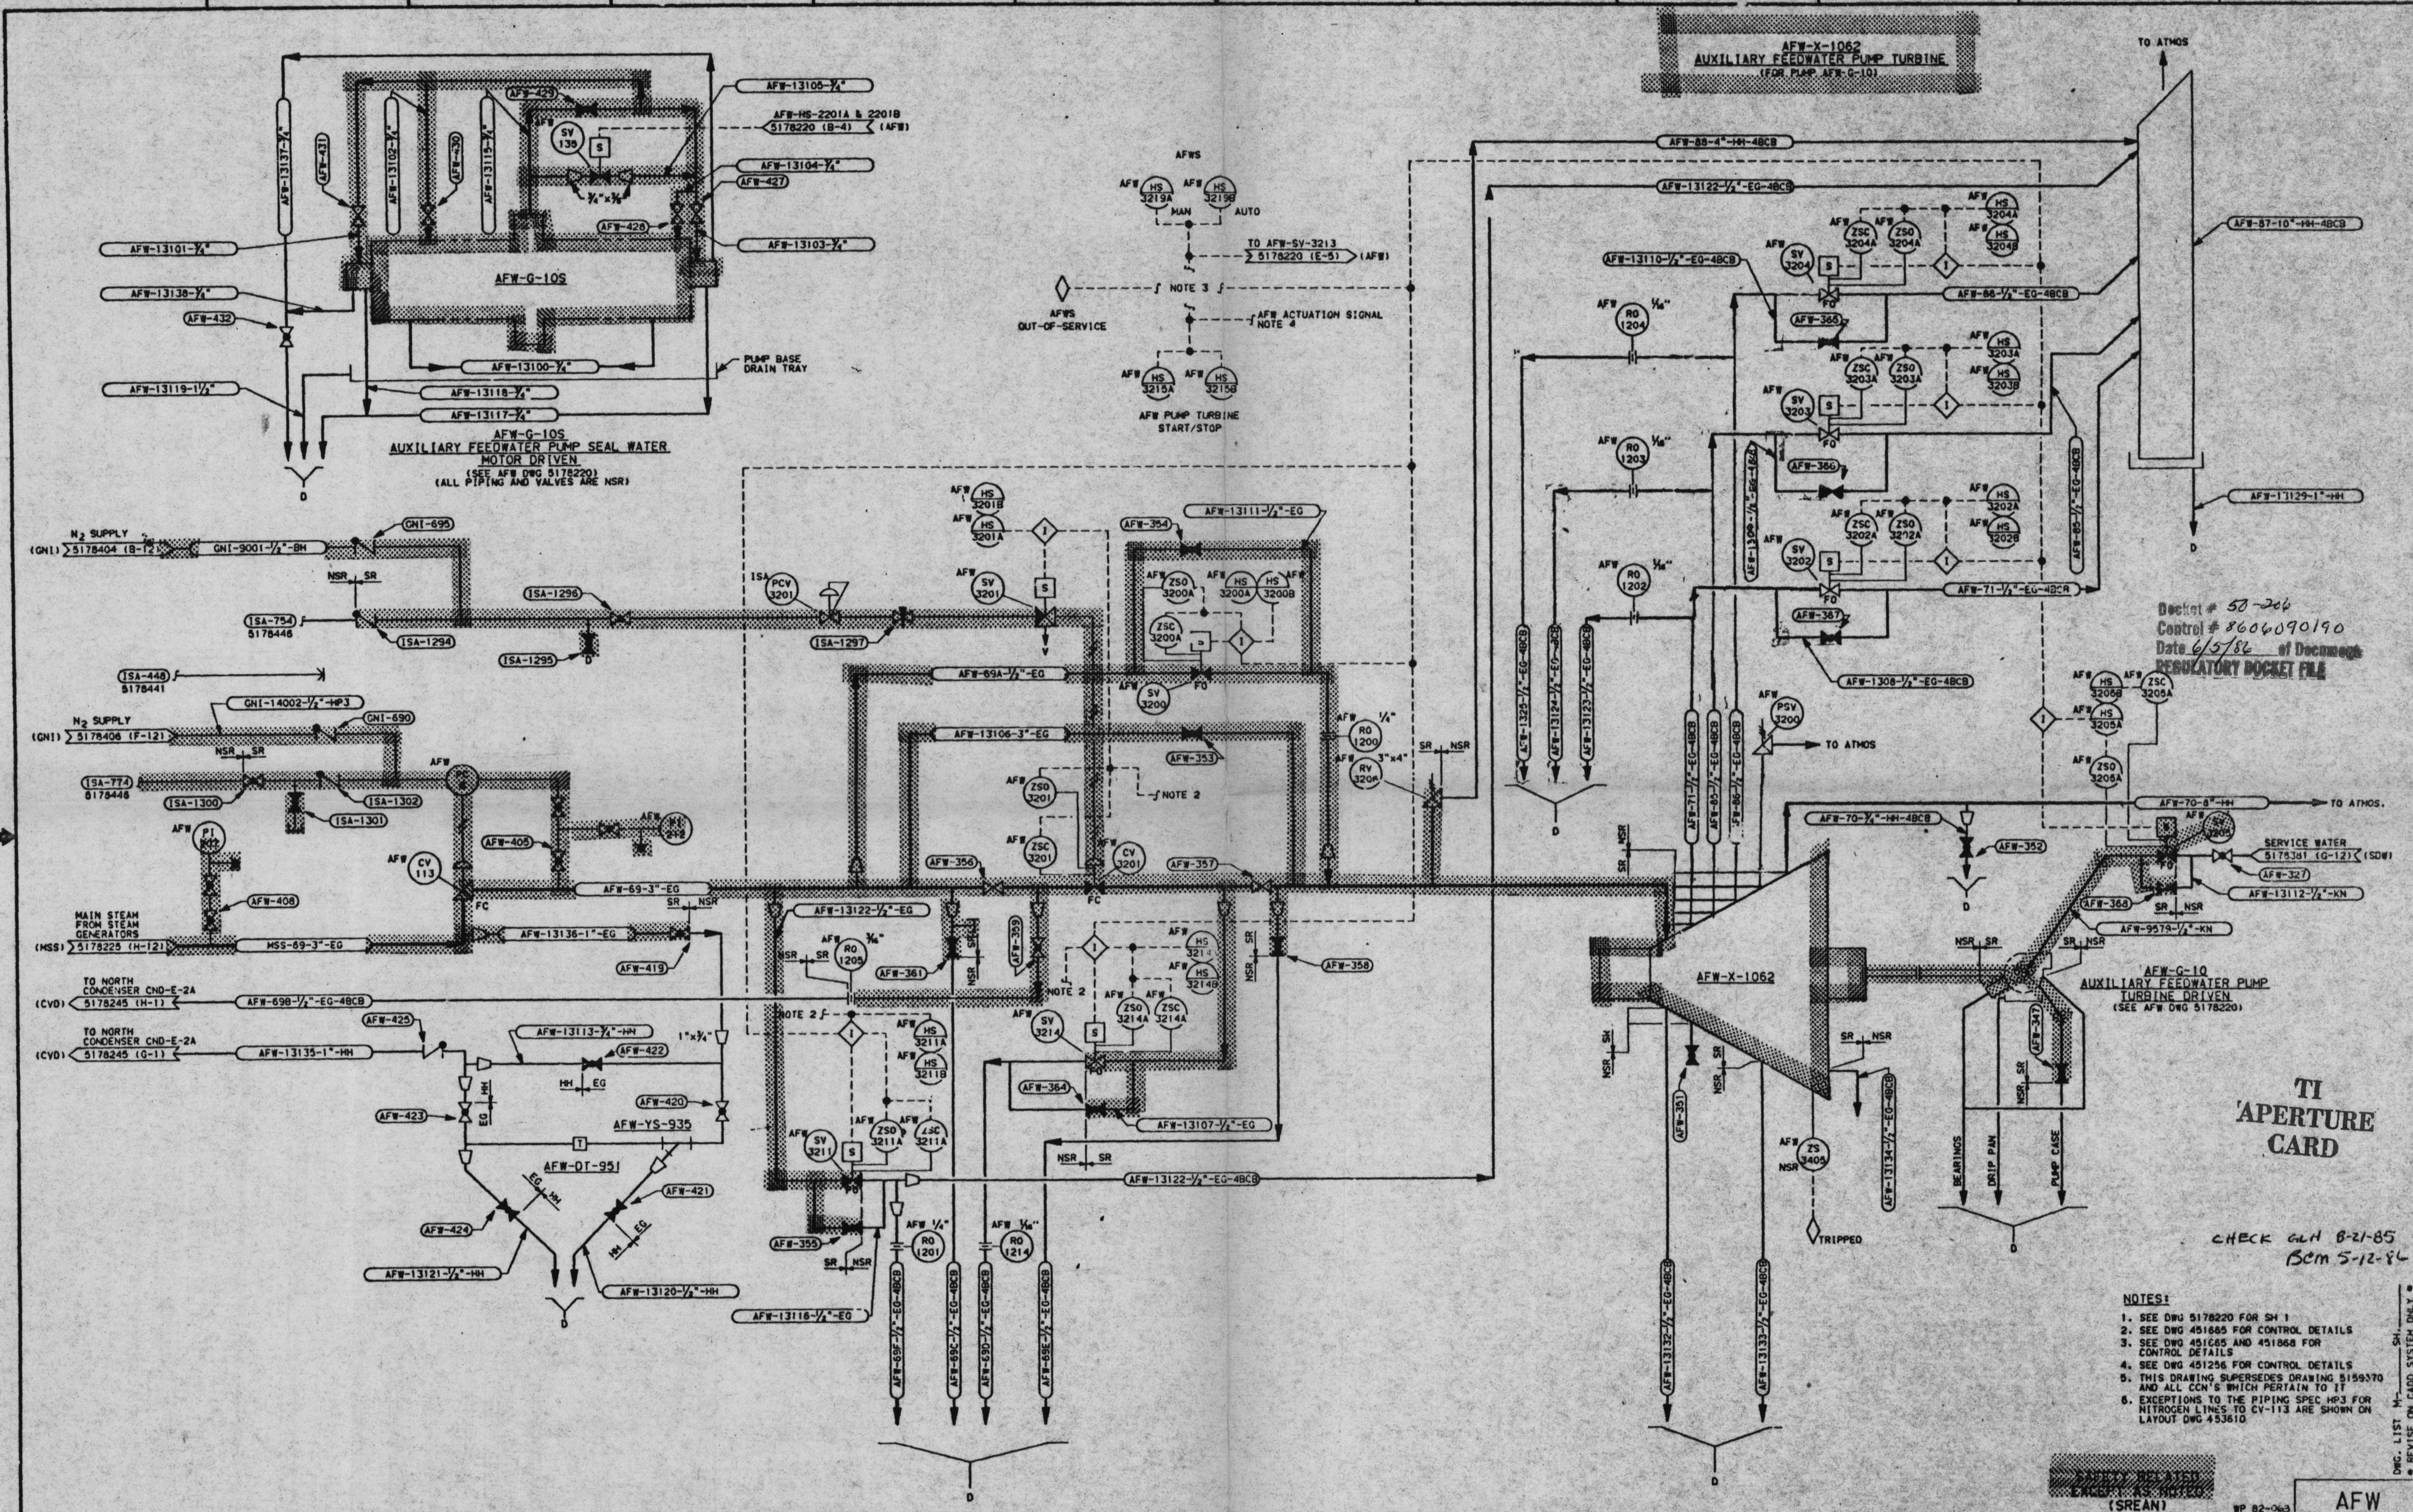

Docket # 50-206
Control # 8606090190
Date 6/5/86 of Document
REGULATORY DOCKET FILE

TI APERTURE CARD

CHECK GLH 8-21-85
BCM 5-12-86

NOTES:

1. SEE DWG 5178220 FOR SH 1
2. SEE DWG 451665 FOR CONTROL DETAILS
3. SEE DWG 451665 AND 451868 FOR CONTROL DETAILS
4. SEE DWG 451256 FOR CONTROL DETAILS
5. THIS DRAWING SUPERSEDES DRAWING 5159370 AND ALL CCN'S WHICH PERTAIN TO IT
6. EXCEPTIONS TO THE PIPING SPEC HP3 FOR NITROGEN LINES TO CV-113 ARE SHOWN ON LAYOUT DWG 453610

DWG. LIST M-____ SH.____ • REVISE ON CADD SYSTEM ONLY •

SAFETY RELATED EXCEPT AS NOTED (SREAN)

WP 82-063

5178000	P&I DIAGRAM LEGEND SH 1
5178001	P&I DIAGRAM LEGEND SH 2
5178002	P&I DIAGRAM LEGEND SH 3
5159794	ELEM DIAGRAM - AFW SOLENOID VALVES
451256	LOGIC DIAGRAM - AFWS ACTUATION
REFERENCE DRAWINGS	

REFERENCE DRAWINGS

NO.	REVISIONS	M	DATE	P.E.	QAE	SUPV	APPROVED	ENGR	CK'D	MADE	J.O.
2	AS BUILT-INCORP DCN #3, #6 & #7 (DCN #4 & 5 NOT USED)		9/20/85	PT				DH		DVY	3083
1	AS BUILT-INCORP DCN #2 CC #1 CANCELED			SEE	CDM FILES FOR SIGNATURES					BLS	8744
0	ISSUED AS BUILT			SEE	CDM FILES FOR SIGNATURES					DVY	8252

LOCATION: SAN ONOFRE NUCLEAR GEN. STA. UNIT 1

P & I DIAGRAM
AUXILIARY FEEDWATER
SYSTEM SHEET 2

SCE EDISON
Rosemead California

AFW

SHEET NO. M

SCALE: NONE

____ OF ____ SHTS.

02-14-85

SCE E4-632-CADD 10-83

5159570

5178221-2

MICROFILMED FROM BEST AVAILABLE COPY

26X

2