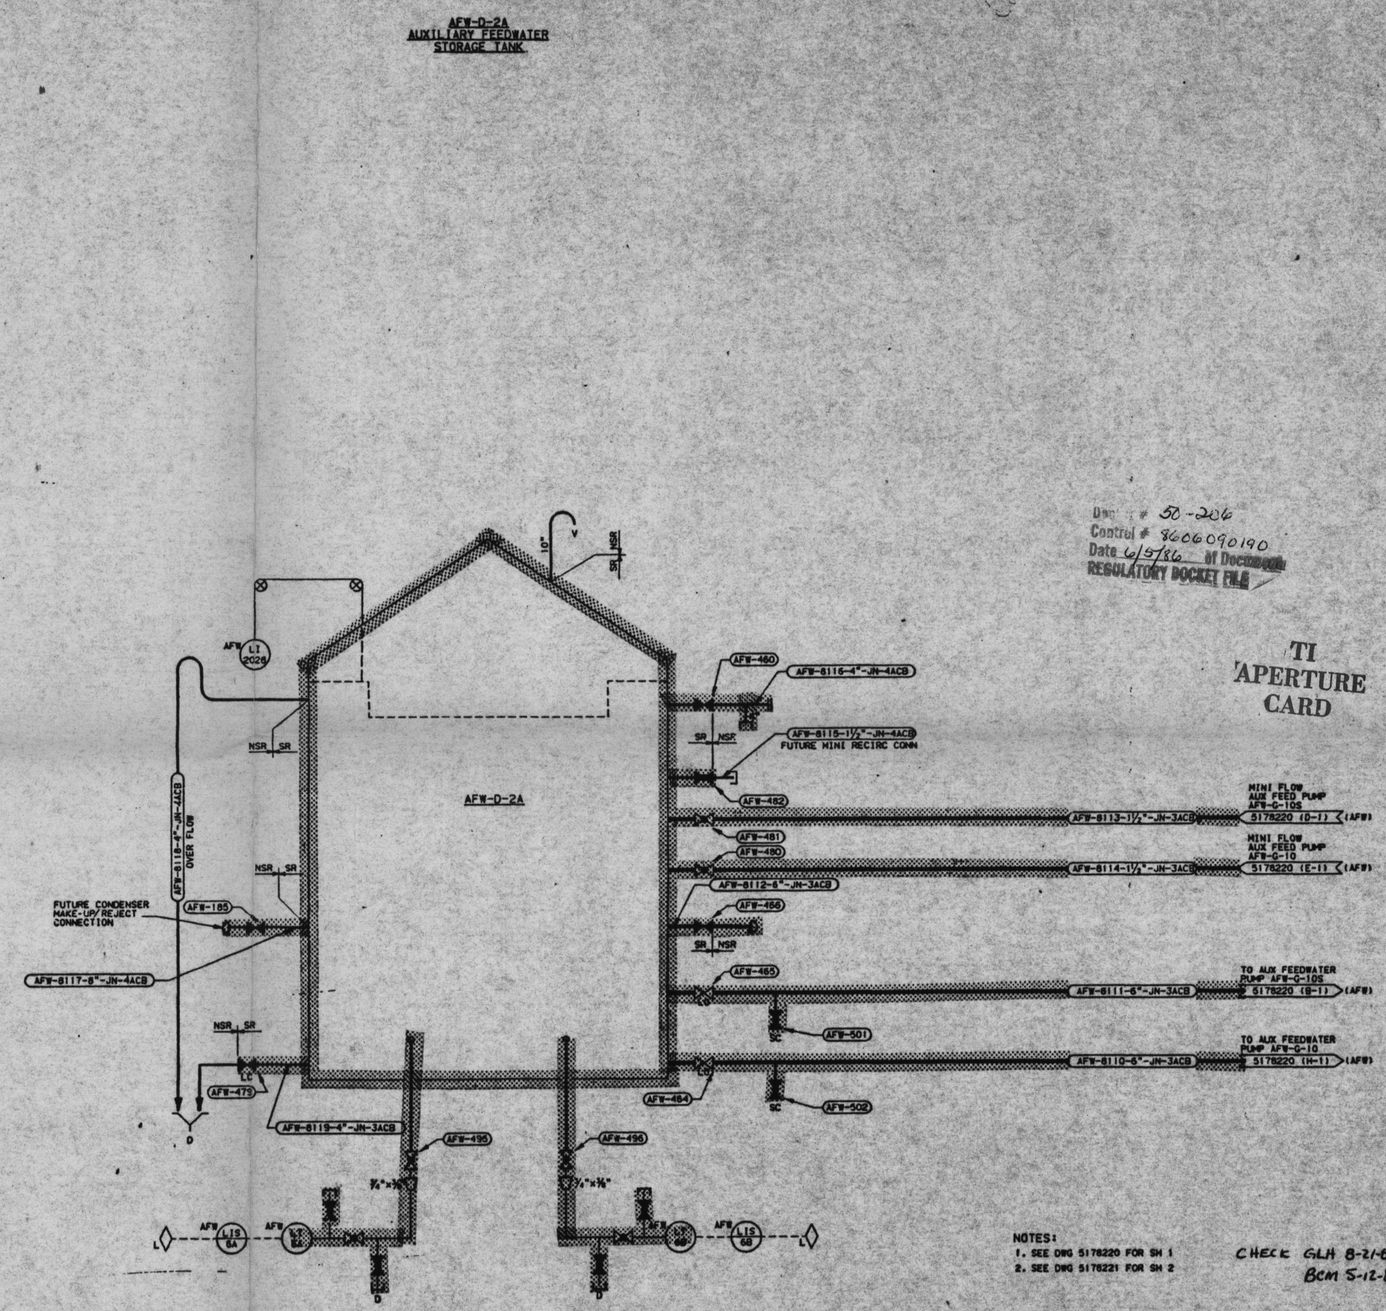

Doc # 50-206
Control # 8606090190
Date 6/5/86 of Document
REGULATORY DOCKET FILE

TI
APERTURE
CARD

NOTES:
1. SEE DWG 5178220 FOR SH 1
2. SEE DWG 5178221 FOR SH 2

CHECK GLH 8-21-85
BCM 5-12-86

DWG. LIST M-___ SH.___
* REVISE ON CADD SYSTEM ONLY *

SAFETY RELATED
EXCEPT AS NOTED
(SREAN)

WP 82-297

AFW

5178000	P&I DIAGRAM LEGEND SH 1
5178001	P&I DIAGRAM LEGEND SH 2
5178002	P&I DIAGRAM LEGEND SH 3

REFERENCE DRAWINGS | REFERENCE DRAWINGS | NO. | REVISIONS | M | DATE | P.E. | QAE | SUPV | APPROVED | ENGR | CK'D | MADE | J.O.

NO.	REVISIONS	M	DATE	P.E.	QAE	SUPV	APPROVED	ENGR	CK'D	MADE	J.O.
0	AS BUILT - PARTIALLY INCORP DCN #3 & #4		7/8/85					DH		BLS	3083
	TO DWG 5178220 ON THIS DWG										

LOCATION: SAN ONOFRE NUCLEAR GEN. STA. UNIT 1

P & I DIAGRAM
AUXILIARY FEEDWATER
SYSTEM SHEET 3

EDISON
Rosemead California

SHEET NO.
M

SCALE: NONE

___ OF ___ SHTS.

01-30-85

5178222-0

26X

MICROFILMED FROM
BEST AVAILABLE COPY

3