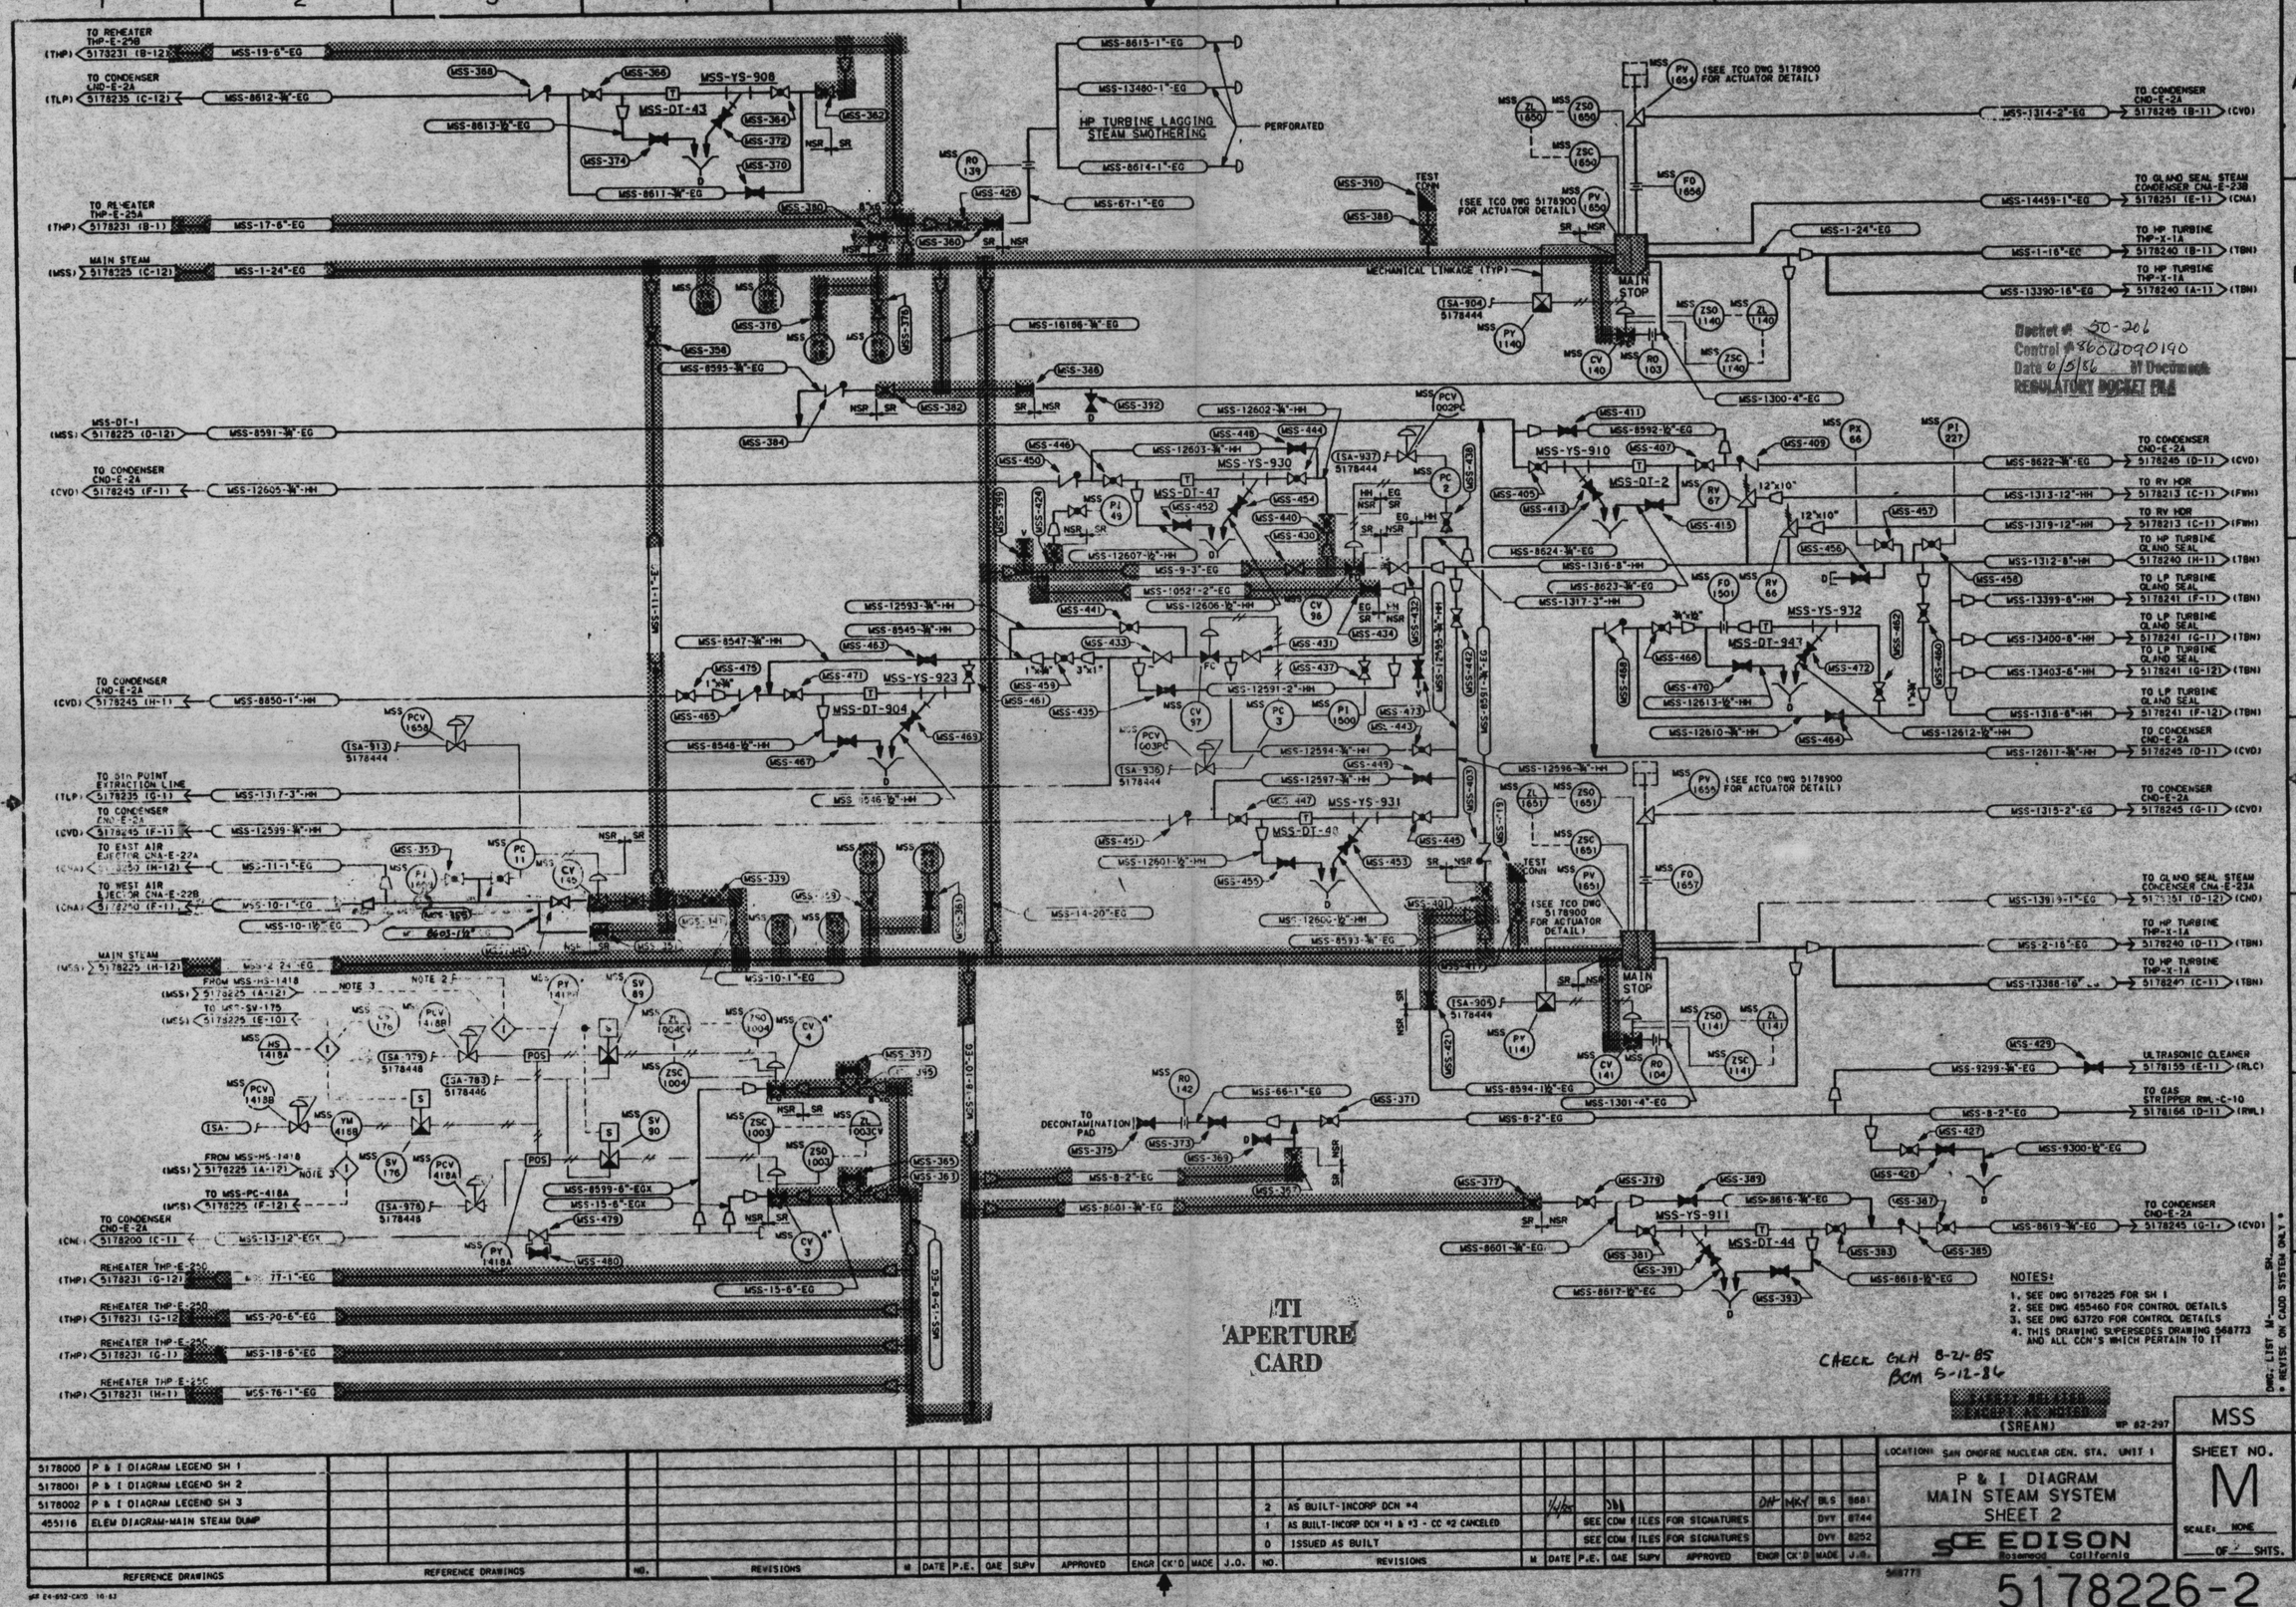

Docket # 50-206
Control # 8602090190
Date 6/5/86 # Documents
REGULATORY DOCKET FILE

TI APERTURE CARD

CHECK GLH 8-21-85
BCM 5-12-86

NOTES:
1. SEE DWG 5178225 FOR SH 1
2. SEE DWG 455460 FOR CONTROL DETAILS
3. SEE DWG 63720 FOR CONTROL DETAILS
4. THIS DRAWING SUPERSEDES DRAWING 568773 AND ALL CCN'S WHICH PERTAIN TO IT

(SREAN) WP 82-297

REFERENCE DRAWINGS	
5178000	P & I DIAGRAM LEGEND SH 1
5178001	P & I DIAGRAM LEGEND SH 2
5178002	P & I DIAGRAM LEGEND SH 3
455116	ELEM DIAGRAM-MAIN STEAM DUMP

NO.	REVISIONS	DATE	P.E.	QAE	SUPV	APPROVED	ENGR	CK'D	MADE	J.O.
2	AS BUILT-INCORP DCN #4	7/86				SEE CDM FILES FOR SIGNATURES		DHF	MKY	BLS 8681
1	AS BUILT-INCORP DCN #1 & #3 - CC #2 CANCELED					SEE CDM FILES FOR SIGNATURES				DVY 8744
0	ISSUED AS BUILT									DVY 8252

LOCATION: SAN ONOFRE NUCLEAR GEN. STA. UNIT 1

P & I DIAGRAM
MAIN STEAM SYSTEM
SHEET 2

SCE EDISON
Rosemead California

MSS

SHEET NO. M

SCALE: NONE

OF SHTS.

12-27-84

568773

5178226-2

DWG: LIST M- SH.
• REVISE ON CADD SYSTEM ONLY •

MICROFILMED FROM BEST AVAILABLE COPY
26X