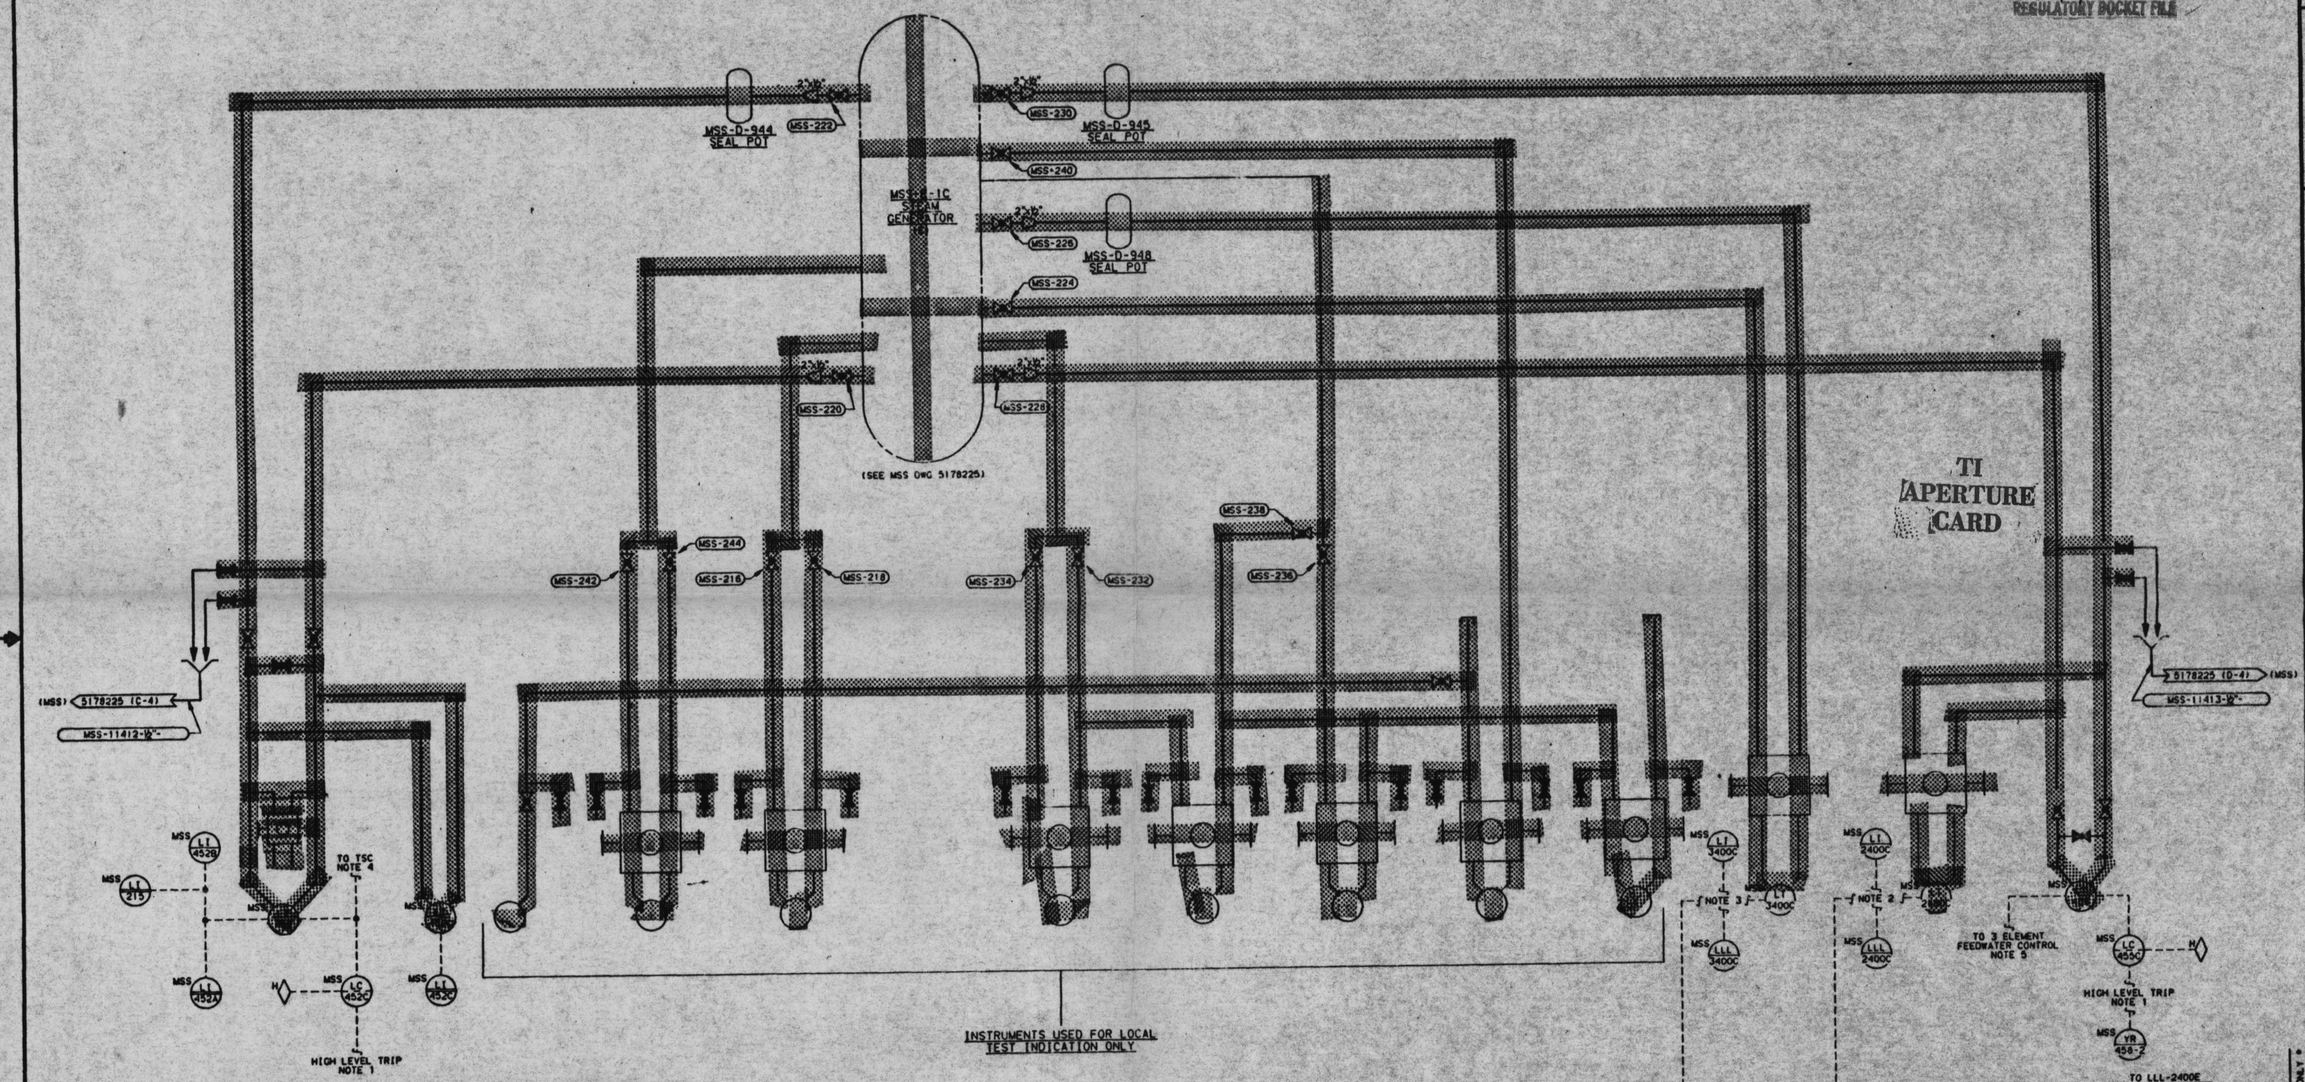

Docket # 50-206
Control # 8606090190
Date 6/5/86 of Document
REGULATORY DOCKET FILE

TI APERTURE CARD

CHECK GLH 8-21-85
BCM 5-12-86

NOTES:
1. SEE DWG N1541 SH 2 FOR CONTROL DETAILS
2. SEE DWG 451775 FOR CONTROL DETAILS
3. SEE DWG 451776 FOR CONTROL DETAILS
4. SEE DWG 451421 FOR CONTROL DETAILS
5. SEE DWG 5129817 FOR CONTROL DETAILS
6. SEE DWG 5178225 FOR SH 1
7. SEE DWG 5178226 FOR SH 3

[redacted]
(SREAN) WP 82-297

DWG. LIST Lc SH. * REVISE ON CADD SYSTEM ONLY *

REFERENCE DRAWINGS	
5178000	P & I DIAGRAM LEGEND SH 1
5178001	P & I DIAGRAM LEGEND SH 2
5178002	P & I DIAGRAM LEGEND SH 3

NO.	REVISIONS	M	DATE	P.E.	QAE	SUPV	APPROVED	ENGR	CK'D	MADE	J.O.
0	ISSUED AS BUILT (INCORP DCN #4 TO DWG 5178225)							DH		DVY	3083

LOCATION: SAN ONOFRE NUCLEAR GEN. STA. UNIT 1

P & I DIAGRAM
MAIN STEAM SYSTEM
SHEET 3

SCE EDISON
Rosemead, California

MSS
SHEET NO. M
SCALE: NONE
OF SHTS.

01-09-85

5178227-0

SR X4-052-CADD 10-83

MICROFILMED FROM BEST AVAILABLE COPY
26X