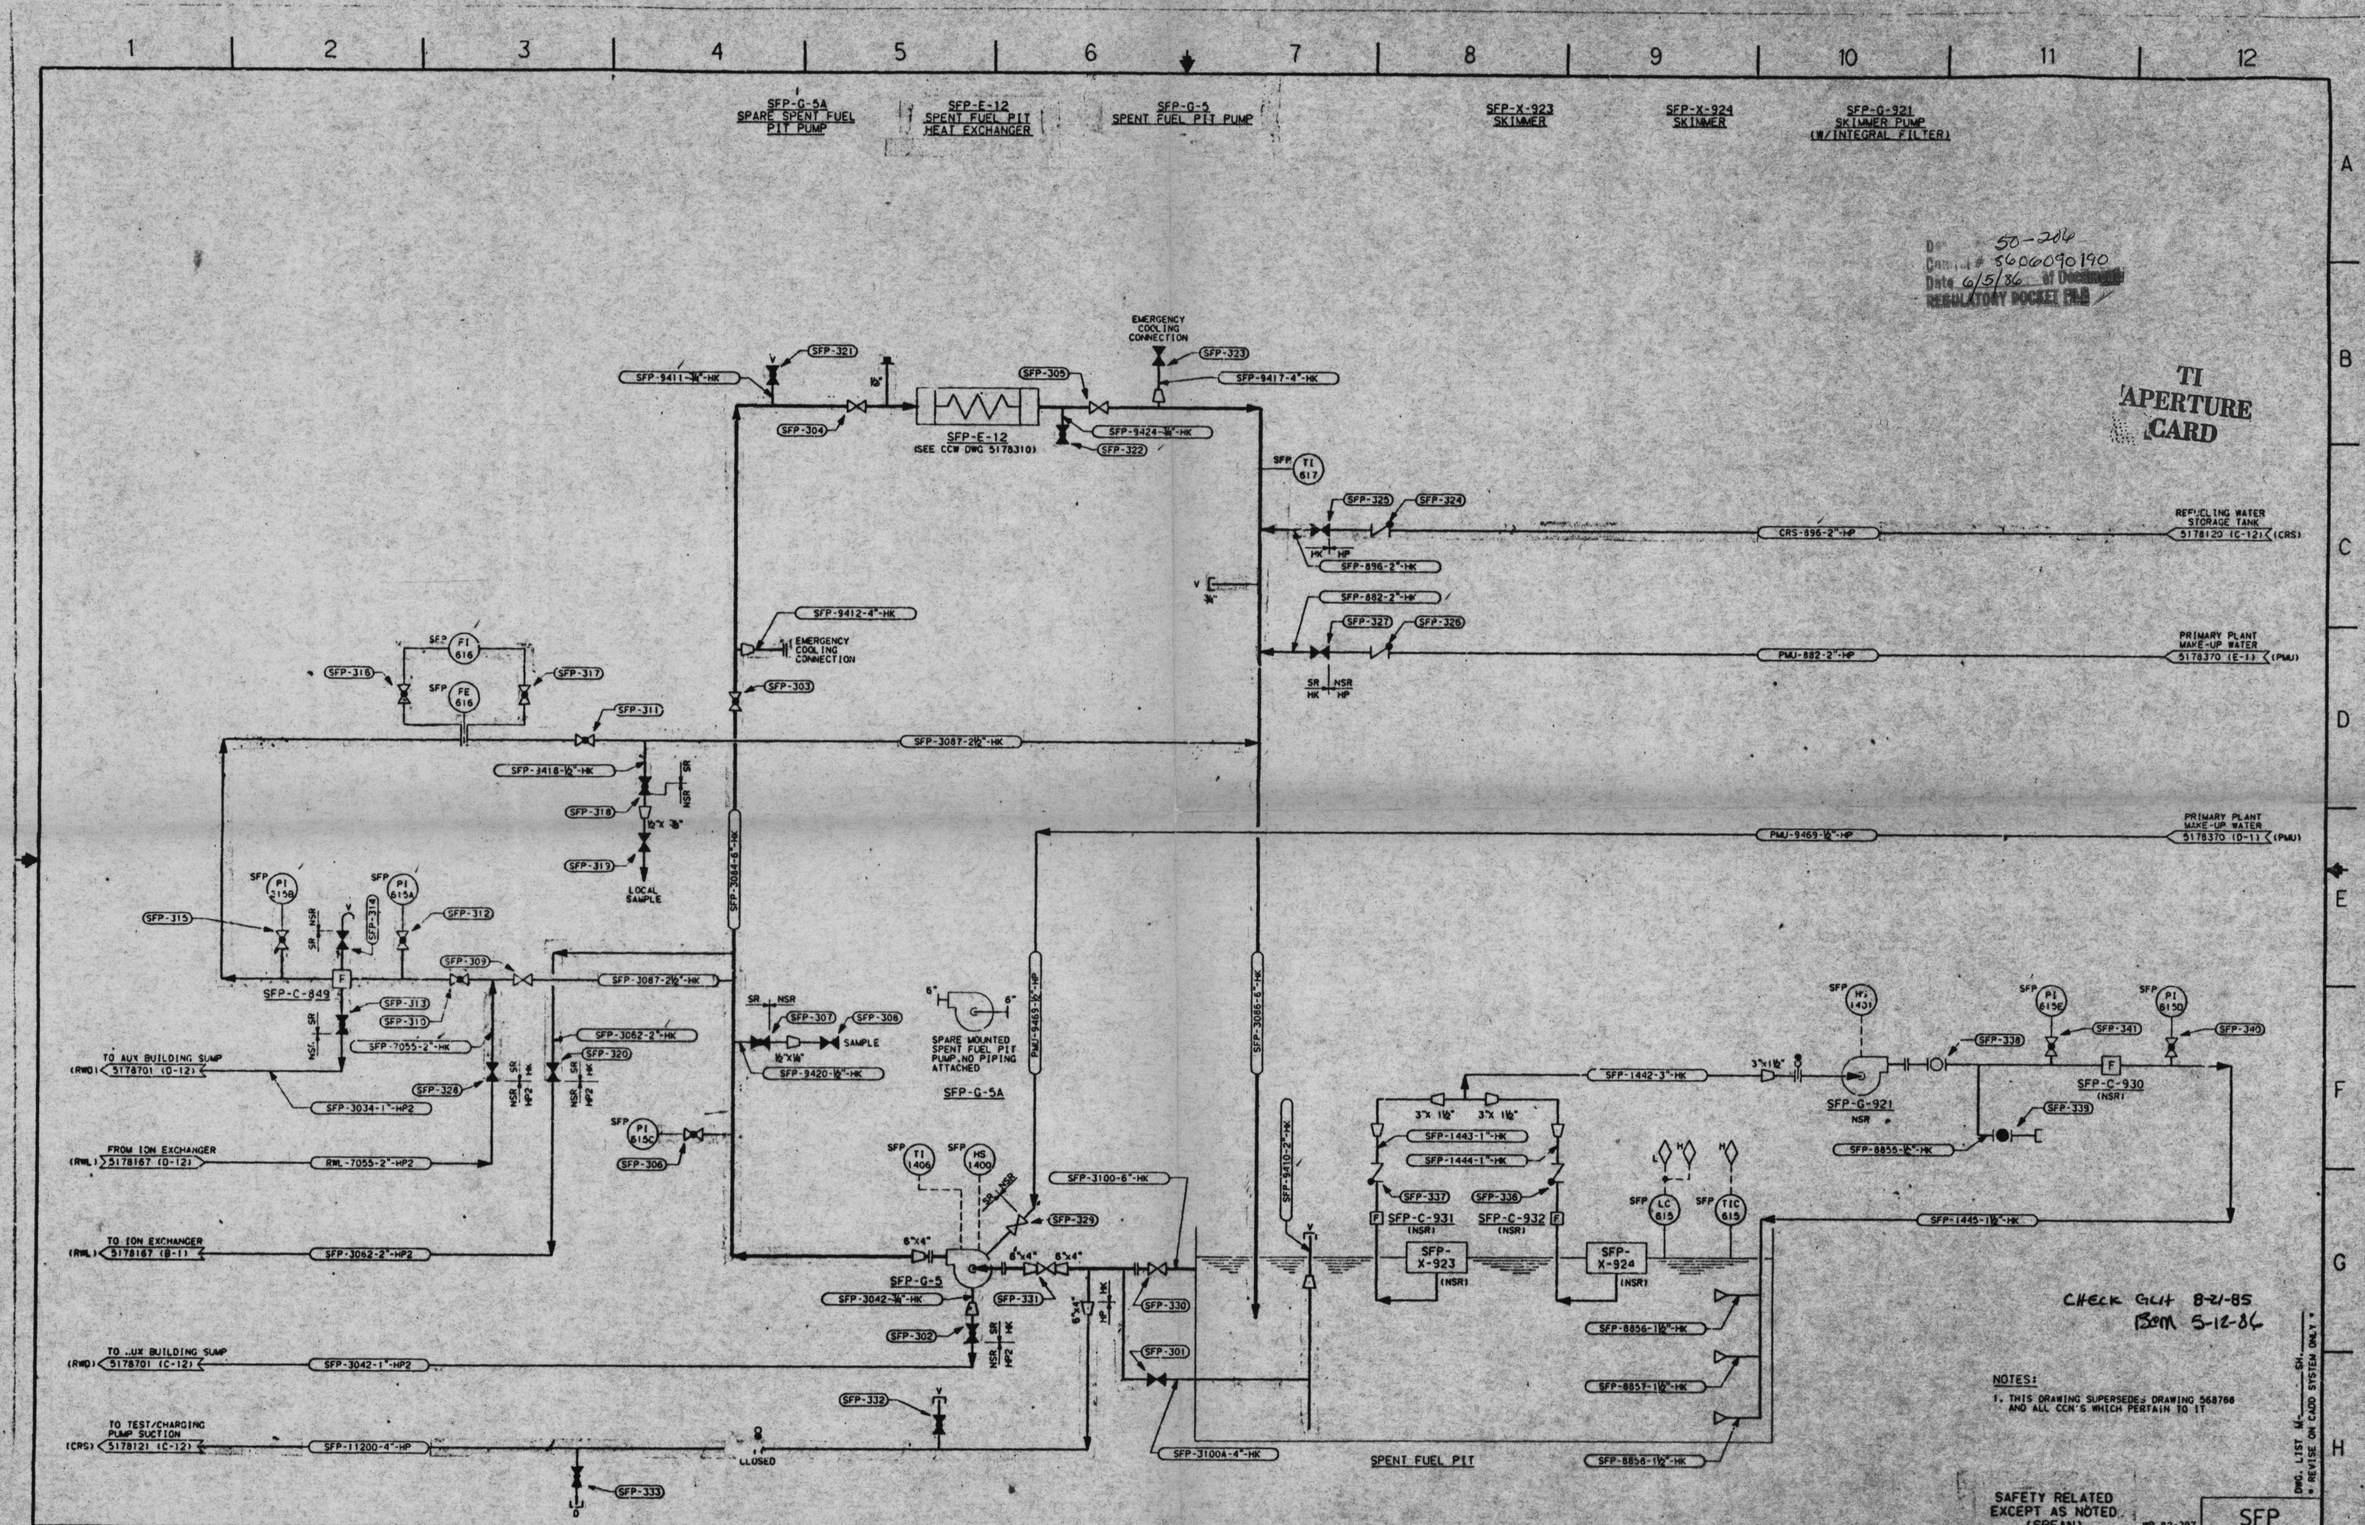


NOTES:
1. THIS DRAWING SUPERSEDES DRAWING 568768 AND ALL CCN'S WHICH PERTAIN TO IT

SAFETY RELATED EXCEPT AS NOTED (SREAN)

| REFERENCE DRAWINGS | |
|---|---|
| 5178000 | P & I DIAGRAM LEGEND SH 1 |
| 5178001 | P & I DIAGRAM LEGEND SH 2 |
| 5178002 | P & I DIAGRAM LEGEND SH 3 |
| 455912 | ELEM DIAGRAM-PUMPS G-5 & G-56 |

| NO. | REVISIONS | M | DATE | P.E. | GAE | SUPV | APPROVED | ENGR | CK'D | MADE | J.O. |
|---|---|---|---|---|---|---|---|---|---|---|---|
| 3 | AS BUILT-INCORP DCN #4,(CC#1 VOID BY DCN #4) | | | | | | | | | DVY | 8881 |
| 2 | AS BUILT-INCORP DCN #3 | | | SEE | COM | FILES | FOR SIGNATURES | | | BLS | 8744 |
| 1 | AS BUILT-INCORP DCN #2 | | | SEE | COM | FILES | FOR SIGNATURES | | | BLS | 9744 |
| 0 | ISSUED AS BUILT | | | SEE | COM | FILES | FOR SIGNATURES | | | DVY | 8252 |

LOCATION: SAN ONOFRE NUCLEAR GEN. STA. UNIT 1

P & I DIAGRAM
SPENT FUEL PIT
COOLING SYSTEM

SCE EDISON
Rosemead California

SFP

SHEET NO. M

SCALE: NONE

___ OF ___ SHTS.

DWG. LIST M-___ SH.___
* REVISE ON CADD SYSTEM ONLY *

12-17-84

566768

5178300-3

MICROFILMED FROM
BEST AVAILABLE COPY

26X