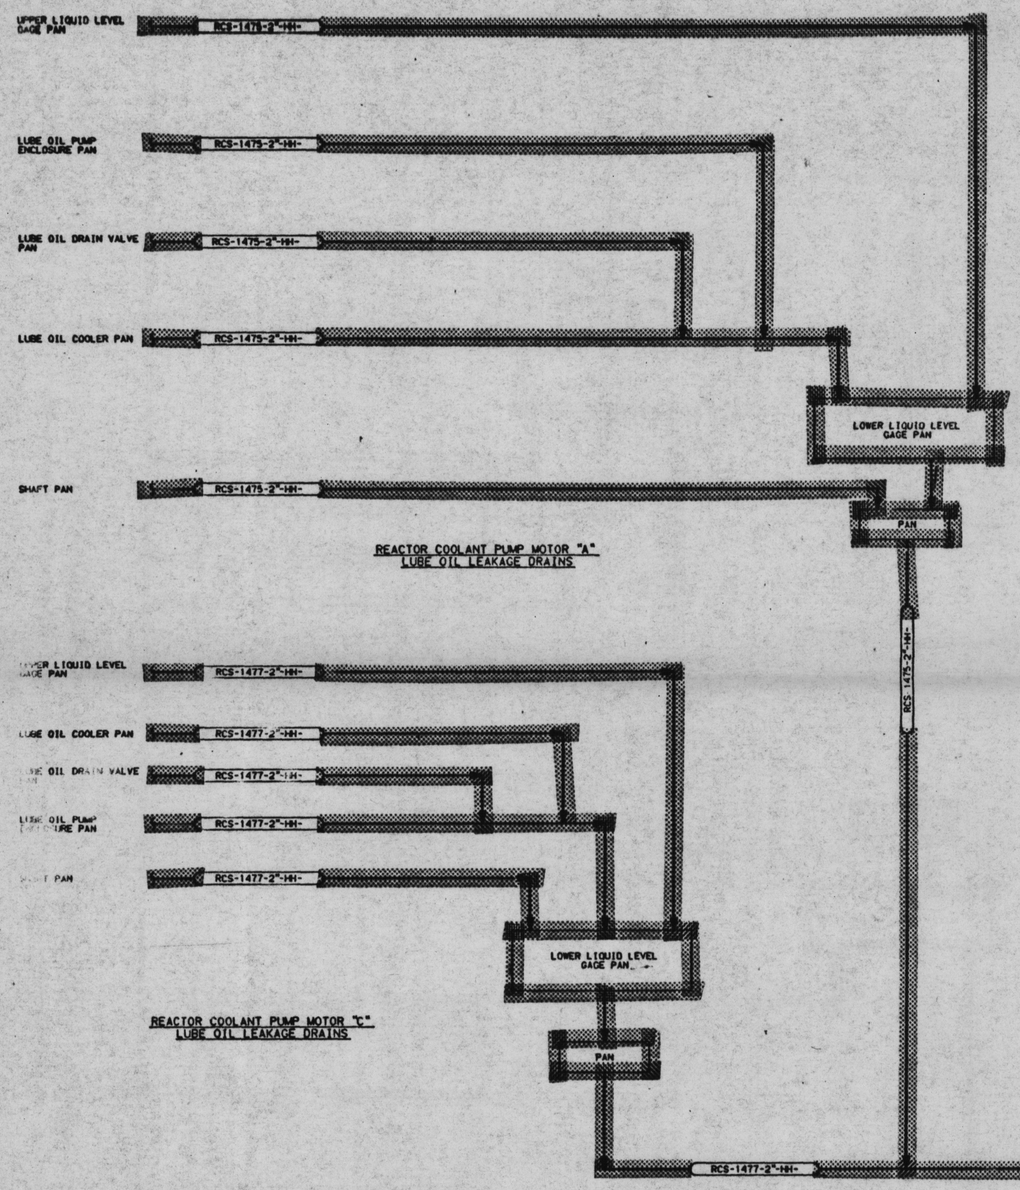

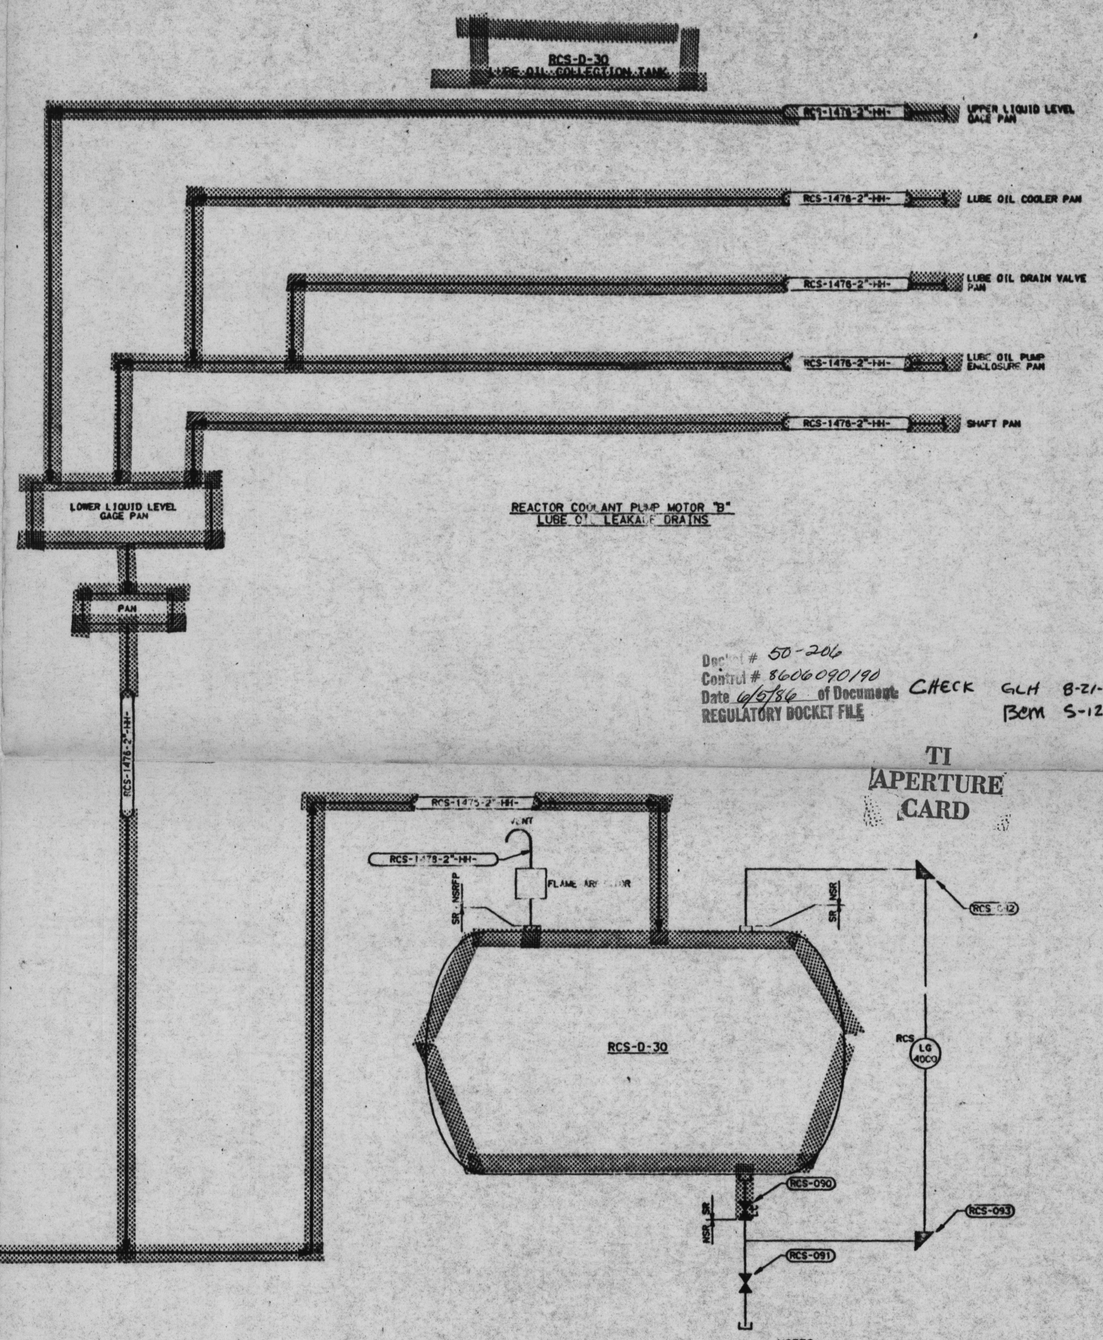

Docket # 50-206
Control # 8606090190
Date 6/5/86 of Document
REGULATORY DOCKET FILE

CHECK GLH 8-21-85
Bem 5-12-86

TI APERTURE CARD

REFERENCE DRAWINGS	
5178000	P & I DIAGRAM LEGEND SH 1
5178001	P & I DIAGRAM LEGEND SH 2
5178002	P & I DIAGRAM LEGEND SH 3

NO.	REVISIONS	M	DATE	P.E.	QAE	SUPV	APPROVED	ENGR	CK'D	MADE	J.O.
0	ISSUED AS BUILT, INCORP DCN #2 TO 5178100							DM	GJ	BLS	8744

LOCATION: SAN ONOFRE NUCLEAR GEN. STA. UNIT 1

P & I DIAGRAM
REACTOR COOLANT
SYSTEM SH 2

SCE EDISON
Rosemead California

RCS

SHEET NO. M

SCALE: NONE

OF SHTS.

5178101-0

MICROFILMED FROM BEST AVAILABLE COPY

26X