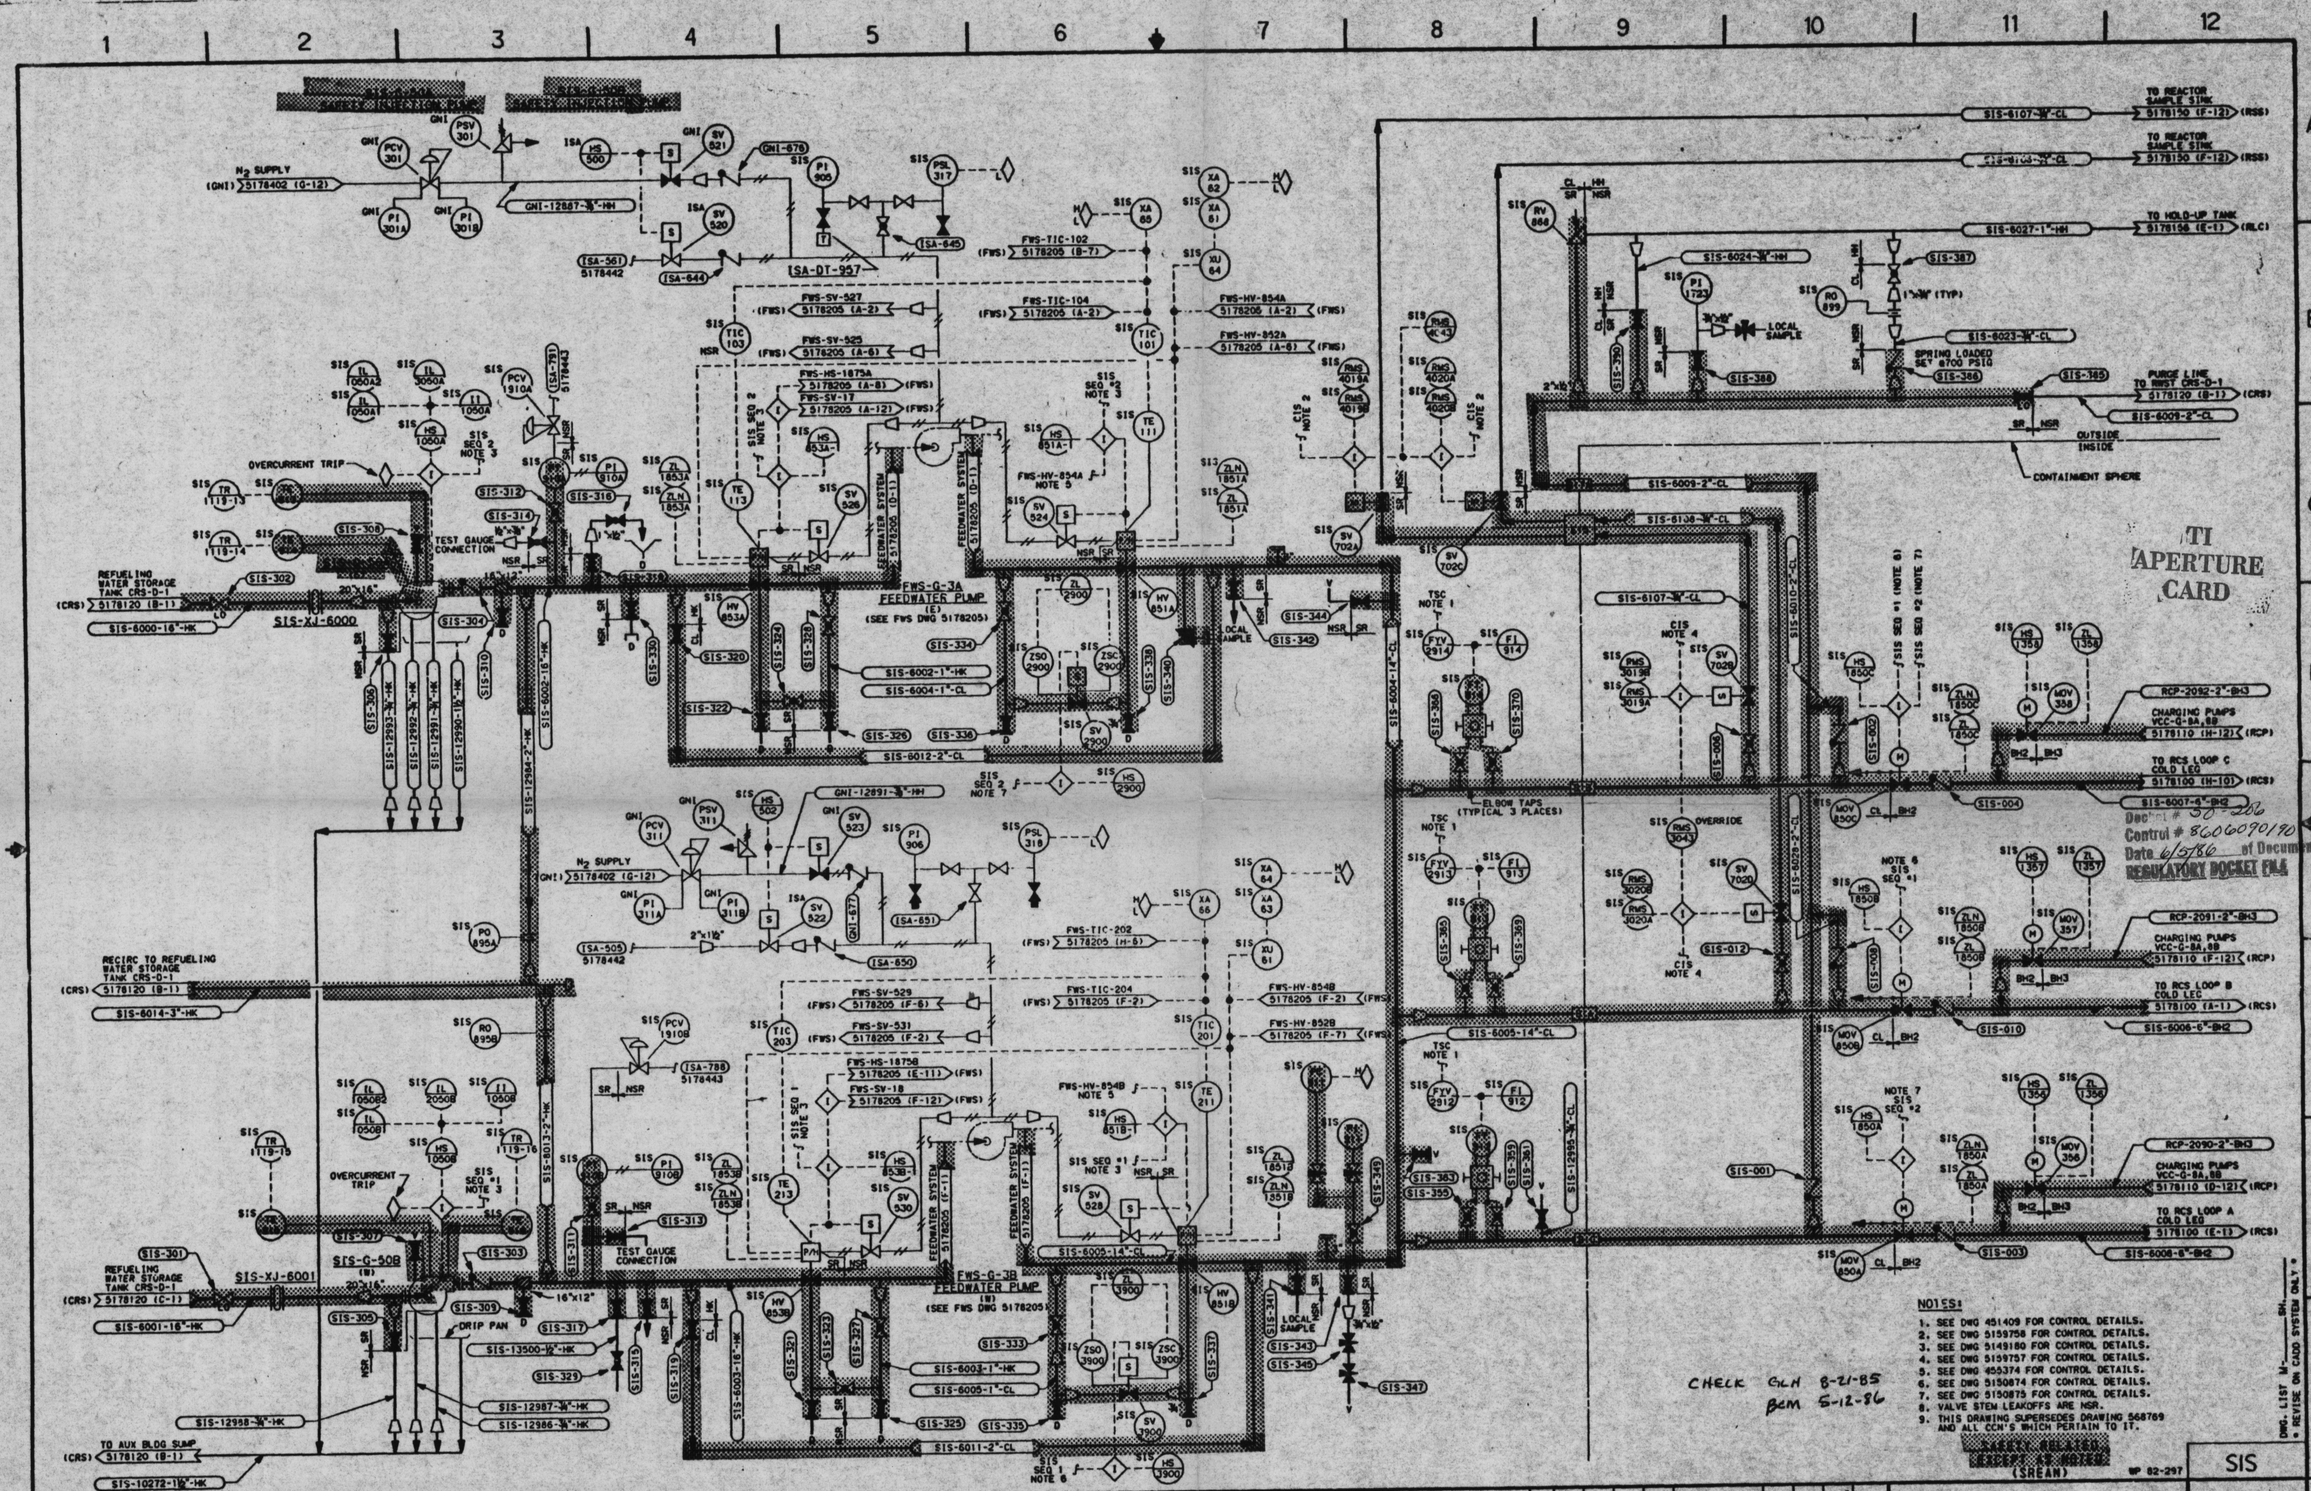

NOTES:

1. SEE DWG 451409 FOR CONTROL DETAILS.
2. SEE DWG 5159758 FOR CONTROL DETAILS.
3. SEE DWG 5149180 FOR CONTROL DETAILS.
4. SEE DWG 5159757 FOR CONTROL DETAILS.
5. SEE DWG 455374 FOR CONTROL DETAILS.
6. SEE DWG 5150874 FOR CONTROL DETAILS.
7. SEE DWG 5150875 FOR CONTROL DETAILS.
8. VALVE STEM LEAKOFFS ARE NSR.
9. THIS DRAWING SUPERSEDES DRAWING 568769 AND ALL CCN'S WHICH PERTAIN TO IT.

SAFETY RELATED EXCEPT AS NOTED (SREAN)

CHECK GLH 8-21-85
BCM 5-12-86

TI APERTURE CARD

Docket # 50-206
Control # 8606090190
Date 6/5/86 of Document
REGULATORY DOCKET FILE

DWG. LIST M-____ SH. ____
• REVISE ON CADD SYSTEM ONLY •

WP 82-297

REFERENCE DRAWINGS		REFERENCE DRAWINGS	
5178000	P & I DIAGRAM LEGEND SH 1	455370	ELEM DIAG G-50A & G-50B
5178001	P & I DIAGRAM LEGEND SH 2	455373	ELEM DIAG HV-851A & HV-851B
5178002	P & I DIAGRAM LEGEND SH 3	5159757	ELEM DIAG SY-702B & 702D
455368	ELEM DIAG MOV-850A & MOV-850B	455372	ELEM DIAG HV-853A & HV-853B
455516	ELEM DIAG MOV-850C	451409	LOGIC DIAG SIS FLOW INDICATION
455371	ELEM DIAG MOV-356,357 & 358	5149180	SEQUENCE SCHEDULE NO 1

NO.	REVISIONS	M	DATE	P.E.	QAE	SUPV	APPROVED	ENGR	CK'D	MADE	J.O.
4	AS BUILT-INCORP DCN #4 & #6 (DCN #5 NEVER USED)		1-15-85					DH	MKY	BLS	9083
3	AS BUILT-INCORP DCN #3			SEE	COM	FILES	FOR SIGNATURES			BLS	8744
2	AS BUILT-INCORP DCN #2			SEE	COM	FILES	FOR SIGNATURES			BLS	8744
1	AS BUILT-INCORP DCN #1			SEE	COM	FILES	FOR SIGNATURES			BLS	8744
0	ISSUED AS BUILT			SEE	COM	FILES	FOR SIGNATURES			BLS	8252

LOCATION: SAN ONOFRE NUCLEAR GEN. STA. UNIT 1

P & I DIAGRAM
SAFETY INJECTION
SYSTEM

SCE EDISON
Rosemead California

SIS

SHEET NO. M

SCALE: NONE

____ OF ____ SHTS.

01-07-85

568769

5178115-4

MICROFILMED FROM BEST AVAILABLE COPY

26X

18