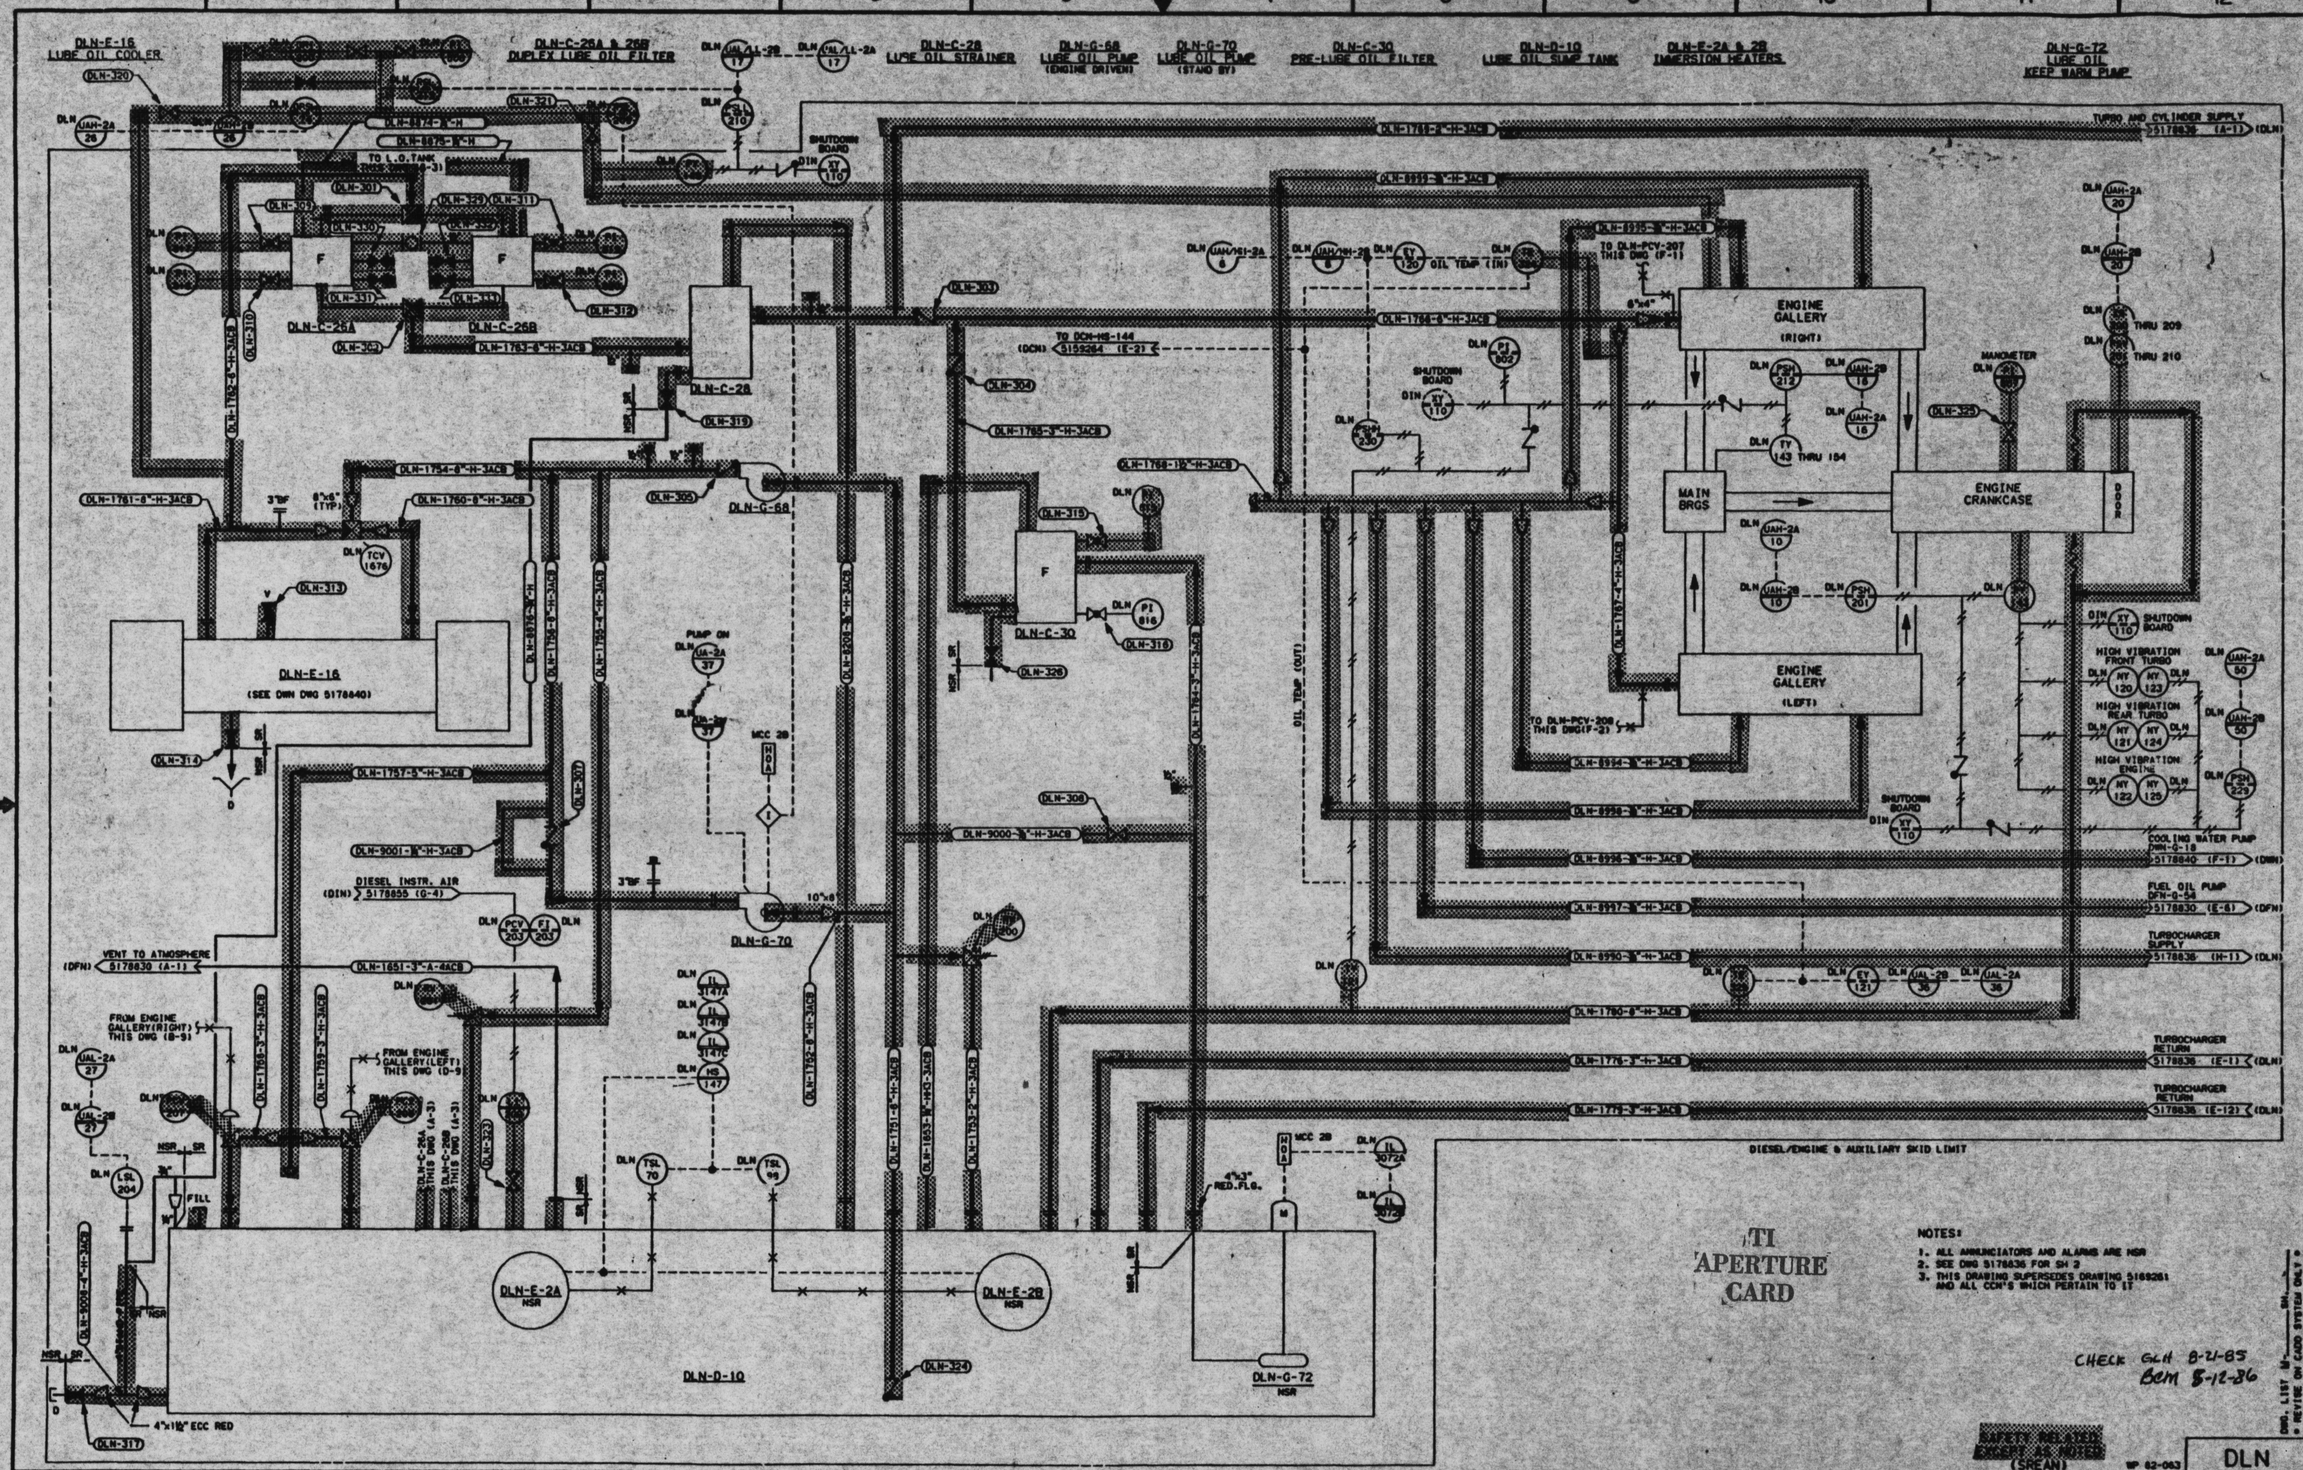

NOTES:
1. ALL ANNUNCIATORS AND ALARMS ARE NSR
2. SEE DWG 5178836 FOR SH 2
3. THIS DRAWING SUPERSEDES DRAWING 5169281 AND ALL CON'S WHICH PERTAIN TO IT

TI APERTURE CARD

CHECK GLH 8-21-85
BEM 8-12-86

5178000	P & I DIAGRAM LEGEND SH 1
5178001	P & I DIAGRAM LEGEND SH 2
5178002	P & I DIAGRAM LEGEND SH 3
5149152	DIESEL GEN. PNEUMATIC SCHEMATIC
5152905	DIESEL GEN. LUBE OIL SUMP

REFERENCE DRAWINGS

NO.	REVISIONS	M	DATE	P.E.	GAE	SUPV	APPROVED	ENGR	CK'D	MADE	J.O.
0	ISSUED AS BUILT										

NO.	REVISIONS	M	DATE	P.E.	GAE	SUPV	APPROVED	ENGR	CK'D	MADE	J.O.
4	DWN REVISED PER DCN-HS-144		8/21/85							JAM	JB 8744

LOCATION: SAN ONOFRE NUCLEAR GEN. STA. UNIT 1

P & I DIAGRAM
DIESEL #2 LUBE OIL
SYSTEM SH 1

SCE EDISON
Rosemead California

DLN

SHEET NO. M

SCALE: NONE

OF SHTS.

WP 82-063

5178835-0

MICROFILMED FROM BEST AVAILABLE COPY
26X
46