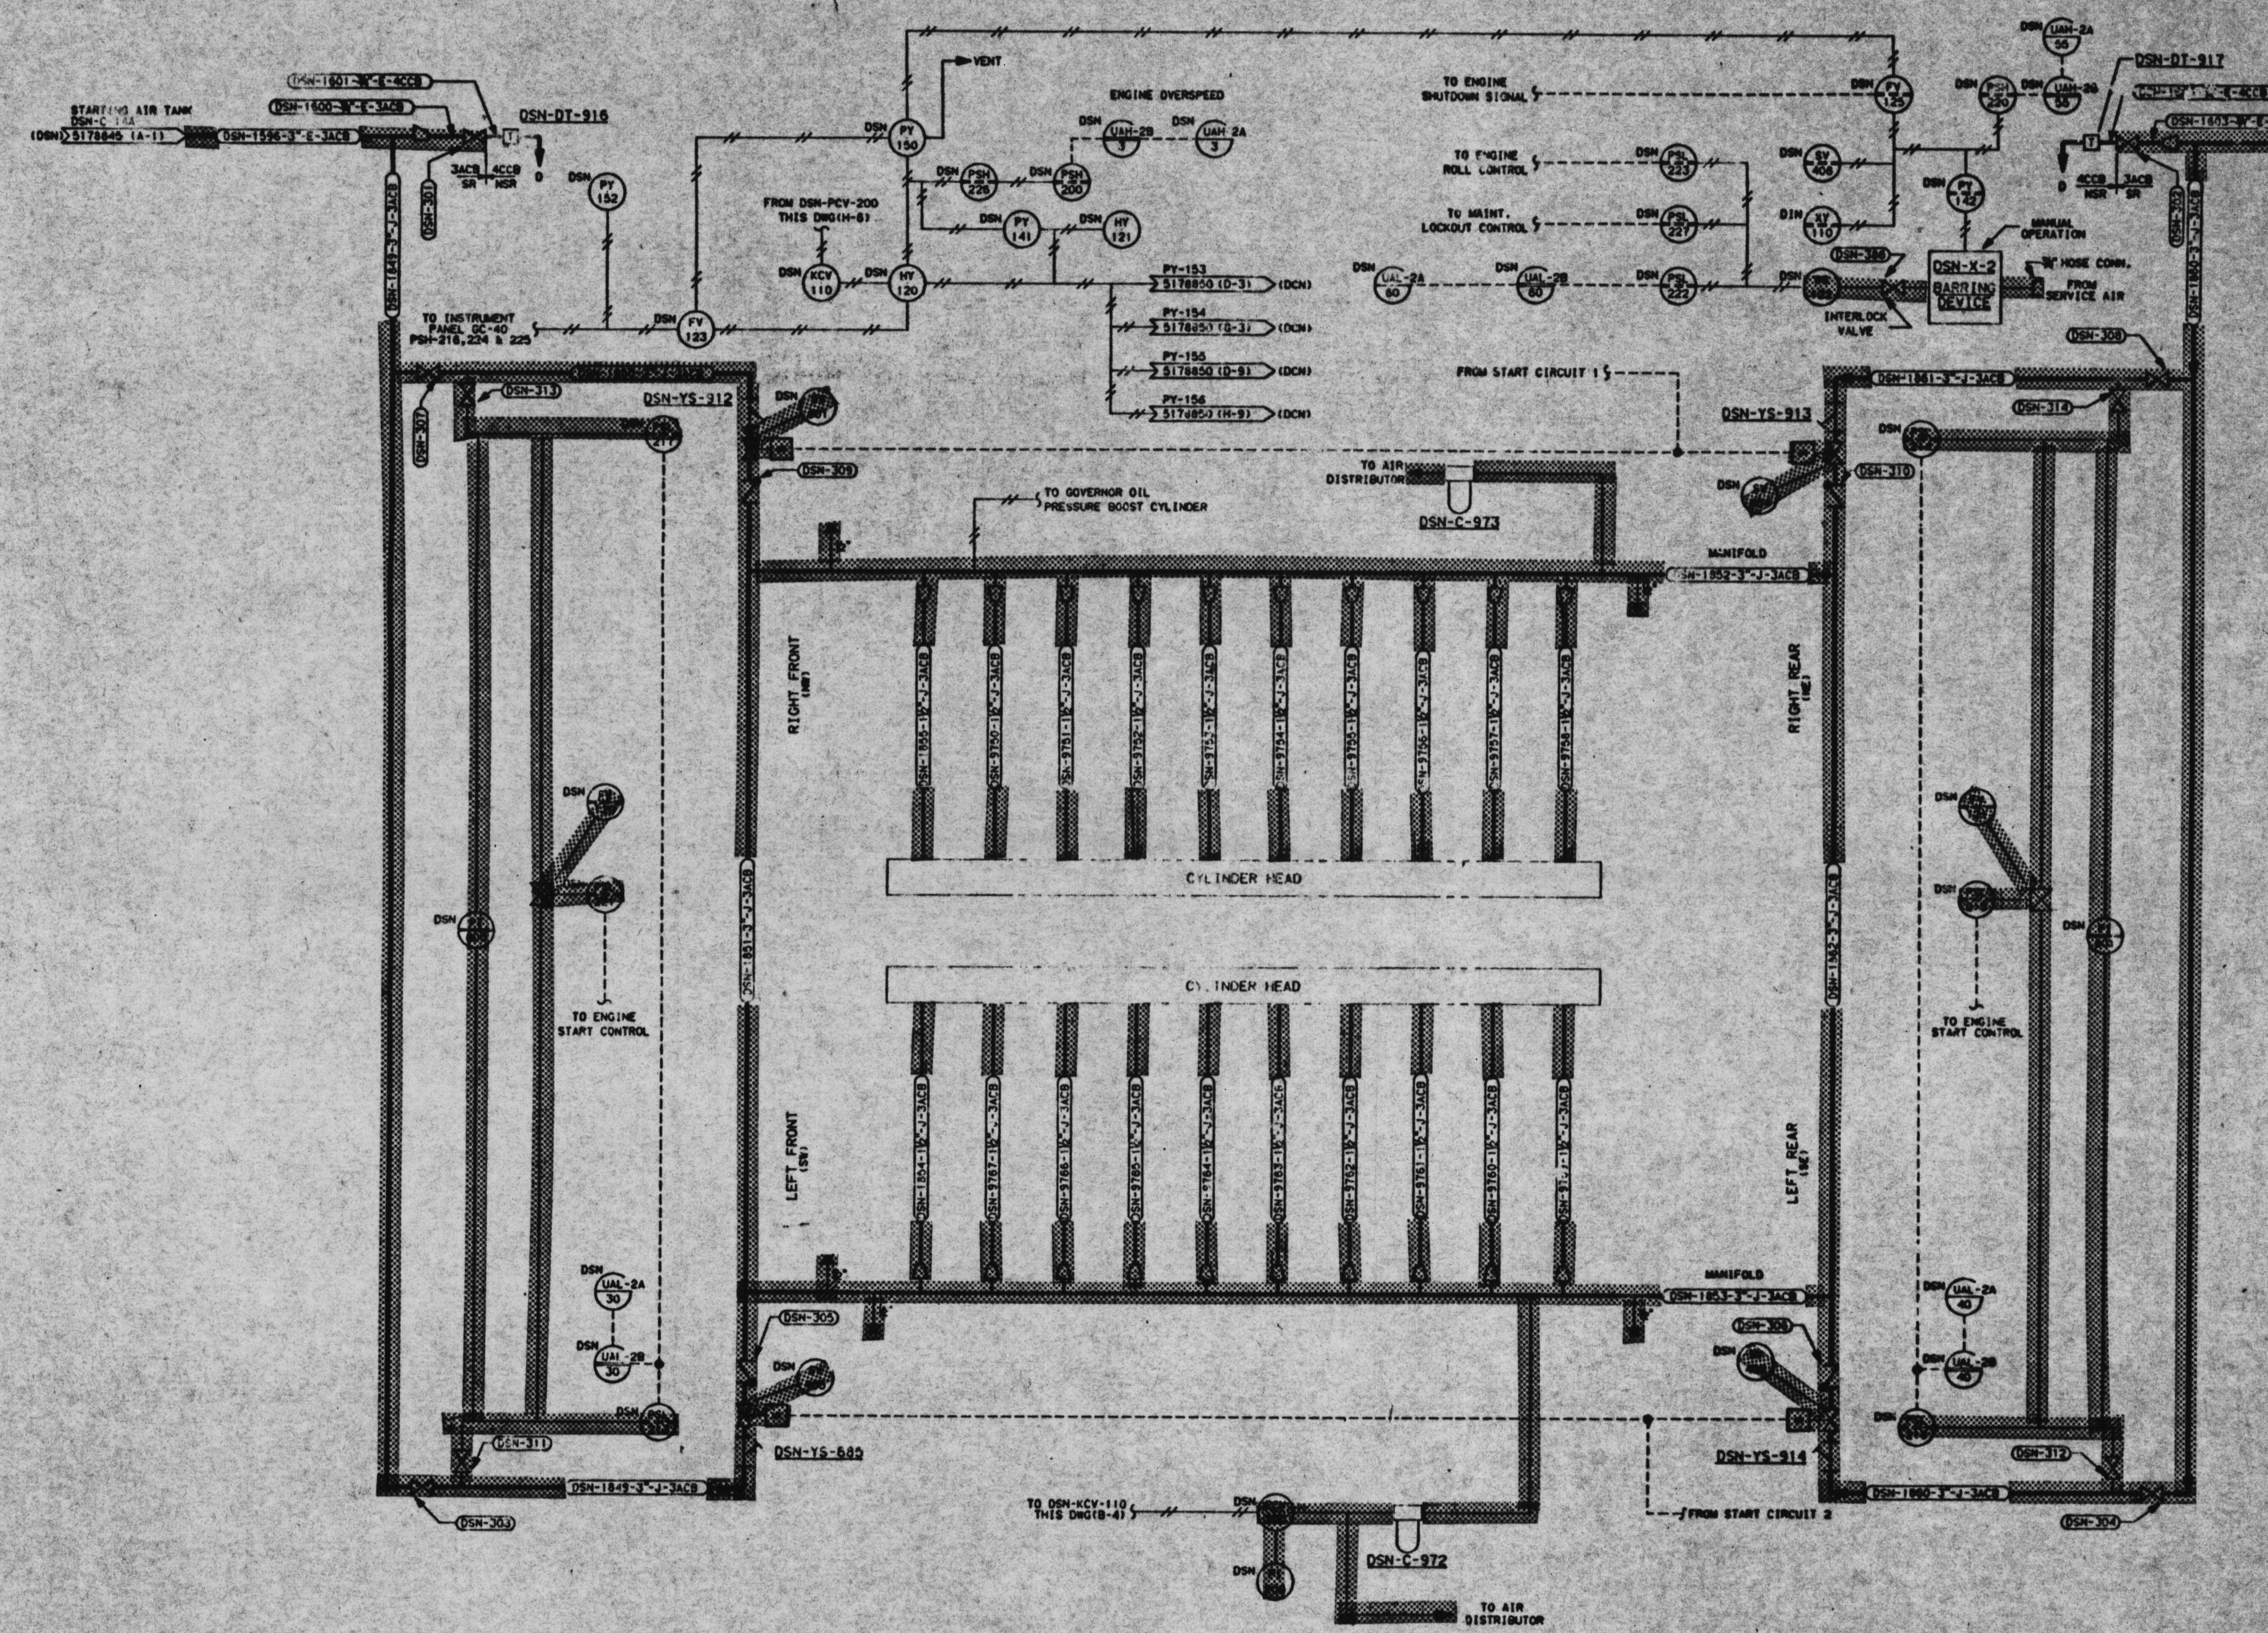

TI APERTURE CARD

NOTES:

1. ALL ANNUNCIATORS AND ALARMS ARE NSR.
2. SEE DWG 5178845 FOR SH 1
3. THIS DRAWING SUPERSEDES DRAWING 5169268 AND ALL CCN'S WHICH PERTAIN TO IT

CHECK GLH 8-21-85
BCM 5-12-86

DWG. LIST M-____ SH.____
• REVISE ON CADD SYSTEM ONLY •

SAFETY RELATED EXCEPT AS NOTED (SREAN)

WP 82-063

DSN

5178000	P & I DIAGRAM LEGEND SH 1
5178001	P & I DIAGRAM LEGEND SH 2
5178002	P & I DIAGRAM LEGEND SH 3
5149192	DIESEL GEN. PNEUMATIC SCHEMATIC
5149802	DIESEL GEN #2 ANN. SYSTEM SH 1
5151364	DIESEL GEN #2 ENGINE CONTR SYS SH 1
REFERENCE DRAWINGS	

REFERENCE DRAWINGS

NO.	REVISIONS	M	DATE	P.E.	QAE	SUPV	APPROVED	ENGR	CK'D	MADE	J.O.
0	ISSUED AS BUILT		2-4-86						LAM	GP	8744

LOCATION: SAN ONOFRE NUCLEAR GEN. STA. UNIT 1

P & I DIAGRAM
DIESEL #2 STARTING AIR
SYSTEM SH 2

SCE EDISON
Rosemead California

SHEET NO.
M

SCALE: NONE
____ OF ____ SHTS.

5154034
7/23/84

5178846-0

SCE 24 662-CADD 10-83

26X

MICROFILMED FROM BEST AVAILABLE COPY

50