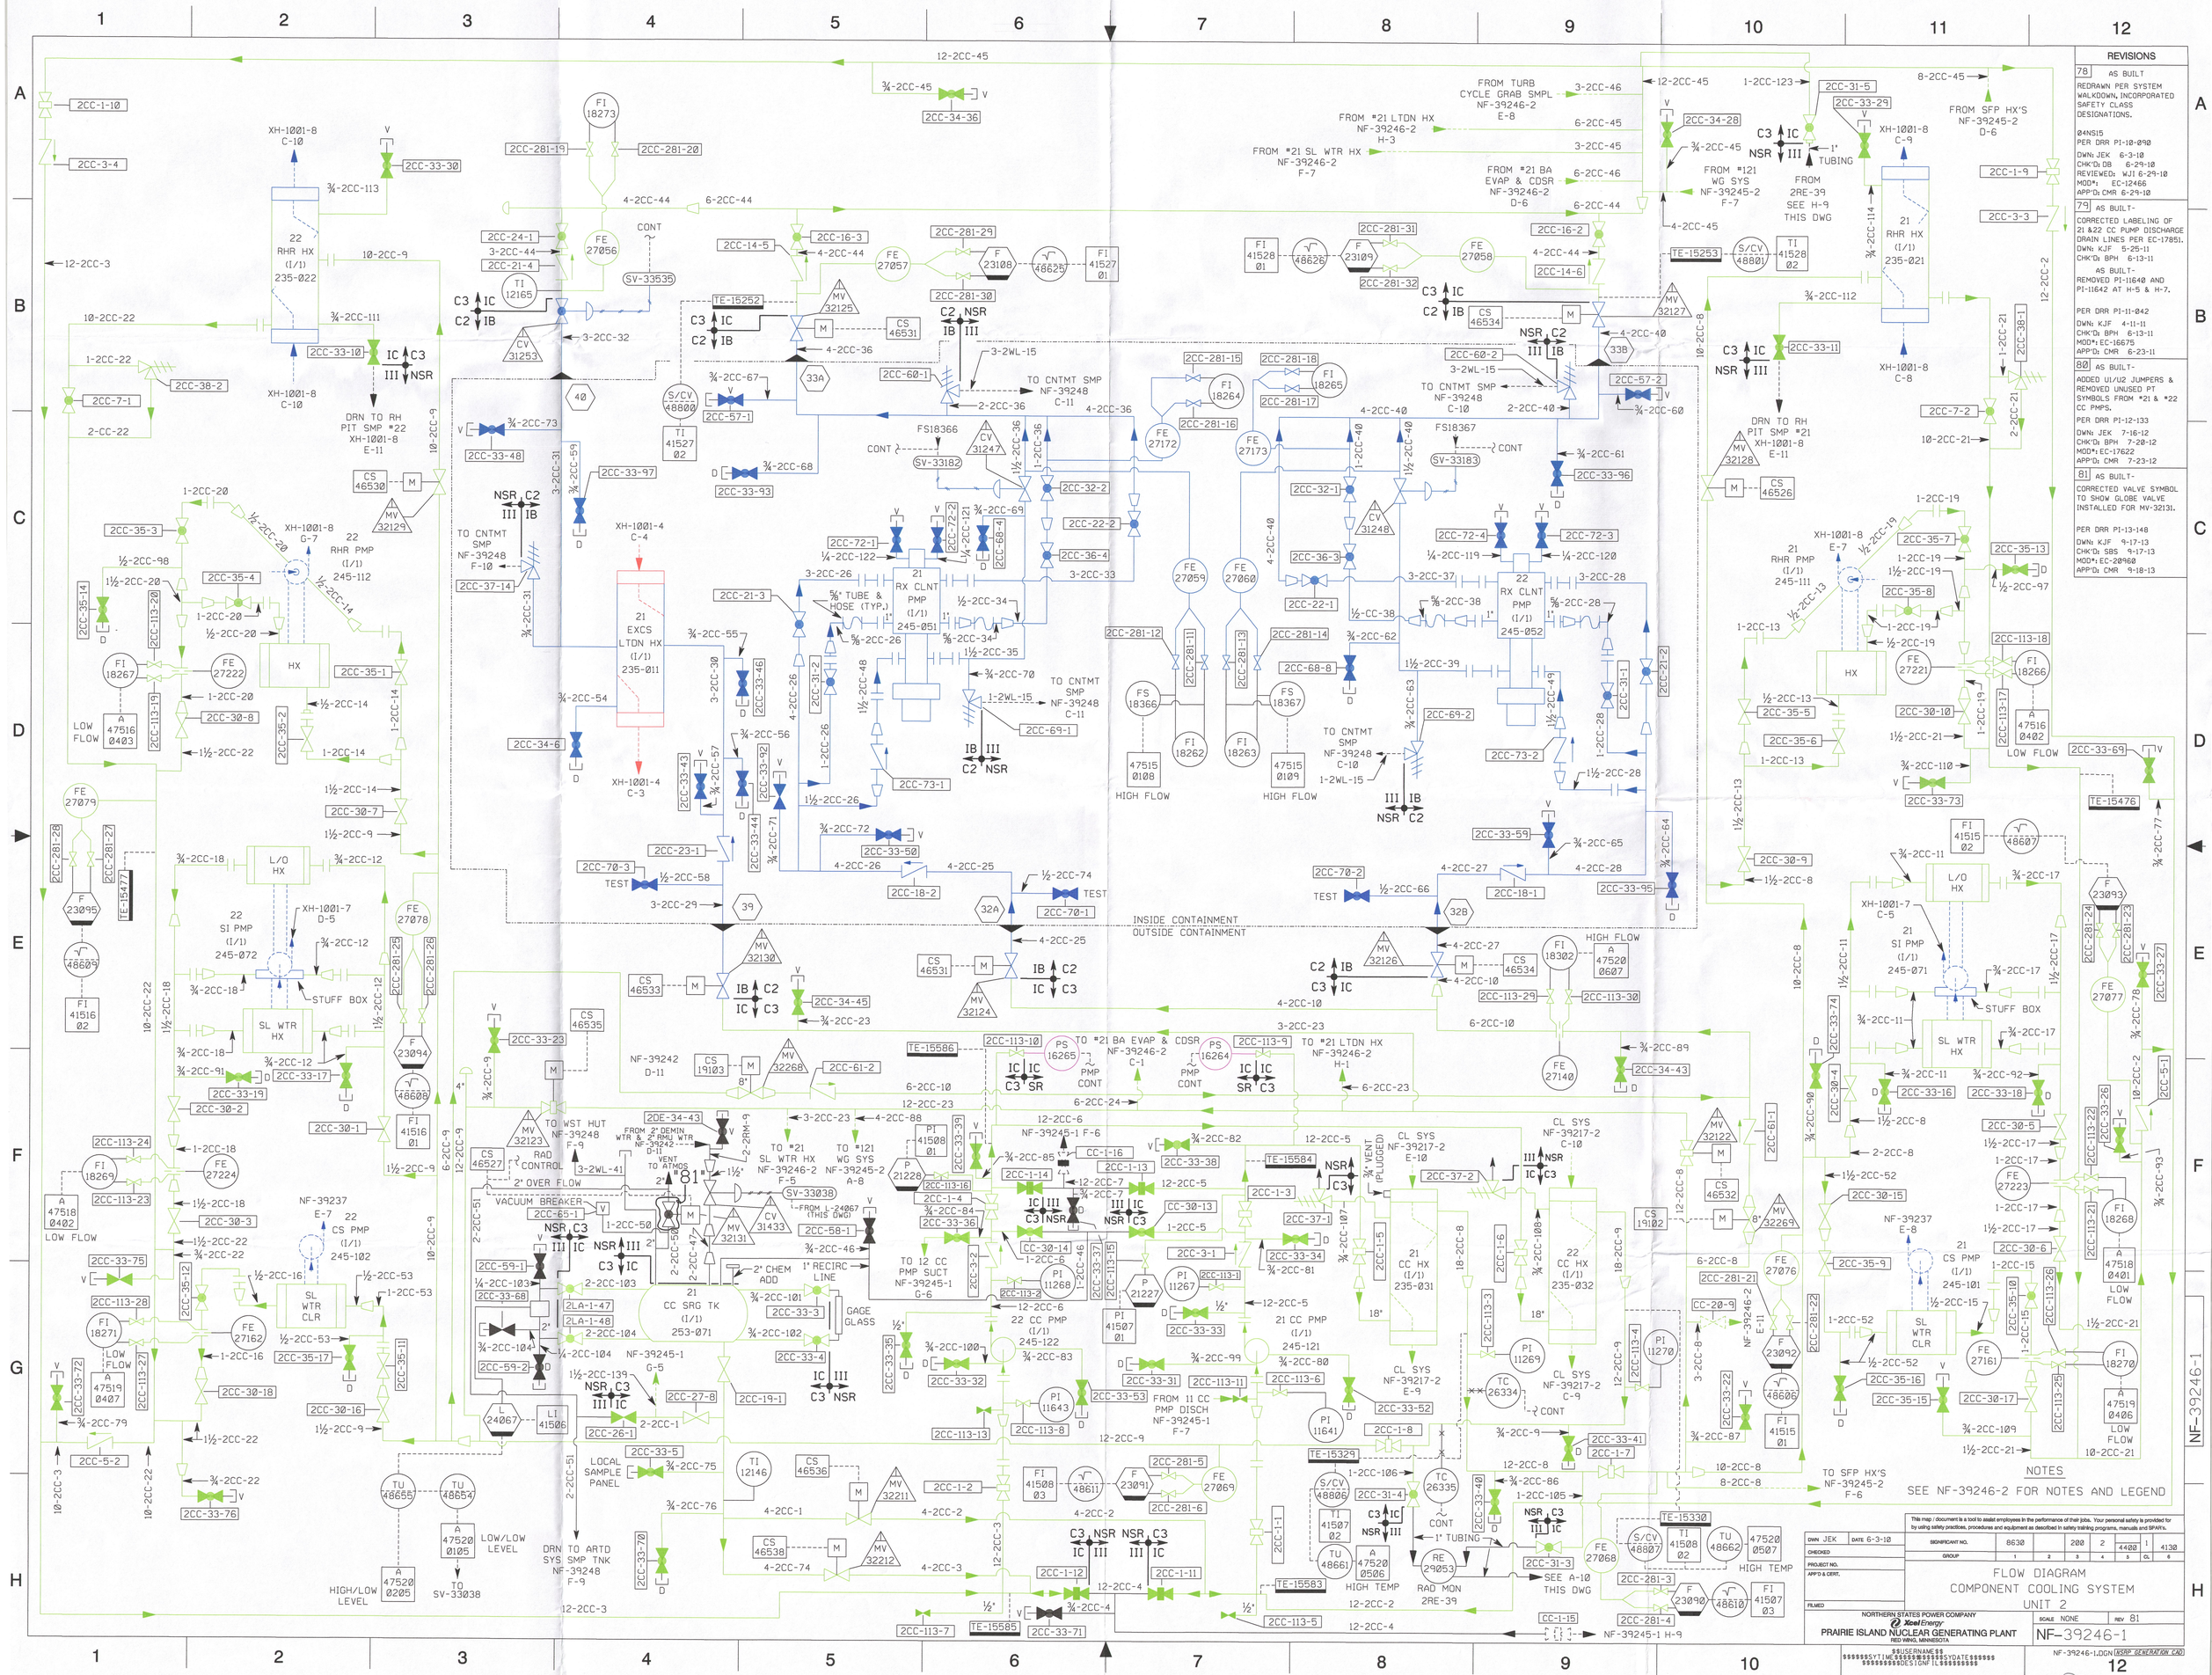
REVISIONS
78 AS BUILT
REDRAWN PER SYSTEM WALKDOWN, INCORPORATED SAFETY CLASS DESIGNATIONS.
04NSI5
PER DRR PI-10-090
DWN: JEK 6-3-10
CHK'D: DB 6-29-10
REVIEWED: WJI 6-29-10
MOD#: EC-12466
APP'D: CMR 6-29-10
79 AS BUILT-
CORRECTED LABELING OF 21 &22 CC PUMP DISCHARGE DRAIN LINES PER EC-17851.
DWN: KJF 5-25-11
CHK'D: BPH 6-13-11
AS BUILT-
REMOVED PI-11640 AND PI-11642 AT H-5 & H-7.
PER DRR PI-11-042
DWN: KJF 4-11-11
CHK'D: BPH 6-13-11
MOD#: EC-16675
APP'D: CMR 6-23-11
80 AS BUILT-
ADDED U1/U2 JUMPERS & REMOVED UNUSED PT SYMBOLS FROM *21 & *22 CC PMPS.
PER DRR PI-12-133
DWN: JEK 7-16-12
CHK'D: BPH 7-20-12
MOD#: EC-17622
APP'D: CMR 7-23-12
81 AS BUILT-
CORRECTED VALVE SYMBOL TO SHOW GLOBE VALVE INSTALLED FOR MV-32131.
PER DRR PI-13-148
DWN: KJF 9-17-13
CHK'D: SBS 9-17-13
MOD#: EC-20960
APP'D: CMR 9-18-13
NOTES
SEE NF-39246-2 FOR NOTES AND LEGEND
FLOW DIAGRAM
COMPONENT COOLING SYSTEM
UNIT 2
NORTHERN STATES POWER COMPANY
PRAIRIE ISLAND NUCLEAR GENERATING PLANT
RED WING, MINNESOTA
NF-39246-1
NF-39246-1.DGN (NSRP GENERATION CAD)
NF-39246-1